
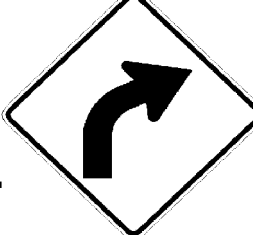
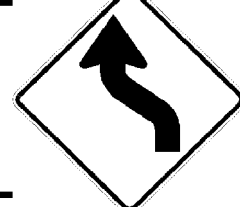




DIRECTION	MILEPOINT	LOCATION CODE (SHEET 2)	SIGN CODE	WIDTH (IN)	HEIGHT (IN)	SHEETING REMARKS	SIGN LEGEND	NEW SIGNS		EXISTING SIGNS				EXIST POST		NUMBER OF NEW POSTS	SQUARE STEEL (IN)			TUBULAR STEEL Ø (IN)				SIGN FRAME REQUIRED	REMARKS	SIGN DETAIL LOCATION					
								"A"	"B"	RETAIN	SALVAGE FROM	SALVAGE TO	REMOVE	RETAIN	REMOVE		1.75	2.00	2.50	FOUNDATION	3.0	3.50	4.00			5.00	SHSM	PROJECT SHEET #	STANDARD SHEET #		
																	(LB / FT)				(LB / FT)										
<b>MARLBORO EB</b>							FY-FLUORESCENT YELLOW FYG-FLUORESCENT YELLOW GREEN															"SHSM"-STANDARD HIGHWAY SIGNS AND MARKINGS									
EB	6.377	A	VW-205	36	36			9.00							2		X							INSTALL 50 FEET WEST OF CURRENT RIGHT CURVE SIGN LOCATION.		8					
EB	6.387	A	W1-2R	30	30		RIGHT CURVE																								
EB	6.415	A	W1-2R	30	30			6.25							1		X							INSTALL 150 FEET EAST OF CURRENT LOCATION.	X						
EB	6.606	A	S3-1	30	30										1		X												TRIM BRUSH		
		A	S3-1	36	36	FYG		9.00							2		X														
EB	6.819	A	W1-4L	30	30			6.25							1		X							INSTALL 75 FEET WEST OF EXISTING UNSAFE TO PASS ASSEMBLY.	X						
EB	6.833	A	VW-092	36	36		UNSAFE TO PASS																								
EB	6.866	A	W1-2L	30	30		<del>RIGHT</del> LEFT CURVE																							RIGHT CURVE	
		A	W13-1	18	18		40 MPH ADVISORY																								
		A	W1-6L	48	24			8.00							2		X														X
EB	7.015	A	W1-4L	30	30		RIGHT REVERSE CURVE																								
		A	W13-1	18	18		40 MPH ADVISORY																								
EB	7.080	A	W8-5	30	30		SLIPPERY WHEN WET CAR SYMBOL				1																				
		A	VW-116	24	18		ICING MAY OCCUR				1																				
EB	7.157	A	S3-1	30	30																										
<b>SIGN SUMMARY SHEET</b>							TOTALS	38.50	0.00	2	0	0	8	0	0	8		120	0	0.0	0.0	0.0	0.0	0.0	PROJECT NAME: <b>WOODFORD-MARLBORO</b> PROJECT NUMBER: <b>STPG SIGN(35)</b>						
VERMONT AGENCY OF TRANSPORTATION							TOWN DIRECTIONAL TOTALS	634.4	0.0	28.0	1.0	1.0	127	0.0	0.0	88		1320.0	0		0.0				FILE NAME: <b>10B336</b> PLOT DATE: <b>4/10/2012</b> PROJECT MANAGER: <b>A. GAMBLE</b> DRAWN BY: <b>J. KELLY</b> DESIGNED BY: <b>J. KELLY</b> CHECKED BY: <b>A. GAMBLE</b> MARLBORO EB SHEET 14 SHEET <b>59</b> OF <b>80</b>						