
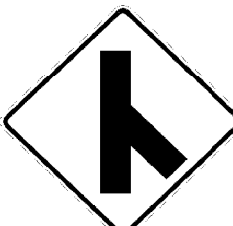


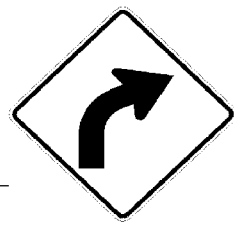




DIRECTION	MILEPOINT	LOCATION CODE (SHEET 2)	SIGN CODE	WIDTH (IN)	HEIGHT (IN)	SHEETING REMARKS	SIGN LEGEND	NEW SIGNS		EXISTING SIGNS				EXIST POST		NUMBER OF NEW POSTS	SQUARE STEEL (IN)			TUBULAR STEEL Ø (IN)				SIGN FRAME REQUIRED	REMARKS	SIGN DETAIL LOCATION			
								"A"	"B"	RETAIN	SALVAGE FROM	SALVAGE TO	REMOVE	RETAIN	REMOVE		1.75	2.00	2.50	FOUNDATION	3.0	3.50	4.00			5.00	SHSM	PROJECT SHEET #	STANDARD SHEET #
																	(LB / FT)				(LB / FT)								
<b>MARLBORO WB</b>							FY-FLUORESCENT YELLOW FYG-FLUORESCENT YELLOW GREEN																"SHSM"-STANDARD HIGHWAY SIGNS AND MARKINGS						
		F	W13-1	24	24	FY		4.00																	X				
WB	7.898	F	W2-3L	30	30	FY		6.25						1		X								INSTALL 250 FEET WEST OF RIGHT ACUTE CURVE SIGN ASSEMBLY.	X				
WB	7.821	G	VR-017	24	30								1		X									HAMILTON RD (TH-22)					
		G	VR-017	24	30			5.00						1		X											7		
WB	7.812	H	R1-1	30	30			6.25					1		X									HAMILTON RD (TH-22)	X				
		H	R1-1	30	30									1		X								REINSTALL ABOVE STOP SIGN USING BRACKET.					
							TOWN'S STREET NAME SIGN			1	1	1																	
WB	7.789	F	W1-4R	30	30		RIGHT REVERSE CURVE						1		X														
		F	W13-1P	18	18		40 MPH ADVISORY						1																
WB	7.751	F	W1-2R	30	30	FY		6.25						1		X								INSTALL 200 FEET WEST OF EXISTING REVERSE CURVE SIGN ASSEMBLY.	X				
		F	W13-1P	18	18	FY		2.25																	X				
WB	7.736	F	M3-4	24	12		WEST						1		X														
		F	M1-5	24	24		VERMONT ROUTE 9						1																
WB	7.700	F	S3-1	30	30		SCHOOL BUS STOP AHEAD						1		X														
		F	S3-1	36	36			9.00						2		X								CUT BRUSH IN ADVANCE OF SIGN.	X	TRIM BRUSH			
<b>SIGN SUMMARY SHEET</b>							<b>SHEET TOTALS</b>	39.00	0.00	0	<del>4</del> 2	<del>4</del> 2	<del>8</del> 9	0	0	6	90	0	0.0	0.0	0.0	0.0		PROJECT NAME: <b>WOODFORD-MARLBORO</b>					
								SF	SF	EA	EA	EA	EA	EA	EA	EA	FT	EA	LB	LB	LB	LB		PROJECT NUMBER: <b>STPG SIGN(35)</b>					
VERMONT AGENCY OF TRANSPORTATION							<b>TOWN DIRECTIONAL TOTALS</b>	607.1	0.0	23.0	1.0	1.0	117	0.0	0.0	70	1050.0	0		0.0				FILE NAME: <b>10B336</b>					
																							PLOT DATE: <b>4/10/2012</b>						
																							PROJECT MANAGER: <b>A. GAMBLE</b>						
																						DESIGNED BY: <b>J. KELLY</b>							
																						MARLBORO WB SHEET 2							
																						CHECKED BY: <b>A. GAMBLE</b>							
																						SHEET <b>65</b> OF <b>80</b>							