

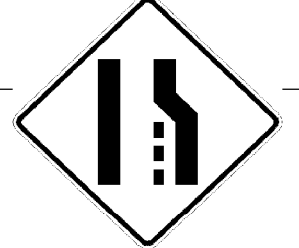

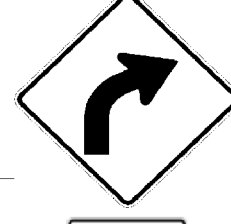



DIRECTION	MILEPOINT	LOCATION CODE (SHEET 2)	SIGN CODE	WIDTH (IN)	HEIGHT (IN)	SHEETING REMARKS	SIGN LEGEND	NEW SIGNS		EXISTING SIGNS				EXIST POST		NUMBER OF NEW POSTS	SQUARE STEEL (IN)			TUBULAR STEEL Ø (IN)				SIGN FRAME REQUIRED	REMARKS	SIGN DETAIL LOCATION					
								"A"	"B"	RETAIN	SALVAGE FROM	SALVAGE TO	REMOVE	RETAIN	REMOVE		1.75	2.00	2.50	FOUNDATION	3.0	3.50	4.00			5.00	SHSM	PROJECT SHEET #	STANDARD SHEET #		
																	(LB / FT)				(LB / FT)										
MARLBORO WB							FY-FLUORESCENT YELLOW FYG-FLUORESCENT YELLOW GREEN																"SHSM"-STANDARD HIGHWAY SIGNS AND MARKINGS								
		F	VD1-1	72	20			10.00							2		X									6					
WB	3.337	F	R4-3	24	30		SLOWER TRAFFIC KEEP RIGHT						1			X															
WB	3.324	F	W9-1R	36	36			9.00							2		X							INSTALL 300 FEET WEST ^{EAST} OF EXISTING MERGE SYMBOL SIGN.	X		INSTALL EAST				
WB	3.267	F	W4-2R	36	36								1			X								RETAIN POST							
		F	W4-2R	36	36			9.00																	X						
WB	3.141	F	VR-186	24	30		TRUCK LANE ENDS						1			X															
WB	2.905	F	VW-054R	30	30		HIDDEN DRIVES RIGHT						1			X															
WB	2.840	F	W2-1R	30	30		RIGHT CURVE						1			X															
		F	VW-054R	30	30			6.25							1		X									TRIM BRUSH	8				
WB	2.774	F	VR-023B	24	30		\$500 FINE FOR THROWING TRASH						1			X															
WB	2.714	F	W1-2R	30	30								1			X															
		F	W13-1P	18	18								1																		
		F	W1-2R	30	30			6.25							1		X								X		PUT OLD SIGNS ON NEW POST. CHANGED ON 9-7-12				
		F	W13-1P	18	18			2.25																		X					
WB	2.618	F	M3-4	24	12		WEST						1			X															
SIGN SUMMARY SHEET							SHEET TOTALS	42.75	0.00	0	0	0	9	0	0	6		90	0	0.0	0.0	0.0	0.0		PROJECT NAME: WOODFORD-MARLBORO						
								SF	SF	EA	EA	EA	EA	EA	EA	EA	FT	EA	LB	LB	LB	LB		PROJECT NUMBER: STPG SIGN(35)							
							TOWN DIRECTIONAL TOTALS	607.1	0.0	23.0	1.0	1.0	117	0.0	0.0	70		1050.0	0			0.0				FILE NAME: 10B336					
VERMONT AGENCY OF TRANSPORTATION																									PLOT DATE: 4/10/2012						
																									PROJECT MANAGER: A. GAMBLE						
																									DRAWN BY: J. KELLY						
																									DESIGNED BY: J. KELLY						
																									CHECKED BY: A. GAMBLE						
																									MARLBORO WB SHEET 11						
																									SHEET 74 OF 80						