



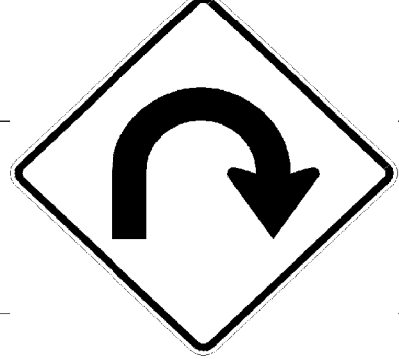



DIRECTION	MILEPOINT	LOCATION CODE (SHEET 2)	SIGN CODE	WIDTH (IN)	HEIGHT (IN)	SHEETING REMARKS	SIGN LEGEND	NEW SIGNS		EXISTING SIGNS				EXIST POST		NUMBER OF NEW POSTS	SQUARE STEEL (IN)			TUBULAR STEEL Ø (IN)				SIGN FRAME REQUIRED	REMARKS	SIGN DETAIL LOCATION			
								"A"	"B"	RETAIN	SALVAGE FROM	SALVAGE TO	REMOVE	RETAIN	REMOVE		1.75	2.00	2.50	FOUNDATION	3.0	3.50	4.00			5.00	SHSM	PROJECT SHEET #	STANDARD SHEET #
																	(LB / FT)				(LB / FT)								
<b>MARLBORO WB</b>							FY-FLUORESCENT YELLOW FYG-FLUORESCENT YELLOW GREEN																"SHSM"-STANDARD HIGHWAY SIGNS AND MARKINGS						
WB	0.917	F	W1-2L	30	30		LEFT CURVE																						
WB	0.875	F	W11-2	48	48		PEDESTRIAN																						
		F	VW-205	36	36																							8	
WB	0.842	F	VW-205	36	36		WATCH FOR TURNING VEHICLES																						MISSING
WB	0.809	F	D6-3M	30	30		SCENIC OVERLOOK AHEAD																						
		A	D5-2L	42	48																							9	
WB	0.778	F	W11A-2	48	48		PEDESTRIAN CROSSWALK																						
		F	W16-4	24	18																								
		F	W11-2	48	48	FYG																						X	
		F	W16-4	30	24	FYG																						X	
WB	0.716	F	VW-537R	48	48																								
		F	W13-1	24	24																								MOVED 145' EAST
		F	W1-11R	36	36	FY																						X	SLIP BASES
		F	W13-1	24	24	FY																						X	TRIM BRUSH
WB	0.601	F	VR-020	24	30		NO PARKING ON TRAVELED LANES																						
<b>SIGN SUMMARY SHEET</b>							SHEET TOTALS	57.00	0.00	0	0	0	9	0	0	6	90	0	0.0	0.0	0.0	0.0	0.0	PROJECT NAME: WOODFORD-MARLBORO PROJECT NUMBER: STPG SIGN(35)					
VERMONT AGENCY OF TRANSPORTATION							TOWN DIRECTIONAL TOTALS	607.1	0.0	23.0	1.0	1.0	117	0.0	0.0	70	1050.0	0			0.0			FILE NAME: 10B336 PROJECT MANAGER: A. GAMBLE DESIGNED BY: J. KELLY MARLBORO WB SHEET 15					
																							PLOT DATE: 4/10/2012 DRAWN BY: J. KELLY CHECKED BY: A. GAMBLE SHEET 78 OF 80						