


STATE OF VERMONT AGENCY OF TRANSPORTATION

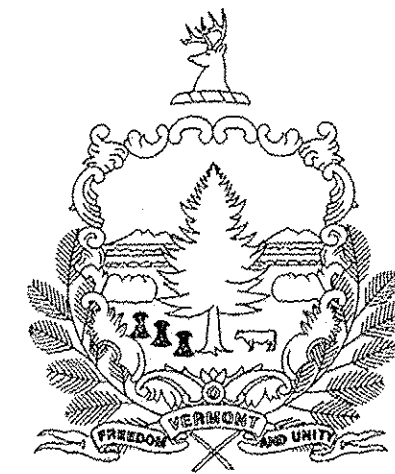


PROPOSED IMPROVEMENT TOWNS OF WOODFORD, SEARSBURG, WILMINGTON AND MARLBORO COUNTIES OF BENNINGTON AND WINDHAM VERMONT ROUTE 9 (PRINCIPAL ARTERIAL - NHS)

SOUTHERN REGION SIGN REPLACEMENT - 30.577 MILES:
WOODFORD MP 0.000-9.575, SEARSBURG MP 0.000-5.538,
WILMINGTON MP 0.000-7.160, MARLBORO MP 0.000-8.304

LENGTH OF ROADWAY = 30.577 MILES
LENGTH OF PROJECT = 30.577 MILES

WORK TO BE PERFORMED UNDER THIS PROJECT INCLUDES THE REMOVAL OF EXISTING SIGNS AND POSTS
AND THE INSTALLATION OF NEW SIGNS, SIGN POSTS AND OTHER RELATED HIGHWAY ITEMS.

INDEX OF SHEETS AND STANDARDS
SEE SHEET 2

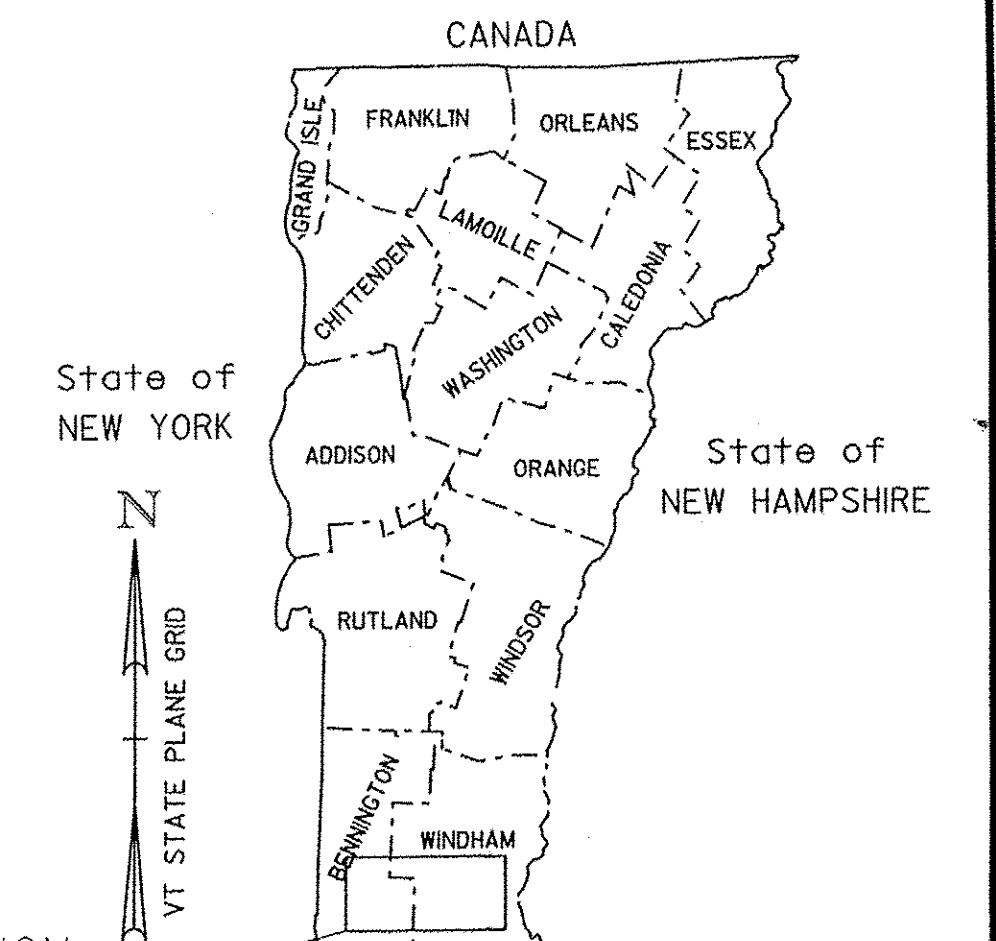


PROJECT LOCATION
WOODFORD-MARLBORO
STPG SIGN(35)
Commonwealth of MASSACHUSETTS
NOT TO SCALE

RECORD PLANS	
CONTRACTOR:	EMI GUIDE RAUL, LLC - SCHENECTADY, NY
RESIDENT ENGINEER:	FRED ROSS
CONSTRUCTION BEGAN:	AUGUST 13, 2012
CONSTRUCTION COMPLETE:	OCTOBER 12, 2012
RECORD PLANS BY:	FRED ROSS & JENNA HYDE
I HEREBY CERTIFY THAT ALL THE CONSTRUCTION REQUIRED BY THIS SET OF DRAWINGS HAS BEEN ACCOMPLISHED AS INDICATED HEREIN.	
BY:	<i>[Signature]</i> RESIDENT ENGINEER
DATE:	1-4-13
NOTE: Any further information concerning final quantities, amounts or other details relative to this project may be found at Central Files in the electronic archives.	

QUALITY ASSURANCE PROGRAM: LEVEL 3

CONVENTIONAL SYMBOLS	
COUNTY LINE	
TOWN LINE	
LIMITS OF ACCESS	
POINT OF ACCESS	
FENCE LINE	
STONE WALL	
TRAVELED WAY	
GUARD RAIL	
RAILROAD	
SURVEY LINE	
CULVERT	
POWER POLE	
TELEPHONE POLE	
TREES	
CONTROL OF ACCESS	
PROPERTY LINE	
R.O.W. TAKING LINE	
SLOPE RIGHTS	
TOP OF CUT	
TOE OF SLOPE	

SURVEYED BY :	N/A
SURVEYED DATE :	N/A
DATUM	
VERTICAL	N/A
HORIZONTAL	N/A

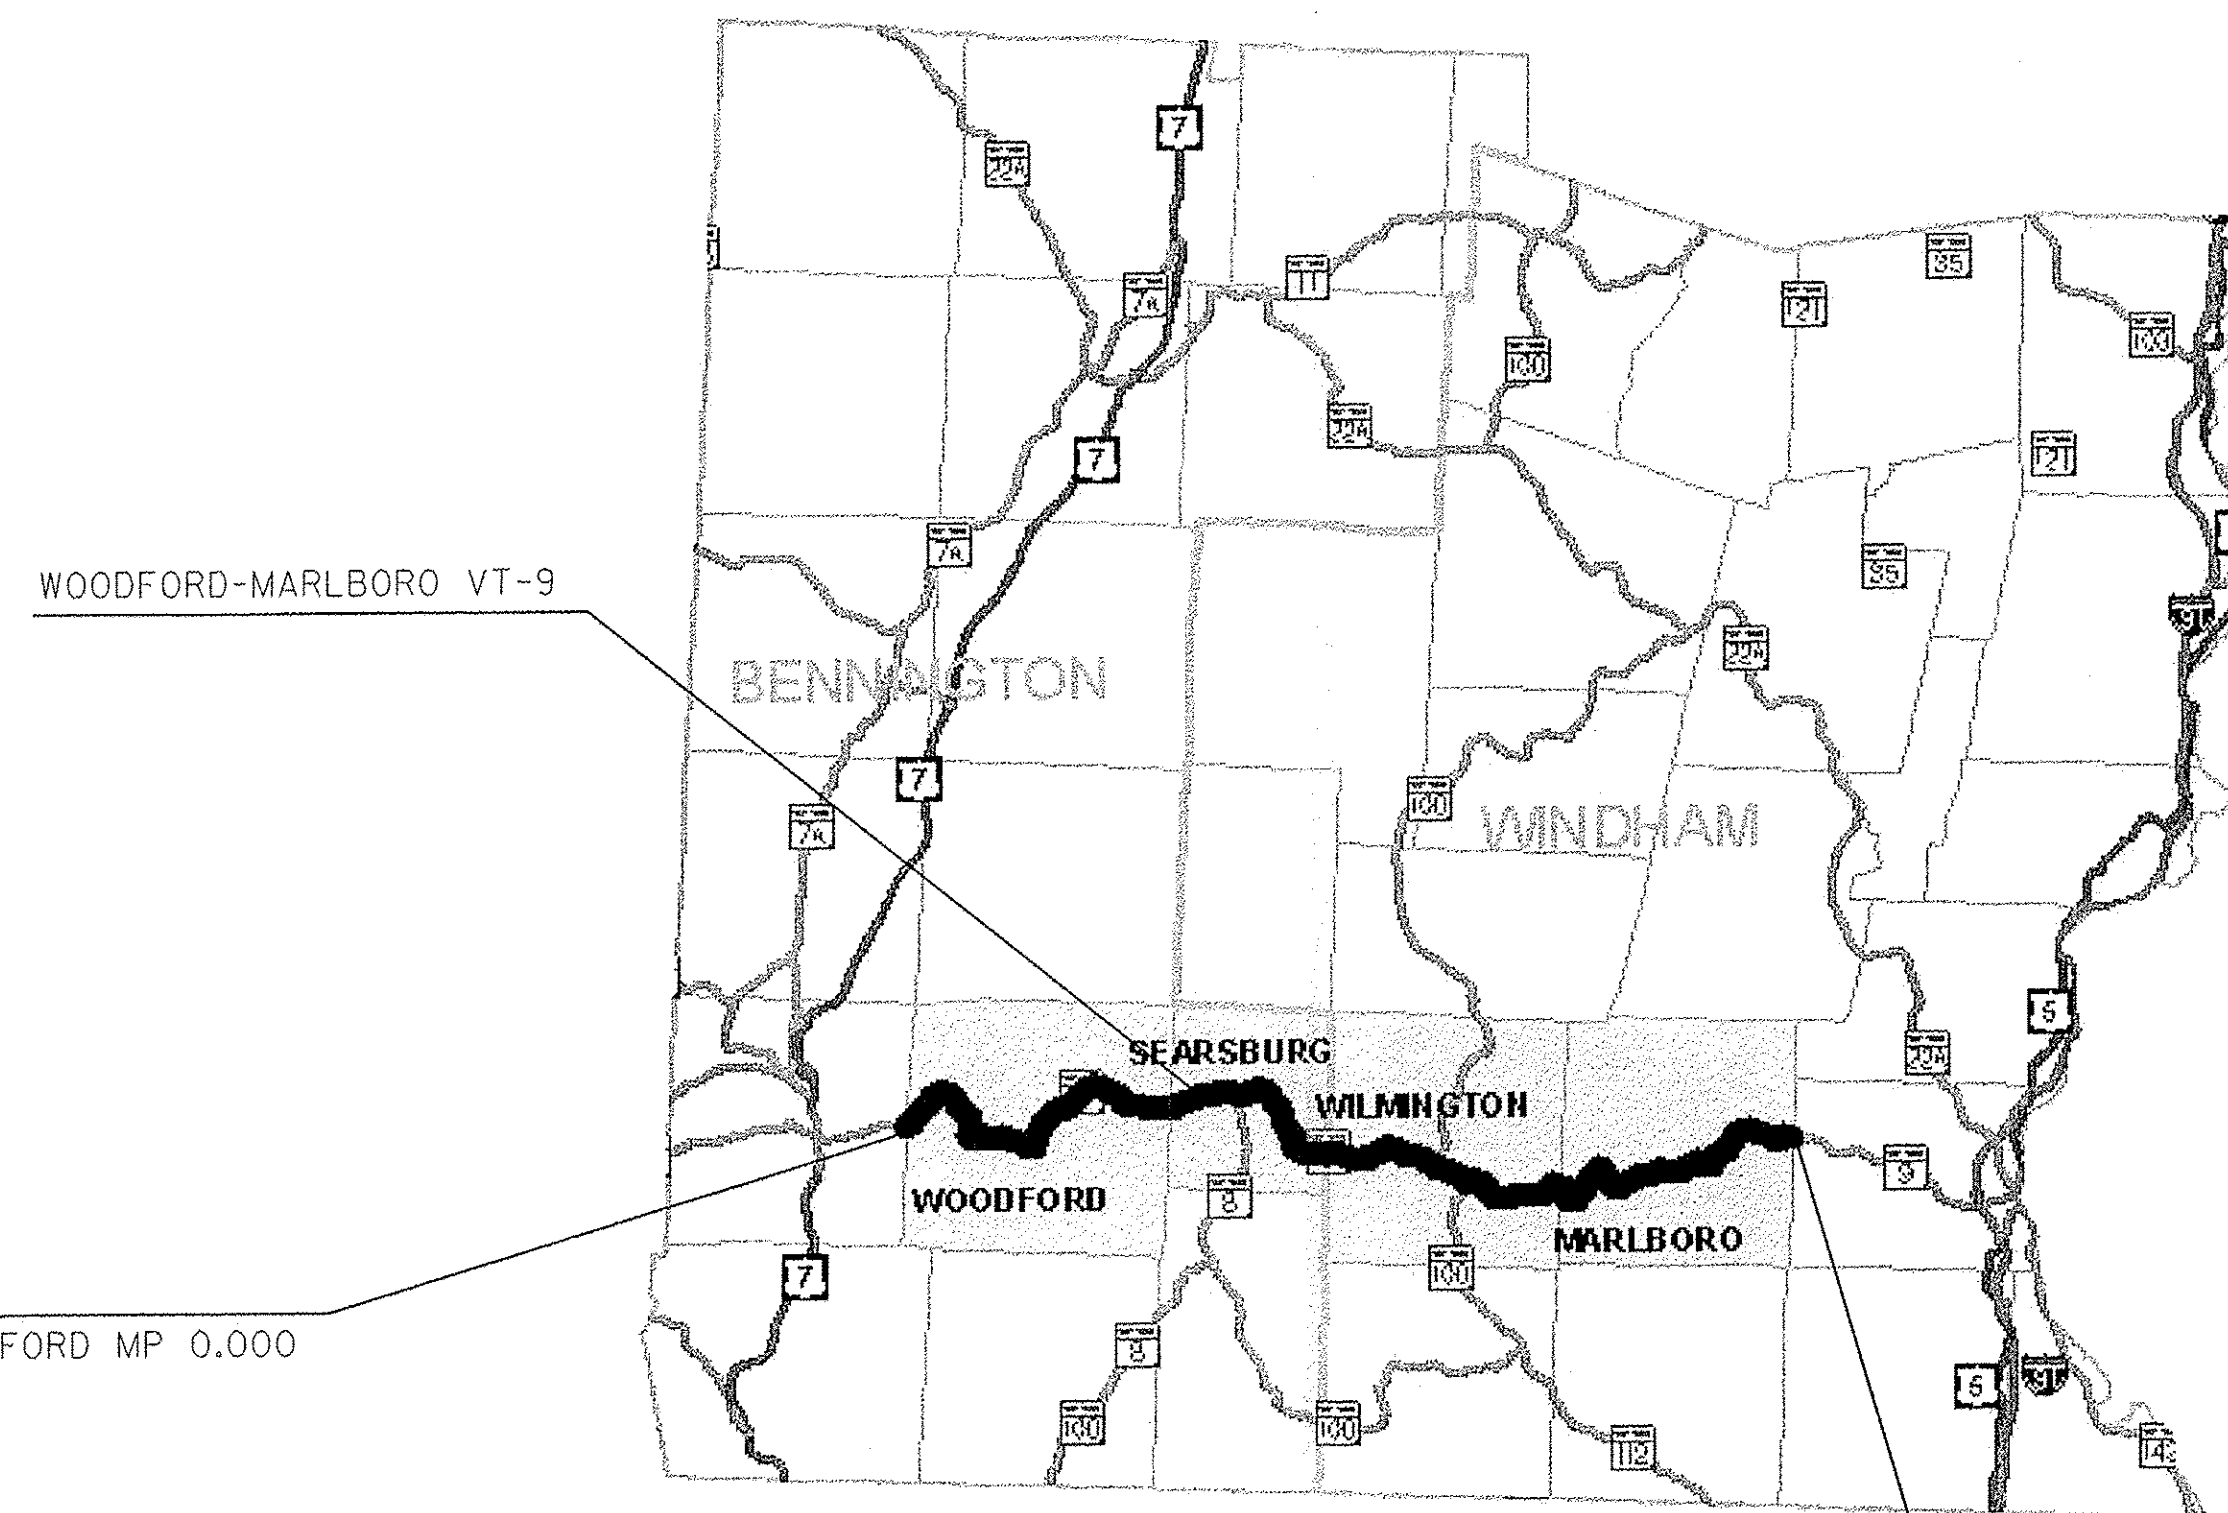

BEGIN
WOODFORD MP 0.000

END
MARLBORO MP 8.304

NOT TO SCALE

THESE PLANS ARE SUBJECT TO SUCH ENGINEERING CHANGES AS MAY BE REQUIRED BY THE FEDERAL HIGHWAY ADMINISTRATION OR THE DIRECTOR OF PROGRAM DEVELOPMENT.
CONSTRUCTION IS TO BE CARRIED ON IN ACCORDANCE WITH THESE PLANS AND THE STANDARD SPECIFICATIONS FOR CONSTRUCTION DATED 2011, AS APPROVED BY THE FEDERAL HIGHWAY ADMINISTRATION ON JULY 20, 2011 FOR USE ON THIS PROJECT, INCLUDING ALL SUBSEQUENT REVISIONS AND SUCH REVISED SPECIFICATIONS AND SPECIAL PROVISIONS AS ARE INCORPORATED IN THESE PLANS.

DIRECTOR OF PROGRAM DEVELOPMENT	
APPROVED <i>[Signature]</i>	DATE 4/12/12
PROJECT MANAGER :	AMY GAMBLE
PROJECT NAME :	WOODFORD-MARLBORO
PROJECT NUMBER :	STPG SIGN (35)
SHEET 1	OF 80 SHEETS

INDEX SHEETS

1	TITLE SHEET
2	GENERAL NOTES
3	QUANTITY SHEET I
4	TOWN/COUNTY LINE SIGN DETAILS
5-9	SIGN DETAILS I-5
10-20	WOODFORD EB VT-9 TRAFFIC SIGN SUMMARY SHEETS I-II
21-29	WOODFORD WB VT-9 TRAFFIC SIGN SUMMARY SHEETS I-9
30-36	SEARSBURG EB VT-9 TRAFFIC SIGN SUMMARY SHEETS I-7
37-41	SEARSBURG WB VT-9 TRAFFIC SIGN SUMMARY SHEETS I-5
42-43	WILMINGTON EB VT-9 TRAFFIC SIGN SUMMARY SHEETS I-2
44-45	WILMINGTON WB VT-9 TRAFFIC SIGN SUMMARY SHEETS I-2
46-63	MARLBORO EB VT-9 TRAFFIC SIGN SUMMARY SHEETS I-18
64-79	MARLBORO WB VT-9 TRAFFIC SIGN SUMMARY SHEETS I-16
80	TOWN TOTAL SIGN SUMMARY SHEET

STANDARDS

E-121	STANDARD SIGN PLACEMENT CONVENTIONAL ROAD	08/08/1995
E-136B	STATE ROUTE MARKER SIGN DETAILS	08/08/1995
E-138	MILE MARKER DETAILS STATE AND TOWN HIGHWAYS	05/30/2003
E-164	SQUARE STEEL SIGN POST	06/08/2009

2-1/2" SOIL BEARING SLIP BASE LOCATIONS:

TOWN:	DIRECTION:	MILE POINT:	NO. REQ:	SHEETS:
SEARSBURG	EB	1.743	2	31
SEARSBURG	EB	1.812	2	31
SEARSBURG	EB	1.918	2	32
SEARSBURG	WB	1.874	2	39
SEARSBURG	WB	1.837	2	39
MARLBORO	EB	0.477	2	47
MARLBORO	EB	7.636	2	61
MARLBORO	WB	7.945	2	64
MARLBORO	WB	0.716	2	78

- THE LOCATIONS SHOWN IN THE TABLE ABOVE WILL REQUIRE THAT EACH 2-1/2" SQUARE STEEL SIGN POST, AS SPECIFIED ON THE APPLICABLE SIGN SUMMARY SHEET, BE INSTALLED USING A SOIL BEARING SLIP BASE WITH ANCHOR SLEEVE. AT THESE SPECIFIED LOCATIONS THE 2-1/2" POSTS ARE NOT PROTECTED BY GUARD RAIL OR CURBING, THUS REQUIRING THE USE OF SOIL BEARING SLIP BASES FOR THIS SIZE POST.
- PAYMENT FOR SOIL BEARING SLIP BASE (EACH) WILL BE MADE UNDER CONTRACT ITEM 900.620, SPECIAL PROVISION, SOIL BEARING SLIP BASE, 2-1/2".

GENERAL NOTES

SIGN DESIGN AND FABRICATION

- THE MUTCD SIGN CODES PROVIDED IN THESE PLANS REFER TO THE 2009 MUTCD. DESIGN DETAILS FOR SIGNS INDICATED ON THE PLANS AS FOUND IN THE STANDARD HIGHWAY SIGNS AND MARKINGS BOOK (SHSM), SHALL BE PER 2009 SHSM, WHICH AT THIS TIME HAS NOT YET BEEN RELEASED. TO ADVANCE THE AVAILABILITY OF NEW INFORMATION FOR FIELD INSTALLATIONS AS SOON AS POSSIBLE, INTERIM RELEASES ARE PLANNED FOR ITEMS THAT ARE NEW OR SIGNIFICANTLY REVISED BY THE 2009 MUTCD; THEY CAN BE FOUND AT: http://mutcd.fhwa.dot.gov/shsm_interim/index.htm. THE CONTRACTOR SHALL CONTACT THE ENGINEER FOR SIGN DETAILS IF NONE ARE AVAILABLE FROM THESE SOURCES.
- SIGN SHEETING FOR FLUORESCENT YELLOW (FY) AND FLUORESCENT YELLOW-GREEN (FYG) SHALL BE ASTM D4956 TYPE VII, VIII OR IX. ALL OTHER SIGN SHEETING SHALL BE TYPE III OR IV.
- SHEETING TYPES AND SHEETING FABRICATED BY DIFFERENT MANUFACTURERS SHALL NOT BE MIXED ON A SINGLE SIGN ASSEMBLY. SHEETING COLOR/TYPE SHOULD BE BY THE SAME MANUFACTURER AND SHOULD BE CONSISTENT THROUGHOUT THE PROJECT.
- SIGN BASE MATERIAL FOR DELINEATORS AND MILE MARKER PLAQUES (VD-700) SHALL BE 0.063" THICK FLAT SHEET ALUMINUM. UNLESS OTHERWISE NOTED ON THE PLANS, ALL OTHER SIGNS SHALL BE FLAT SHEET ALUMINUM WITH THE FOLLOWING MINIMUM THICKNESSES:

SIGN SIZE	9" X 12"		
	12" X 12"		
18" X 18"			
21" X 15"			
24" X 10"			48" X 18"
24" X 12"	36" X 12"	48" X 24"	
24" X 18"	36" X 15"	48" X 30"	
24" X 24"	36" X 18"	48" X 42"	
24" X 30"	36" X 24"	48" X 48"	
30" X 15"	30" X 42"	48" X 60"	
30" X 18"	36" X 36"	72" X 10"	
30" X 30"	36" X 48"	72" X 12"	
30" X 42"	36" X 54"	72" X 20"	
THICKNESS	0.080"	0.100"	0.125"

SIGN POSTS


- ALL SQUARE STEEL SIGN POSTS SHALL BE INSTALLED IN A NEW ANCHOR. ALL SIGNS INSTALLED IN PAVED OR CONCRETE ISLANDS OR SIDEWALKS SHALL ALSO BE INSTALLED WITH AN 18" SLEEVE. PAYMENT FOR SLEEVE SHALL BE INCIDENTAL TO THE SIGN POST CONTRACT ITEM.
- 1.75" SQUARE STEEL POSTS SHALL BE 14 GAUGE STEEL. 2" AND 2.5" SQUARE STEEL POSTS SHALL BE 12 GAUGE STEEL.

SIGN INSTALLATION

- THE CONTRACTOR SHALL BE RESPONSIBLE FOR REPAIRING ANY DAMAGE TO PRIVATE OR PUBLIC PROPERTY CAUSED BY THE CONTRACTOR, AT CONTRACTOR'S EXPENSE.
- SIGN LOCATIONS AS SHOWN ON THE PLANS ARE APPROXIMATE. EXACT LOCATIONS TO BE DETERMINED IN THE FIELD AND APPROVED BY THE ENGINEER.
- ALL SIGN PLACEMENT SHALL BE IN CONFORMANCE WITH VAOT STANDARD E-121 STANDARD SIGN PLACEMENT CONVENTIONAL ROAD, UNLESS OTHERWISE NOTED.
- ALL SIGNS, FRAMES, MOUNTING HARDWARE, POSTS, AND ANCHORS FOR ANY SIGN ASSEMBLY SHALL BE REPLACED AT THE SAME TIME. MIXING OF OLD AND NEW SIGNS ON THE SAME ASSEMBLY WILL NOT BE ALLOWED. ALL NEW OR SALVAGED SIGNS SHALL BE INSTALLED WITH NEW ASSEMBLY HARDWARE MEETING SUBSECTION 750.12 ASSEMBLY HARDWARE.
- NEW SIGNS WITH THEIR GREATER NIGHTTIME RETROREFLECTIVITY CAN OBSCURE OLDER SIGNS MOUNTED IN CLOSE PROXIMITY TO THEM. TO AVOID CONFUSION OF ROAD USERS, WORK SHALL BE COORDINATED SUCH THAT ALL SIGNS ASSOCIATED WITH A CURVE, INTERSECTION, OR SPEED CHANGES, SHALL BE REPLACED ON THE SAME DAY AND NOT LEFT INCOMPLETE NOR WITH A MIXTURE OF OLD AND NEW SIGNS WITHIN A GROUP OF ASSOCIATED SIGNS. AT NO TIME SHALL A SIGN ASSEMBLY BE REMOVED WITHOUT IMMEDIATELY INSTALLING THE REPLACEMENT SIGN ASSEMBLY UNLESS OTHERWISE SHOWN ON THE PLANS.
- ALL NEW SIGN INSTALLATIONS SHALL BE NO CLOSER THAN 10 FEET FROM UTILITY POLES.

TEMPORARY TRAFFIC CONTROL NOTES

- THE CONTRACTOR SHALL SUBMIT SITE SPECIFIC TRAFFIC CONTROL PLANS CONFORMING TO THE MANUAL ON UNIFORM TRAFFIC CONTROL DEVICES (MUTCD), DATED 2009, AND ITS LATEST REVISIONS, AT THE PRE-CONSTRUCTION MEETING FOR REVIEW AND APPROVAL BY THE ENGINEER.
- WHEN WORKING IN THE VICINITY OF EXISTING PEDESTRIAN FACILITIES, ADA ACCESSIBLE PEDESTRIAN ACCOMMODATIONS SHALL BE MAINTAINED AT ALL TIMES. PAYMENT SHALL BE INCLUDED IN THE UNIT BID PRICE FOR CONTRACT ITEM 641.0 TRAFFIC CONTROL.
- THE CONTRACTOR SHALL PROVIDE ACCESS THROUGH THE WORK ZONE FOR EMERGENCY VEHICLES AT ALL TIMES.
- THE CONTRACTOR SHALL CONDUCT THE WORK AT ALL TIMES IN SUCH A MANNER AND IN SUCH SEQUENCE SO AS TO ENSURE THE LEAST INTERFERENCE WITH TRAFFIC OCCURS.
- SIGNS SHALL ONLY BE VISIBLE TO MOTORISTS AT THE TIMES WHEN THE MESSAGE IS PERTINENT. I.E. A "FLAGGER AHEAD" SIGN SHALL ONLY BE VISIBLE TO MOTORISTS WHEN THE FLAGGER IS ACTUALLY PRESENT PERFORMING THEIR DUTIES.
- PAYMENT FOR CONSTRUCTION SIGNING WILL BE MADE UNDER CONTRACT ITEM 641.0.
- SIGNS SHALL BE MOVED AS WORK AREA MOVES. AT NO TIME SHALL THE FLAGGER SIGN BE GREATER THAN 750 FEET IN ADVANCE OF THE FLAGGER STATION.

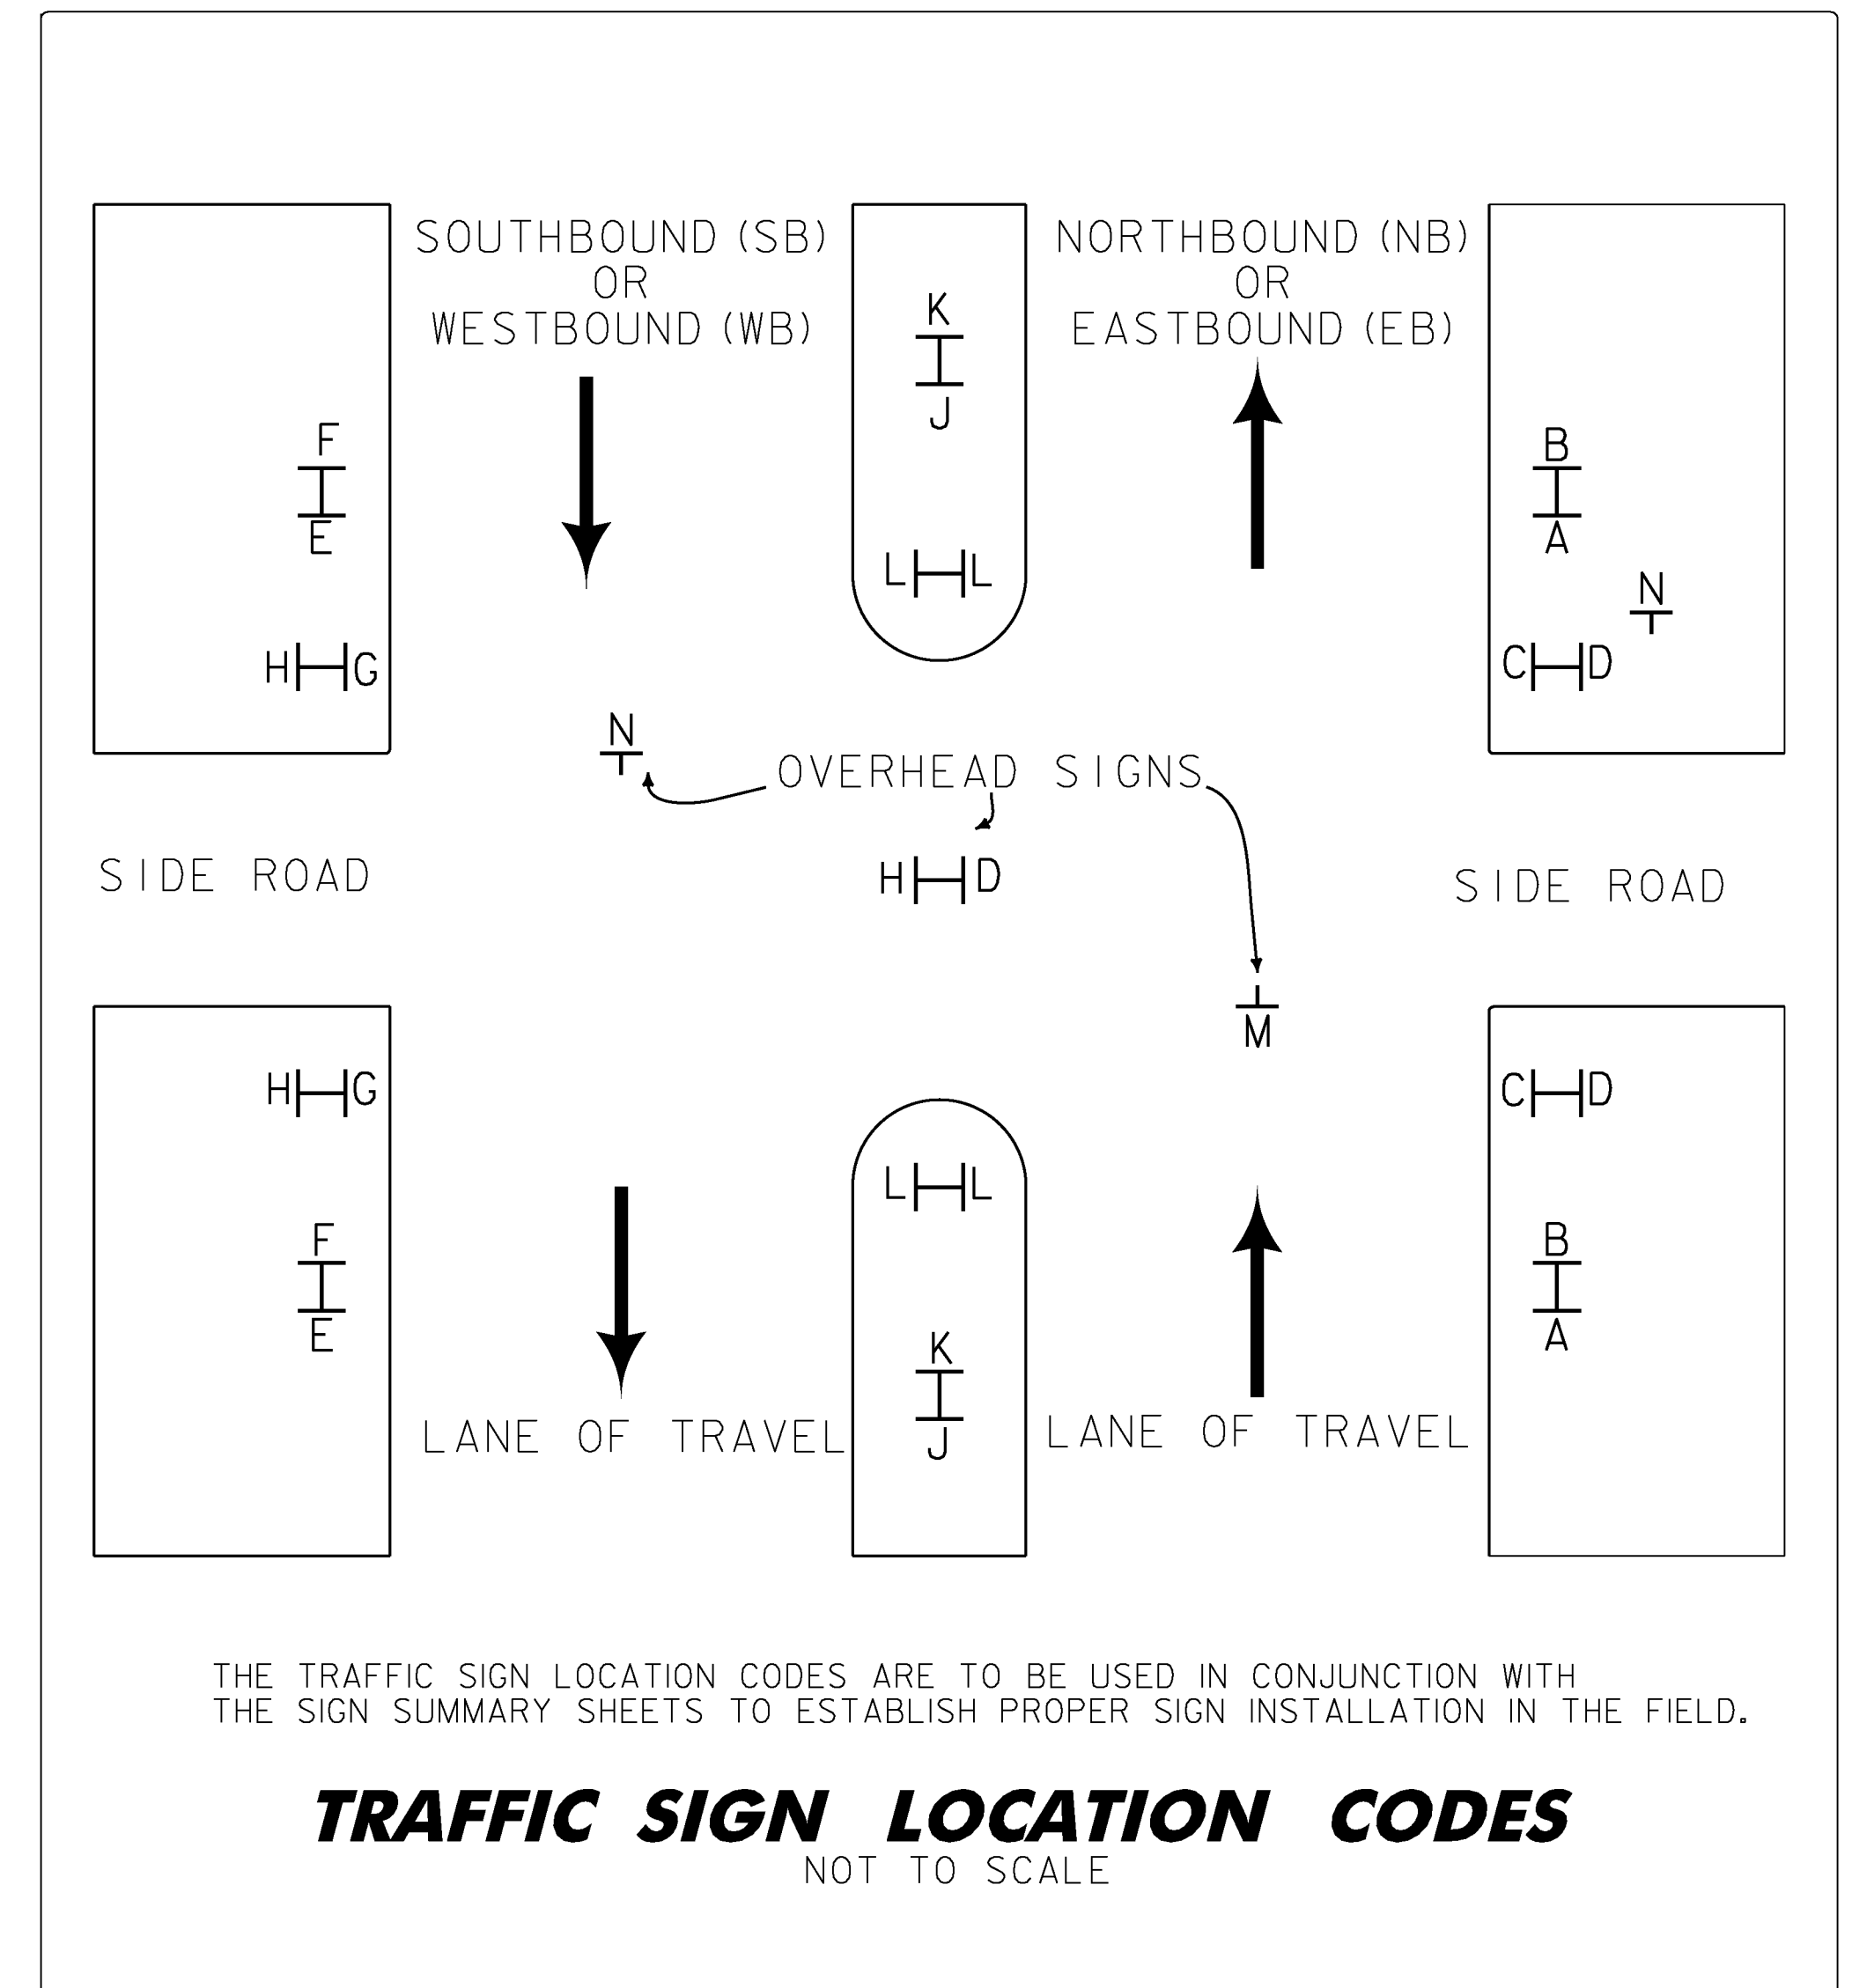

GENERAL NOTES


- EXISTING STAND ALONE MILE MARKERS OR MILE MARKERS ATTACHED TO A RETAINED SIGN POST ASSEMBLY SHALL BE RETAINED.
- EXISTING MILE MARKERS ON SIGN POSTS BEING REPLACED SHALL BE REMOVED AND SALVAGED ONTO THE NEW SIGN POST.
- EXISTING MILE MARKERS ATTACHED TO A SIGN ASSEMBLY THAT IS TO BE RELOCATED SHALL BE REMOVED, SALVAGED AND REINSTALLED ONTO A NEW DELINEATOR POST (1.75" SQUARE STEEL) UNLESS OTHERWISE DIRECTED BY THE ENGINEER.
- EXISTING STREET NAME SIGNS ATTACHED TO SIGN POSTS THAT ARE TO BE REPLACED SHALL BE REMOVED, SALVAGED AND INSTALLED AT THE TOP OF THE NEW POST.
- ALL EXISTING STREET NAME SIGNS INSTALLED ON STAND ALONE SIGN POSTS SHALL BE RETAINED UNLESS OTHERWISE NOTED.
- AN ESTIMATED QUANTITY FOR CONTRACT ITEMS 675.50 REMOVING SIGNS AND 675.60 ERECTING SALVAGED SIGNS HAS BEEN INCLUDED FOR MILE MARKERS AND STREET NAME SIGNS.
- SELECTIVE CUTTING OF BRUSH OR TREE BRANCHES IN THE IMMEDIATE VICINITY OF THE SIGN MAY BE NECESSARY TO PROVIDE FULL VISIBILITY FOR ANY EXISTING (RETAINED) OR NEW SIGN LOCATIONS. SIGNS SHALL BE COMPLETELY VISIBLE FOR 200 FEET BY APPROACHING MOTORISTS. THIS WORK WILL BE PERFORMED AT THE DIRECTION OF THE ENGINEER AND PAID FOR UNDER CONTRACT ITEM 201.31 THINNING AND TRIMMING FOR SIGNS. THIS WORK SHALL BE DONE AT THE SAME TIME THAT THE SIGNS ARE INSTALLED.

PROJECT NAME:	WOODFORD - MARLBORO
PROJECT NUMBER:	STPG SIGN (35)
FILE NAME:	10B336_TS.DGN
PROJECT LEADER:	A. GAMBLE
DESIGNED BY:	J. KELLY
GENERAL NOTES	PLOT DATE: 10-APR-2012 DRAWN BY: J. KELLY CHECKED BY: A. GAMBLE SHEET 2 OF 80


QUANTITY SHEET 1

SUMMARY OF ESTIMATED QUANTITIES										TOTALS			DESCRIPTIONS				DETAILED SUMMARY OF QUANTITIES		
									ROADWAY	GRAND TOTAL	FINAL	UNIT	ITEMS	ITEM NUMBER	ROUND	QUANTITIES	UNIT	ITEMS	
									20	20		EACH	THINNING AND TRIMMING FOR SIGNS	201.31	EST				
									1	1		CY	TRENCH EXCAVATION OF EARTH, EXPLORATORY (N.A.B.I.)	204.22					
									30	30		HR	UNIFORMED TRAFFIC OFFICERS	630.10	EST				
									500	500		HR	FLAGGERS	630.15	EST				
									1	1		LS	MOBILIZATION/DEMOBILIZATION	635.11					
									1	1		LS	TRAFFIC CONTROL	641.10					
									2134	2134		SF	TRAFFIC SIGNS, TYPE A	675.20	EST				
									4770	4770		LF	SQUARE TUBE SIGN POST AND ANCHOR	675.341					
									501	501		EACH	REMOVING SIGNS	675.50	EST				
									51	51		EACH	ERECTING SALVAGED SIGNS	675.60	EST				
									15	15		EACH	DELINEATOR WITH STEEL POST	676.10					
									18	18		EACH	SPECIAL PROVISION (SOIL BEARING SLIP BASE) (2 1/2")	900.620					


PROJECT NAME: WOODFORD - MARLBORO
 PROJECT NUMBER: STPG SIGN (35)
 FILE NAME: I0B336_TS.DGN
 PROJECT LEADER: A. GAMBLE
 DESIGNED BY: J. KELLY
 QUANTITY SHEET 1
 PLOT DATE: 17-APR-2012
 DRAWN BY: J. KELLY
 CHECKED BY: A. GAMBLE
 SHEET 3 OF 80

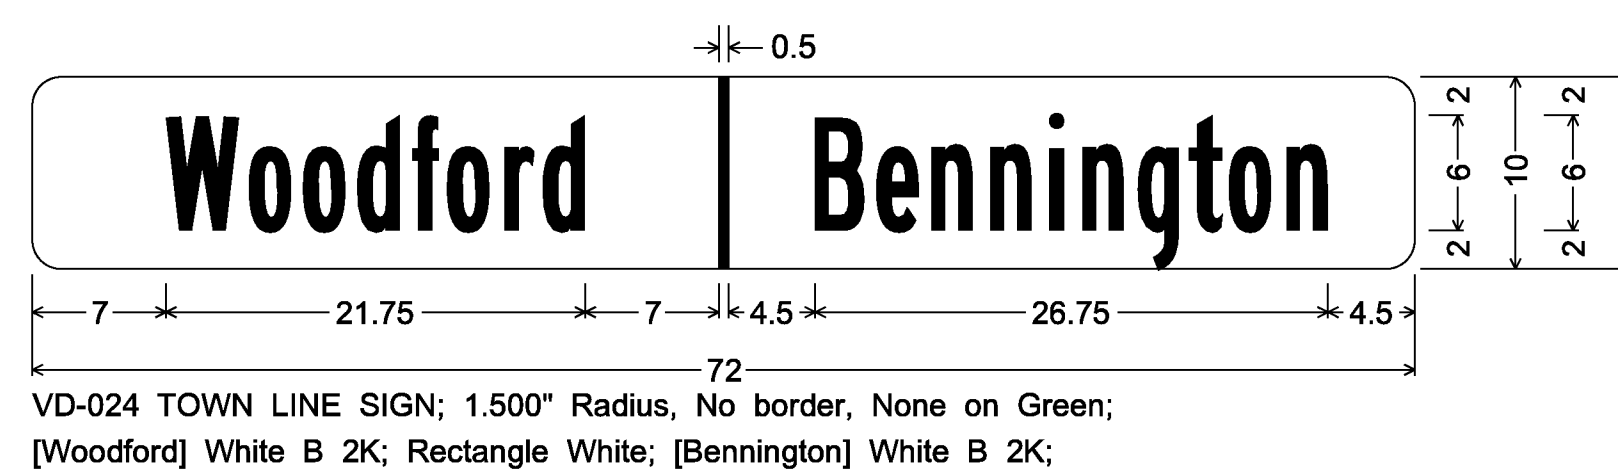


VD-024 TOWN LINE SIGN; 1.500" Radius, No border, None on Green; [Woodford] White B 2K; [Bennington] White B 2K;

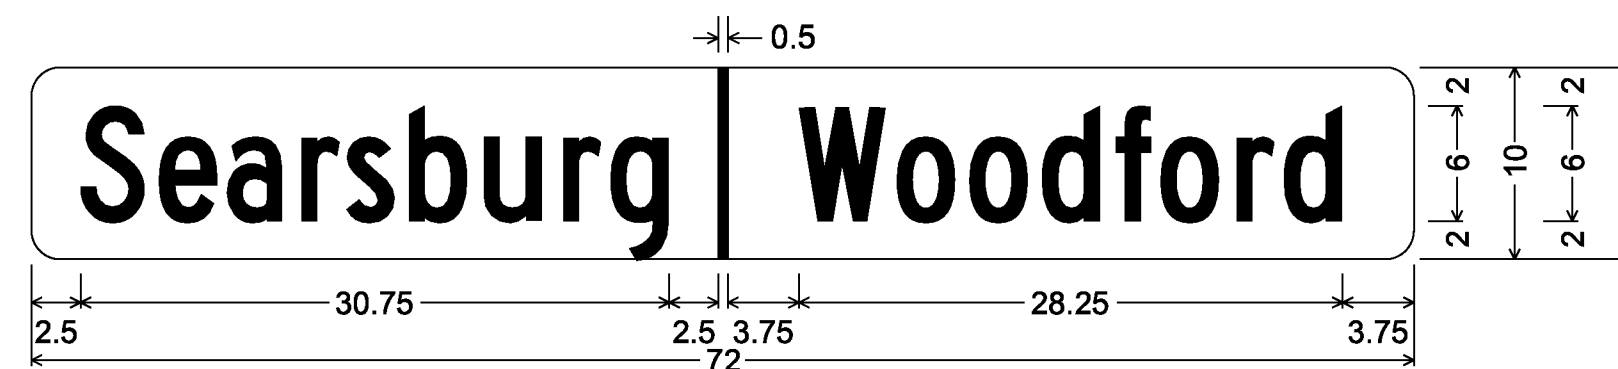

VD-024 TOWN LINE SIGN; 1.500" Radius, No border, None on Green; [Searsburg] White C 2K; [Woodford] White C 2K;

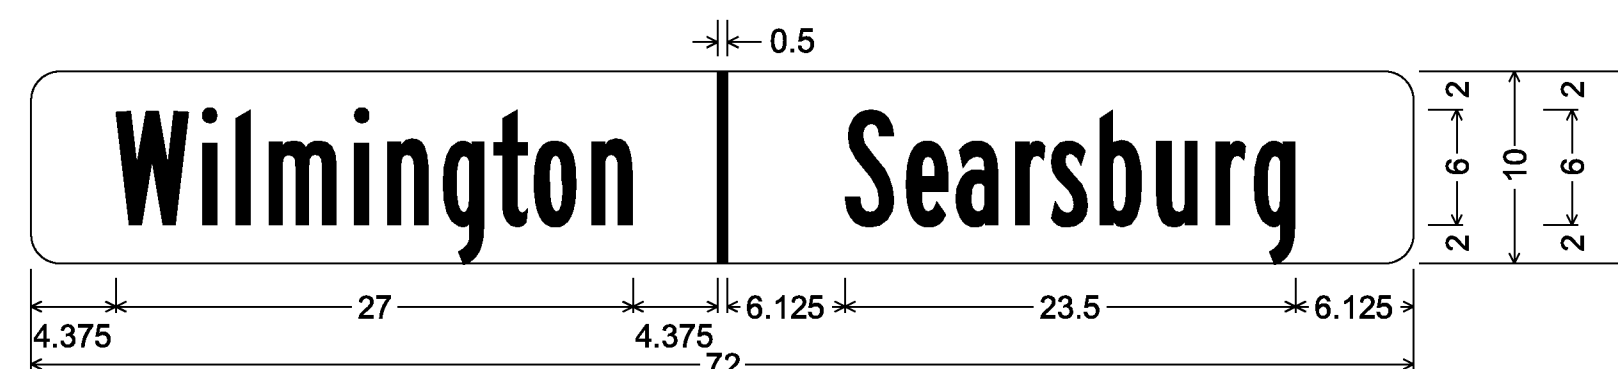


VD-024 TOWN LINE SIGN; 1.500" Radius, No border, None on Green; [Wilmington] White B 2K; [Searsburg] White B 2K;

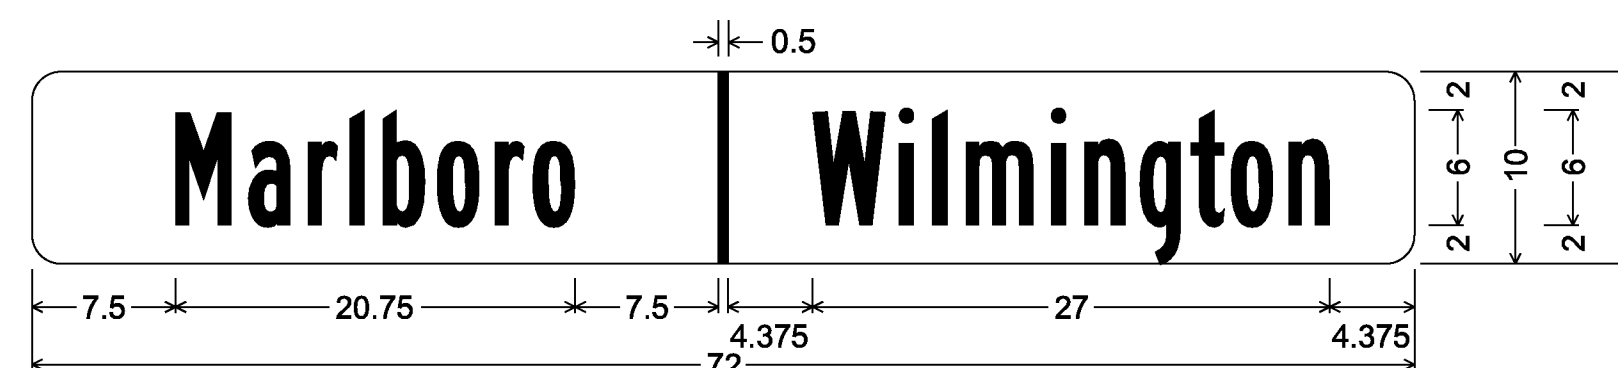


VD-024 TOWN LINE SIGN; 1.500" Radius, No border, None on Green; [Marlboro] White B 2K; [Wilmington] White B 2K;

VD-024

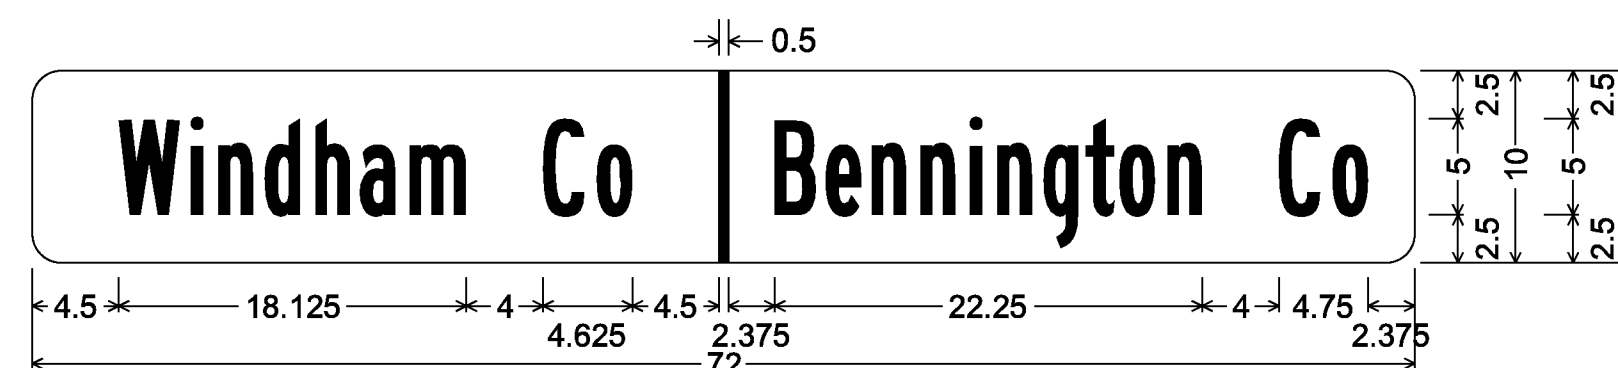

VD-025 COUNTY LINE SIGN; 1.500" Radius, No border, None on Green; [Windham Co] White B 2K; [Bennington Co] White B 2K;


VD-025

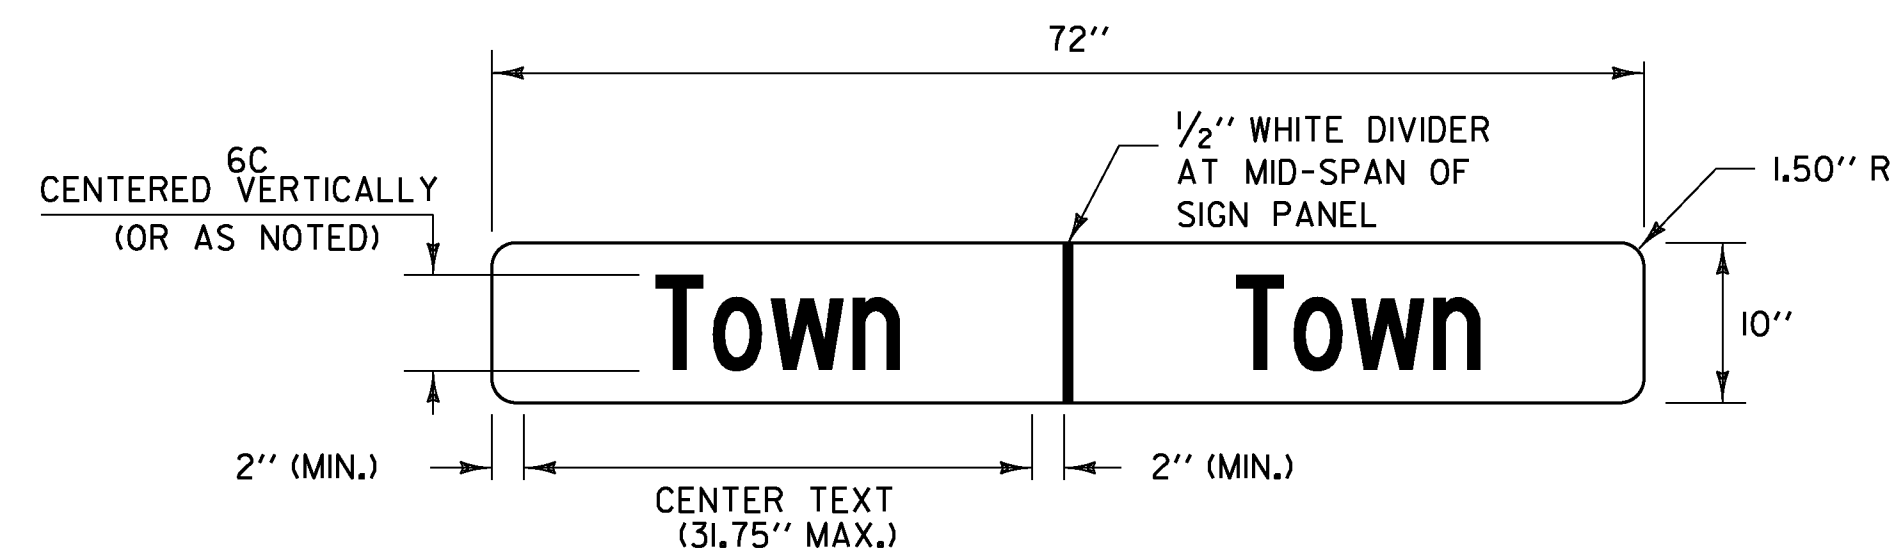


VD-024

TOWN/COUNTY LINE SIGN NOTES:

1. THE SIGN BASE MATERIAL SHALL BE SHEET ALUMINUM WITH A 0.125" MINIMUM THICKNESS.
2. THE RETROREFLECTIVE MATERIAL SHALL BE SHEETING APPLIED TO THE ENTIRE BACKGROUND OF THE SIGN. THE LEGEND SHALL BE CUT-OUT RETROREFLECTIVE LEGEND. ALL RETROREFLECTIVE MATERIAL SHALL BE EQUAL TO OR EXCEEDING THE "THE AMERICAN SOCIETY OF TESTING AND MATERIALS" (ASTM) TYPE III.
3. SIGNS SHALL HAVE A WHITE LEGEND ON A GREEN BACKGROUND.
4. LEGEND SHALL CONFORM WITH THE STANDARD ALPHABETS FOR HIGHWAY SIGNS APPROVED BY THE NATIONAL COMMITTEE ON UNIFORM TRAFFIC CONTROL DEVICES.
5. SIGNS SHALL BE FABRICATED IN UPPER/LOWER CASE TEXT AS SHOWN IN SIGN DETAIL. ALL TEXT ON AN INDIVIDUAL SIGN SHALL BE OF THE SAME SIZE AND FONT.
6. ALL DIMENSIONS IN INCHES UNLESS OTHERWISE NOTED.
7. WORD TO WORD SPACING FOR MULTIPLE TEXT TOWN/COUNTY NAMES IS ADJUSTABLE TO ACCOMMODATE DIMENSION REQUIREMENT.
8. DIMENSIONS SHOWN ARE APPROXIMATE AND MAY BE ADJUSTED SLIGHTLY TO ACCOMMODATE VARIOUS MANUFACTURER'S LETTER WIDTHS.

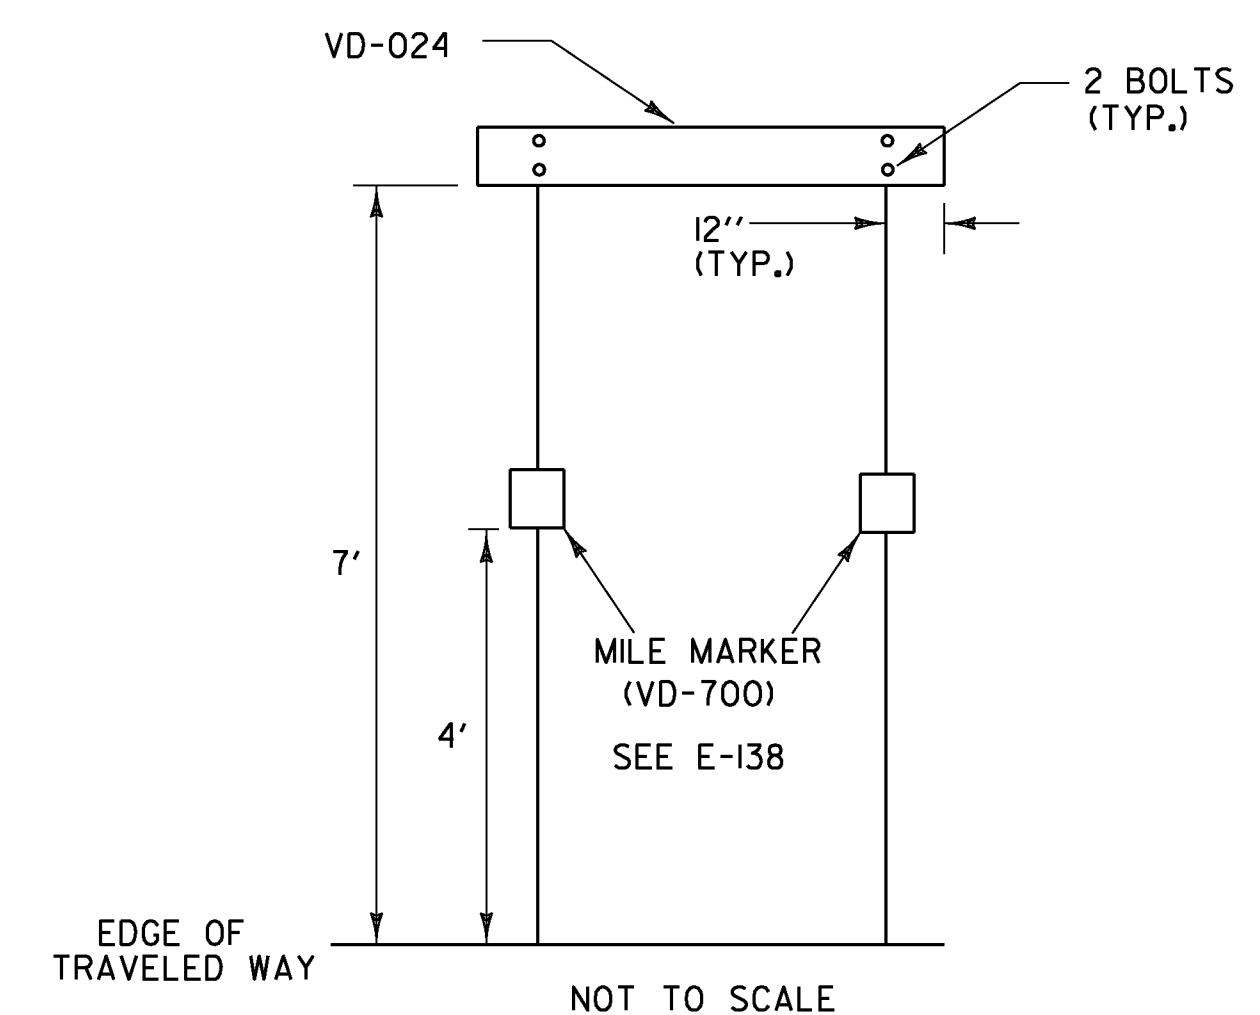

WHEN CROSSING COUNTY BOUNDARIES, AN ADDITIONAL COUNTY LINE SIGN (VD-025) SHALL BE MOUNTED BELOW THE TOWN LINE SIGN (VD-024), MAINTAINING A SEVEN FOOT CLEARANCE.

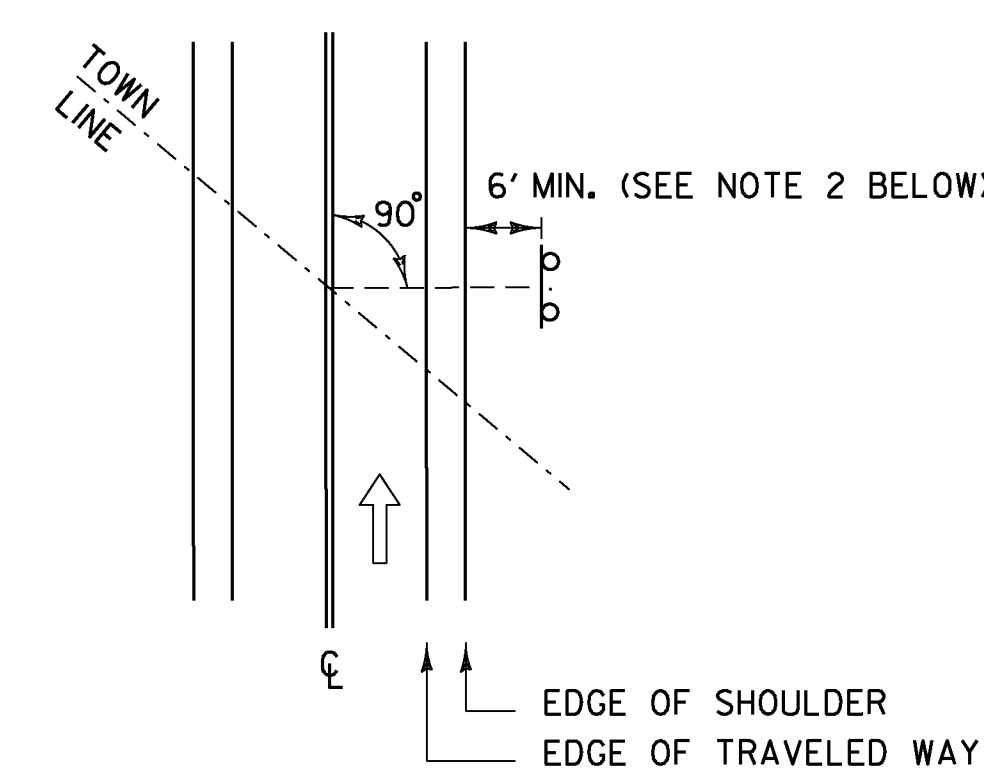


TOWN /COUNTY LINE (VD-024 /VD-025) INSTALLATION:

1. THE SIGN SHALL BE MOUNTED PARALLEL WITH THE ROADWAY, NORMALLY ON THE RIGHT SIDE TRAVELING WEST TO EAST OR SOUTH TO NORTH.
2. FOR POST-MOUNTED SIGNS, THE MINIMUM LATERAL OFFSET SHOULD BE 12 FEET FROM THE EDGE OF THE TRAVELED WAY. IF A SHOULDER WIDER THAN 6 FEET EXISTS, THE MINIMUM LATERAL OFFSET FOR POST-MOUNTED SIGNS SHOULD BE 6 FEET FROM THE EDGE OF SHOULDER.


NOT TO SCALE

PROJECT NAME:	WOODFORD - MARLBORO
PROJECT NUMBER:	STPG SIGN (35)
FILE NAME:	I0B336_TS.DGN
PROJECT LEADER:	A. GAMBLE
DESIGNED BY:	J. KELLY
TOWN/COUNTY LINE SIGN DETAILS	
PLOT DATE:	10-APR-2012
DRAWN BY:	J. KELLY
CHECKED BY:	A. GAMBLE
SHEET	4 OF 80

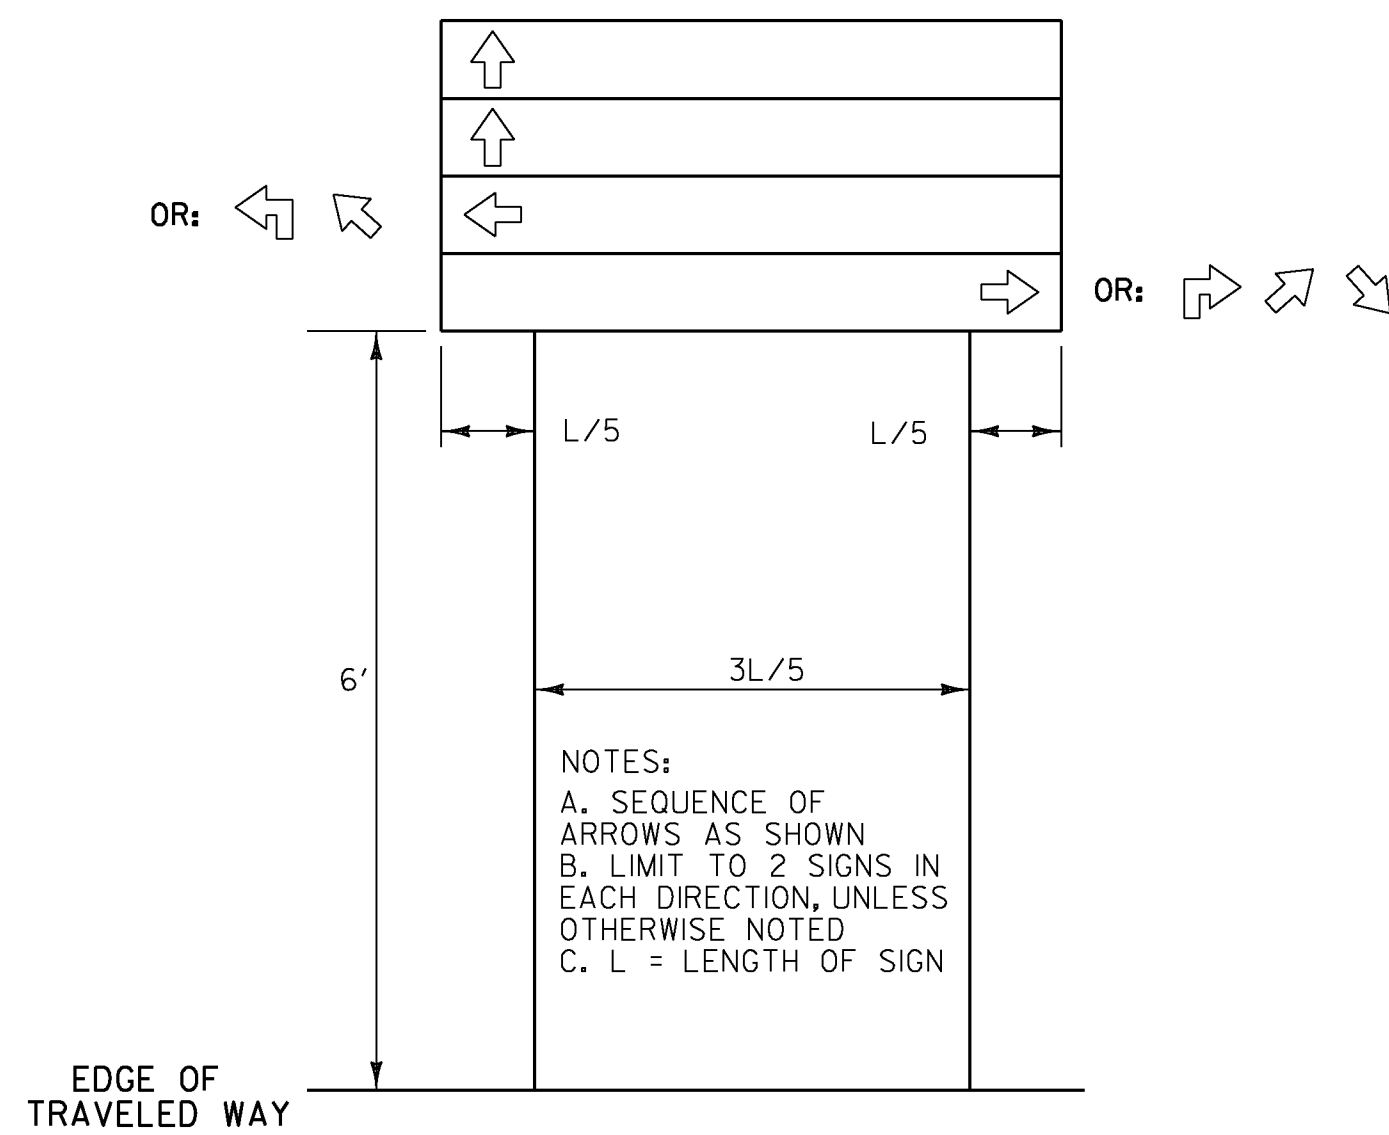


DESTINATION SIGN (VD1-1, VD1-1A, VD1-2, VD2-1) ASSEMBLY:


1. THE DESTINATION SIGN DETAILS SHOWN ON SHEETS 6 AND 7 SHALL HAVE WHITE RETROREFLECTIVE ASTM TYPE III OR IV TEXT, ARROWS AND BORDERS ON A GREEN RETROREFLECTIVE ASTM TYPE III OR IV BACKGROUND.
2. FONT SPACING SHOWN ON AN INDIVIDUAL SIGN DETAIL MAY BE ADJUSTED SLIGHTLY TO MEET DIMENSION REQUIREMENT(S).
3. DIMENSIONS SHOWN ON THE INDIVIDUAL SIGN DETAILS MAY BE ADJUSTED SLIGHTLY TO ACCOMMODATE VARIOUS MANUFACTURER'S LETTER WIDTHS.

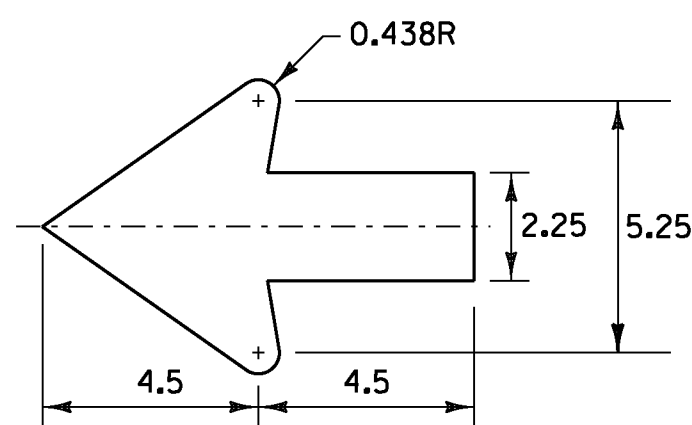


STANDARD SHS 2.25" ARROW

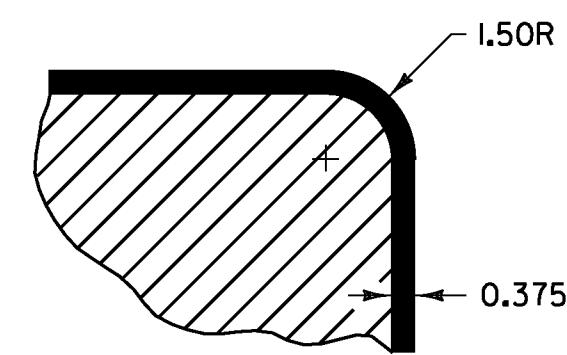

BORDER DETAIL

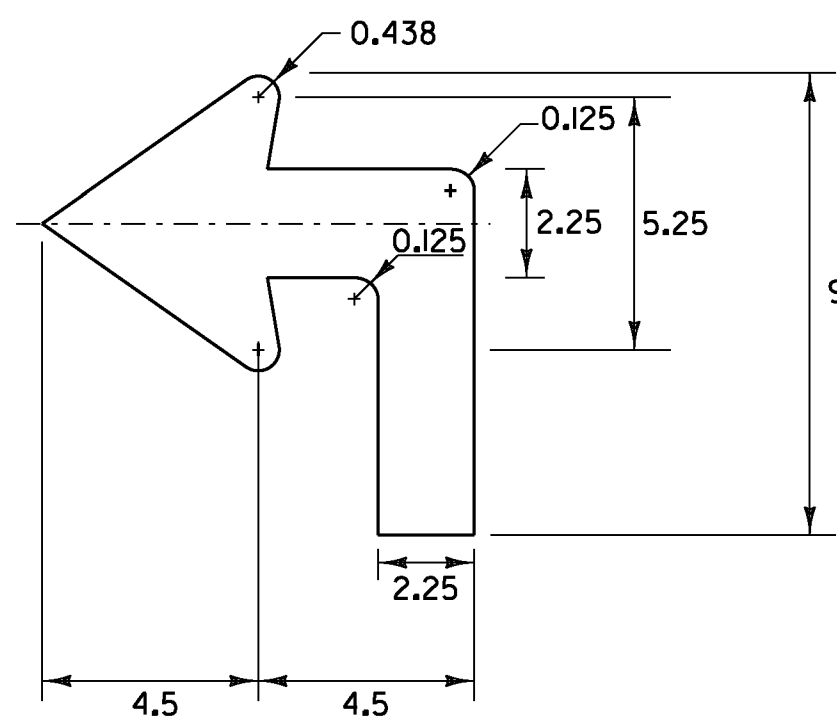

ADVANCE 2.25" ARROW

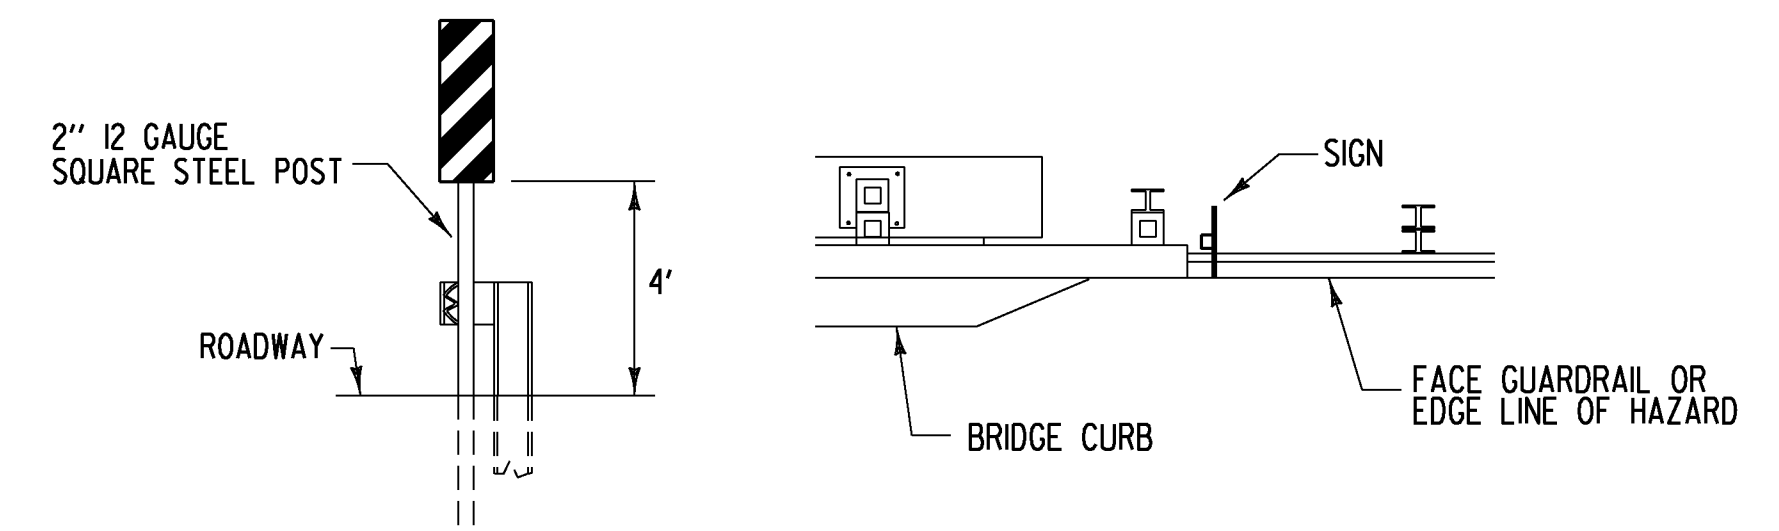


ELEVATION

PLAN VIEW

OBJECT MARKER (OM3-L or OM3-R) INSTALLATION:

1. OBJECT MARKER SHOULD BE INSTALLED SO THAT THE INSIDE EDGE OF THE SIGN IS AS CLOSE AS POSSIBLE TO THE FACE OF GUARDRAIL OR INSIDE EDGE OF THE HAZARD.
2. THE SIGN SHALL BE MOUNTED SO THE DIAGONAL STRIPES SLOPE DOWNWARDS TOWARD THE ROAD CENTERLINE.
3. ASSEMBLY HARDWARE SHALL CONFORM TO SUBSECTION 750.12 (c). RIVETS SHALL NOT BE USED.
4. SIGN BASE MATERIAL SHALL BE 0.100" FLAT SHEET ALUMINUM.
5. MOUNTING HARDWARE FOR SIGNS ATTACHED TO ABUTMENTS OR HAZARDS SHALL BE APPROVED BY THE ENGINEER.
6. PAYMENT FOR ALL MATERIALS AND LABOR NECESSARY TO ATTACH AN OM3(L/R) SIGN TO ANYTHING OTHER THAN A SIGN POST WILL BE PAID FOR AS ONE 2" SQUARE STEEL SIGN POST 15 FEET LONG.

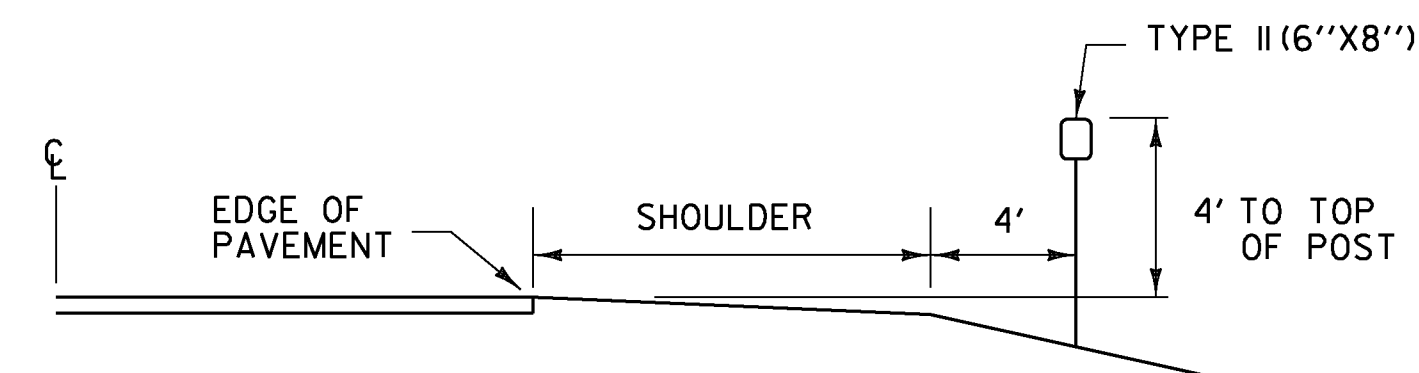


DELINEATOR LOCATIONS:

TOWN:	DIRECTION:	MILE POINT:	NO. OF NEW TYPE II (POSTS):	NO. OF REMOVALS:	POST SPACING:	SHEET:
WOODFORD	EB	4.856-4.996	30 (15)		50 FT	14

DELINEATORS WITH RETROREFLECTIVE SHEETING:

1. MATERIAL FOR A TYPE II (6"x8") DELINEATOR SHALL BE A 0.063" ALUMINUM BACKING WITH WHITE ASTM TYPE III OR IV RETROREFLECTIVE SHEETING APPLIED TO ONE SIDE.
2. ALL TYPE II (6"x8") DELINEATOR POSTS SHALL BE 1.75" SQUARE STEEL, 1.88 LB/FT (14 GAUGE) WITH A 12 GAUGE ANCHOR. ANCHOR REVEAL OF 2" MAXIMUM.
3. DELINEATOR POSTS SHALL HAVE A MINIMUM EMBEDMENT OF 2'-6" IN THE GROUND.
4. ALL WORK ASSOCIATED WITH INSTALLING NEW TYPE II (6"x8") DELINEATORS SHALL BE PAID FOR UNDER ITEM 676.10 DELINEATOR WITH STEEL POST.

DELINEATOR PLACEMENT

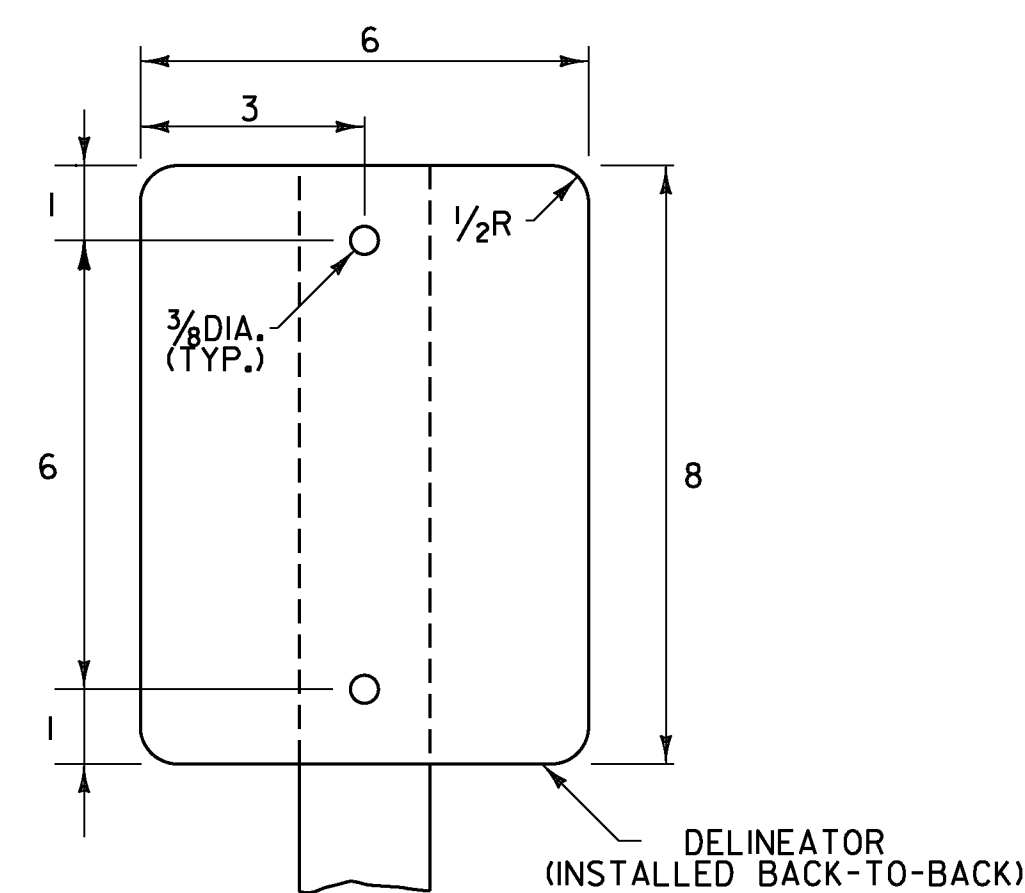

TYPE II (6"x8") DELINEATOR


ALL DIMENSIONS SHOWN IN INCHES, EXCEPT WHERE NOTED.

PROJECT NAME:	WOODFORD - MARLBORO	PLOT DATE:	10-APR-2012
PROJECT NUMBER:	STPG SIGN (35)	DRAWN BY:	J. KELLY
FILE NAME:	IOC332.SD_I	DESIGNED BY:	J. KELLY
PROJECT LEADER:	A. GAMBLE	CHECKED BY:	A. GAMBLE
SIGN DETAILS I		SHEET	5 OF 80

NOT TO SCALE



1.500" Radius, 0.375" Border, White on Green;
Standard Arrow Custom 9.000" X 6.125" 90°; [Wilmington] C; [8] C;

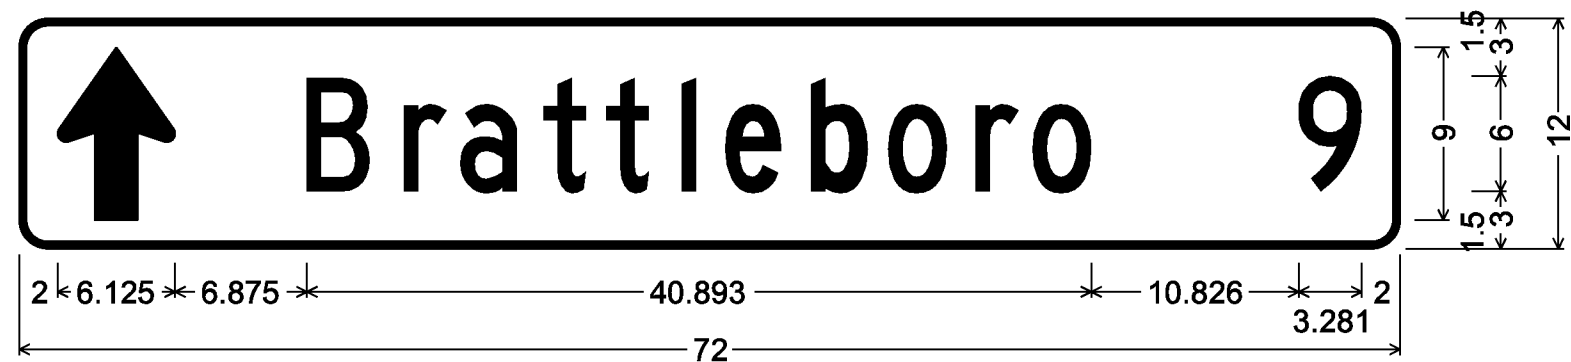

1.500" Radius, 0.375" Border, White on Green;
Standard Arrow Custom 9.000" X 6.125" 90°; [Brattleboro] C; [9] C;



1.50" Radius, 0.38" Border, White on Green;
Standard Arrow Custom 9.00" X 6.13" 180°; [Marlboro] C; [1] B;



1.50" Radius, 0.38" Border, White on Green;
[Marlboro] C; [1] B; Standard Arrow Custom 9.00" X 6.13" 0°;




1.500" Radius, 0.375" Border, White on Green;
Standard Arrow Custom 9.000" X 6.125" 180°; [S Newfane] C; [8] C;




1.500" Radius, 0.375" Border, White on Green;
[S Newfane] C; [8] C; Standard Arrow Custom 9.000" X 6.125" 0°;

VD1-1A SIGN DETAILS

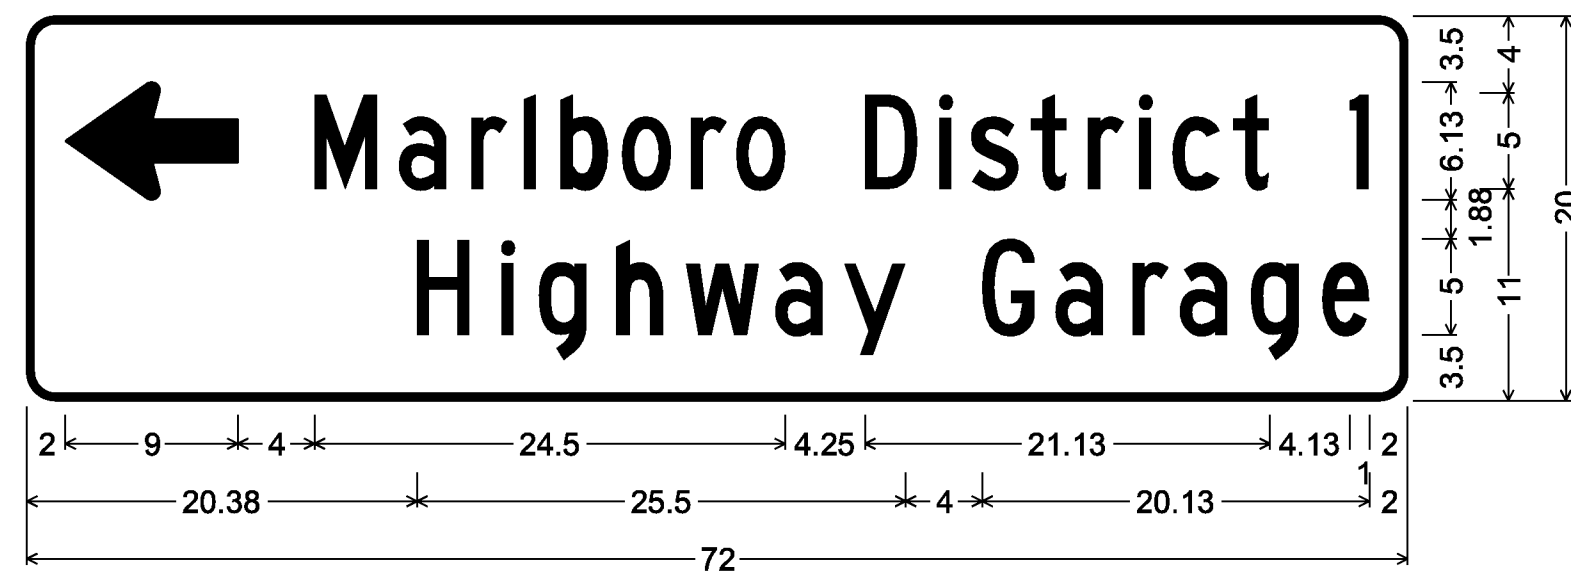


1.50" Radius, 0.38" Border, Black on White;
Standard Arrow Custom 9.00" X 6.13" 180°; [Marlboro District 1] C specified length;
[Highway Garage] C;

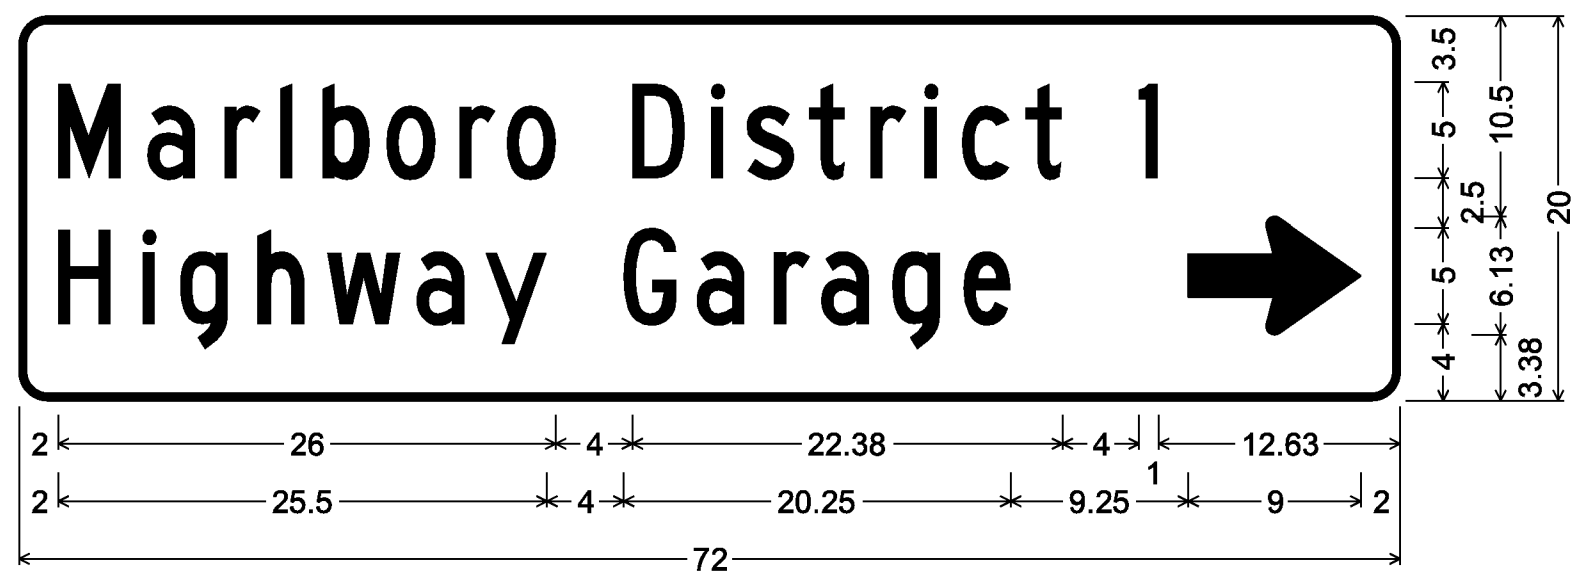


1.50" Radius, 0.38" Border, White on Green;
[Marlboro District 1] C; [Highway Garage] C; Standard Arrow Custom 9.00" X 6.13" 0°;

VD1-1 SIGN DETAILS

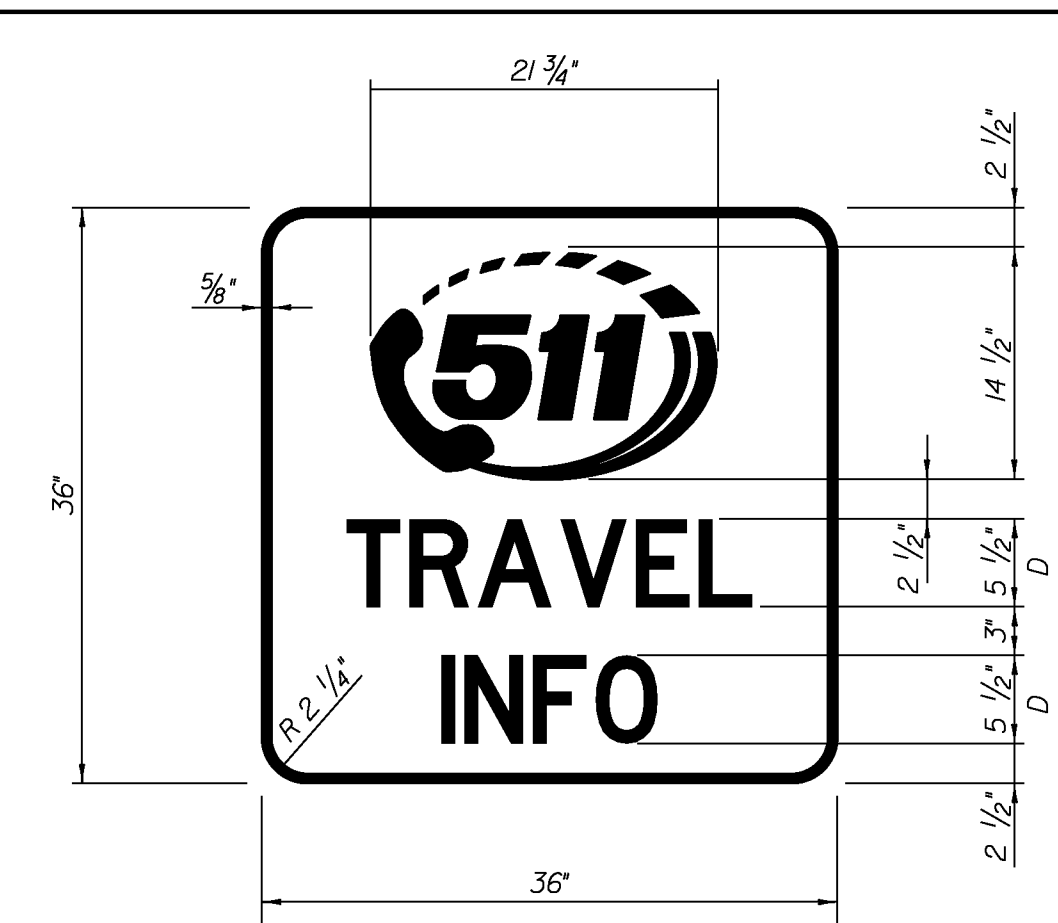


VD-123

LEGEND: WHITE (RETROREFLECTIVE)
BACKGROUND: BLUE (RETROREFLECTIVE)

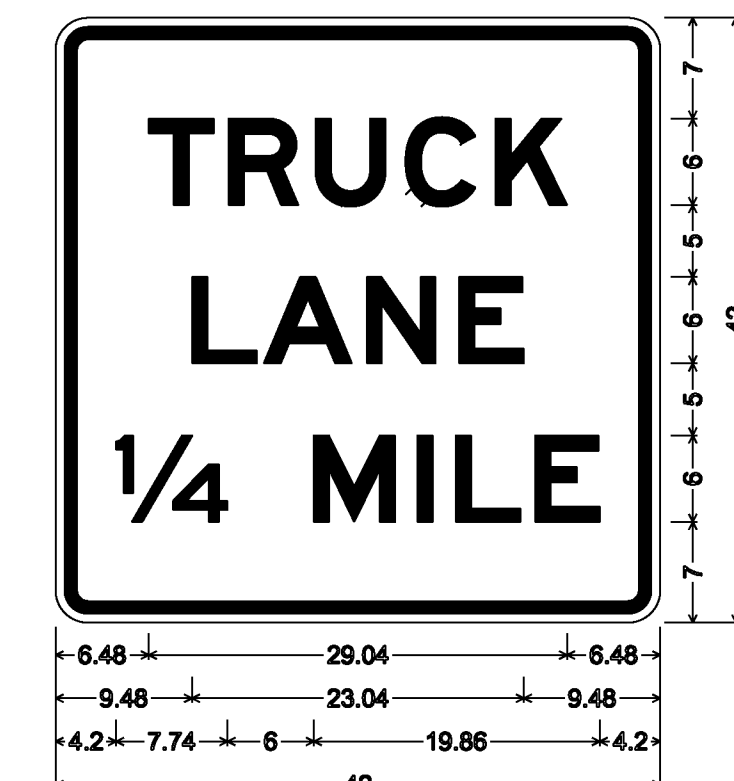

D17-2 2.250" Radius, 0.675" Border, 0.625" Indent, White on Green;
"TRUCK" E 2K; "LANE" E 2K; "1/4 MILE" E 2K;

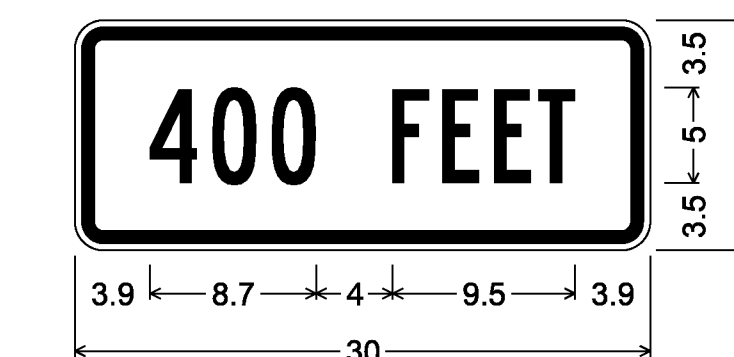

VD4-1 PARKING SUPPLEMENTAL;
1.5" Radius, 0.6" Border, 0.4" Indent, Green on White;
[400 FEET] B 2K;


PROJECT NAME: WOODFORD - MARLBORO

PROJECT NUMBER: STPG SIGN (35)

FILE NAME: IOB336_TS.DGN
PROJECT LEADER: A. GAMBLE
DESIGNED BY: J. KELLY
SIGN DETAILS 2

PLOT DATE: 10-APR-2012
DRAWN BY: J. KELLY
CHECKED BY: A. GAMBLE
SHEET 6 OF 80


NOT TO SCALE

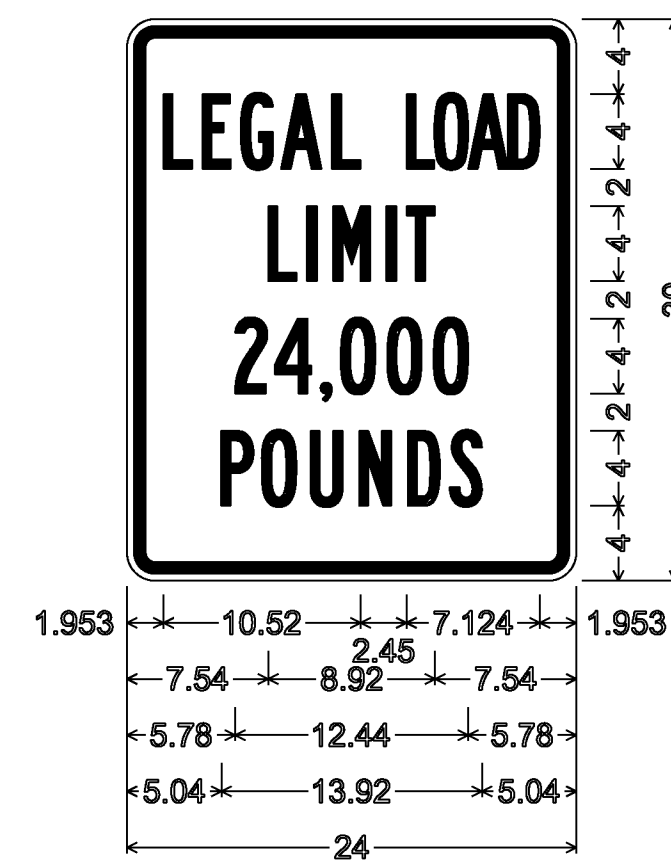


VR-017;
 1.500" Radius, 0.625" Border, 0.375" Indent, Black on White;
 LEGAL B 2K * LOAD* Highway B;
 LIMIT B 2K;
 24,000 B 2K;
 POUNDS B 2K;




COLORS
 LEGEND - RED (REFL.)
 BACKGROUND - WHITE (REFL.)
VR - 020

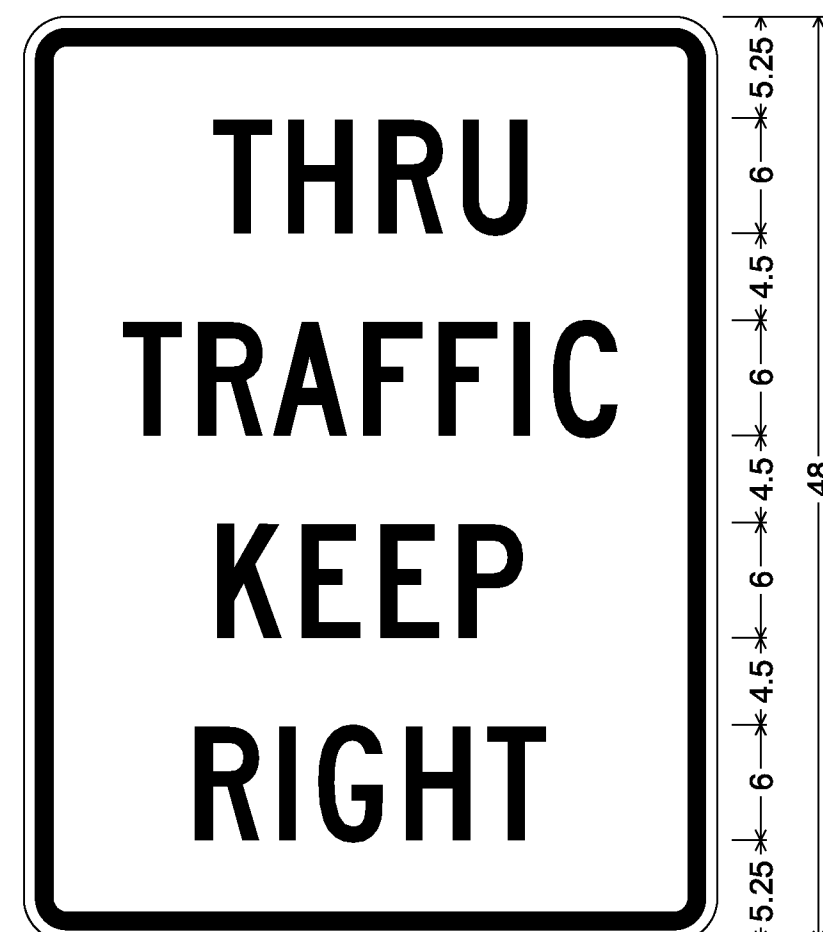


VR-118R THRU TRAFFIC KEEP R/L;
 2.25" Radius, 0.88" Border, 0.63" Indent, Black on White;
 [THRU] C 2K; [TRAFFIC] C 2K;
 [KEEP] C 2K; [RIGHT] C 2K;

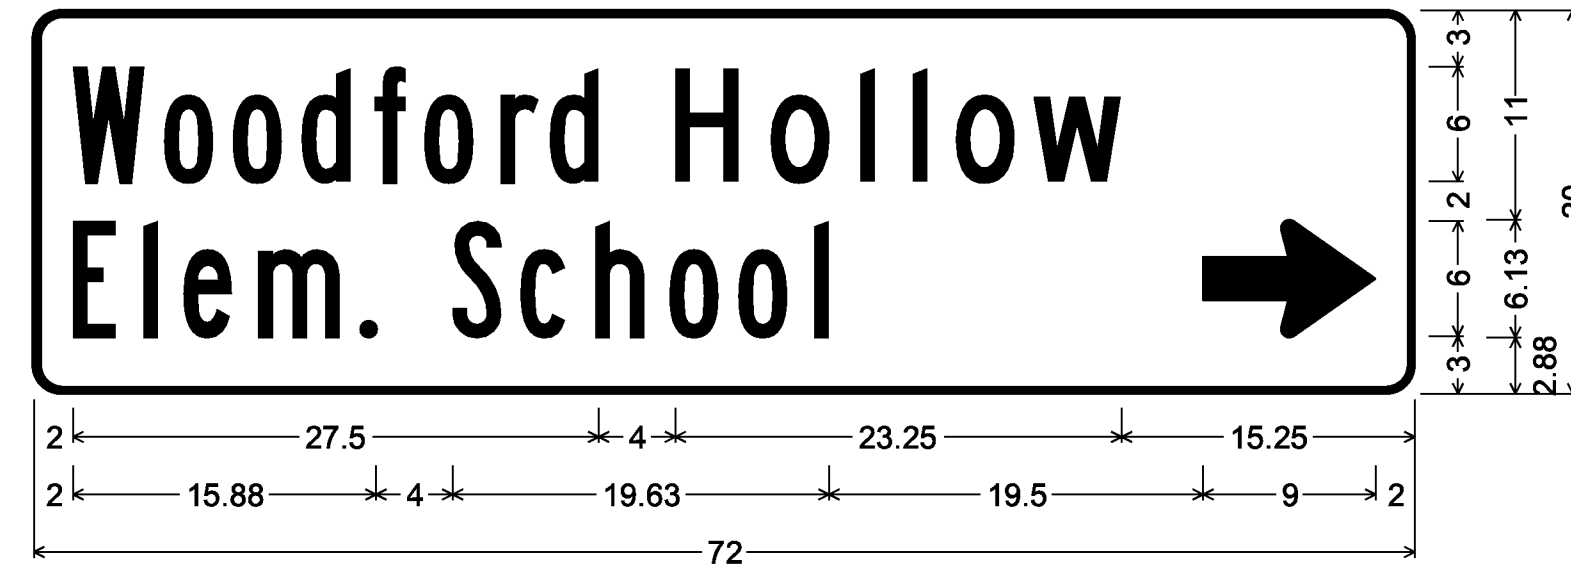


1.50" Radius, 0.38" Border, White on Green;
 [Woodford] B [Hollow] C; [Elem. School] B; Standard Arrow Custom 9.00" X 6.13" 0°;

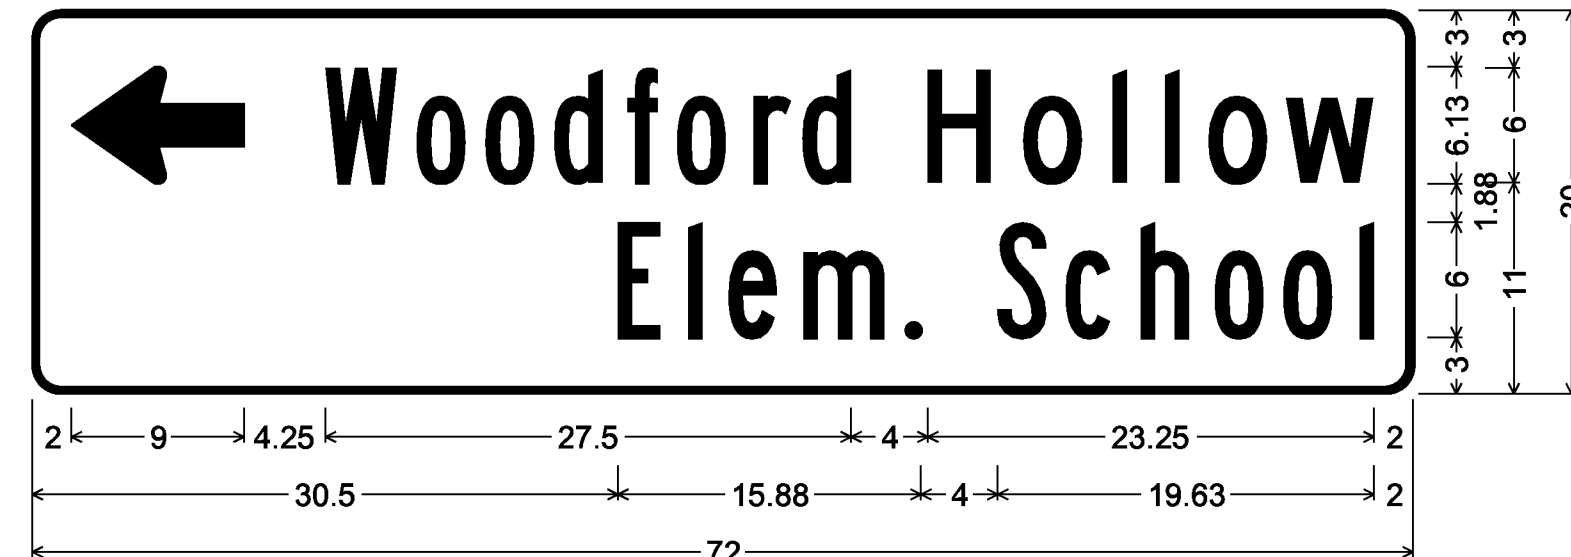

1.50" Radius, 0.38" Border, White on Green;
 Standard Arrow Custom 9.00" X 6.13" 180°; [Woodford] B [Hollow] C;
 [Elem. School] B;

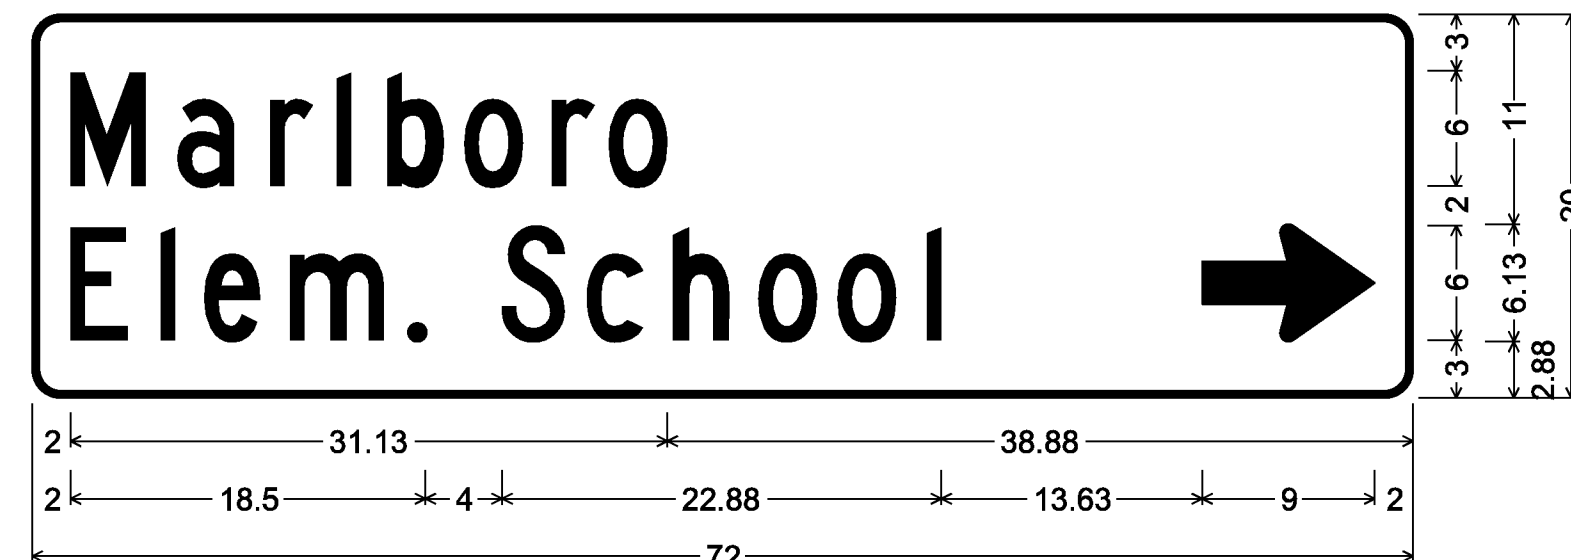


1.50" Radius, 0.38" Border, White on Green;
 [Marlboro] C; [Elem. School] C; Standard Arrow Custom 9.00" X 6.13" 0°;

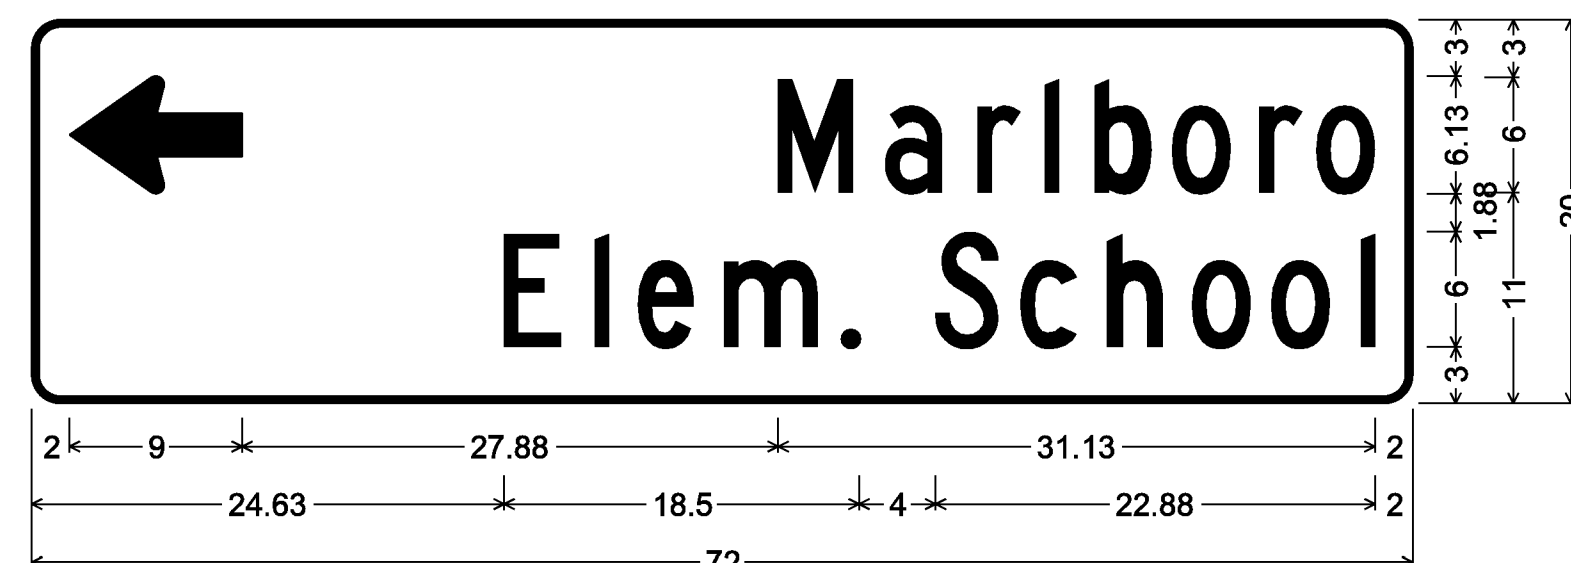


1.50" Radius, 0.38" Border, White on Green;
 Standard Arrow Custom 9.00" X 6.13" 180°; [Marlboro] C; [Elem. School] C;

VD1-1 SIGN DETAILS

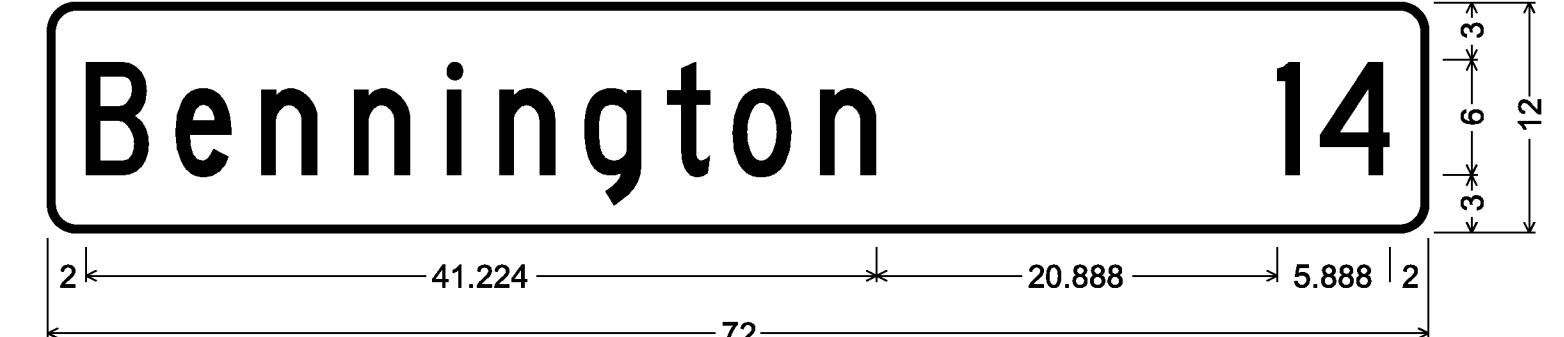

1.500" Radius, 0.375" Border, White on Green;
 [Bennington] C; [14] C;

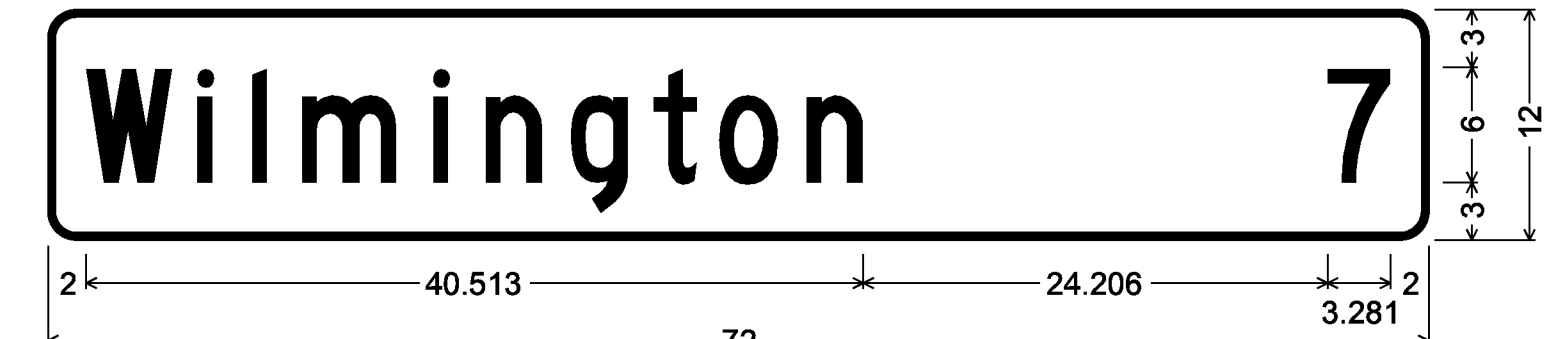

1.500" Radius, 0.375" Border, White on Green;
 [Wilmington] C; [7] C 90% spacing;



1.500" Radius, 0.375" Border, White on Green;
 [Ski Areas] C;



1.500" Radius, 0.375" Border, White on Green;
 [Brattleboro] C; [24] C 90% spacing;

VD2-1 SIGN DETAILS

ALL DIMENSIONS SHOWN IN INCHES UNLESS OTHERWISE NOTED.


PROJECT NAME: WOODFORD - MARLBORO

PROJECT NUMBER: STPG SIGN (35)


FILE NAME: IOB336_TS.DGN
 PROJECT LEADER: A. GAMBLE
 DESIGNED BY: J. KELLY
 SIGN DETAILS 3

PLOT DATE: 10-APR-2012
 DRAWN BY: J. KELLY
 CHECKED BY: A. GAMBLE
 SHEET 7 OF 80


NOT TO SCALE

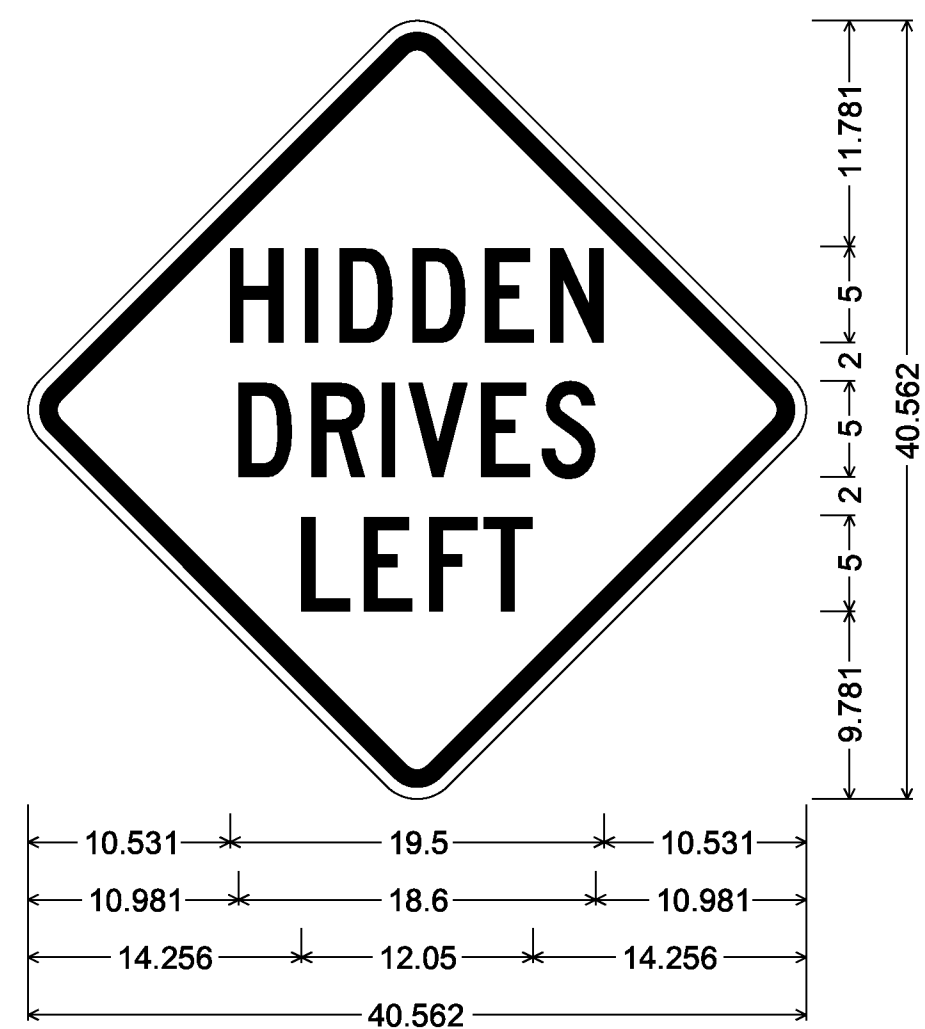


VW-133L
 30.000" across sides 2.250" Radius, 0.875" Border,
 0.625" Indent, Black on Yellow;
 [HIDDEN] C 2K; [DRIVES] C 2K; [LEFT] C 2K;

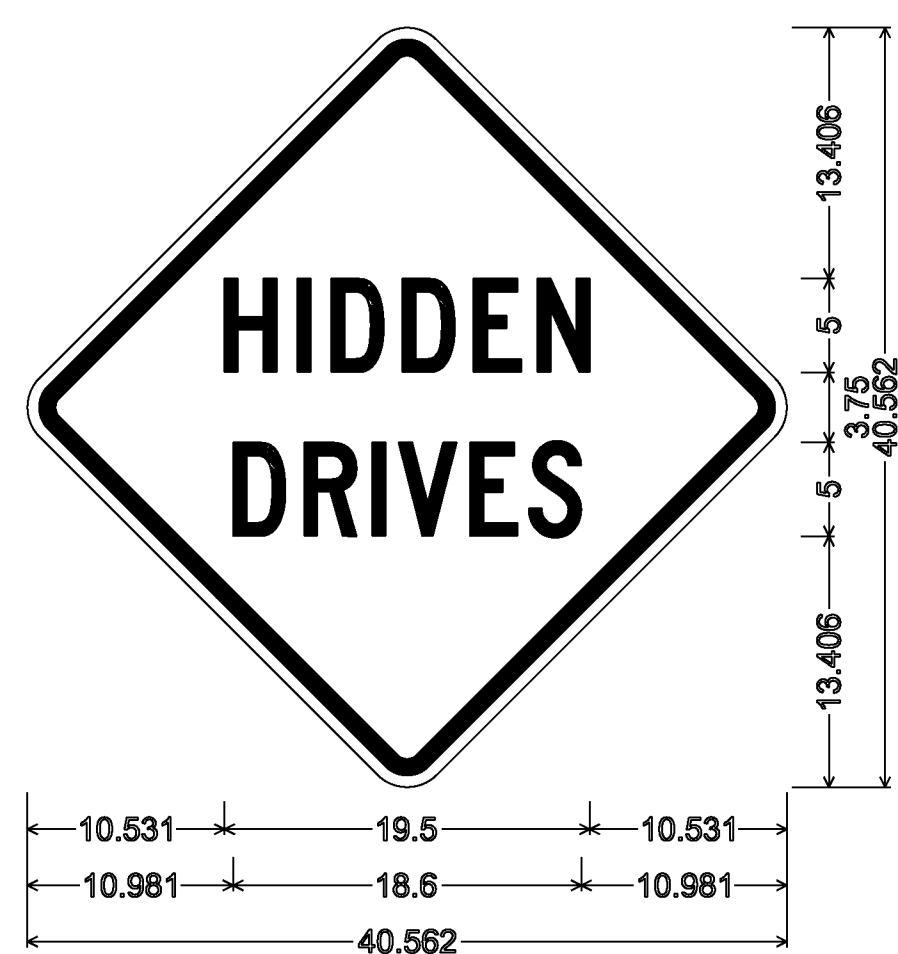


VD-060;
 30.000" across sides 2.250" Radius, 0.875" Border,
 0.625" Indent, Black on Yellow;
 "HIDDEN" C 2K; "DRIVES" C 2K;

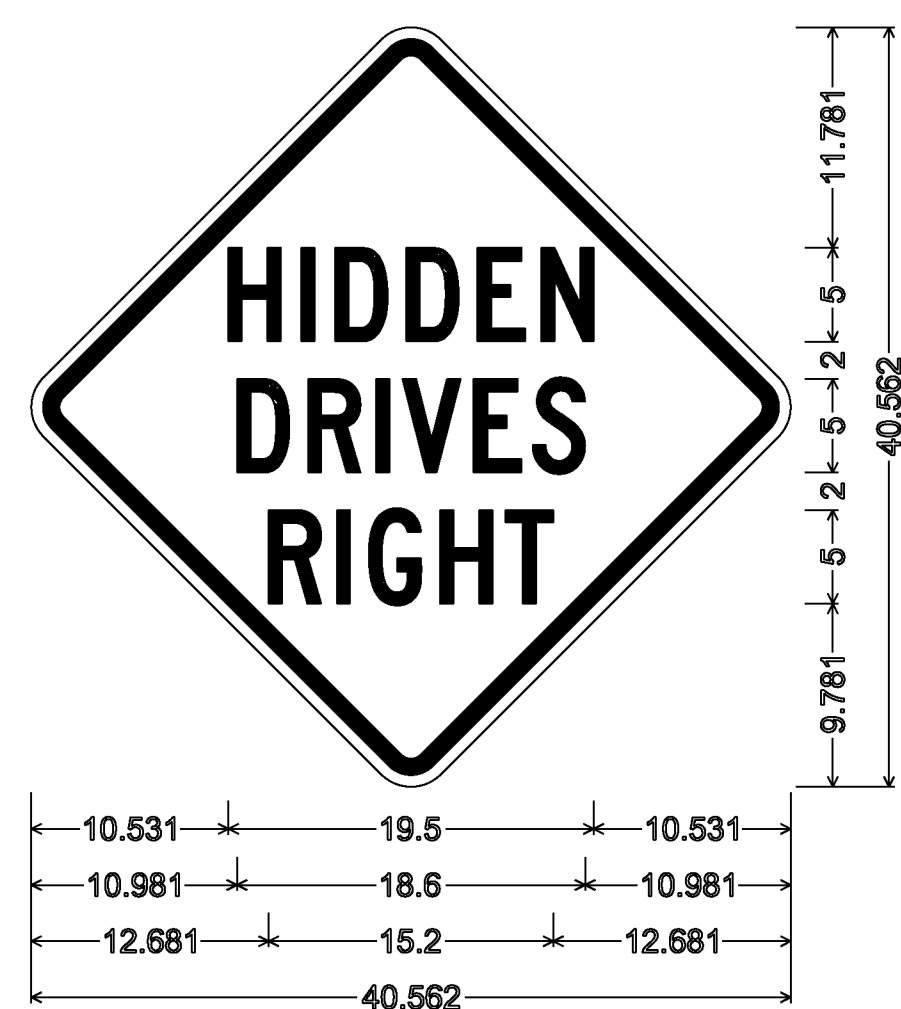


VW-133R
 30.000" across sides 2.250" Radius, 0.875" Border,
 0.625" Indent, Black on Yellow;
 "HIDDEN" C 2K; "DRIVES" C 2K;
 "RIGHT" C 2K;

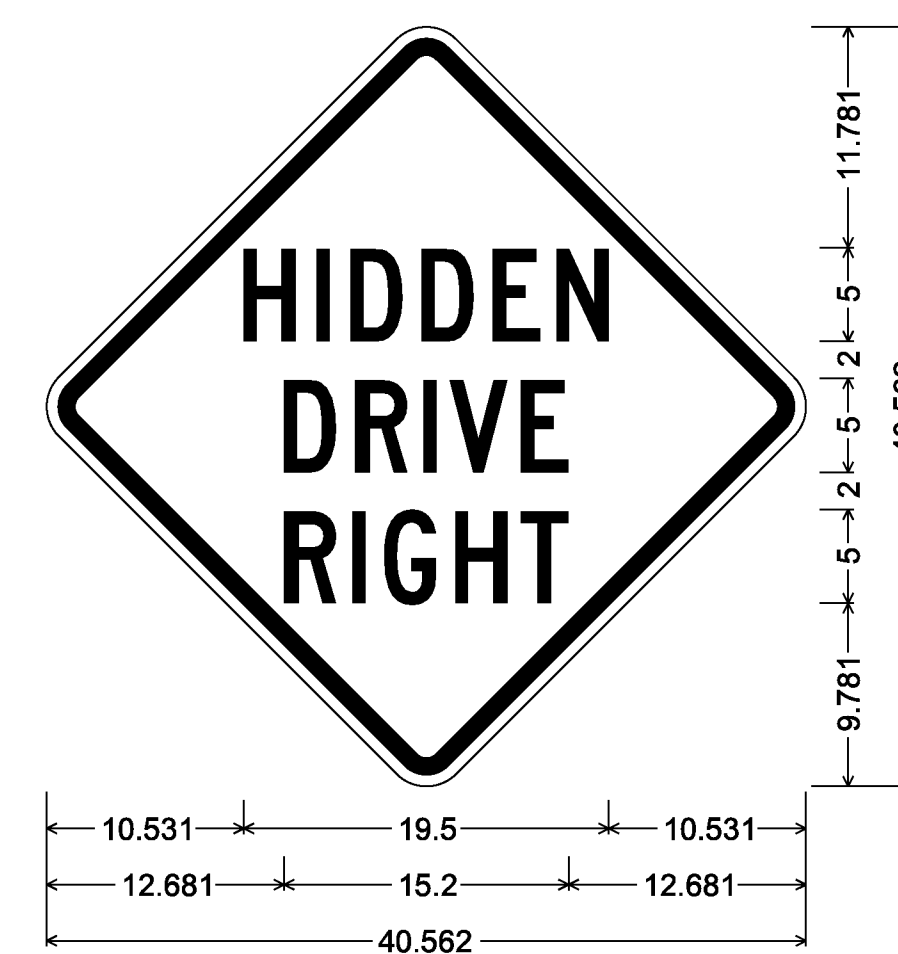


VW-054R
 30.000" across sides 2.250" Radius, 0.875" Border,
 0.625" Indent, Black on Yellow;
 [HIDDEN] C 2K; [DRIVE] C 2K; [RIGHT] C 2K;

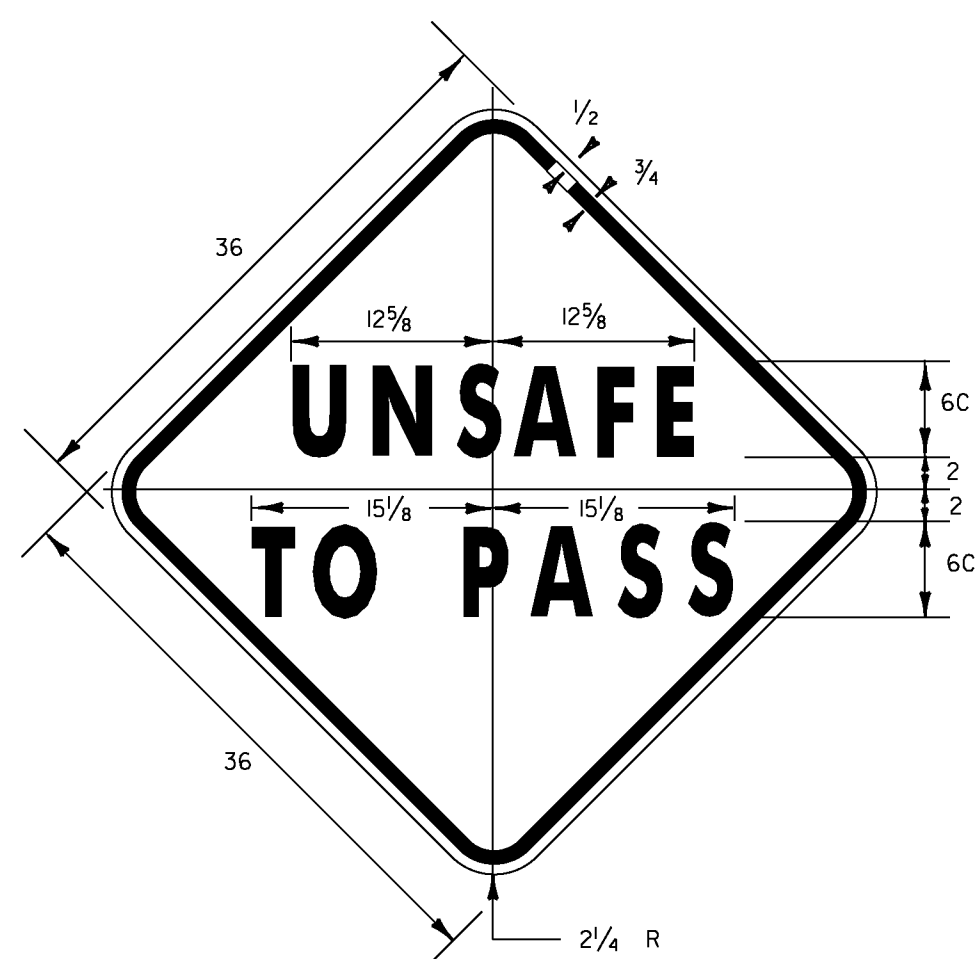

VW-092

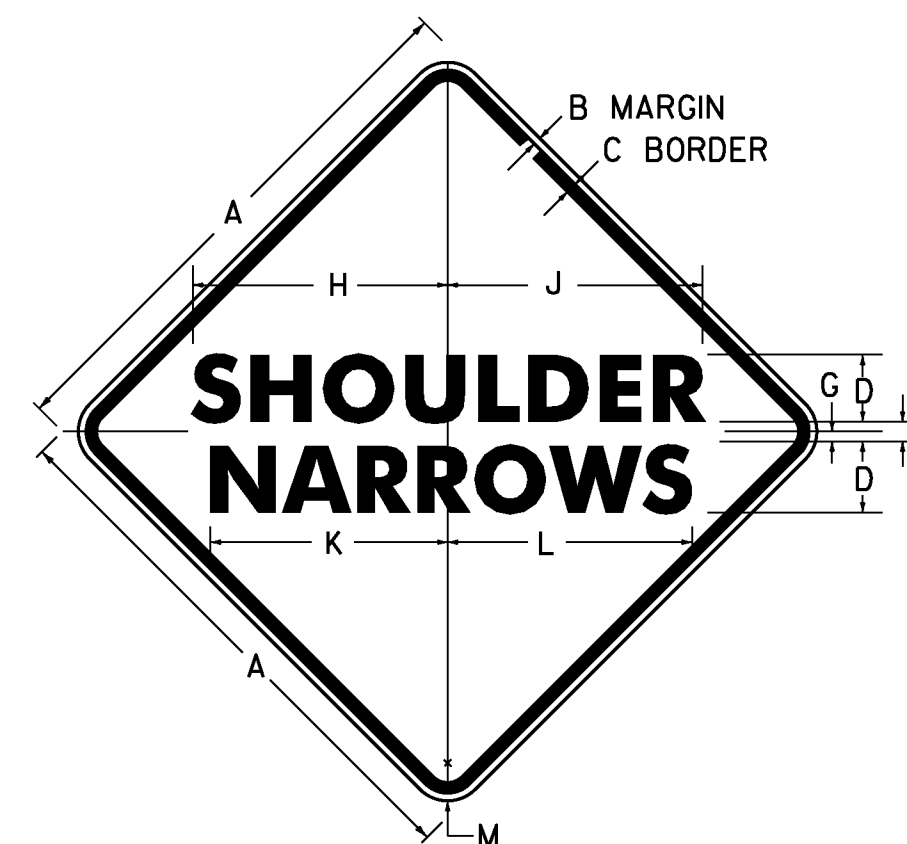


VW-619

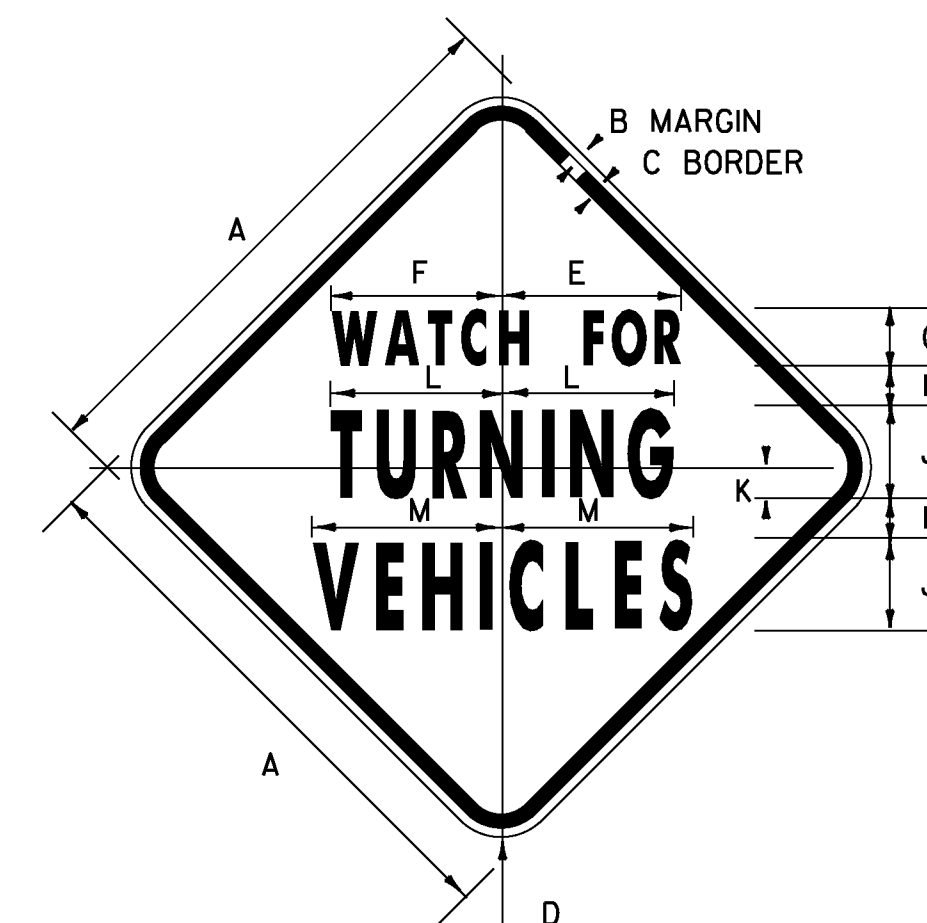


VW-205

SIGN	DIMENSIONS (INCHES)												
	A	B	C	D	E	F	G	H	J	K	L	M	
MIN. & STD.	36	5/8	7/8	5C	3	6D	I	13 1/16	13 1/16	17 3/8	18 1/4	2 1/4	
EXPWY.	48	3/4	1 1/4	7D	3 1/2	7D	I	23 3/16	23 3/16	27 1/2	27 1/2	3	

SIGN	DIMENSIONS (INCHES)												
	A	B	C	D	E	F	G	H	J	K	L	M	
MIN.	30	1/2	3/4	1 1/8	9 3/4	9 3/4	4B	2	5B	2	9 1/4	10 1/4	
STD.	36	3/8	1/2	2 1/4	11 3/4	12	4C	2 1/2	5C	2	11 1/2	12 1/2	
EXPWY.	48	3/4	1 1/4	3	14 3/4	15 3/4	5C	3 3/8	8B	2 3/4	14 3/8	16 3/8	

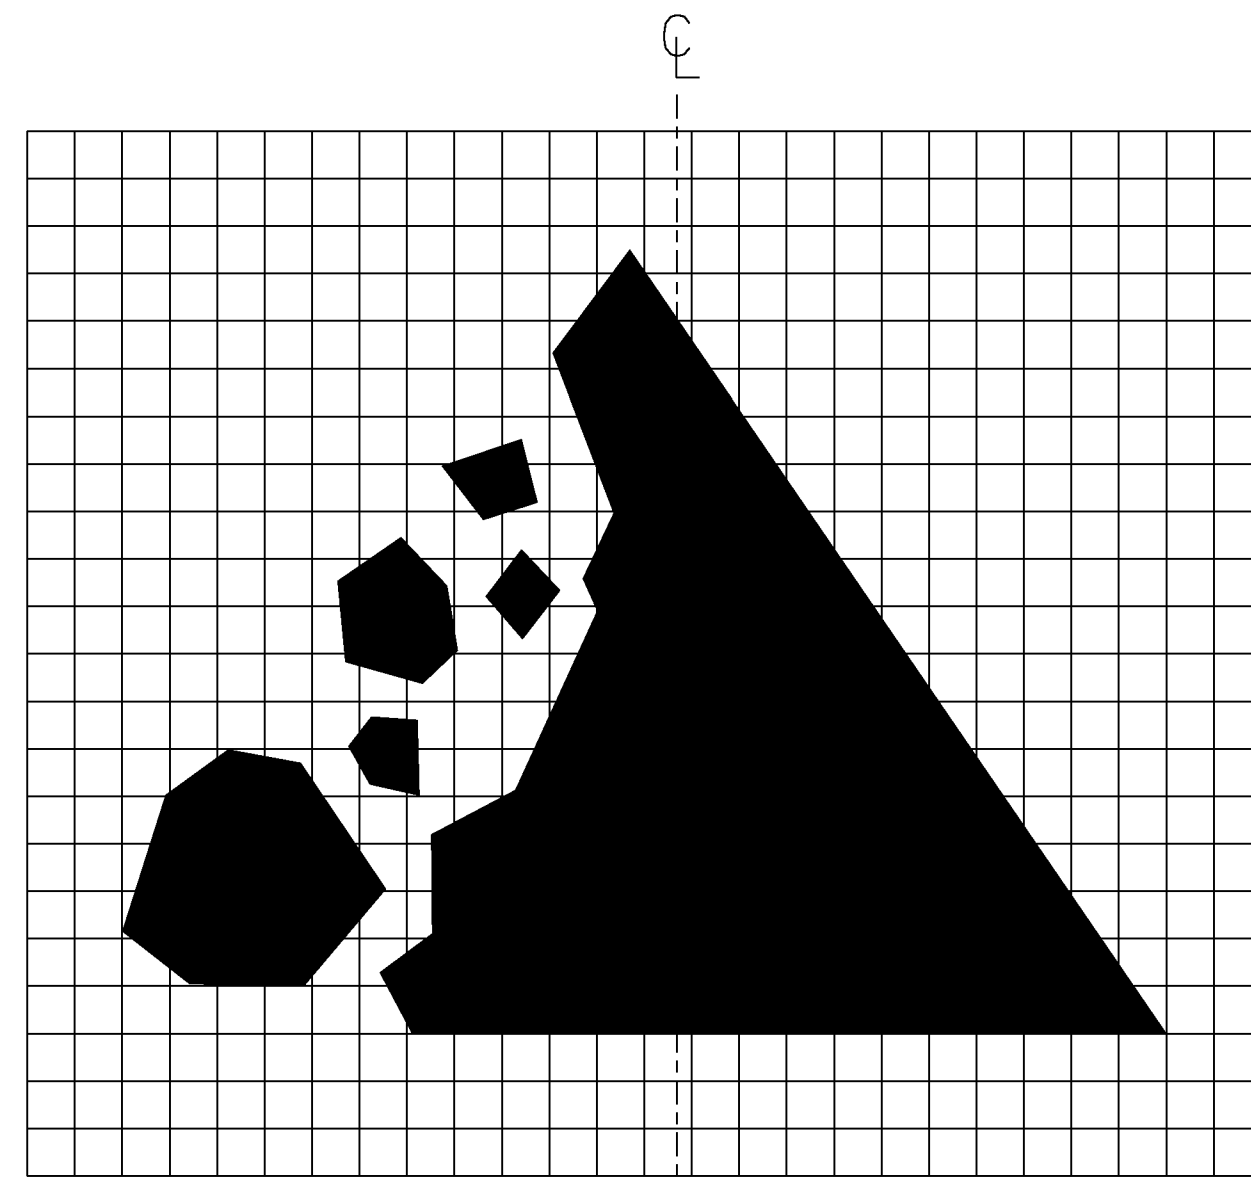


1 SQUARE = 1"

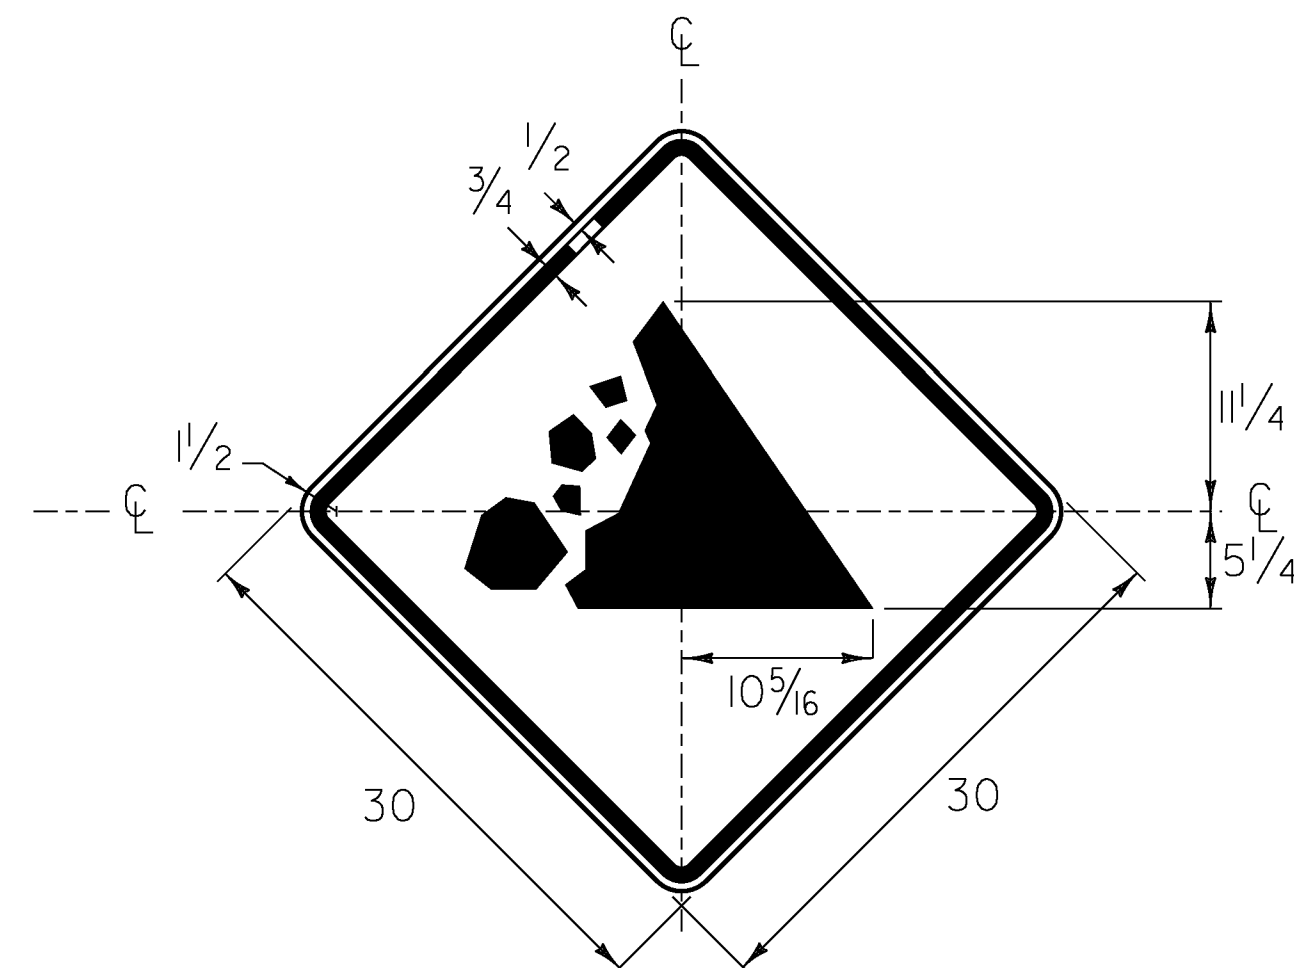


VW-285

SYMBOL AND BORDER - BLACK (NON-REFL.)
 BACKGROUND - YELLOW (REFL.)

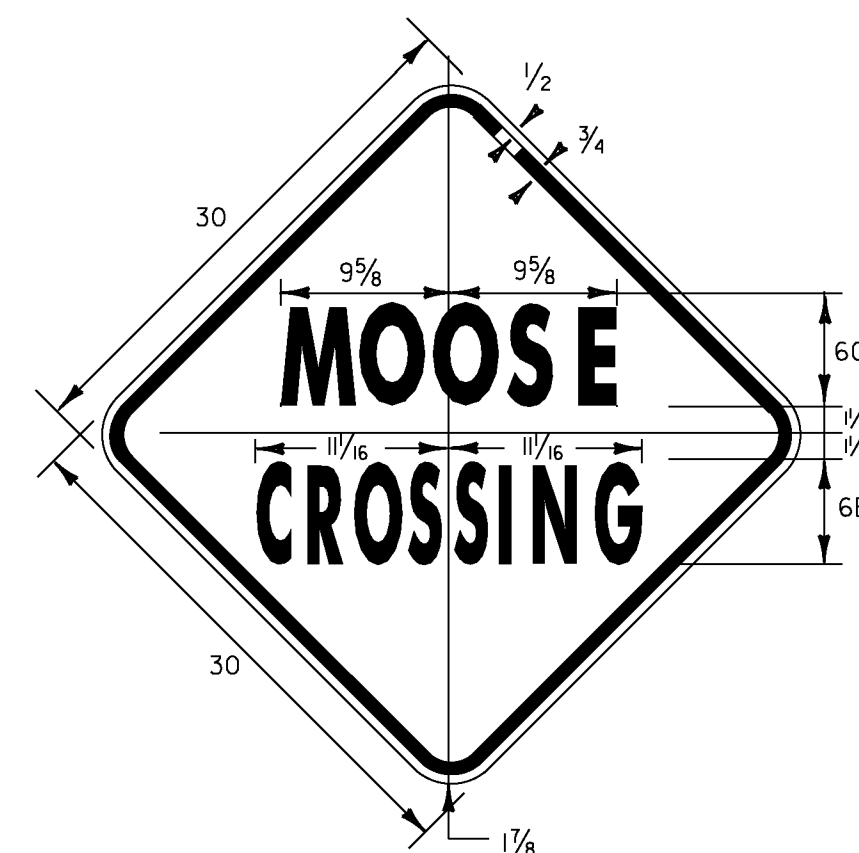

VW-000

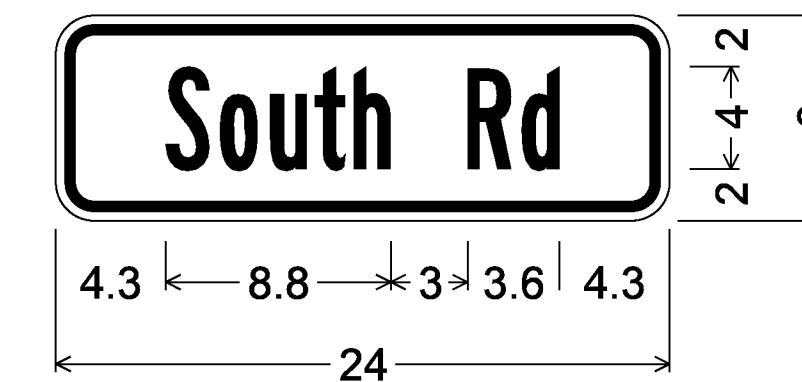

W16-8aP;
 1.5" Radius, 0.4" Border, 0.4" Indent,
 Black on Fluorescent yellow;
 [South Rd] B 2K;

ALL DIMENSIONS SHOWN IN INCHES UNLESS OTHERWISE NOTED.

PROJECT NAME: WOODFORD - MARLBORO

PROJECT NUMBER: STPG SIGN (35)

FILE NAME: IOB336_TS.DGN

PROJECT LEADER: A. GAMBLE

DESIGNED BY: J. KELLY

SIGN DETAILS 4


PLOT DATE: 10-APR-2012

DRAWN BY: J. KELLY

CHECKED BY: A. GAMBLE

SHEET 8 OF 80


ROUTE MARKER ASSEMBLY FRAMES

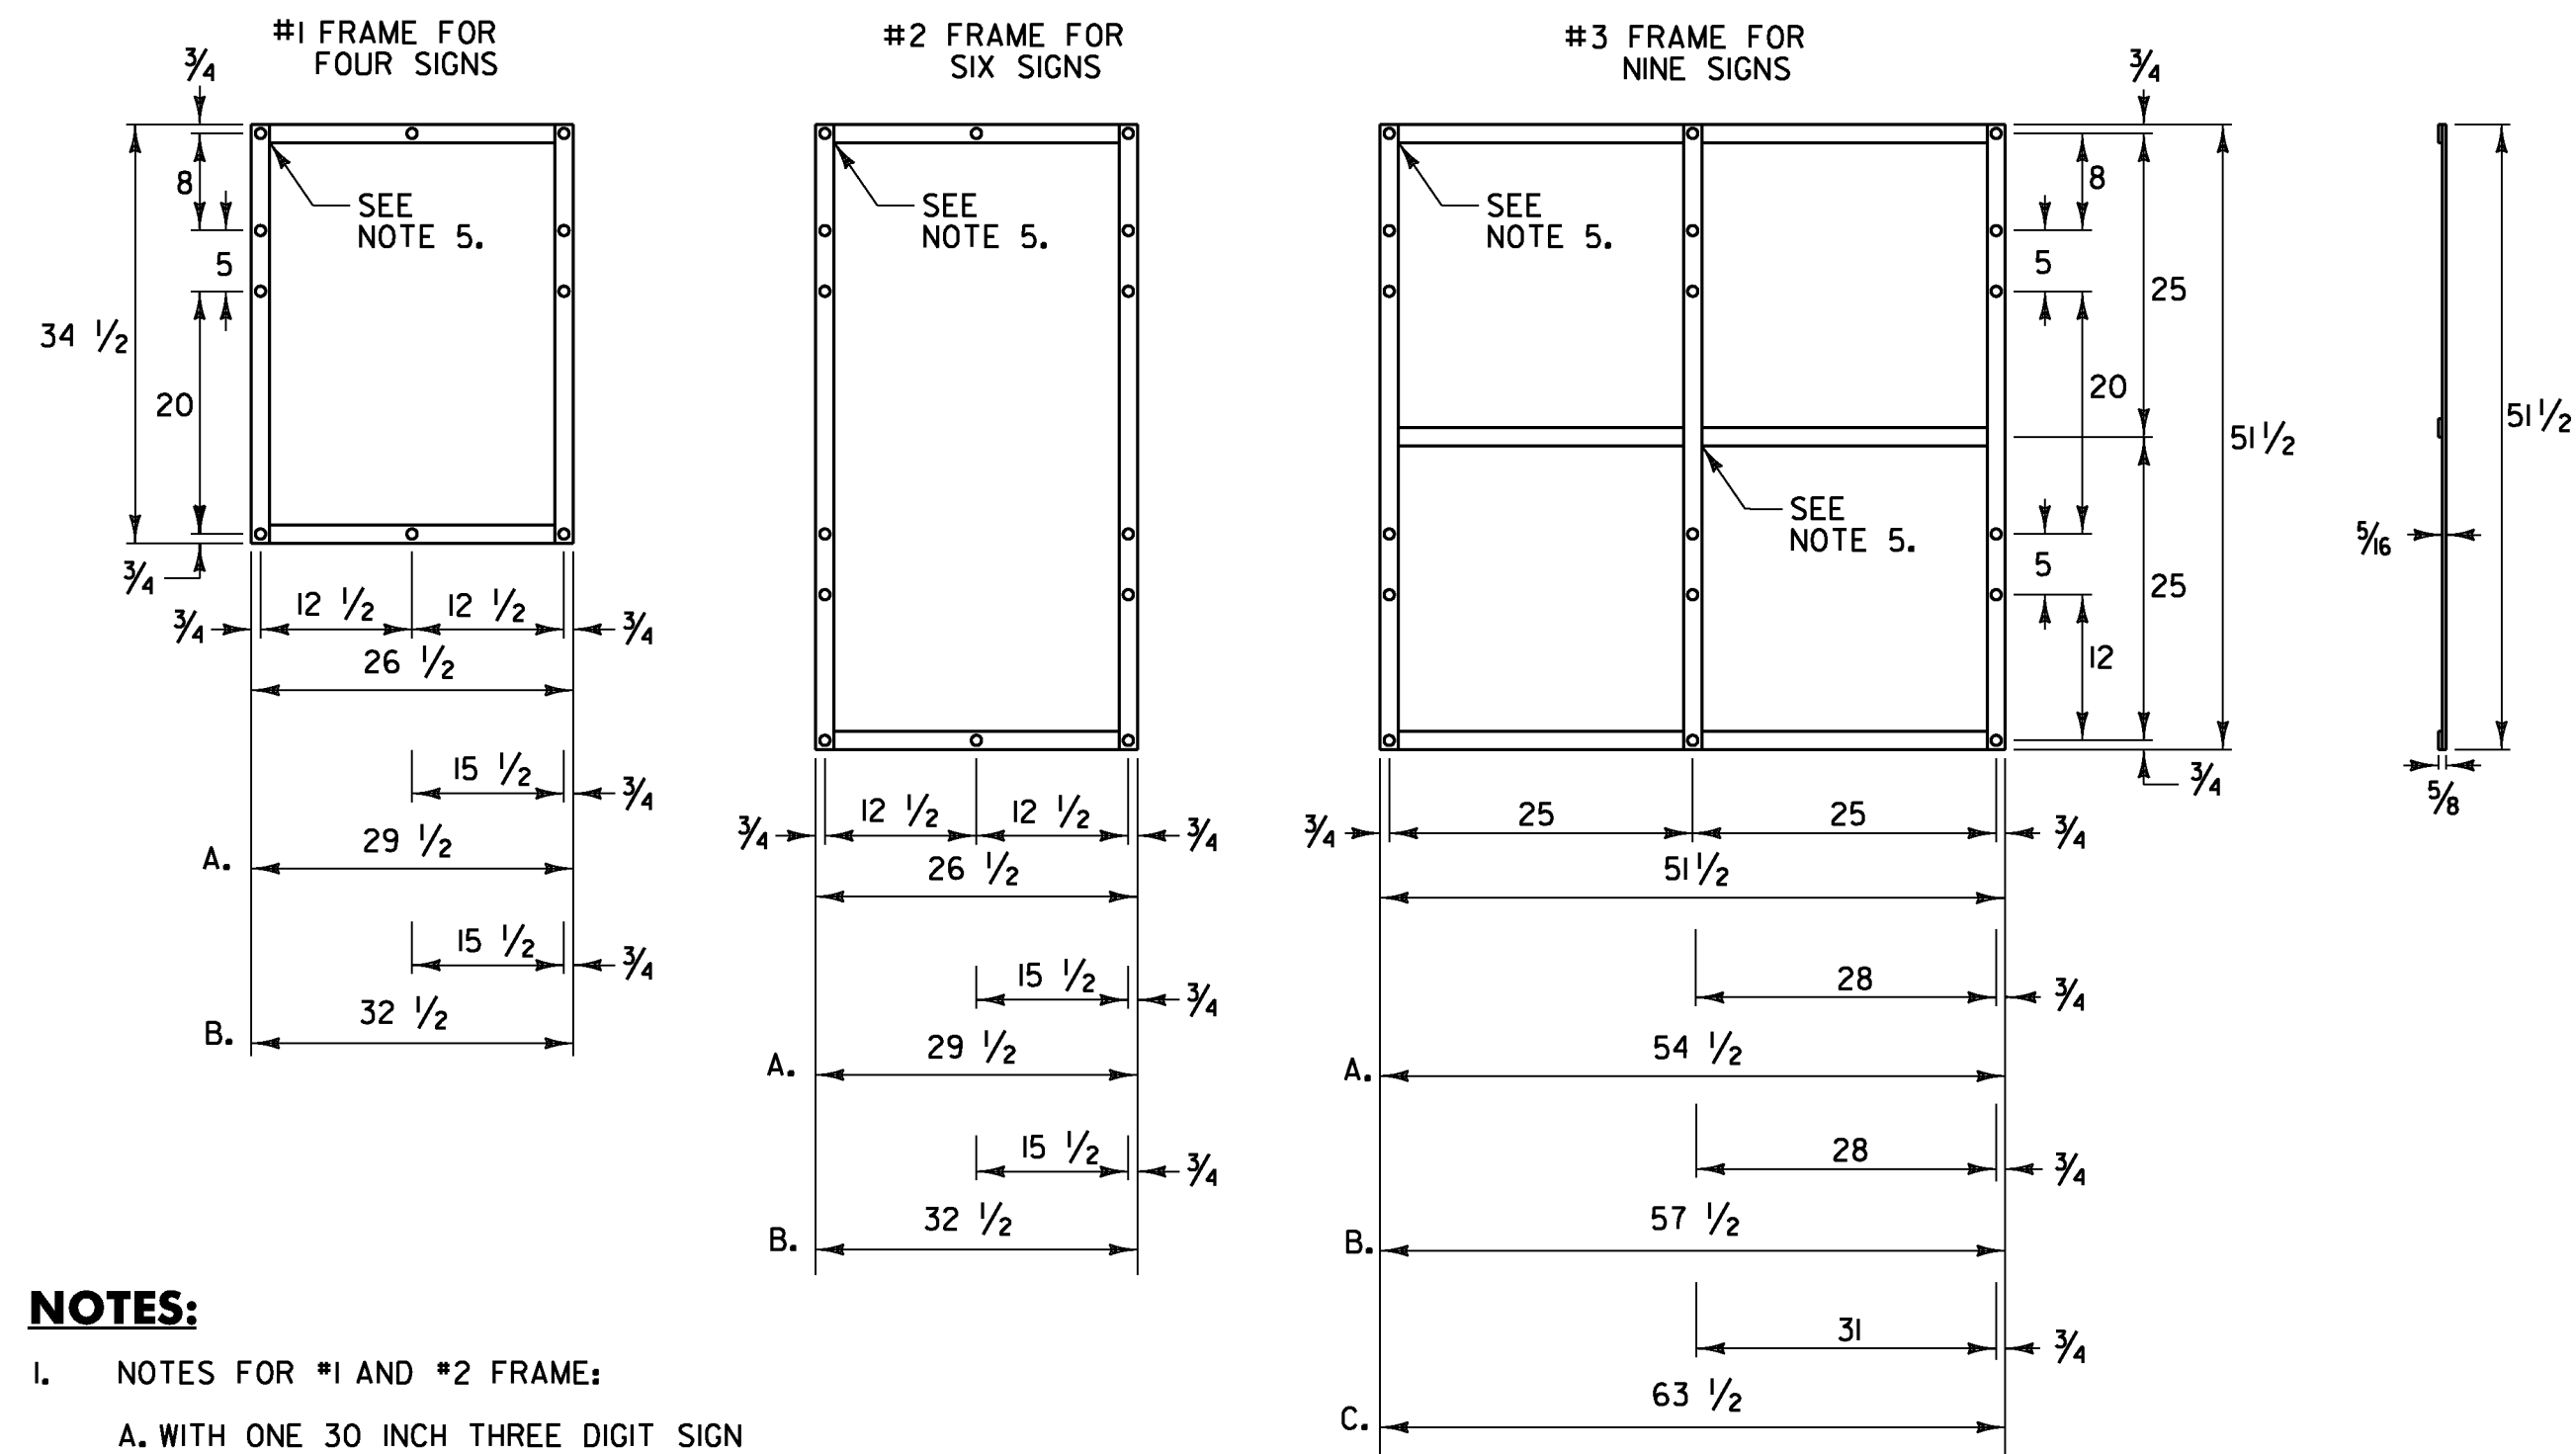

NOTES:

- NOTES FOR #1 AND #2 FRAME:
 - WITH ONE 30 INCH THREE DIGIT SIGN
 - WITH TWO 30 INCH THREE DIGIT SIGNS
- NOTES FOR #3 FRAME:
 - WITH ONE 30 INCH THREE DIGIT SIGN IN AN OUTSIDE POSITION.
 - WITH ONE 30 INCH THREE DIGIT SIGN IN THE CENTER POSITION OR TWO SUCH SIGNS IN THE OUTSIDE POSITIONS.
 - WITH THREE 30 INCH THREE DIGIT SIGNS.
- ALL HOLES SHALL BE 1/8 INCH DIAMETER. FOR OTHER SIGN COMBINATIONS THAN ABOVE, THE FRAME DIMENSIONS AND HOLE SPACING SHALL BE MODIFIED AS NECESSARY. THE FRAME SHALL BE PAINTED WITH ONE COAT OF PRIMER AND A SECOND COAT OF BLACK PAINT. THE PAINT SHALL BE OF THE TYPE USED ON EXTERIOR METAL SURFACES TO PREVENT METAL CORROSION.
- FRAMES SHALL BE CONSTRUCTED OF 3/16 INCH x 1 1/2 INCH A-36 STEEL.
- ALL OVERLAPPED CONNECTIONS SHALL BE WELDED WITH TWO 1/4 INCH WIDE FILLET WELDS, 1 1/2 INCHES LONG.

STANDARD MOUNTING OF ROUTE MARKER ASSEMBLIES

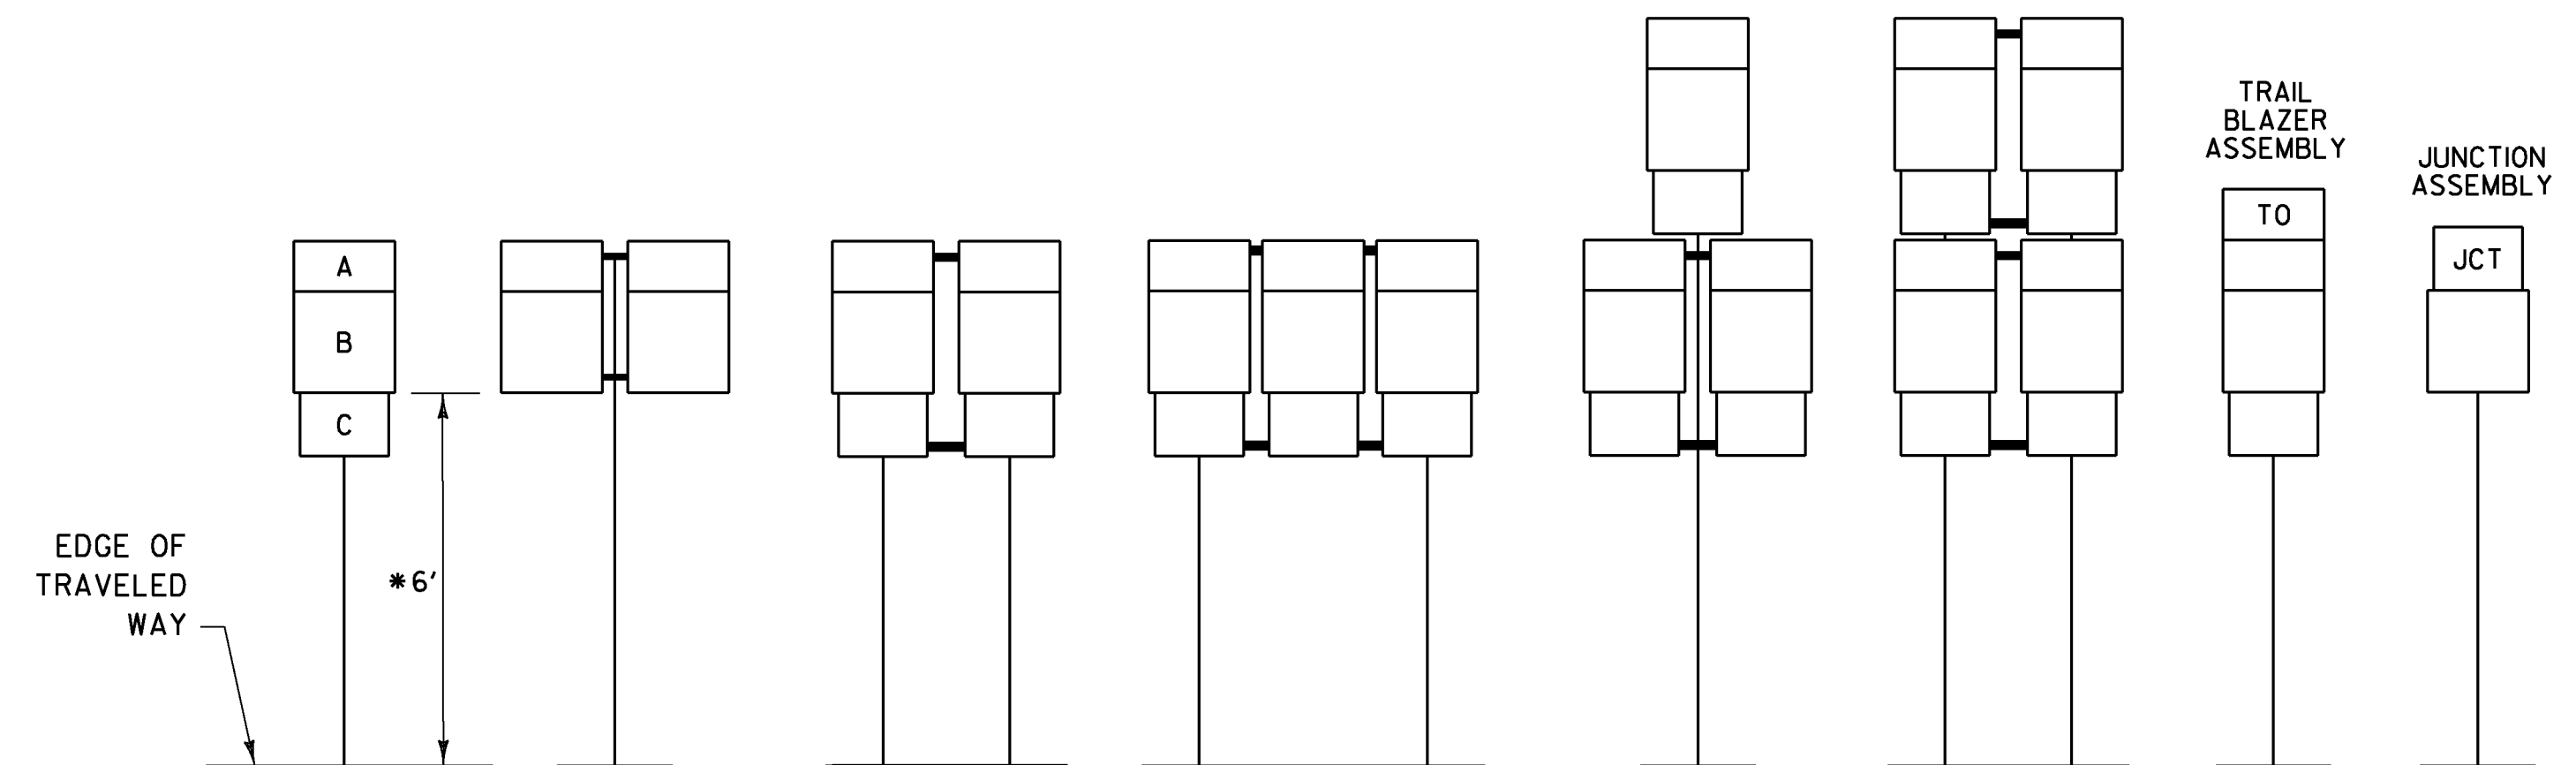

- A - CARDINAL DIRECTION MARKER
- B - ROUTE NUMBER
- C - ADVANCE TURN ARROW OR DIRECTIONAL ARROW


* WHERE PARKING OR PEDESTRIAN TRAFFIC WILL OCCUR IN THE IMMEDIATE VICINITY OF THESE SIGNS MINIMUM VERTICAL CLEARANCE SHALL BE INCREASED TO SEVEN FEET

INSTALLATION SEQUENCE:


IN MULTIPLE HORIZONTAL MOUNTINGS PLACE A ROUTE MARKER ASSEMBLY INDICATING A LEFT TURN ON THE LEFT SIDE OF THE ASSEMBLY; RIGHT TURN ON THE RIGHT SIDE. FOR VERTICALLY STACKED MOUNTINGS PLACE THE STRAIGHT THROUGH MOVE INDICATION ON TOP, THE LEFT OR RIGHT TURNS AS APPROPRIATE BENEATH.

NOTES:

- ALL DIMENSIONS SHOWN IN INCHES UNLESS OTHERWISE NOTED.
- VERTICAL FRAME MEMBERS SHALL LINE UP WITH SIGN POST ON WHICH THEY ARE MOUNTED.

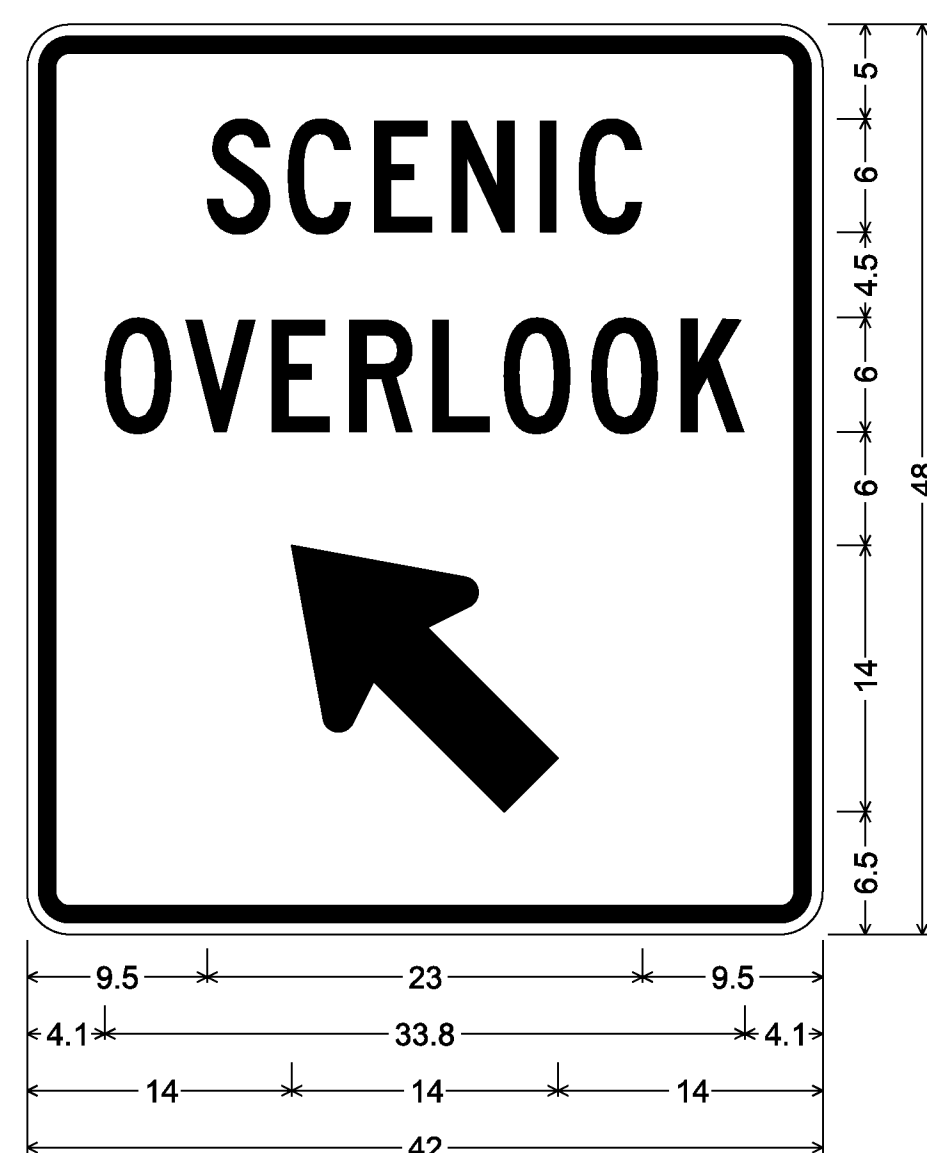

D5-2L
2.3" Radius, 0.9" Border, 0.6" Indent, White on Blue;
[SCENIC] C 2K; [OVERLOOK] C 2K;

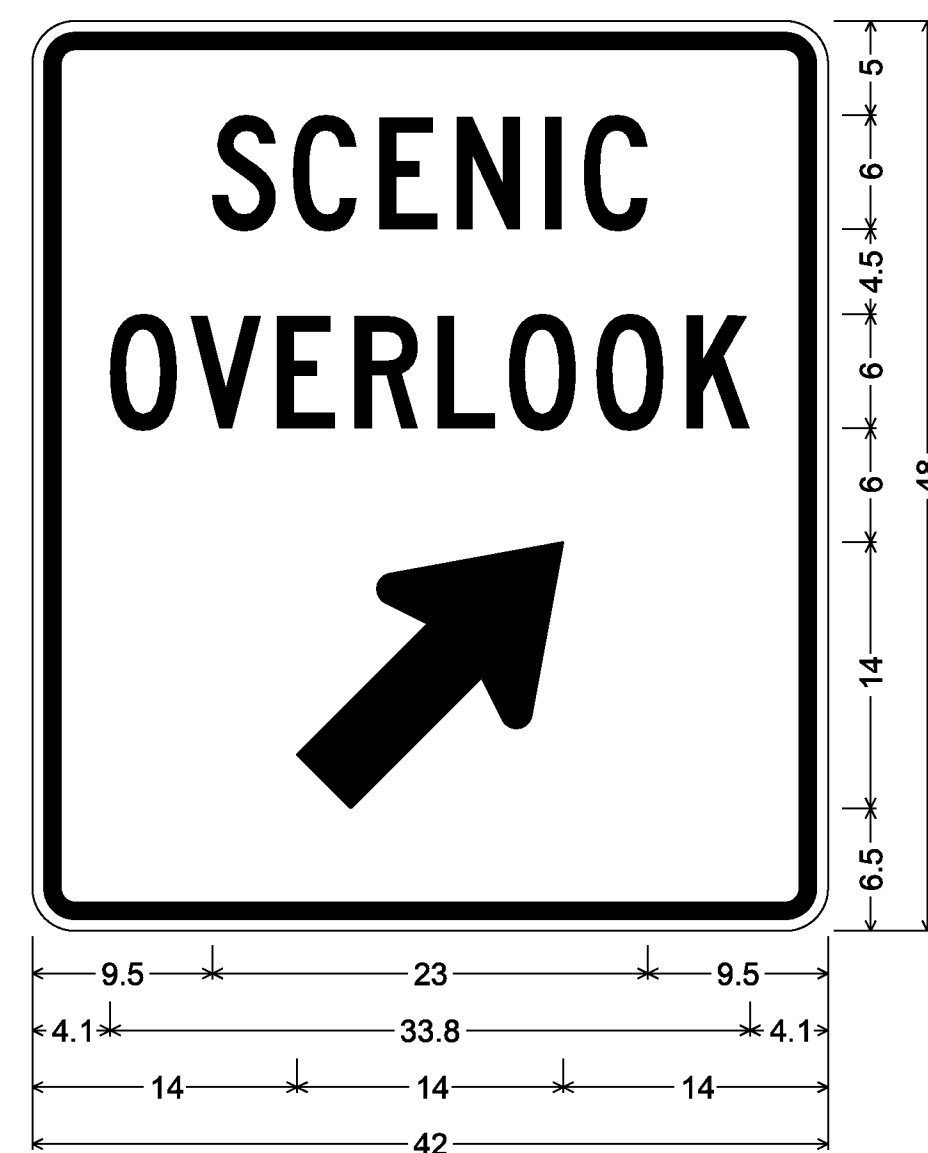

D5-2R
2.3" Radius, 0.9" Border, 0.6" Indent, White on Blue;
[SCENIC] C 2K; [OVERLOOK] C 2K;

ALL DIMENSIONS SHOWN IN INCHES UNLESS OTHERWISE NOTED.








PROJECT NAME: WOODFORD - MARLBORO


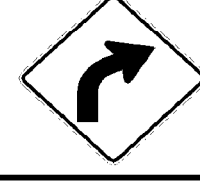


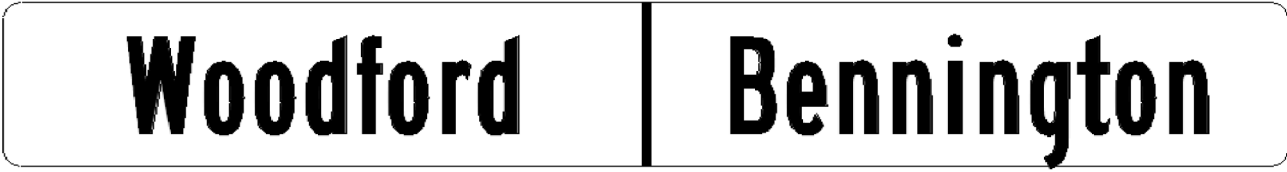


PROJECT NUMBER: STPG SIGN (35)


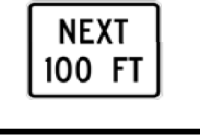



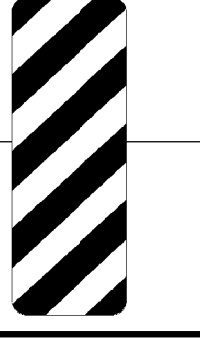
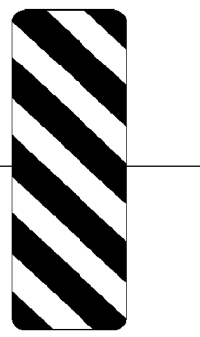

FILE NAME: IOB336_TS.DGN
PROJECT LEADER: A. GAMBLE
DESIGNED BY: J. KELLY
SIGN DETAILS 5


PLOT DATE: 17-APR-2012
DRAWN BY: J. KELLY
CHECKED BY: A. GAMBLE
SHEET 9 OF 80








NOT TO SCALE







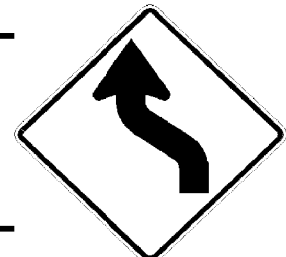


DIRECTION	MILEPOINT	LOCATION CODE (SHEET 2)	SIGN CODE	WIDTH (IN)	HEIGHT (IN)	SHEETING REMARKS	SIGN LEGEND	NEW SIGNS		EXISTING SIGNS				EXIST POST		NUMBER OF NEW POSTS	SQUARE STEEL (IN)			TUBULAR STEEL Ø (IN)				SIGN FRAME REQUIRED	REMARKS	SIGN DETAIL LOCATION			
								"A"	"B"	RETAIN	SALVAGE FROM	SALVAGE TO	REMOVE	RETAIN	REMOVE		1.75	2.00	2.50	FOUNDATION	3.0	3.50	4.00			5.00	SHSM	PROJECT SHEET #	STANDARD SHEET #
																	(LB / FT)				(LB / FT)								
WOODFORD EB							FY-FLUORESCENT YELLOW FYG-FLUORESCENT YELLOW GREEN															"SHSM"-STANDARD HIGHWAY SIGNS AND MARKINGS							
EB	0.000	C	VD-024	60	7.5							1		X															
		C	VD-024	72	10			5.00										X							4				
		C	VD-700	6	10			0.42																	REMOVE OLD MM	E-138			
		C	VD-700	6	10			0.42																	REMOVE OLD MM	E-138			
EB	0.385	A	R2-5A	24	30		REDUCED SPEED AHEAD 					1		X											TRIM BRUSH				
		A	W3-5	36	36			9.00										X							X				
EB	0.520	A	R2-1	24	30							1		X											TRIM BRUSH				
		A	R2-1	30	36			7.50										X							INSTALL DIRECTLY ACROSS FROM WEST BOUND SL50 SIGN.	X			
EB	0.761	A	R2-1	24	30							1		X											X				
		A	R2-1	24	30			5.00										X							X				
EB	0.828	A	S1-1	30	30							1		X											INSTALL NEXT TO SCHOOL PAVEMENT MARKING.	X			
		A	S1-1	36	36	FYG		9.00										X							X				
		A	S4-3P	24	8	FYG		1.33																	X				
EB	0.873	A	S4-3P	24	8							1	X																
		A	R2-1	24	30							1																	
SIGN SUMMARY SHEET							SHEET TOTALS	37.67	0.00	0	0	0	9	0	0	8	120	0	0.0	0.0	0.0	0.0	0.0	PROJECT NAME: WOODFORD-MARLBORO					
								SF	SF	EA	EA	EA	EA	EA	EA	EA	FT	EA	LB	LB	LB	LB	PROJECT NUMBER: STPG SIGN(35)						
																							FILE NAME: 10B336						
VERMONT AGENCY OF TRANSPORTATION							TOWN DIRECTIONAL TOTALS	310.4	0.0	28.0	0.0	0.0	61	0.0	0.0	52	780.0	0		0.0				PLOT DATE: 4/10/2012					
																							DRAWN BY: J. KELLY						
																							DESIGNED BY: J. KELLY						
																							CHECKED BY: A. GAMBLE						
																							WOODFORD EB SHEET 1						
																							SHEET 10 OF 80						









DIRECTION	MILEPOINT	LOCATION CODE (SHEET 2)	SIGN CODE	WIDTH (IN)	HEIGHT (IN)	SHEETING REMARKS	SIGN LEGEND	NEW SIGNS		EXISTING SIGNS				EXIST POST		NUMBER OF NEW POSTS	SQUARE STEEL (IN)			TUBULAR STEEL Ø (IN)				SIGN FRAME REQUIRED	REMARKS	SIGN DETAIL LOCATION							
								"A"	"B"	RETAIN	SALVAGE FROM	SALVAGE TO	REMOVE	RETAIN	REMOVE		1.75	2.00	2.50	FOUNDATION	3.0	3.50	4.00			5.00	SHSM	PROJECT SHEET #	STANDARD SHEET #				
																	(LB / FT)				(LB / FT)												
WOODFORD EB							FY-FLUORESCENT YELLOW FYG-FLUORESCENT YELLOW GREEN															"SHSM"-STANDARD HIGHWAY SIGNS AND MARKINGS											
		A	D17-2	42	42			12.25							2		X											6					
EB	2.299	A	W1-2R	30	30			6.25							1		X													INSTALL 375 FEET EAST OF EXISTING RIGHT CURVE ASSEMBLY.	X		
EB	2.362	A	R4-6	24	30		TRUCK LANE 500 FEET							1		X																	
EB	2.382	A	W11-2	30	30	FYG		6.25							1		X													INSTALL 150 FEET WEST OF EXISTING PEDESTRIAN ASSEMBLY.	X		
		A	W16-9P	24	12	FYG		2.00																									
EB	2.411	A	W11-2	30	30		PEDESTRIAN							1		X																	
		A	W16-9P	24	10		AHEAD							1																			
EB	2.420	A	VR-072	24	30		ENCARE - THINK				1			X																			
		B	VR-072	24	30		ENCARE - THINK				1																						
EB	2.457	A	R4-3	24	30									1		X																	
		A	R4-3	24	30		 	5.00							1		X													REINSTALL 2.45 MILE MARKER	X		R/S MM
EB	2.483	A	D4-1	30	24									1		X																	
		A	D4-1L	30	24			5.00							1		X																
EB	2.525	A	W11-2	30	30									1		X																	
		A	W16-7	24	12		DOWNWARD LEFT ARROW							1																			
SIGN SUMMARY SHEET							SHEET TOTALS	36.75	0.00	2	0	0	8	0	0	6		90	0	0.0	0.0	0.0	0.0		PROJECT NAME: WOODFORD-MARLBORO								
								SF	SF	EA	EA	EA	EA	EA	EA	EA		FT	EA	LB	LB	LB	LB		PROJECT NUMBER: STPG SIGN(35)								
																									FILE NAME: 10B336								
VERMONT AGENCY OF TRANSPORTATION							TOWN DIRECTIONAL TOTALS	310.4	0.0	28.0	0.0	0.0	61	0.0	0.0	52		780.0	0			0.0			PLOT DATE: 4/10/2012								
																									DRAWN BY: J. KELLY								
																									DESIGNED BY: J. KELLY								
																									CHECKED BY: A. GAMBLE								
																									WOODFORD EB SHEET 3								
																									SHEET 12 OF 80								







DIRECTION	MILEPOINT	LOCATION CODE (SHEET 2)	SIGN CODE	WIDTH (IN)	HEIGHT (IN)	SHEETING REMARKS	SIGN LEGEND	NEW SIGNS		EXISTING SIGNS				EXIST POST		NUMBER OF NEW POSTS	SQUARE STEEL (IN)			TUBULAR STEEL Ø (IN)				SIGN FRAME REQUIRED	REMARKS	SIGN DETAIL LOCATION				
								"A"	"B"	RETAIN	SALVAGE FROM	SALVAGE TO	REMOVE	RETAIN	REMOVE		1.75	2.00	2.50	FOUNDATION	3.0	3.50	4.00			5.00	SHSM	PROJECT SHEET #	STANDARD SHEET #	
																	(LB / FT)				(LB / FT)									
WOODFORD EB							FY-FLUORESCENT YELLOW FYG-FLUORESCENT YELLOW GREEN																"SHSM"-STANDARD HIGHWAY SIGNS AND MARKINGS							
		A	W11-2	30	30	FYG		6.25										X								X				
		A	W16-4P	30	24	FYG		5.00																			X			
EB	2.590	A	R2-1	24	30								1																PLACED SIGN ON 8-30, COUNTED ON 8-29	
		A	R2-1	24	30			5.00										X								X				
EB	2.735	A	VW-285	30	30		FALLING ROCK SYMBOL						1																	
EB	2.792	C	VR-017	24	30								1	X	X														NOTCH RD (TH-4)	
		C	VR-017	24	30			5.00																					RETAIN POST	
EB	2.792	D	R1-1	30	30																									NOTCH RD (TH-4)
		D	R1-1	30	30			6.25										X								X			STREET SIGN R/S	
EB	2.801	A	OM3-R	12	36																									RETAIN ANCHOR
		A	OM3-R	12	36			3.00										X								X			RETAIN ANCHOR	
EB	2.853	B	OM3-L	12	36																									R/S TWO PLAQUES
		B	OM3-L	12	36			3.00																		X			RETAIN POST	
EB	2.866	A	VW-285	30	30			6.25																						INSTALL 50 FEET WEST OF LARGE ARROW.
EB	2.883	B	W1-6	48	24		RIGHT LARGE ARROW																							
SIGN SUMMARY SHEET							SHEET TOTALS	39.75	0.00	1	3	3	9	0	0	7	105	0	0.0	0.0	0.0	0.0	0.0	PROJECT NAME: WOODFORD-MARLBORO						
VERMONT AGENCY OF TRANSPORTATION							TOWN DIRECTIONAL TOTALS	310.4	0.0	28.0	0.0	0.0	61	0.0	0.0	52	780.0	0					PROJECT NUMBER: STPG SIGN(35)							
																						FILE NAME: 10B336	PLOT DATE: 4/10/2012							
																						PROJECT MANAGER: A. GAMBLE	DRAWN BY: J. KELLY							
																						DESIGNED BY: J. KELLY	CHECKED BY: A. GAMBLE							
																						WOODFORD EB SHEET 4	SHEET 13 OF 80							

DIRECTION	MILEPOINT	LOCATION CODE (SHEET 2)	SIGN CODE	WIDTH (IN)	HEIGHT (IN)	SHEETING REMARKS	SIGN LEGEND	NEW SIGNS		EXISTING SIGNS				EXIST POST		NUMBER OF NEW POSTS	SQUARE STEEL (IN) (LB / FT)			TUBULAR STEEL Ø (IN) (LB / FT)				SIGN FRAME REQUIRED	REMARKS	SIGN DETAIL LOCATION				
								"A"	"B"	RETAIN	SALVAGE FROM	SALVAGE TO	REMOVE	RETAIN	REMOVE		1.75	2.00	2.50	FOUNDATION	3.0	3.50	4.00			5.00	SHSM	PROJECT SHEET #	STANDARD SHEET #	
WOODFORD EB							FY-FLUORESCENT YELLOW FYG-FLUORESCENT YELLOW GREEN																"SHSM"-STANDARD HIGHWAY SIGNS AND MARKINGS							
EB	2.918	B	W1-6	48	24		RIGHT LARGE ARROW			1					X															
EB	2.968	B	W1-6	48	24		RIGHT LARGE ARROW			1					X															
EB	3.018	B	W1-6	48	24		RIGHT LARGE ARROW			1					X															
EB	3.048	B	W1-6	48	24		RIGHT LARGE ARROW			1					X															
EB	3.060	A	R4-3	24	30											X														
		A	R4-3	24	30			5.00									1	X									INSTALL ON WEST SIDE OF UTILITY POLE.	X		
EB	3.069	B	W1-6	48	24		RIGHT LARGE ARROW			1					X															
EB	3.336	B	W1-1R	48	48		RIGHT TURN			1					X															
		B	VW-527	30	24		TRUCKS 25 MPH			1																				
		B	W16-2	30	24		1000 FEET			1																				
EB	3.660	B	W1-6	48	24		RIGHT LARGE ARROW			1					X															
EB	3.708	B	W1-6	48	24		RIGHT LARGE ARROW			1					X															
EB	3.755	B	W1-6	48	24		RIGHT LARGE ARROW			1					X															
EB	3.986	A	M3-2	24	12											X														
		A	M1-5	24	24												X													
SIGN SUMMARY SHEET							SHEET TOTALS	5.00	0.00	11	0	0	3	0	0	1	15	0	0.0	0.0	0.0	0.0	PROJECT NAME: WOODFORD-MARLBORO							
								SF	SF	EA	EA	EA	EA	EA	EA	EA	FT	EA	LB	LB	LB	LB	PROJECT NUMBER: STPG SIGN(35)							
VERMONT AGENCY OF TRANSPORTATION							TOWN DIRECTIONAL TOTALS	310.4	0.0	28.0	0.0	0.0	61	0.0	0.0	52	780.0	0			0.0	FILE NAME: 10B336								
																				PROJECT MANAGER: A. GAMBLE										
																				DESIGNED BY: J. KELLY										
																				PLOT DATE: 4/10/2012										
																				DRAWN BY: J. KELLY										
																				CHECKED BY: A. GAMBLE										
																				SHEET 14 OF 80										

DIRECTION	MILEPOINT	LOCATION CODE (SHEET 2)	SIGN CODE	WIDTH (IN)	HEIGHT (IN)	SHEETING REMARKS	SIGN LEGEND	NEW SIGNS		EXISTING SIGNS				EXIST POST		NUMBER OF NEW POSTS	SQUARE STEEL (IN)			TUBULAR STEEL Ø (IN)				SIGN FRAME REQUIRED	REMARKS	SIGN DETAIL LOCATION			
								"A"	"B"	RETAIN	SALVAGE FROM	SALVAGE TO	REMOVE	RETAIN	REMOVE		1.75	2.00	2.50	FOUNDATION	3.0	3.50	4.00			5.00	SHSM	PROJECT SHEET #	STANDARD SHEET #
																	(LB / FT)				(LB / FT)								
WOODFORD EB							FY-FLUORESCENT YELLOW FYG-FLUORESCENT YELLOW GREEN															"SHSM"-STANDARD HIGHWAY SIGNS AND MARKINGS							
		A	R2-1	24	30		 	5.00										X						X	R/S MM				
EB	5.512	A	VW-060	30	30		HIDDEN DRIVES						1																
		A	M3-2	24	12			2.00											X							E-136B			
		A	M1-5	24	24			4.00																	E-136B				
EB	5.808	A	M3-2	24	12		EAST						1																
		A	M1-5	24	24		VERMONT ROUTE 9						1																
EB	5.911	A	VW-205	36	36								1																
		A	VW-205	36	36	FY		9.00											X						8				
EB	5.994	A	S3-1	30	30		SCHOOL BUS STOP AHEAD 						1																
		A	S3-1	36	36	FYG		9.00										X						X					
EB	6.371	A	W1-4L	30	30		LEFT REVERSE CURVE						1																
		A	W1-4L	30	30			6.25											X										
EB	6.540	A	VW-054R	30	30		HIDDEN DRIVE RIGHT						1																
EB	6.785	A	VW-054R	30	30								1																
SIGN SUMMARY SHEET							SHEET TOTALS	41.50	0.00	0	2	2	10	0	0	8	120	0	0.0	0.0	0.0	0.0	PROJECT NAME: WOODFORD-MARLBORO						
VERMONT AGENCY OF TRANSPORTATION							TOWN DIRECTIONAL TOTALS	310.4	0.0	28.0	0.0	0.0	61	0.0	0.0	52	780.0	0		0.0			PROJECT NUMBER: STPG SIGN(35)						
																						FILE NAME: 10B336							
																						PLOT DATE: 4/10/2012							
																						DRAWN BY: J. KELLY							
																						CHECKED BY: A. GAMBLE							
																						DESIGNED BY: J. KELLY							
																						WOODFORD EB SHEET 7							
																						SHEET 16 OF 80							

DIRECTION	MILEPOINT	LOCATION CODE (SHEET 2)	SIGN CODE	WIDTH (IN)	HEIGHT (IN)	SHEETING REMARKS	SIGN LEGEND	NEW SIGNS		EXISTING SIGNS				EXIST POST		NUMBER OF NEW POSTS	SQUARE STEEL (IN)			TUBULAR STEEL Ø (IN)				SIGN FRAME REQUIRED	REMARKS	SIGN DETAIL LOCATION			
								"A"	"B"	RETAIN	SALVAGE FROM	SALVAGE TO	REMOVE	RETAIN	REMOVE		1.75	2.00	2.50	FOUNDATION	3.0	3.50	4.00			5.00	SHSM	PROJECT SHEET #	STANDARD SHEET #
																	(LB / FT)				(LB / FT)								
WOODFORD EB							FY-FLUORESCENT YELLOW FYG-FLUORESCENT YELLOW GREEN																"SHSM"-STANDARD HIGHWAY SIGNS AND MARKINGS						
		A	VW-054R	30	30			6.25								1		X									8		
EB	7.000	A	VW-000	30	30		 	6.25								1		X						INSTALL NEW AT POLE #2/199/20T			8		
		A	W7-3A	24	18			3.00																	X				
EB	7.174	A	VW-054																										
		A	VW-054R	30	30			6.25								1		X									8		
EB	7.360	A	VW-054R	30	30		HIDDEN DRIVES RIGHT (SIGN IS MISSING)																				NOTHING THERE		
EB	7.375	A	VW-054R	30	30			6.25								1		X						INSTALL 80 FEET EAST OF EXISTING HIDDEN DRIVE RIGHT SIGN.			8		
EB	8.100	A	R3-9CP	30	12			2.50								1		X						INSTALL 160 FEET WEST OF EXISTING BEGIN NO PARKING ASSEMBLY.	X				
		A	R8-3A	24	24			4.00																	X				
EB	8.131	A	R3-9CP	24	12		BEGIN																						
		A	R8-3A	24	24		NO PARKING SYMBOL																						
EB	8.147	A	W11-2	30	30																								
		A	W11-2	30	30	FYG		6.25								1		X								X			
		A	W16-4P	30	24	FYG		5.00																		X			
EB	8.192	A	R8-3A	24	24		NO PARKING ASSEMBLY IS MISSING																				NOTHING THERE		
SIGN SUMMARY SHEET							SHEET TOTALS	45.75	0.00	0	0	0	4 6	0	0	6		90	0	0.0	0.0	0.0	0.0		PROJECT NAME: WOODFORD-MARLBORO PROJECT NUMBER: STPG SIGN(35)				
								SF	SF	EA	EA	EA	EA	EA	EA	EA	FT	EA	LB	LB	LB	LB		FILE NAME: 10B336 PLOT DATE: 4/10/2012 PROJECT MANAGER: A. GAMBLE DRAWN BY: J. KELLY DESIGNED BY: J. KELLY CHECKED BY: A. GAMBLE WOODFORD EB SHEET 8 SHEET 17 OF 80					
VERMONT AGENCY OF TRANSPORTATION							TOWN DIRECTIONAL TOTALS	310.4	0.0	28.0	0.0	0.0	61	0.0	0.0	52		780.0	0		0.0								






DIRECTION	MILEPOINT	LOCATION CODE (SHEET 2)	SIGN CODE	WIDTH (IN)	HEIGHT (IN)	SHEETING REMARKS	SIGN LEGEND	NEW SIGNS		EXISTING SIGNS				EXIST POST		NUMBER OF NEW POSTS	SQUARE STEEL (IN)			TUBULAR STEEL Ø (IN)				SIGN FRAME REQUIRED	REMARKS	SIGN DETAIL LOCATION			
								"A"	"B"	RETAIN	SALVAGE FROM	SALVAGE TO	REMOVE	RETAIN	REMOVE		1.75	2.00	2.50	FOUNDATION	3.0	3.50	4.00			5.00	SHSM	PROJECT SHEET #	STANDARD SHEET #
																	(LB / FT)				(LB / FT)								
WOODFORD EB							FY-FLUORESCENT YELLOW FYG-FLUORESCENT YELLOW GREEN																"SHSM"-STANDARD HIGHWAY SIGNS AND MARKINGS						
			A	R8-3A	24	24		4.00										X							X				
EB	8.246		A	R8-3A	24	24																							
			A	R8-3A	24	24		4.00										X							X				
			A	W11A-2	30	30	PEDESTRIAN WITH CROSSWALK																						
EB	8.260		C	VR-017	24	30																							
			C	VR-020	24	30																							
			C	VR-017	24	30		5.00																				RETAIN POSTS 7	
			C	VR-020	24	30		5.00																				7	
EB	8.264		D	R1-1	30	30																							
			D	R1-1	30	30		6.25																					
EB	8.283		A	R8-3A	24	24	NO PARKING SIGN ASSEMBLY IS MISSING.																					NOTHING THERE	
			A	R8-3A	24	24		4.00																					
EB	8.323		A	VD-537	30	18	RECREATION PARKING (UP)																						
EB	8.351		A	VW-054L	30	30	HIDDEN DRIVE LEFT																						
EB	8.365		A	D4-1L	30	24		5.00																					
SIGN SUMMARY SHEET							SHEET TOTALS	33.25	0.00	2	0	0	6	0	0	6	90	0	0.0	0.0	0.0	0.0	0.0	PROJECT NAME: WOODFORD-MARLBORO					
								SF	SF	EA	EA	EA	EA	EA	EA	EA	FT	EA	LB	LB	LB	LB	PROJECT NUMBER: STPG SIGN(35)						
							TOWN DIRECTIONAL TOTALS	310.4	0.0	28.0	0.0	0.0	61	0.0	0.0	52	780.0	0		0.0			FILE NAME: 10B336	PLOT DATE: 4/10/2012					
VERMONT AGENCY OF TRANSPORTATION																							PROJECT MANAGER: A. GAMBLE	DRAWN BY: J. KELLY					
																						DESIGNED BY: J. KELLY	CHECKED BY: A. GAMBLE						
																						WOODFORD EB SHEET 9	SHEET 18 OF 80						










DIRECTION	MILEPOINT	LOCATION CODE (SHEET 2)	SIGN CODE	WIDTH (IN)	HEIGHT (IN)	SHEETING REMARKS	SIGN LEGEND	NEW SIGNS		EXISTING SIGNS				EXIST POST		NUMBER OF NEW POSTS	SQUARE STEEL (IN)			TUBULAR STEEL Ø (IN)				SIGN FRAME REQUIRED	REMARKS	SIGN DETAIL LOCATION					
								"A"	"B"	RETAIN	SALVAGE FROM	SALVAGE TO	REMOVE	RETAIN	REMOVE		1.75	2.00	2.50	FOUNDATION	3.0	3.50	4.00			5.00	SHSM	PROJECT SHEET #	STANDARD SHEET #		
																	(LB / FT)				(LB / FT)										
WOODFORD EB							FY-FLUORESCENT YELLOW FYG-FLUORESCENT YELLOW GREEN																"SHSM"-STANDARD HIGHWAY SIGNS AND MARKINGS								
EB	8.375	A	VD-537	30	18		RECREATION PARKING (LEFT)																								
		B	VD-537	30	18		RECREATION PARKING (RIGHT)																								
																															
EB	8.400	A	R3-9DP	30	12			2.50							1			X										INSTALL AT END OF GUARDRAIL AND WEST OF MAILBOXES (60 FEET WEST OF EXISTING).	X		
		A	R8-3A	24	24			4.00																					X		
EB	8.412	A	R8-3A	24	24		END																								
		A	M4-6P	24	12		NO PARKING SYMBOL																								
EB	8.436	A	VW-205	30	30		WATCH FOR TURNING VEHICLES																								
EB	8.477	A	VD-062BRN	72	16		BUSINESS SIGN				1																				
EB	9.118	C	VR-017	24	30		POST PRESENT BUT NO SIGN.																								
		C	VR-017	24	30			5.00																							
EB	9.122	D	R1-1	30	30																										
		D	R1-1	30	30			6.25																							
EB	9.213	A	VW-000	30	30		MOOSE CROSSING				1																				
		A	W7-3aP	24	18		NEXT 2 MILES				1																				
EB	9.304	A	R2-1	24	30			5.00																							
SIGN SUMMARY SHEET							SHEET TOTALS	22.75	0.00	3	0	0	8	0	0	4	60	0	0.0	0.0	0.0	0.0	0.0	PROJECT NAME: WOODFORD-MARLBORO							
								SF	SF	EA	EA	EA	EA	EA	EA	EA	FT	EA	LB	LB	LB	LB	PROJECT NUMBER: STPG SIGN(35)								
																								FILE NAME: 10B336							
VERMONT AGENCY OF TRANSPORTATION							TOWN DIRECTIONAL TOTALS	310.4	0.0	28.0	0.0	0.0	61	0.0	0.0	52	780.0	0			0.0			PLOT DATE: 4/10/2012							
																								DRAWN BY: J. KELLY							
																								CHECKED BY: A. GAMBLE							
																								DESIGNED BY: J. KELLY							
																								WOODFORD EB SHEET 10							
																								SHEET 19 OF 80							




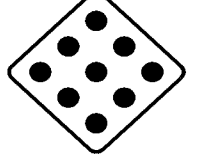


DIRECTION	MILEPOINT	LOCATION CODE (SHEET 2)	SIGN CODE	WIDTH (IN)	HEIGHT (IN)	SHEETING REMARKS	SIGN LEGEND	NEW SIGNS		EXISTING SIGNS				EXIST POST		NUMBER OF NEW POSTS	SQUARE STEEL (IN)			TUBULAR STEEL Ø (IN)				SIGN FRAME REQUIRED	REMARKS	SIGN DETAIL LOCATION			
								"A"	"B"	RETAIN	SALVAGE FROM	SALVAGE TO	REMOVE	RETAIN	REMOVE		1.75	2.00	2.50	FOUNDATION	3.0	3.50	4.00			5.00	SHSM	PROJECT SHEET #	STANDARD SHEET #
																	(LB / FT)				(LB / FT)								
WOODFORD EB							FY-FLUORESCENT YELLOW FYG-FLUORESCENT YELLOW GREEN																"SHSM"-STANDARD HIGHWAY SIGNS AND MARKINGS						
EB	9.561	A	R2-1	24	30		SPEED LIMIT 50					1		X															
SIGN SUMMARY SHEET							SHEET TOTALS	0.00	0.00	0	0	0	1	0	0	0	0	0.0	0.0	0.0	0.0	0	0.0	0.0	0.0	0.0	PROJECT NAME: WOODFORD-MARLBORO		
VERMONT AGENCY OF TRANSPORTATION							TOWN DIRECTIONAL TOTALS	310.4	0.0	28.0	0.0	0.0	61	0.0	0.0	52	780.0	0			0.0	0					PROJECT NUMBER: STPG SIGN(35)		
																											FILE NAME: 10B336		
																											PLOT DATE: 4/10/2012		
																											DRAWN BY: J. KELLY		
																											CHECKED BY: A. GAMBLE		
																											SHEET 20 OF 80		
																											WOODFORD EB SHEET 11		


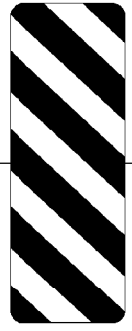





PER JOE KELLY - RETAIN FOLDED SPTA ASSEMBLIES.
NOT SHOWN ON PLANS






SIGN LEGEND





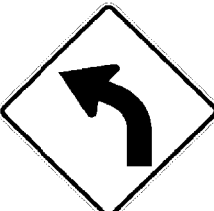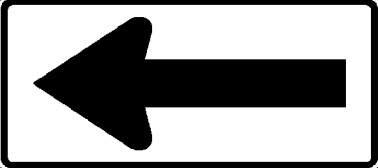

DIRECTION	MILEPOINT	LOCATION CODE (SHEET 2)	SIGN CODE	WIDTH (IN)	HEIGHT (IN)	SHEETING REMARKS	SIGN LEGEND	NEW SIGNS		EXISTING SIGNS				EXIST POST		NUMBER OF NEW POSTS	SQUARE STEEL (IN)			TUBULAR STEEL Ø (IN)				SIGN FRAME REQUIRED	REMARKS	SIGN DETAIL LOCATION			
								"A"	"B"	RETAIN	SALVAGE FROM	SALVAGE TO	REMOVE	RETAIN	REMOVE		1.75	2.00	2.50	FOUNDATION	3.0	3.50	4.00			5.00	SHSM	PROJECT SHEET #	STANDARD SHEET #
																	(LB / FT)				(LB / FT)								
WOODFORD WB							FY-FLUORESCENT YELLOW FYG-FLUORESCENT YELLOW GREEN																"SHSM"-STANDARD HIGHWAY SIGNS AND MARKINGS						
WB	9.561	F	R2-1	24	30		SPEED LIMIT 50			1					X														
WB	9.221	F	W11-6H	30	30		SNOWMOBILE CROSSING SIGN																	REMOVE SIGNAGE DUE TO ADEQUATE SSD.		NO SIGN OR POST			
		F	W16-4P	30	24		NEXT 500 FEET																						
WB	9.092	F					EMPTY POST																						
WB	8.882	F	VD-062BRN	72	16		BUSINESS SIGN			1					X														
WB	8.544 8.629	F	VW-205	36	36		WATCH FOR TURNING VEHICLES 	9.00																					
WB	8.497	F	VD-537	30	18		RECREATION PARKING																						
		F	VD-411	12	18		STATE PARK AHEAD																						
		F	W11-2	30	30	FYG		6.25																		X			
		F	W16-9P	24	12	FYG		2.00																		X			
WB	8.441	F	VW-205	36	36		WATCH FOR TURNING VEHICLES (MISSING SIGN) 																						
		F	D4-1R	30	24			5.00																		X			
		F	VD4-1	30	12			2.50																					
WB	8.413	F	R8-3A	24	24		NO PARKING SYMBOL																						
		F	VR-644P	24	12		BEGIN																						
SIGN SUMMARY SHEET							SHEET TOTALS	24.75	0.00	2	2	2	7	0	0	4	60	0	0.0	0.0	0.0	0.0	0.0	PROJECT NAME: WOODFORD-MARLBORO PROJECT NUMBER: STPG SIGN(35)					
								SF	SF	EA	EA	EA	EA	EA	EA	EA	FT	EA	LB	LB	LB	LB	FILE NAME: 10B336 PLOT DATE: 4/10/2012 PROJECT MANAGER: A. GAMBLE DRAWN BY: J. KELLY DESIGNED BY: J. KELLY CHECKED BY: A. GAMBLE WOODFORD WB SHEET 1 SHEET 21 OF 80						
VERMONT AGENCY OF TRANSPORTATION							TOWN DIRECTIONAL TOTALS	260.8	0.0	9.0	4.0	4.0	60	0.0	0.0	48	720.0	0		0.0									








DIRECTION	MILEPOINT	LOCATION CODE (SHEET 2)	SIGN CODE	WIDTH (IN)	HEIGHT (IN)	SHEETING REMARKS	SIGN LEGEND	NEW SIGNS		EXISTING SIGNS				EXIST POST		NUMBER OF NEW POSTS	SQUARE STEEL (IN)			TUBULAR STEEL Ø (IN)				SIGN FRAME REQUIRED	REMARKS	SIGN DETAIL LOCATION			
								"A"	"B"	RETAIN	SALVAGE FROM	SALVAGE TO	REMOVE	RETAIN	REMOVE		1.75	2.00	2.50	FOUNDATION	3.0	3.50	4.00			5.00	SHSM	PROJECT SHEET #	STANDARD SHEET #
																	(LB / FT)				(LB / FT)								
WOODFORD WB							FY-FLUORESCENT YELLOW FYG-FLUORESCENT YELLOW GREEN															"SHSM"-STANDARD HIGHWAY SIGNS AND MARKINGS							
WB	6.868	F	W1-4L	30	30			6.25										X						INSTALL 250 FEET WEST OF EXISTING LEFT REVERSE CURVE ASSEMBLY.	X				
		F	W13-1	18	18			2.25																	X	INSTALLED 40 MPH			
WB	6.825	F	S3-1	36	36	FYG		9.00										X						INSTALL 200 FEET IN ADVANCE OF EXISTING HIDDEN DRIVE RIGHT ASSEMBLY.	X				
WB	6.799	F	S3-1	30	30		SCHOOL BUS STOP AHEAD																						
WB	6.787	F	VW-054R	30	30		HIDDEN DRIVE RIGHT																						
		F	VW-054R	30	30		 0090 0217 0680	6.25										X								R/S MM	8		
WB	6.329	F	VW-133R	30	30		HIDDEN DRIVES RIGHT																						
WB	6.200	F	S3-1	30	30																								
		F	S3-1	36	36	FYG	 0090 0217 0620	9.00										X								X	R/S MM		
WB	5.825	F	S3-1	30	30																								
		F	S3-1	36	36	FYG		9.00										X								X			
WB	5.573	F	VD-062B	72	16		BUSINESS SIGN																						
WB	5.403	F	VD-062C	74.75	16		BUSINESS SIGN																						
		F	VD-062BC	74.75	16		 0090 0217 0536																						
WB	5.360	F	VW-054R	30	30		HIDDEN DRIVE RIGHT																				R/S MM		
SIGN SUMMARY SHEET							SHEET TOTALS	41.75	0.00	2	5 2	5 2	10 7	0	0	10		150	0	0.0	0.0	0.0	0.0		PROJECT NAME: WOODFORD-MARLBORO PROJECT NUMBER: STPG SIGN(35)				
VERMONT AGENCY OF TRANSPORTATION							TOWN DIRECTIONAL TOTALS	260.8	0.0	9.0	4.0	4.0	60	0.0	0.0	48		720.0	0		0.0				FILE NAME: 10B336 PLOT DATE: 4/10/2012 PROJECT MANAGER: A. GAMBLE DRAWN BY: J. KELLY DESIGNED BY: J. KELLY CHECKED BY: A. GAMBLE WOODFORD WB SHEET 3 SHEET 23 OF 80				











DIRECTION	MILEPOINT	LOCATION CODE (SHEET 2)	SIGN CODE	WIDTH (IN)	HEIGHT (IN)	SHEETING REMARKS	SIGN LEGEND	NEW SIGNS		EXISTING SIGNS				EXIST POST		NUMBER OF NEW POSTS	SQUARE STEEL (IN)			TUBULAR STEEL Ø (IN)				SIGN FRAME REQUIRED	REMARKS	SIGN DETAIL LOCATION			
								"A"	"B"	RETAIN	SALVAGE FROM	SALVAGE TO	REMOVE	RETAIN	REMOVE		1.75	2.00	2.50	FOUNDATION	3.0	3.50	4.00			5.00	SHSM	PROJECT SHEET #	STANDARD SHEET #
																	(LB / FT)				(LB / FT)								
WOODFORD WB							FY-FLUORESCENT YELLOW FYG-FLUORESCENT YELLOW GREEN															"SHSM"-STANDARD HIGHWAY SIGNS AND MARKINGS							
		F	VW-133R	30	30			6.25							1	X										8			
SKIP TO TRUCK RAMP DUE TO RECENT SIGN REPLACEMENTS																													
WB	3.300	F	R3-9cP	30	12			2.50							1	X								INSTALL 100 FEET EAST OF EXISTING BEGIN NO PARKING SIGN ASSEMBLY.	X				
		F	R8-3	24	24			4.00																	X				
WB	3.280	F	VR-644P	24	12		BEGIN																						
		F	R8-3A	24	24		NO PARKING																						
WB	3.254	F	OM1-1	18	18																								
		F	OM1-1	18	18			2.25							1	X									X				
WB	3.251	F	W7-4B	78	60		RUNAWAY TRUCK RAMP(UP 45 RIGHT ARROW)			1																			
WB	3.239	F	M4-6P	24	12																								
		F	R8-3A	24	24																								
		F	R3-9dP	30	12			2.50							1	X									X				
		F	R8-3	24	24			4.00																	X				
WB	3.162	F	W1-1R	48	48		RIGHT TURN			1																			
		F	VW-527	30	24		TRUCKS 25 MPH			1																			
SIGN SUMMARY SHEET							SHEET TOTALS	21.50	0.00	3	0	0	5	0	0	4	60	0	0.0	0.0	0.0	0.0	0.0	PROJECT NAME: WOODFORD-MARLBORO					
VERMONT AGENCY OF TRANSPORTATION							TOWN DIRECTIONAL TOTALS	260.8	0.0	9.0	4.0	4.0	60	0.0	0.0	48	720.0	0		0.0				PROJECT NUMBER: STPG SIGN(35)					
																							FILE NAME: 10B336						
																							PLOT DATE: 4/10/2012						
																							DRAWN BY: J. KELLY						
																							CHECKED BY: A. GAMBLE						
																							SHEET 24 OF 80						

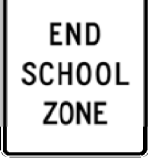
DIRECTION	MILEPOINT	LOCATION CODE (SHEET 2)	SIGN CODE	WIDTH (IN)	HEIGHT (IN)	SHEETING REMARKS	SIGN LEGEND	NEW SIGNS		EXISTING SIGNS				EXIST POST		NUMBER OF NEW POSTS	SQUARE STEEL (IN)			TUBULAR STEEL Ø (IN)				SIGN FRAME REQUIRED	REMARKS	SIGN DETAIL LOCATION							
								"A"	"B"	RETAIN	SALVAGE FROM	SALVAGE TO	REMOVE	RETAIN	REMOVE		1.75	2.00	2.50	FOUNDATION	3.0	3.50	4.00			5.00	SHSM	PROJECT SHEET #	STANDARD SHEET #				
																	(LB / FT)				(LB / FT)												
WOODFORD WB							FY-FLUORESCENT YELLOW FYG-FLUORESCENT YELLOW GREEN																"SHSM"-STANDARD HIGHWAY SIGNS AND MARKINGS										
WB	3.100	F	VW-285	30	30		FALLING ROCK			1				X																			
WB	2.843	F	OM-3R	12	36								1	X	X																		
		F	OM3-R	12	36			3.00								X											X					RETAIN POST	
WB	2.793	E	OM-3L	12	36								1		X																		
		E	OM3-L	12	36			3.00																			X					RETAIN ANCHOR	
WB	2.680	F	W11-2	30	30										1		X																
		F	W16-9	24	10										1																		
		F	W11-2	30	30	FYG		6.25																				X					
		F	W16-9P	24	10 ¹²	FYG		1.67 ^{2.00}																				X					
WB	2.570	F	W11-2	30	30										1		X																
		F	W16-7	24	12		DIAGONAL ARROW								1																		
		F	W11-2	30	30	FYG		6.25																				X					
		A	W16-4P	30	24	FYG		5.00																				X					
WB	2.534	F	D4-1R	30	24			5.00																				X					INSTALL IN LINE WITH NATIONAL FOREST WOODEN SIGN.
WB	2.519	F	D4-1	30	24		PARKING RIGHT ARROW								1		X																
SIGN SUMMARY SHEET							SHEET TOTALS	30.50 ^{30.17}	0.00	1	0	0	7	0	0	5	75	0	0.0	0.0	0.0	0.0	0.0	PROJECT NAME: WOODFORD-MARLBORO									
								SF	SF	EA	EA	EA	EA	EA	EA	EA	FT	EA	LB	LB	LB	LB	LB	PROJECT NUMBER: STPG SIGN(35)									
																								FILE NAME: 10B336									
VERMONT AGENCY OF TRANSPORTATION							TOWN DIRECTIONAL TOTALS	260.8	0.0	9.0	4.0	4.0	60	0.0	0.0	48	720.0	0			0.0			PLOT DATE: 4/10/2012									
																								DRAWN BY: J. KELLY									
																								DESIGNED BY: J. KELLY									
																								CHECKED BY: A. GAMBLE									
																								WOODFORD WB SHEET 5									
																								SHEET 25 OF 80									

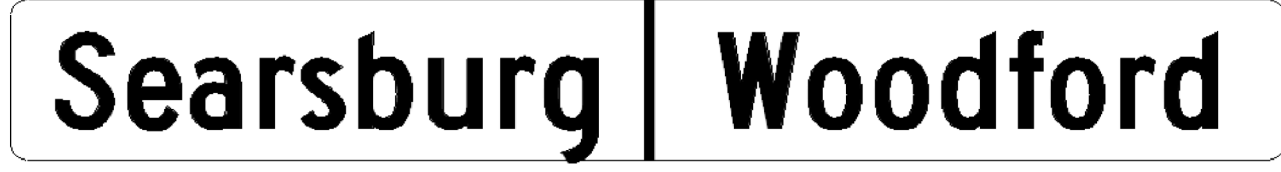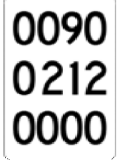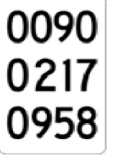DIRECTION	MILEPOINT	LOCATION CODE (SHEET 2)	SIGN CODE	WIDTH (IN)	HEIGHT (IN)	SHEETING REMARKS	SIGN LEGEND	NEW SIGNS		EXISTING SIGNS				EXIST POST		NUMBER OF NEW POSTS	SQUARE STEEL (IN)			TUBULAR STEEL Ø (IN)				SIGN FRAME REQUIRED	REMARKS	SIGN DETAIL LOCATION										
								"A"	"B"	RETAIN	SALVAGE FROM	SALVAGE TO	REMOVE	RETAIN	REMOVE		1.75	2.00	2.50	FOUNDATION	3.0	3.50	4.00			5.00	SHSM	PROJECT SHEET #	STANDARD SHEET #							
																	(LB / FT)				(LB / FT)															
WOODFORD WB							FY-FLUORESCENT YELLOW FYG-FLUORESCENT YELLOW GREEN															"SHSM"-STANDARD HIGHWAY SIGNS AND MARKINGS														
WB	2.500	F	W1-2L	30	30		CURVE LEFT																													
		F	W13-1	18	18		45 MPH ADVISORY																													
WB	2.438	F	W1-2L	30	30	FY		6.25																									INSTALL 325 FEET WEST OF EXISTING LEFT CURVE WARNING SIGN ASSEMBLY.	X		
WB	2.395	F	W1-8L	18	24		CHEVRON																													
WB	2.377	F	W1-8L	18	24		CHEVRON																													
		F	W1-6L	48	24	FY		8.00																										X		
WB	2.355	F	W1-8L	18	24		CHEVRON																													
WB	2.278	F	M3-4	24	12																															
		F	M1-5	24	24																															
		F	M3-4	24	12			2.00																										E-136B		
		F	M1-5	24	24			4.00																										E-136B		
		F	VM-120	18	24		MOLLY STARK BYWAY																										REINSTALL ON THE NEW POST BELOW ROUTE MARKER.			
WB	2.165	F	VW-619	30	30																															
		F	VW-619	30	30			6.25																										8		
WB	1.640	F	R2-5A	24	30		REDUCED SPEED AHEAD																													
SIGN SUMMARY SHEET							SHEET TOTALS	26.50	0.00	0	1	1	10 9	0	0	5	75	0	0.0	0.0	0.0	0.0	0.0		PROJECT NAME: WOODFORD-MARLBORO PROJECT NUMBER: STPG SIGN(35)											
VERMONT AGENCY OF TRANSPORTATION							TOWN DIRECTIONAL TOTALS	260.8	0.0	9.0	4.0	4.0	60	0.0	0.0	48	720.0	0			0.0				FILE NAME: 10B336 PLOT DATE: 4/10/2012 PROJECT MANAGER: A. GAMBLE DRAWN BY: J. KELLY DESIGNED BY: J. KELLY CHECKED BY: A. GAMBLE WOODFORD WB SHEET 6 SHEET 26 OF 80											





DIRECTION	MILEPOINT	LOCATION CODE (SHEET 2)	SIGN CODE	WIDTH (IN)	HEIGHT (IN)	SHEETING REMARKS	SIGN LEGEND	NEW SIGNS		EXISTING SIGNS				EXIST POST		NUMBER OF NEW POSTS	SQUARE STEEL (IN)			TUBULAR STEEL Ø (IN)				SIGN FRAME REQUIRED	REMARKS	SIGN DETAIL LOCATION			
								"A"	"B"	RETAIN	SALVAGE FROM	SALVAGE TO	REMOVE	RETAIN	REMOVE		1.75	2.00	2.50	FOUNDATION	3.0	3.50	4.00			5.00	SHSM	PROJECT SHEET #	STANDARD SHEET #
																	(LB / FT)				(LB / FT)								
WOODFORD WB							FY-FLUORESCENT YELLOW FYG-FLUORESCENT YELLOW GREEN																"SHSM"-STANDARD HIGHWAY SIGNS AND MARKINGS						
WB	1.604	F	VD-018	30	18		WOODFORD HOLLOW VILLAGE SIGN BENNINGTON 4						1		X														
		F	W3-5	36	36			9.00									X								X				
WB	1.563	F	S3-1	30	30		SCHOOL BUS STOP AHEAD 						1		X														
		F	S3-1	36	36	FYG		9.00									X								X				
WB	1.495	F	R2-1	24	30								1		X														
		F	R2-1	30	36			7.50									X								INSTALL DIRECTLY ACROSS FROM EB SPEED LIMIT 50 SIGN.	X			
WB	1.445	F	R2-1	24	30		SPEED LIMIT 40						1		X														
WB	1.433	G	VR-017	24	30								1		X										HARBOUR RD (TH-1)				
		G	VR-017	24	30			5.00									X									7			
WB	1.413	H	R1-1	30	30		 0090 0217 0142						1		X										HARBOUR RD (TH-1)		R/S MM		
		H	R1-1	30	30			6.25									X									X			
		F	D3-1				STREET NAME SIGN				1	1	1												REINSTALL ABOVE NEW STOP SIGN.				
WB	1.285	F	VD-060	30	30		HIDDEN DRIVES T. BUCK REMOVED						+		X												* IN CONSTRUCTION AREA T. BUCK WILL INSTALL GIVEN TO LEE ABLE		
		F	R2-1	24	30		 T. BUCK WILL INSTALL AT A LATER DATE.	5.00									X									X			
WB	1.189	F	R2-1	24	30		SPEED LIMIT 40 MISSING						+		X												MISSING		
SIGN SUMMARY SHEET							SHEET TOTALS	41.75	0.00	0	2 4	2 4	8 9	0	0	8	120	0	0.0	0.0	0.0	0.0	PROJECT NAME: WOODFORD-MARLBORO PROJECT NUMBER: STPG SIGN(35)						
								SF	SF	EA	EA	EA	EA	EA	EA	EA	FT	EA	LB	LB	LB	LB	FILE NAME: 10B336 PLOT DATE: 4/10/2012 PROJECT MANAGER: A. GAMBLE DRAWN BY: J. KELLY DESIGNED BY: J. KELLY CHECKED BY: A. GAMBLE WOODFORD WB SHEET 7 SHEET 27 OF 80						
VERMONT AGENCY OF TRANSPORTATION							TOWN DIRECTIONAL TOTALS	260.8	0.0	9.0	4.0	4.0	60	0.0	0.0	48	720.0	0		0.0									




DIRECTION	MILEPOINT	LOCATION CODE (SHEET 2)	SIGN CODE	WIDTH (IN)	HEIGHT (IN)	SHEETING REMARKS	SIGN LEGEND	NEW SIGNS		EXISTING SIGNS				EXIST POST		NUMBER OF NEW POSTS	SQUARE STEEL (IN)			TUBULAR STEEL Ø (IN)				SIGN FRAME REQUIRED	REMARKS	SIGN DETAIL LOCATION			
								"A"	"B"	RETAIN	SALVAGE FROM	SALVAGE TO	REMOVE	RETAIN	REMOVE		1.75	2.00	2.50	FOUNDATION	3.0	3.50	4.00			5.00	SHSM	PROJECT SHEET #	STANDARD SHEET #
																	(LB / FT)				(LB / FT)								
WOODFORD WB							FY-FLUORESCENT YELLOW FYG-FLUORESCENT YELLOW GREEN															"SHSM"-STANDARD HIGHWAY SIGNS AND MARKINGS							
WB	1.170	F	S1-1	36	36																				T. BUCK REMOVED				
		F	S1-1	36	36	FYG	 T. BUCK WILL INSTALL AT A LATER DATE	9.00*									X								T. BUCK WILL INSTALL ONCE BRIDGE IS DONE, GIVEN TO LEE ABLE				
		F	S4-3P	24	8	FYG		1.33*																	X				
WB	1.126	F	S4-3P	24	8																								
		F	R2-1	24	30																								
		F	S4-4P	24	10																								
		F	S4-3P	24	8	FYG		1.33																	REPLACE SIGNS. RETAIN POST, FLASHING BEACON AND WIRING.				
		F	R2-1	24	30			5.00																	X				
		F	S4-4P	24	10			1.67																	X				
WB	1.053	F	D1-1E	72	20		WOODFORD HOLLOW ELEM SCHOOL (RIGHT)																						
WB	1.025	F	VD1-1	72	20			10.00																	INSTALL 150 FEET WEST OF EXISTING SCHOOL DESTINATION SIGN.				
WB	0.869	F	S5-2	30	24		END SCHOOL ZONE																						
		F	R2-1	24	30			5.00																	INSTALL DIRECTLY ACROSS FROM EB SCHOOL FLASHING BEACON ASSEMBLY.				
		F	S5-2	24	30			5.00																	X				
WB	0.779	F	R2-1	24	30		SPEED LIMIT 40																						
SIGN SUMMARY SHEET							SHEET TOTALS	38.33	0.00	0	0	0	6	0	0	5	75	0	0.0	0.0	0.0	0.0	0.0	PROJECT NAME: WOODFORD-MARLBORO PROJECT NUMBER: STPG SIGN(35)					
								SF	SF	EA	EA	EA	EA	EA	EA	EA	FT	EA	LB	LB	LB	LB	FILE NAME: 10B336 PLOT DATE: 4/10/2012 PROJECT MANAGER: A. GAMBLE DRAWN BY: J. KELLY DESIGNED BY: J. KELLY CHECKED BY: A. GAMBLE WOODFORD WB SHEET 8 SHEET 28 OF 80						
VERMONT AGENCY OF TRANSPORTATION							TOWN DIRECTIONAL TOTALS	260.8	0.0	9.0	4.0	4.0	60	0.0	0.0	48	720.0	0		0.0									


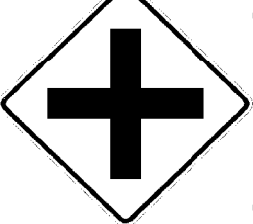




DIRECTION	MILEPOINT	LOCATION CODE (SHEET 2)	SIGN CODE	WIDTH (IN)	HEIGHT (IN)	SHEETING REMARKS	SIGN LEGEND	NEW SIGNS		EXISTING SIGNS				EXIST POST		NUMBER OF NEW POSTS	SQUARE STEEL (IN)			TUBULAR STEEL Ø (IN)				SIGN FRAME REQUIRED	REMARKS	SIGN DETAIL LOCATION			
								"A"	"B"	RETAIN	SALVAGE FROM	SALVAGE TO	REMOVE	RETAIN	REMOVE		1.75	2.00	2.50	FOUNDATION	3.0	3.50	4.00			5.00	SHSM	PROJECT SHEET #	STANDARD SHEET #
																	(LB / FT)				(LB / FT)								
SEARSBURG EB							FY-FLUORESCENT YELLOW FYG-FLUORESCENT YELLOW GREEN																"SHSM"-STANDARD HIGHWAY SIGNS AND MARKINGS						
EB	0.000	C	VD-024	60	7.5							1		X															
		C	VD-024	72	10			5.00									X									4			
		C	VD-700	6	10			0.42																	INSTALL ON LEFT POST BELOW SEARSBURG	R MM		E-138	
		C	VD-700	6	10			0.42																	INSTALL ON RIGHT POST BELOW WOODFORD	R MM		E-138	
EB	0.485	C	VR-017	24	30							1		X											OLD ROUTE 9 (TH-6)				
		C	VR-017	24	30			5.00									X										7		
EB	0.495	D	R1-1	30	30							1		X											OLD ROUTE 9 (TH-6) R/S			REMOVED SIGN FROM NEW POST AND PUT ON SAME POST AS STOP SIGN AT SEARSBURG ROAD SUPT REQUEST.	
		D	R1-1	30	30		 	6.25									X									X			
EB	0.761	C	VR-017	24	24							1	X	X											OLD ROUTE 9 (TH-6)				
		C	VR-017	24	30			5.00									X										7		
EB	0.770	D	R1-1	30	30							1	X	X											OLD ROUTE 9 (TH-6)				
		D	R1-1	30	30		 	6.25									X									X			
EB	0.795	A	M3-2	24	12							1																	
		A	M1-5	24	24							1		X															
		A	M3-2	24	12			2.00									X											E-136B	
SIGN SUMMARY SHEET							SHEET TOTALS	30.34	0.00	0	3	3	12	0	0	7	105	0	0.0	0.0	0.0	0.0	0.0	PROJECT NAME: WOODFORD-MARLBORO PROJECT NUMBER: STPG SIGN(35)					
								SF	SF	EA	EA	EA	EA	EA	EA	EA	FT	EA	LB	LB	LB	LB	FILE NAME: 10B336 PLOT DATE: 4/10/2012 PROJECT MANAGER: A. GAMBLE DRAWN BY: J. KELLY DESIGNED BY: J. KELLY CHECKED BY: A. GAMBLE						
VERMONT AGENCY OF TRANSPORTATION							TOWN DIRECTIONAL TOTALS	130.8	0.0	29.0	18.0	18.0	41	0.0	0.0	28	420.0	0		0.0				SEARSBURG EB SHEET 1 SHEET 30 OF 80					

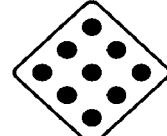


DIRECTION	MILEPOINT	LOCATION CODE (SHEET 2)	SIGN CODE	WIDTH (IN)	HEIGHT (IN)	SHEETING REMARKS	SIGN LEGEND	NEW SIGNS		EXISTING SIGNS				EXIST POST		NUMBER OF NEW POSTS	SQUARE STEEL (IN)			TUBULAR STEEL Ø (IN)				SIGN FRAME REQUIRED	REMARKS	SIGN DETAIL LOCATION			
								"A"	"B"	RETAIN	SALVAGE FROM	SALVAGE TO	REMOVE	RETAIN	REMOVE		1.75	2.00	2.50	FOUNDATION	3.0	3.50	4.00			5.00	SHSM	PROJECT SHEET #	STANDARD SHEET #
																	(LB / FT)				(LB / FT)								
SEARSBURG EB							FY-FLUORESCENT YELLOW FYG-FLUORESCENT YELLOW GREEN																"SHSM"-STANDARD HIGHWAY SIGNS AND MARKINGS						
		A	M1-5	24	24			4.00																				E-136B	
EB	1.353	A	W7-4	78	40		RUNAWAY TRUCK RAMP 1 MILE			1																			
EB	1.462	A	VW-092	30	30		UNSAFE TO PASS			1																			
EB	1.580	A	W7-1	30	30		HILL SYMBOL (8%)			1																			
		A	W7-3A	24	18		NEXT 2 MILES			1																			
EB	1.670	A	W2-2R	30	30		RIGHT SIDE ROAD			1																			
EB	1.698	A	M2-1	21	15		JCT			1																			
		A	M1-5	24	24		VERMONT ROUTE 8			1																			
EB	1.743	A	D1-1A	72	12		↑ WILMINGTON 7				1	1	1		X	2	SLIP BASES	X										REINSTALL SIGNS ON NEW POSTS AND SLIP-BASES. SEE SHEET 2.	SLIP BASES
		A	D1-1S	72	12		↑ SKI AREAS				1	1	1																
		A	D1-1A	72	12		↑ BRATTLEBORO 24				1	1	1																
		A	D1-1A	72	12		HEARTWELLVILLE 6 ---->																						
		A	D1-1A	72	12		READSBORO 11 ---->				1	1	1																
		A	D1-1A	72	12		STAMFORD 12 ---->				1	1	1																
EB	1.812	A	M3-2	24	12		ROUTE MARKER ASSEMBLY				1	1	1		X	2		X										REINSTALL SIGNS AND FRAME ON NEW POSTS WITH SLIP-BASES. SEE SHEET 2.	
SIGN SUMMARY SHEET							SHEET TOTALS	4.00	0.00	7	6	6	7	0	0	4	60	0	0.0	0.0	0.0	0.0	0.0	PROJECT NAME: WOODFORD-MARLBORO					
								SF	SF	EA	EA	EA	EA	EA	EA	EA	FT	EA	LB	LB	LB	LB	PROJECT NUMBER: STPG SIGN(35)						
																								FILE NAME: 10B336					
VERMONT AGENCY OF TRANSPORTATION							TOWN DIRECTIONAL TOTALS	130.8	0.0	29.0	18.0	18.0	41	0.0	0.0	28	420.0	0			0.0			PLOT DATE: 4/10/2012					
																								DRAWN BY: J. KELLY					
																							CHECKED BY: A. GAMBLE						
																							DESIGNED BY: J. KELLY						
																							SEARSBURG EB SHEET 2						
																							SHEET 31 OF 80						








DIRECTION	MILEPOINT	LOCATION CODE (SHEET 2)	SIGN CODE	WIDTH (IN)	HEIGHT (IN)	SHEETING REMARKS	SIGN LEGEND	NEW SIGNS		EXISTING SIGNS				EXIST POST		NUMBER OF NEW POSTS	SQUARE STEEL (IN)			TUBULAR STEEL Ø (IN)				SIGN FRAME REQUIRED	REMARKS	SIGN DETAIL LOCATION									
								"A"	"B"	RETAIN	SALVAGE FROM	SALVAGE TO	REMOVE	RETAIN	REMOVE		1.75	2.00	2.50	FOUNDATION	3.0	3.50	4.00			5.00	SHSM	PROJECT SHEET #	STANDARD SHEET #						
																	(LB / FT)				(LB / FT)														
SEARSBURG EB							FY-FLUORESCENT YELLOW FYG-FLUORESCENT YELLOW GREEN															"SHSM"-STANDARD HIGHWAY SIGNS AND MARKINGS													
		A	M1-5	24	24						1	1	1																						
		A	M6-3	21	15						1	1	1																						
		A	M3-3	24	12						1	1	1																						
		A	M1-5	24	24						1	1	1				SLIP BASES																		
		A	M6-1	21	15						1	1	1																						
		A	M4-5	24	12						1	1	1																						
		A	M3-3	24	12						1	1	1																						
		A	M1-5	30	24						1	1	1																						
		A	M6-1	21	15						1	1	1																						
EB	1.850	A	W7-1	30	30		HILL SYMBOL (8%)				1																								
		A	W7-3A	24	18		NEXT 2 MILES				1																								
EB	1.884	A	W7-4	78	40		RUNAWAY TRUCK RAMP 1/2 MILE				1																								
EB	1.905	A	D2-1	72	10		WILMINGTON 7						1																						
		A	D2-1	72	10		ACTUAL SIGN SKI-AREAS						1																						
							BRATTLEBORO 24																												
EB	1.918	A	VD2-1	72	12		Wilmington 7				6.00						SLIP BASES																		
SIGN SUMMARY SHEET							SHEET TOTALS	6.00	0.00	3	9	9	11	0	0	2		30	0	0.0	0.0	0.0	0.0	PROJECT NAME: WOODFORD-MARLBORO PROJECT NUMBER: STPG SIGN(35)											
VERMONT AGENCY OF TRANSPORTATION							TOWN DIRECTIONAL TOTALS	130.8	0.0	29.0	18.0	18.0	41	0.0	0.0	28		420.0	0		0.0		FILE NAME: 10B336 PROJECT MANAGER: A. GAMBLE DESIGNED BY: J. KELLY SEARSBURG EB SHEET 3												
																							PLOT DATE: 4/10/2012 DRAWN BY: J. KELLY CHECKED BY: A. GAMBLE SHEET 32 OF 80												



DIRECTION	MILEPOINT	LOCATION CODE (SHEET 2)	SIGN CODE	WIDTH (IN)	HEIGHT (IN)	SHEETING REMARKS	SIGN LEGEND	NEW SIGNS		EXISTING SIGNS				EXIST POST		NUMBER OF NEW POSTS	SQUARE STEEL (IN)			TUBULAR STEEL Ø (IN)				SIGN FRAME REQUIRED	REMARKS	SIGN DETAIL LOCATION			
								"A"	"B"	RETAIN	SALVAGE FROM	SALVAGE TO	REMOVE	RETAIN	REMOVE		1.75	2.00	2.50	FOUNDATION	3.0	3.50	4.00			5.00	SHSM	PROJECT SHEET #	STANDARD SHEET #
																	(LB / FT)				(LB / FT)								
SEARSBURG EB							FY-FLUORESCENT YELLOW FYG-FLUORESCENT YELLOW GREEN																"SHSM"-STANDARD HIGHWAY SIGNS AND MARKINGS						
		A	VD2-1	72	12			6.00																SEE SHEET 2.		7			
		A	VD2-1	72	12			6.00																		7			
		A	M3-2	24	12			2.00																INSTALL ON LEFT POST			E-136B		
		A	M1-5	24	24			4.00																INSTALL ON LEFT POST			E-136B		
EB	1.952	A	VW-092	36	36		UNSAFE TO PASS				1		1		X														
EB	1.978	A	VW-092	36	36		UNSAFE TO PASS						1			2		X			USED OLD SIGN POSTS		INSTALL 135 FEET EAST OF EXISTING UNSAFE TO PASS ASSEMBLY.			USED OLD SIGN POSTS			
EB	2.068	A	VW-000	30	30		MOOSE CROSSING				1				X														
		A	W7-3A	24	18		NEXT 4 MILES				1																		
EB	2.342	A	VW-092	36	36		SCHOOL BUS STOP AHEAD UNSAFE TO PASS	9.00								2													
EB	2.375	A	VR-644P	24	12		BEGIN				1				X														
		A	R8-3	24	24		NO PARKING				1																		
EB	2.408	A	OM1-1	18	18		OBJECT MARKER				1				X														
EB	2.413	A	W7-3B	60	60		RUNAWAY TRUCK RAMP				1				X								RETAIN SIGN ASSEMBLY AND FLASHING BEACONS.						
EB	2.425	A	M4-6P	24	12		END				1				X														
		A	R8-3	24	24		NO PARKING				1																		
SIGN SUMMARY SHEET							SHEET TOTALS	27.00 18.00	0.00	9	1	1	1	0	0	2	30	0	0.0	0.0	0.0	0.0	0.0	PROJECT NAME: WOODFORD-MARLBORO					
VERMONT AGENCY OF TRANSPORTATION							TOWN DIRECTIONAL TOTALS	130.8	0.0	29.0	18.0	18.0	41	0.0	0.0	28	420.0	0		0.0				PROJECT NUMBER: STPG SIGN(35)					
										EA	EA	EA	EA	EA	EA	EA	FT	EA	LB	LB	LB	LB	FILE NAME: 10B336						
																							PLOT DATE: 4/10/2012						
																							DRAWN BY: J. KELLY						
																							CHECKED BY: A. GAMBLE						
																							SEARSBURG EB SHEET 4						
																							SHEET 33 OF 80						


DIRECTION	MILEPOINT	LOCATION CODE (SHEET 2)	SIGN CODE	WIDTH (IN)	HEIGHT (IN)	SHEETING REMARKS	SIGN LEGEND	NEW SIGNS		EXISTING SIGNS				EXIST POST		NUMBER OF NEW POSTS	SQUARE STEEL (IN)			TUBULAR STEEL Ø (IN)				SIGN FRAME REQUIRED	REMARKS	SIGN DETAIL LOCATION				
								"A"	"B"	RETAIN	SALVAGE FROM	SALVAGE TO	REMOVE	RETAIN	REMOVE		1.75	2.00	2.50	FOUNDATION	3.0	3.50	4.00			5.00	SHSM	PROJECT SHEET #	STANDARD SHEET #	
																	(LB / FT)				(LB / FT)									
SEARSBURG EB							FY-FLUORESCENT YELLOW FYG-FLUORESCENT YELLOW GREEN															"SHSM"-STANDARD HIGHWAY SIGNS AND MARKINGS								
EB	2.442	A	W1-1R	36	36		RIGHT CURVE																							
		A	W13-1	24	24		40 MPH ADVISORY (MISSING)																		NOTHING THERE					
EB	2.468	A	W7-4	96	48		RUNAWAY TRUCK RAMP 1/2 MILE			1																				
EB	2.542	A	W1-2R	36	36	FY		9.00							2		X								INSTALL 10 FEET WEST OF UTILITY POLE #604/11 1/2.	X				
		A	W13-1	24	24	FY		4.00																	INSTALL ON LEFT POST	X				
EB	2.986	A	VR-644P	30	12		BEGIN			1																				
		A	R8-3	24	24		NO PARKING			1																				
EB	3.025	A	OM1-1	18	18		OBJECT MARKER (MISSING)																		NOTHING THERE					
		A	OM1-1	18	18			2.25							1		X								INSTALL AT POINT OF GORE FOR TRUCK RAMP.	X				
EB	3.036	A	W7-4B	60	60		RUNAWAY TRUCK RAMP			1																				
EB	3.067	C	R5-1	30	30		DO NOT ENTER			1																				
		C	R8-3A	24	24		NO PARKING			1																				
EB	3.106	A	M4-6P	24	12		END			1																				
		A	R8-3	24	24		NO PARKING			1																				
EB	3.170	A	W2-1M	36	36		MODIFIED CROSSROAD																							
SIGN SUMMARY SHEET							SHEET TOTALS	15.25	0.00	8	0	0	2 4	0	0	3		45	0	0.0	0.0	0.0	0.0		PROJECT NAME: WOODFORD-MARLBORO PROJECT NUMBER: STPG SIGN(35)					
								SF	SF	EA	EA	EA	EA	EA	EA	EA		FT	EA	LB	LB	LB	LB		FILE NAME: 10B336 PLOT DATE: 4/10/2012 PROJECT MANAGER: A. GAMBLE DRAWN BY: J. KELLY DESIGNED BY: J. KELLY CHECKED BY: A. GAMBLE SEARSBURG EB SHEET 5 SHEET 34 OF 80					
VERMONT AGENCY OF TRANSPORTATION							TOWN DIRECTIONAL TOTALS	130.8	0.0	29.0	18.0	18.0	41	0.0	0.0	28		420.0	0		0.0									

DIRECTION	MILEPOINT	LOCATION CODE (SHEET 2)	SIGN CODE	WIDTH (IN)	HEIGHT (IN)	SHEETING REMARKS	SIGN LEGEND	NEW SIGNS		EXISTING SIGNS				EXIST POST		NUMBER OF NEW POSTS	SQUARE STEEL (IN)			TUBULAR STEEL Ø (IN)				SIGN FRAME REQUIRED	REMARKS	SIGN DETAIL LOCATION			
								"A"	"B"	RETAIN	SALVAGE FROM	SALVAGE TO	REMOVE	RETAIN	REMOVE		1.75	2.00	2.50	FOUNDATION	3.0	3.50	4.00			5.00	SHSM	PROJECT SHEET #	STANDARD SHEET #
																	(LB / FT)				(LB / FT)								
SEARSBURG EB							FY-FLUORESCENT YELLOW FYG-FLUORESCENT YELLOW GREEN															"SHSM"-STANDARD HIGHWAY SIGNS AND MARKINGS							
EB	3.198	A	VW-092	36	36			9.00										X						INSTALL 150 EAST OF EXISTING CROSSROAD SIGN ASSEMBLY.		8			
EB	3.270	A	W2-1	36	36			9.00										X						INSTALL 50 FEET EAST OF BREAK IN GUARDRAIL	X				
EB	3.357	C	VR-017	24	30							1												SLEEPY HOLLOW RD. (TH-3)					
		C	VR-017	24	30			5.00										X						USED NEW POST REMOVED FROM EB 0.485 AND PAID THERE		7			
		C		30	30		DEAD END (TOWN-OWNED) NOW "NO OUTLET"																	REINSTALL TOWN'S DEAD END SIGN 50 FEET FURTHER UP TOWN HIGHWAY ON A SEPARATE POST.			TOWN HAS PUT IN "NO OUTLET" SIGN		
EB	3.361	D	R1-1	30	30							1	X	X										SLEEPY HOLLOW RD. (TH-3)					
		D	R1-1	30	30			6.25																REINSTALL ABOVE NEW STOP SIGN USING 90 DEG. BRACKET.	X		RETAINED POST		
		D	D3-1				STREET NAME SIGN (TOWN-OWNED)																					RETAIN POST	
EB	3.402	A	M3-2	24	12							1	X	X										RETAIN FLANGED CHANNEL POST					
		A	M1-5	24	24							1																	
		A	M3-2	24	12			2.00																				E-136B	
		A	M1-5	24	24			4.00																				E-136B	
		A	VM-120	18	24		MOLLY STARK BYWAY				1														RETAIN BYWAY SIGN.				
EB	3.510	A	R2-1	24	30							1	X	X											RETAIN FLANGED CHANNEL POST.			OLD POST DAMAGED	
		A	R2-1	24	30			5.00																			X		
SIGN SUMMARY SHEET							SHEET TOTALS	40.25	0.00	1	0	0	5	0	0	7	105	0	0.0	0.0	0.0	0.0	0.0	PROJECT NAME: WOODFORD-MARLBORO					
								SF	SF	EA	EA	EA	EA	EA	EA	EA	FT	EA	LB	LB	LB	LB	PROJECT NUMBER: STPG SIGN(35)						
							TOWN DIRECTIONAL TOTALS	130.8	0.0	29.0	18.0	18.0	41	0.0	0.0	28	420.0	0		0.0				FILE NAME: 10B336					
VERMONT AGENCY OF TRANSPORTATION																							PLOT DATE: 4/10/2012						
																						DRAWN BY: J. KELLY							
																						DESIGNED BY: J. KELLY							
																						CHECKED BY: A. GAMBLE							
																						SEARSBURG EB SHEET 6							
																						SHEET 35 OF 80							

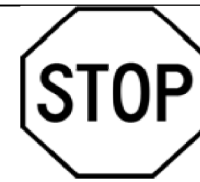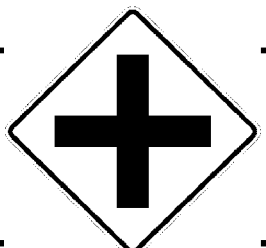



DIRECTION	MILEPOINT	LOCATION CODE (SHEET 2)	SIGN CODE	WIDTH (IN)	HEIGHT (IN)	SHEETING REMARKS	SIGN LEGEND	NEW SIGNS		EXISTING SIGNS				EXIST POST		NUMBER OF NEW POSTS	SQUARE STEEL (IN)			TUBULAR STEEL Ø (IN)				SIGN FRAME REQUIRED	REMARKS	SIGN DETAIL LOCATION			
								"A"	"B"	RETAIN	SALVAGE FROM	SALVAGE TO	REMOVE	RETAIN	REMOVE		1.75	2.00	2.50	FOUNDATION	3.0	3.50	4.00			5.00	SHSM	PROJECT SHEET #	STANDARD SHEET #
																	(LB / FT)				(LB / FT)								
SEARSBURG EB							FY-FLUORESCENT YELLOW FYG-FLUORESCENT YELLOW GREEN																"SHSM"-STANDARD HIGHWAY SIGNS AND MARKINGS						
EB	3.857	A	VW-005	30	30		BRIDGES FREEZE BEFORE ROAD																						
		A	W8-13	36	36			9.00										X							X				
		A	W7-3aP	24	18			3.00																	X				
EB	4.039	A	M3-2	24	12		EAST																						
		A	M1-5	24	24		VERMONT ROUTE 9																						
EB	5.473	A	VD-062AS	72	16		BUSINESS SIGN			1																			
EB	5.519	A	R2-1	24	30																								
		A	R2-1	24	30			5.00																	X				
SIGN SUMMARY SHEET							SHEET TOTALS		17.00	0.00	1	0	0	4	0	0	3	45	0	0.0	0.0	0.0	0.0	PROJECT NAME: WOODFORD-MARLBORO					
VERMONT AGENCY OF TRANSPORTATION							TOWN DIRECTIONAL TOTALS		130.8	0.0	29.0	18.0	18.0	41	0.0	0.0	28	420.0	0		0.0			PROJECT NUMBER: STPG SIGN(35)					
																							FILE NAME: 10B336						
																							PLOT DATE: 4/10/2012						
																							DRAWN BY: J. KELLY						
																							DESIGNED BY: J. KELLY						
																							CHECKED BY: A. GAMBLE						
																							SHEET 36 OF 80						






DIRECTION	MILEPOINT	LOCATION CODE (SHEET 2)	SIGN CODE	WIDTH (IN)	HEIGHT (IN)	SHEETING REMARKS	SIGN LEGEND	NEW SIGNS		EXISTING SIGNS				EXIST POST		NUMBER OF NEW POSTS	SQUARE STEEL (IN)			TUBULAR STEEL Ø (IN)				SIGN FRAME REQUIRED	REMARKS	SIGN DETAIL LOCATION			
								"A"	"B"	RETAIN	SALVAGE FROM	SALVAGE TO	REMOVE	RETAIN	REMOVE		1.75	2.00	2.50	FOUNDATION	3.0	3.50	4.00			5.00	SHSM	PROJECT SHEET #	STANDARD SHEET #
																	(LB / FT)				(LB / FT)								
SEARSBURG WB							FY-FLUORESCENT YELLOW FYG-FLUORESCENT YELLOW GREEN															"SHSM"-STANDARD HIGHWAY SIGNS AND MARKINGS							
WB	5.518	F	R2-1	24	30							1	X									RETAIN POST	RETAIN FLANGED CHANNEL POST.						
		F	R2-1	24	30			5.00																X					
WB	4.590	F	VW-005	30	30		BRIDGES FREEZE BEFORE ROAD					1	X										REMOVE FLAGS.						
		F	W8-13	36	36			9.00						2	X									X					
		F	W7-3aP	24	18			3.00																X					
WB	4.490	G	VR-017	24	30							1	X									RETAIN POST	LIND LANE (TH-8)						
		G	VR-017	24	30			5.00																	7				
WB	4.484	H	R1-1	30	30							1	X									RETAIN POST	LIND LANE (TH-8)			STREET SIGN ON TOP OF STOP SIGN INSTALLED 9-11			
		H	R1-1	30	30			6.25																X					
WB	3.488	F	W2-1M	36	36		MODIFIED CROSSROADS					1	X													REMOVE OLD POSTS FOR ONE MISSING SIGN			
		F	W2-1	36	36			9.00						2	X								INSTALL ¹⁰⁰ 225 FEET WEST OF EXISTING CROSSROADS SIGN.	X		PER JOE KELLY			
WB	3.390	F	D17-2	42	42			12.25						2	X								INSTALL ⁶⁰⁰ 300 FEET WEST OF NEW CROSSROADS SIGN.			PER JOE KELLY 6			
WB	3.362	G	VR-017	24	30		LEGAL LOAD 24K			1			X										SOMERSET RD (TH-4)						
WB	3.356	H	R1-1	30	30		STOP			1			X										SOMERSET RD (TH-4)						
WB	3.321	F	R2-1	24	30		SPEED LIMIT 50			1			X																
SIGN SUMMARY SHEET							SHEET TOTALS	49.50	0.00	3	0	0	7 5	0	0	6	90	0	0.0	0.0	0.0	0.0	0.0	PROJECT NAME: WOODFORD-MARLBORO					
								SF	SF	EA	EA	EA	EA	EA	EA	EA	FT	EA	LB	LB	LB	LB	PROJECT NUMBER: STPG SIGN(35)						
VERMONT AGENCY OF TRANSPORTATION							TOWN DIRECTIONAL TOTALS	86.0	0.0	21.0	17.0	17.0	34	0.0	0.0	18	270.0	0			0.0			FILE NAME: 10B336	PLOT DATE: 4/10/2012				
																						PROJECT MANAGER: A. GAMBLE	DRAWN BY: J. KELLY						
																						DESIGNED BY: J. KELLY	CHECKED BY: A. GAMBLE						
																						SEARSBURG WB SHEET 1	SHEET 37 OF 80						




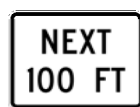
DIRECTION	MILEPOINT	LOCATION CODE (SHEET 2)	SIGN CODE	WIDTH (IN)	HEIGHT (IN)	SHEETING REMARKS	SIGN LEGEND	NEW SIGNS		EXISTING SIGNS				EXIST POST		NUMBER OF NEW POSTS	SQUARE STEEL (IN)			TUBULAR STEEL Ø (IN)				SIGN FRAME REQUIRED	REMARKS	SIGN DETAIL LOCATION						
								"A"	"B"	RETAIN	SALVAGE FROM	SALVAGE TO	REMOVE	RETAIN	REMOVE		1.75	2.00	2.50	FOUNDATION	3.0	3.50	4.00			5.00	SHSM	PROJECT SHEET #	STANDARD SHEET #			
																	(LB / FT)				(LB / FT)											
SEARSBURG WB							FY-FLUORESCENT YELLOW FYG-FLUORESCENT YELLOW GREEN															"SHSM"-STANDARD HIGHWAY SIGNS AND MARKINGS										
WB	3.273	F	R4-6	24	30		TRUCK LANE 500 FEET						1		X																	
WB	3.178	F	R4-3	24	30		SLOWER TRAFFIC KEEP RIGHT			1					X																	
WB	2.744	F	R4-3	24	30		SLOWER TRAFFIC KEEP RIGHT			1					X																	
WB	2.709	E	W1-8R	18	24		CHEVRON			1					X																	
WB	2.694	E	W1-8R	18	24		CHEVRON			1					X																	
WB	2.677	E	W1-8R	18	24		CHEVRON			+		I			X																	
WB	2.666	E	W1-8R	18	24		CHEVRON			1					X																	
WB	2.643	E	W1-8R	18	24		CHEVRON			1					X																	
WB	2.627	E	W1-8R	18	24		CHEVRON			1					X																	
WB	2.612	E	W1-8R	18	24		CHEVRON			1					X																	
	2.394						SCHOOL BUS STOP AHEAD			9.00						2																
WB	2.394	F	VW-133R	30	30		HIDDEN DRIVES RIGHT (SIGN IS MISSING)						1		X																	
WB	2.343	F	VW-054R	30	30					6.25						1																
WB	2.070	F	R4-3	24	30		SLOWER TRAFFIC KEEP RIGHT						1		X																	
		F	VW-054R	30	30					6.25						1																
	2.034						SCHOOL BUS STOP AHEAD			9.00						2																
WB	1.991	F	W2-2L	30	30		LEFT SIDE ROAD						1			1																
SIGN SUMMARY SHEET							SHEET TOTALS	30.50 12.50	0.00	9	0	2 +	3	0	0	3	45	0	0.0	0.0	0.0	0.0	0.0	PROJECT NAME: WOODFORD-MARLBORO PROJECT NUMBER: STPG SIGN(35)								
VERMONT AGENCY OF TRANSPORTATION							TOWN DIRECTIONAL TOTALS	86.0	0.0	21.0	17.0	17.0	34	0.0	0.0	18	270.0	0		0.0				FILE NAME: 10B336 PLOT DATE: 4/10/2012 PROJECT MANAGER: A. GAMBLE DRAWN BY: J. KELLY DESIGNED BY: J. KELLY CHECKED BY: A. GAMBLE SEARSBURG WB SHEET 2 SHEET 38 OF 80								


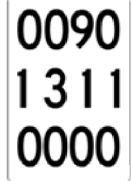





DIRECTION	MILEPOINT	LOCATION CODE (SHEET 2)	SIGN CODE	WIDTH (IN)	HEIGHT (IN)	SHEETING REMARKS	SIGN LEGEND	NEW SIGNS		EXISTING SIGNS				EXIST POST		NUMBER OF NEW POSTS	SQUARE STEEL (IN)			TUBULAR STEEL Ø (IN)				SIGN FRAME REQUIRED	REMARKS	SIGN DETAIL LOCATION			
								"A"	"B"	RETAIN	SALVAGE FROM	SALVAGE TO	REMOVE	RETAIN	REMOVE		1.75	2.00	2.50	FOUNDATION	3.0	3.50	4.00			5.00	SHSM	PROJECT SHEET #	STANDARD SHEET #
																	(LB / FT)				(LB / FT)								
SEARSBURG WB							FY-FLUORESCENT YELLOW FYG-FLUORESCENT YELLOW GREEN															"SHSM"-STANDARD HIGHWAY SIGNS AND MARKINGS							
WB	1.972	F	W2-2L	30	30		LEFT SIDE ROAD				1		1		X										RELOCATE ASSEMBLY 100 FEET EAST OF CURRENT LOCATION.				
WB	1.953	F	M2-1	21	15		JCT									1		X							INSTALL ASSEMBLY 150 FEET EAST OF CURRENT LOCATION.				
		F	M1-5	24	24		VERMONT ROUTE 8						1																
WB	1.924	F	M2-1	21	15		JCT				1		1		X										RELOCATE ASSEMBLY 150 FEET EAST OF CURRENT LOCATION.				
		F	M1-5	24	24		VERMONT ROUTE 8				1		1																
WB	1.915	F	VR-731	36	48			12.00								2		X							INSTALL 200 FEET EAST OF DESTINATION SIGNS.		7		
WB	1.901	F	VR-731	24	30		THRU TRAFFIC USE RIGHT LANE						1		X														
WB	1.874	F	VD1-1A	72	10		↑ BENNINGTON 14				1	1	1		X	2			X						REINSTALL SIGNS ON NEW POSTS AND SLIP-BASES. SEE SHEET 2.				
		F	VD1-1A	72	10		<---- HEARTWELLVILLE 6						1												REMOVE SIGN FROM ASSEMBLY.				
		F	VD1-1A	72	10		<---- READSBORO 11				1	1	1												MOVE SIGN UP			SLIP BASES	
		F	VD1-1A	72	10		<---- STAMFORD 12				1	1	1												MOVE SIGN UP				
WB	1.837	F	M3-3	24	12		ROUTE MARKER ASSEMBLY				1	1	1		X	2			X						REINSTALL SIGNS AND FRAME ON NEW POSTS AND SLIP-BASES. SEE SHEET 2.				
		F	M1-5	24	24						1	1	1															SLIP BASES	
		F	M6-1	21	15						1	1	1																
		F	M4-5	24	12						1	1	1																
SIGN SUMMARY SHEET							SHEET TOTALS	12.00	0.00	0	10	9	12	0	0	7	105	0	0.0	0.0	0.0	0.0	PROJECT NAME: WOODFORD-MARLBORO PROJECT NUMBER: STPG SIGN(35)						
								SF	SF	EA	EA	EA	EA	EA	EA	EA	FT	EA	LB	LB	LB	LB	FILE NAME: 10B336 PLOT DATE: 4/10/2012 PROJECT MANAGER: A. GAMBLE DRAWN BY: J. KELLY DESIGNED BY: J. KELLY CHECKED BY: A. GAMBLE						
VERMONT AGENCY OF TRANSPORTATION							TOWN DIRECTIONAL TOTALS	86.0	0.0	21.0	17.0	17.0	34	0.0	0.0	18	270.0	0		0.0			SEARSBURG WB SHEET 3 SHEET 39 OF 80						


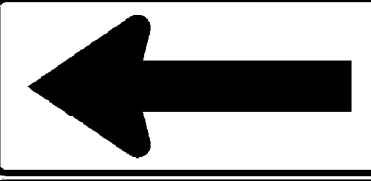




DIRECTION	MILEPOINT	LOCATION CODE (SHEET 2)	SIGN CODE	WIDTH (IN)	HEIGHT (IN)	SHEETING REMARKS	SIGN LEGEND	NEW SIGNS		EXISTING SIGNS				EXIST POST		NUMBER OF NEW POSTS	SQUARE STEEL (IN)			TUBULAR STEEL Ø (IN)				SIGN FRAME REQUIRED	REMARKS	SIGN DETAIL LOCATION			
								"A"	"B"	RETAIN	SALVAGE FROM	SALVAGE TO	REMOVE	RETAIN	REMOVE		1.75	2.00	2.50	FOUNDATION	3.0	3.50	4.00			5.00	SHSM	PROJECT SHEET #	STANDARD SHEET #
																	(LB / FT)				(LB / FT)								
SEARSBURG WB							FY-FLUORESCENT YELLOW FYG-FLUORESCENT YELLOW GREEN																"SHSM"-STANDARD HIGHWAY SIGNS AND MARKINGS						
		F	VM-120	18	24		MOLLY STARK BYWAY				1		1													RELOCATE SIGN TO D-BOARD ASSEMBLY AT MP 1.792+/-			
WB	1.752	G	VR-017	24	30		LEGAL LOAD 24K			1				X												TOWN GARAGE RD (TH-7)			
WB	1.745	H	R1-1	30	30		STOP			1				X												TOWN GARAGE RD (TH-7)			
WB	1.714	F	W4-2R	36	36		RIGHT LANE REDUCTION			1				X															
WB	1.679	F	VW-054R	30	30		HIDDEN DRIVE RIGHT			1				X															
WB	1.642	F	VW-000	30	30		MOOSE CROSSING			1				X															
		F	W7-3A	24	18		NEXT 2 MILES			1																			
WB	1.060	F					(EMPTY POST)						1		X											REMOVE EMPTY POST.			
WB	0.925	F	VW-139	30	30		LIVESTOCK CROSSING (MISSING)						1		X											SIGN IS NO LONGER WARRANTED.			
WB	0.556	F	W11-6H	30	30		SNOWMOBILE						1		X											SIGN IS NOT WARRANTED DUE TO ADEQUATE SSD.			
WB	0.458	F	M3-4	24	12		WEST			1				X															
		F	M1-5	24	24		VERMONT ROUTE 9			1																			
SIGN SUMMARY SHEET							SHEET TOTALS	0.00	0.00	8	1	0	4	0	0	0		0	0.0	0.0	0.0	0.0	PROJECT NAME: WOODFORD-MARLBORO						
								SF	SF	EA	EA	EA	EA	EA	EA	EA		FT	EA	LB	LB	LB	LB	PROJECT NUMBER: STPG SIGN(35)					
																						FILE NAME: 10B336							
VERMONT AGENCY OF TRANSPORTATION							TOWN DIRECTIONAL TOTALS	86.0	0.0	21.0	17.0	17.0	34	0.0	0.0	18		270.0	0		0.0		PROJECT MANAGER: A. GAMBLE						
																						DESIGNED BY: J. KELLY							
																						PLOT DATE: 4/10/2012							
																						DRAWN BY: J. KELLY							
																						CHECKED BY: A. GAMBLE							
																						SEARSBURG WB SHEET 5							
																						SHEET 41 OF 80							







DIRECTION	MILEPOINT	LOCATION CODE (SHEET 2)	SIGN CODE	WIDTH (IN)	HEIGHT (IN)	SHEETING REMARKS	SIGN LEGEND	NEW SIGNS		EXISTING SIGNS				EXIST POST		NUMBER OF NEW POSTS	SQUARE STEEL (IN)			TUBULAR STEEL Ø (IN)				SIGN FRAME REQUIRED	REMARKS	SIGN DETAIL LOCATION													
								"A"	"B"	RETAIN	SALVAGE FROM	SALVAGE TO	REMOVE	RETAIN	REMOVE		1.75	2.00	2.50	FOUNDATION	3.0	3.50	4.00			5.00	SHSM	PROJECT SHEET #	STANDARD SHEET #										
																	(LB / FT)				(LB / FT)																		
WILMINGTON EB							FY-FLUORESCENT YELLOW FYG-FLUORESCENT YELLOW GREEN																"SHSM"-STANDARD HIGHWAY SIGNS AND MARKINGS																
EB	0.984	A					PICNIC AREA RIGHT			1					X																								
EB	1.000	C	VR-017	24	30		LEGAL LOAD 24K			1					X																								
EB	1.006	D	R1-1	30	30		STOP			1					X																								
EB	1.041	A	W11-2	30	30																																		
		A	W16-2	24	12		500 FEET																																
		A	W11-2	30	30	FYG		6.25									1		X																			X	
		A	W16-9P	24	12	FYG		2.00																														X	
EB	1.131	C	VR-017	24	30		LEGAL LOAD 24K			1					X																								
EB	1.137	D	R1-1	30	30		STOP			1					X																								
EB	1.144	A	W11-2	30	30																																		
		A	W16-7	24	12		(DOWN ARROW)																																
		A	W11-2	30	30	FYG		6.25									1		X																				X
		A	W16-4P	30	24	FYG		5.00																															
SKIP FROM MP 1.50+/- TO MARLBORO TOWN LINE DUE TO RECENT SIGN REPLACEMENTS																																							
SIGN SUMMARY SHEET							SHEET TOTALS			19.50	0.00	5	0	0	4	0	0	2	30	0	0.0	0.0	0.0	0.0	PROJECT NAME: WOODFORD-MARLBORO														
VERMONT AGENCY OF TRANSPORTATION							TOWN DIRECTIONAL TOTALS			SF	SF	EA	EA	EA	EA	EA	EA	EA	FT	EA	LB	LB	LB	LB	PROJECT NUMBER: STPG SIGN(35)														
										56.8	0.0	7.0	0.0	0.0	9	0.0	0.0	7	105.0	0		0.0		FILE NAME: 10B336															
																						PLOT DATE: 4/10/2012																	
																						DRAWN BY: J. KELLY																	
																						DESIGNED BY: J. KELLY																	
																						CHECKED BY: A. GAMBLE																	
																						SHEET 43 OF 80																	
																						WILMINGTON EB SHEET 2																	






DIRECTION	MILEPOINT	LOCATION CODE (SHEET 2)	SIGN CODE	WIDTH (IN)	HEIGHT (IN)	SHEETING REMARKS	SIGN LEGEND	NEW SIGNS		EXISTING SIGNS				EXIST POST		NUMBER OF NEW POSTS	SQUARE STEEL (IN)			TUBULAR STEEL Ø (IN)				SIGN FRAME REQUIRED	REMARKS	SIGN DETAIL LOCATION			
								"A"	"B"	RETAIN	SALVAGE FROM	SALVAGE TO	REMOVE	RETAIN	REMOVE		1.75	2.00	2.50	FOUNDATION	3.0	3.50	4.00			5.00	SHSM	PROJECT SHEET #	STANDARD SHEET #
																	(LB / FT)				(LB / FT)								
WILMINGTON WB							FY-FLUORESCENT YELLOW FYG-FLUORESCENT YELLOW GREEN																"SHSM"-STANDARD HIGHWAY SIGNS AND MARKINGS						
WB	7.145	G	VR-017	24	30																		SUN & SKI RD (TH-68)						
		G	VR-017	24	30			5.00																	TRIM BRUSH 7				
WB	7.143	H	R1-1	30	30																		SUN & SKI RD (TH-68)						
		H	R1-1	30	30			6.25																X					
WB	7.113	F	M3-4	24	12																								
		F	M1-5	24	24																								
		F	M3-4	24	12			2.00																		E-136B			
		F	M1-5	24	24			4.00																		E-136B			
WB	7.075	F	R2-1	24	30		OLD SIGN MISSING																		NONE THERE				
		F	R2-1	24	30			5.00																X					
SKIP FROM MP 7.00+/- to MP 1.40+/- DUE TO RECENT SIGN REPLACEMENTS																													
WB	1.399	F	M3-4	24	12																								
		F	M1-5	24	24																								
		F	M3-4	24	12			2.00																		E-136B			
		F	M1-5	24	24			4.00																		E-136B			
SIGN SUMMARY SHEET							SHEET TOTALS		28.25	0.00	0	0	0	5	75	0	0.0	0.0	0.0	0.0	0.0	PROJECT NAME: WOODFORD-MARLBORO							
VERMONT AGENCY OF TRANSPORTATION							TOWN DIRECTIONAL TOTALS		47.8	0.0	3.0	0.0	0.0	7	105.0	0		0.0				PROJECT NUMBER: STPG SIGN(35)							
									SF	SF	EA	EA	EA	EA	EA	EA	EA	EA	EA	EA	EA	FILE NAME: 10B336							
																					PLOT DATE: 4/10/2012								
																					DRAWN BY: J. KELLY								
																					DESIGNED BY: J. KELLY								
																					CHECKED BY: A. GAMBLE								
																					WILMINGTON WB SHEET 1								
																					SHEET 44 OF 80								

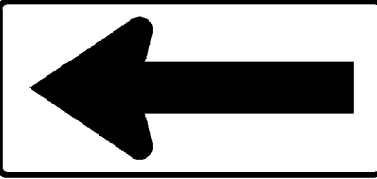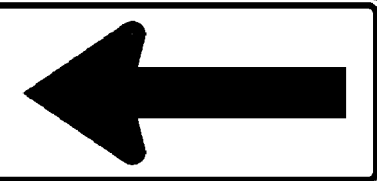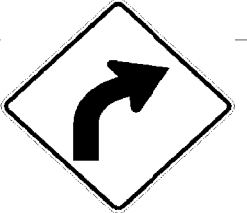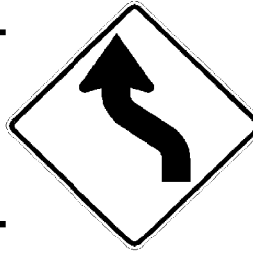







DIRECTION	MILEPOINT	LOCATION CODE (SHEET 2)	SIGN CODE	WIDTH (IN)	HEIGHT (IN)	SHEETING REMARKS	SIGN LEGEND	NEW SIGNS		EXISTING SIGNS				EXIST POST		NUMBER OF NEW POSTS	SQUARE STEEL (IN) (LB / FT)			TUBULAR STEEL Ø (IN) (LB / FT)				SIGN FRAME REQUIRED	REMARKS	SIGN DETAIL LOCATION										
								"A"	"B"	RETAIN	SALVAGE FROM	SALVAGE TO	REMOVE	RETAIN	REMOVE		1.75	2.00	2.50	FOUNDATION	3.0	3.50	4.00			5.00	SHSM	PROJECT SHEET #	STANDARD SHEET #							
																														1.88	2.42	3.35	7.6	9.00	10.80	14.60
WILMINGTON WB							FY-FLUORESCENT YELLOW FYG-FLUORESCENT YELLOW GREEN															"SHSM"-STANDARD HIGHWAY SIGNS AND MARKINGS														
WB	1.360	F	VD-062BRN	72	16		BUSINESS SIGN			1					X																					
WB	1.308	F	W11-2	30	30																															
		F	W16-2	24	12		500 FEET																													
		F	W11-2	30	30	FYG		6.25								1		X														X				
		F	W16-9P	24	12	FYG		2.00																								X				
WB	1.201	F	W11-2	30	30																															
		F	W16-7	24	12																															
		F	W11-2	30	30	FYG		6.25								1		X														X				
		F	W16-4P	30	24	FYG		5.00																								X				
WB	1.141	F					PICNIC AREA LEFT			1					X																					
WB	0.985	F	VD-062AS	72	16		BUSINESS SIGN			1					X																					
SIGN SUMMARY SHEET							SHEET TOTALS	19.50	0.00	3	0	0	4	0	0	2	30	0	0.0	0.0	0.0	0.0	0.0	PROJECT NAME: WOODFORD-MARLBORO												
								SF	SF	EA	EA	EA	EA	EA	EA	EA	FT	EA	LB	LB	LB	LB	PROJECT NUMBER: STPG SIGN(35)													
VERMONT AGENCY OF TRANSPORTATION							TOWN DIRECTIONAL TOTALS	47.8	0.0	3.0	0.0	0.0	11	0.0	0.0	7	105.0	0		0.0			FILE NAME: 10B336													
																						PLOT DATE: 4/10/2012														
																						DRAWN BY: J. KELLY														
																						DESIGNED BY: J. KELLY														
																						CHECKED BY: A. GAMBLE														
																						SHEET 45 OF 80														




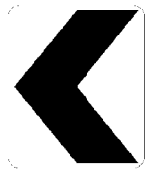


DIRECTION	MILEPOINT	LOCATION CODE (SHEET 2)	SIGN CODE	WIDTH (IN)	HEIGHT (IN)	SHEETING REMARKS	SIGN LEGEND	NEW SIGNS		EXISTING SIGNS				EXIST POST		NUMBER OF NEW POSTS	SQUARE STEEL (IN)			TUBULAR STEEL Ø (IN)				SIGN FRAME REQUIRED	REMARKS	SIGN DETAIL LOCATION					
								"A"	"B"	RETAIN	SALVAGE FROM	SALVAGE TO	REMOVE	RETAIN	REMOVE		1.75	2.00	2.50	FOUNDATION	3.0	3.50	4.00			5.00	SHSM	PROJECT SHEET #	STANDARD SHEET #		
																	(LB / FT)				(LB / FT)										
MARLBORO EB							FY-FLUORESCENT YELLOW FYG-FLUORESCENT YELLOW GREEN																"SHSM"-STANDARD HIGHWAY SIGNS AND MARKINGS								
EB	0.000	C	VD-024	60	7.5									1		X															
		C	VD-024	72	10			5.00											X								4				
		C	VD-700	6	10			0.42																				INSTALL ON LEFT POST BELOW MARLBORO		R MM	E-138
		C	VD-700	6	10	 		0.42																				INSTALL ON RIGHT POST BELOW WILMINGTON		R MM	E-138
EB	0.109	A	M3-2	24	12																										
		A	M1-5	24	24																										
		A	M3-2	24	12		2.00																							E-136B	
		A	M1-5	24	24		4.00																							E-136B	
EB	0.147	A	R2-1	24	30																										
		A	R2-1	24	30		5.00																								
EB	0.185	A	VD-062BRN	72	16	BUSINESS SIGN			1																						
EB	0.247	A	VR-020	24	30	NO PARKING ON TRAVEL LANE																									
EB	0.284	A	VW-205	36	36																										
		A	VW-205	36	36		9.00																								
EB	0.330	A	W11-2	48	48	PEDESTRIAN																									
SIGN SUMMARY SHEET							SHEET TOTALS	25.84	0.00	1	0	0	9 7	0	0	2	30	0	0.0	0.0	0.0	0.0	PROJECT NAME: WOODFORD-MARLBORO								
VERMONT AGENCY OF TRANSPORTATION							TOWN DIRECTIONAL TOTALS	634.4	0.0	28.0	1.0	1.0	127	0.0	0.0	88	1320.0	0		0.0			PROJECT NUMBER: STPG SIGN(35)								
																							FILE NAME: 10B336 PLOT DATE: 4/10/2012								
																							PROJECT MANAGER: A. GAMBLE DRAWN BY: J. KELLY								
																							DESIGNED BY: J. KELLY CHECKED BY: A. GAMBLE								
																							MARLBORO EB SHEET 1 SHEET 46 OF 80								

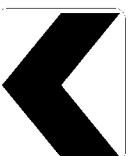







DIRECTION	MILEPOINT	LOCATION CODE (SHEET 2)	SIGN CODE	WIDTH (IN)	HEIGHT (IN)	SHEETING REMARKS	SIGN LEGEND	NEW SIGNS		EXISTING SIGNS				EXIST POST		NUMBER OF NEW POSTS	SQUARE STEEL (IN)			TUBULAR STEEL Ø (IN)				SIGN FRAME REQUIRED	REMARKS	SIGN DETAIL LOCATION			
								"A"	"B"	RETAIN	SALVAGE FROM	SALVAGE TO	REMOVE	RETAIN	REMOVE		1.75	2.00	2.50	FOUNDATION	3.0	3.50	4.00			5.00	SHSM	PROJECT SHEET #	STANDARD SHEET #
																	(LB / FT)				(LB / FT)								
MARLBORO EB							FY-FLUORESCENT YELLOW FYG-FLUORESCENT YELLOW GREEN															"SHSM"-STANDARD HIGHWAY SIGNS AND MARKINGS							
EB	0.362	A	D6-3M	30	30		SCENIC OVERLOOK AHEAD																						
		A	D5-2R	42	48			14.00										X							9				
EB	0.396	A	VR-020	24	30		NO PARKING ON TRAVEL LANE																						
EB	0.412	A	W1-6L	48	24																								
		A	W1-6L	48	24			8.00																	X				
EB	0.446	A	W11A-2	48	48		PEDESTRIAN CROSSWALK																						
		A	W16-4	24	18																								
		A	W11-2	48	48	FYG		16.00																	X				
		A	W16-4	30	24	FYG		5.00																	X				
EB	0.477	A	VW-537L	48	48																								
		A	W13-1	24	24																								
		A	W1-11L	36	36	FY		9.00																	X				
		A	W13-1	24	24	FY		4.00																	X				
EB	0.497	A		36	36		CENTERLINE RUMBLE STRIPS																						
		A		24	18		NEXT 9 MILES																						
SIGN SUMMARY SHEET							SHEET TOTALS	56.00	0.00	2	0	0	7	0	0	6	90	0	0.0	0.0	0.0	0.0	0.0	PROJECT NAME: WOODFORD-MARLBORO PROJECT NUMBER: STPG SIGN(35)					
								SF	SF	EA	EA	EA	EA	EA	EA	EA	FT	EA	LB	LB	LB	LB	FILE NAME: 10B336 PLOT DATE: 4/10/2012 PROJECT MANAGER: A. GAMBLE DRAWN BY: J. KELLY DESIGNED BY: J. KELLY CHECKED BY: A. GAMBLE MARLBORO EB SHEET 2 SHEET 47 OF 80						
VERMONT AGENCY OF TRANSPORTATION							TOWN DIRECTIONAL TOTALS	634.4	0.0	28.0	1.0	1.0	127	0.0	0.0	88	1320.0	0			0.0								






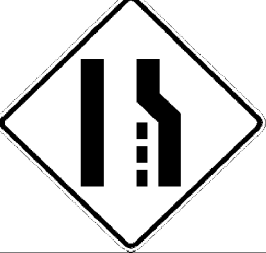


DIRECTION	MILEPOINT	LOCATION CODE (SHEET 2)	SIGN CODE	WIDTH (IN)	HEIGHT (IN)	SHEETING REMARKS	SIGN LEGEND	NEW SIGNS		EXISTING SIGNS				EXIST POST		NUMBER OF NEW POSTS	SQUARE STEEL (IN)			TUBULAR STEEL Ø (IN)				SIGN FRAME REQUIRED	REMARKS	SIGN DETAIL LOCATION				
								"A"	"B"	RETAIN	SALVAGE FROM	SALVAGE TO	REMOVE	RETAIN	REMOVE		1.75	2.00	2.50	FOUNDATION	3.0	3.50	4.00			5.00	SHSM	PROJECT SHEET #	STANDARD SHEET #	
																	(LB / FT)				(LB / FT)									
MARLBORO EB							FY-FLUORESCENT YELLOW FYG-FLUORESCENT YELLOW GREEN																"SHSM"-STANDARD HIGHWAY SIGNS AND MARKINGS							
EB	0.585	A	W1-6L	48	24							1	X													RETAIN POST				
		A	W1-6L	48	24	FY		8.00																X						
EB	0.612	A	W1-6L	48	24							1	X													RETAIN POST				
		A	W1-6L	48	24	FY		8.00																X						
EB	0.708	A	W1-2R	30	30							1	X													RETAIN POST				
		A	W1-2R	30	30			6.25																X						
EB	0.924	A	W1-4L	30	30							1	X																	
		A	W1-4L	30	30	LEFT REVERSE CURVE		6.25							1	X											INSTALL 200 FEET EAST OF EXISTING REVERSE CURVE SIGN.	X	TRIM BRUSH	
EB	1.139	A	M3-2	24	12							1	X													RETAIN POST				
		A	M1-5	24	24			2.00																						
		A	M3-2	24	12			4.00																						E-136B
		A	M1-5	24	24								1	X													RETAIN POST			E-136B
EB	1.172	A	R2-1	24	30							1	X													RETAIN POST				
		A	R2-1	24	30			5.00																X						
EB	1.238	A										1	X													REMOVE EMPTY POSTS.				
SIGN SUMMARY SHEET							SHEET TOTALS	39.50	0.00	0	0	0	8	0	0	1	15	0	0.0	0.0	0.0	0.0	0.0	PROJECT NAME: WOODFORD-MARLBORO						
								SF	SF	EA	EA	EA	EA	EA	EA	EA	FT	EA	LB	LB	LB	LB	PROJECT NUMBER: STPG SIGN(35)							
																							FILE NAME: 10B336							
VERMONT AGENCY OF TRANSPORTATION							TOWN DIRECTIONAL TOTALS	634.4	0.0	28.0	1.0	1.0	127	0.0	0.0	88	1320.0	0			0.0			PLOT DATE: 4/10/2012						
																							DRAWN BY: J. KELLY							
																							CHECKED BY: A. GAMBLE							
																							SHEET 48 OF 80							








DIRECTION	MILEPOINT	LOCATION CODE (SHEET 2)	SIGN CODE	WIDTH (IN)	HEIGHT (IN)	SHEETING REMARKS	SIGN LEGEND	NEW SIGNS		EXISTING SIGNS				EXIST POST		NUMBER OF NEW POSTS	SQUARE STEEL (IN)			TUBULAR STEEL Ø (IN)				SIGN FRAME REQUIRED	REMARKS	SIGN DETAIL LOCATION						
								"A"	"B"	RETAIN	SALVAGE FROM	SALVAGE TO	REMOVE	RETAIN	REMOVE		1.75	2.00	2.50	3.0	3.50	4.00	5.00			SHSM	PROJECT SHEET #	STANDARD SHEET #				
																	(LB / FT)			(LB / FT)												
MARLBORO EB							FY-FLUORESCENT YELLOW FYG-FLUORESCENT YELLOW GREEN																"SHSM"-STANDARD HIGHWAY SIGNS AND MARKINGS									
			A	M1-5	24	24								1																		
			A	M3-2	24	12		2.00																						E-136B		
			A	M1-5	24	24		4.00																						E-136B		
EB	1.966		A	R2-1	24	30								1	X																	
			A	R2-1	24	30		5.00																						X		
EB	2.024		A	VD-062B	72	16	BUSINESS SIGN			1						X																
			A	VD-062AS	72	16	BUSINESS SIGN			1																						
EB	2.161		A	VR-023B	24	30	\$500 FINE							1		X																
EB	2.384		A	W1-2L	30	30	LEFT CURVE							1		X																
EB	2.442		A	W1-2L	30	30		6.25									1	X											INSTALL 300 FEET EAST OF EXISTING LEFT CURVE ASSEMBLY, WEST OF POLE #68B/7A/1.	X		
EB	2.479		A	W1-8L	18	24								1		X																
			A	W1-8L	18	24		3.00									1	X													X	
EB	2.479		B	W1-8R	18	24								1		X																
			B	W1-8R	18	24		3.00									1	X													X	
EB	2.513		A	W1-8L	18	24								1		X																
SIGN SUMMARY SHEET							SHEET TOTALS	23.25	0.00	2	0	0	7	0	0	3	45	0	0.0	0.0	0.0	0.0	PROJECT NAME: WOODFORD-MARLBORO									
VERMONT AGENCY OF TRANSPORTATION							TOWN DIRECTIONAL TOTALS	634.4	0.0	28.0	1.0	1.0	127	0.0	0.0	88	1320.0	0		0.0			PROJECT NUMBER: STPG SIGN(35)									
																							FILE NAME: 10B336									
																								PROJECT MANAGER: A. GAMBLE								
																								DESIGNED BY: J. KELLY								
																								PLOT DATE: 4/10/2012								
																								DRAWN BY: J. KELLY								
																								CHECKED BY: A. GAMBLE								
																								SHEET 50 OF 80								
																								MARLBORO EB SHEET 5								


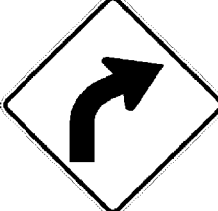



DIRECTION	MILEPOINT	LOCATION CODE (SHEET 2)	SIGN CODE	WIDTH (IN)	HEIGHT (IN)	SHEETING REMARKS	SIGN LEGEND	NEW SIGNS		EXISTING SIGNS				EXIST POST		NUMBER OF NEW POSTS	SQUARE STEEL (IN)			TUBULAR STEEL Ø (IN)				SIGN FRAME REQUIRED	REMARKS	SIGN DETAIL LOCATION			
								"A"	"B"	RETAIN	SALVAGE FROM	SALVAGE TO	REMOVE	RETAIN	REMOVE		1.75	2.00	2.50	FOUNDATION	3.0	3.50	4.00			5.00	SHSM	PROJECT SHEET #	STANDARD SHEET #
																	(LB / FT)				(LB / FT)								
MARLBORO EB							FY-FLUORESCENT YELLOW FYG-FLUORESCENT YELLOW GREEN																"SHSM"-STANDARD HIGHWAY SIGNS AND MARKINGS						
			A	W1-8L	18	24		3.00							1		X										X		
EB	2.513		B	W1-8R	18	24																							
			B	W1-8R	18	24		3.00							1		X											X	
EB	2.546		A	W1-8L	18	24																							
			A	W1-8L	18	24		3.00							1		X											X	
EB	2.546		B	W1-8R	18	24																							
			B	W1-8R	18	24		3.00							1		X											X	
EB	2.579		A	W1-8L	18	24																							
			A	W1-8L	18	24		3.00							1		X											X	
EB	2.579		B	W1-8R	18	24																							
			B	W1-8R	18	24		3.00							1		X											X	
EB	2.612		A	W1-8L	18	24																							
			A	W1-8L	18	24		3.00							1		X											X	
EB	2.612		B	W1-8R	18	24																							
			B	W1-8R	18	24		3.00							1		X											X	
SIGN SUMMARY SHEET							SHEET TOTALS	24.00	0.00	0	0	0	7	0	0	8	120	0	0.0	0.0	0.0	0.0	PROJECT NAME: WOODFORD-MARLBORO						
VERMONT AGENCY OF TRANSPORTATION							TOWN DIRECTIONAL TOTALS	634.4	0.0	28.0	1.0	1.0	127	0.0	0.0	88	1320.0	0		0.0		PROJECT NUMBER: STPG SIGN(35)							
																						FILE NAME: 10B336							
																						PROJECT MANAGER: A. GAMBLE							
																						DRAWN BY: J. KELLY							
																						DESIGNED BY: J. KELLY							
																						CHECKED BY: A. GAMBLE							
																						SHEET 51 OF 80							







DIRECTION	MILEPOINT	LOCATION CODE (SHEET 2)	SIGN CODE	WIDTH (IN)	HEIGHT (IN)	SHEETING REMARKS	SIGN LEGEND	NEW SIGNS		EXISTING SIGNS				EXIST POST		NUMBER OF NEW POSTS	SQUARE STEEL (IN)			TUBULAR STEEL Ø (IN)				SIGN FRAME REQUIRED	REMARKS	SIGN DETAIL LOCATION			
								"A"	"B"	RETAIN	SALVAGE FROM	SALVAGE TO	REMOVE	RETAIN	REMOVE		1.75	2.00	2.50	FOUNDATION	3.0	3.50	4.00			5.00	SHSM	PROJECT SHEET #	STANDARD SHEET #
																	(LB / FT)				(LB / FT)								
MARLBORO EB							FY-FLUORESCENT YELLOW FYG-FLUORESCENT YELLOW GREEN															"SHSM"-STANDARD HIGHWAY SIGNS AND MARKINGS							
EB	2.618	C	VR-017	24	30					1														ADAMS CROSSROAD (TH-34)	RETAIN ROAD CLOSED RETAIN POST				
		C	VR-017	24	30			5.00																	7				
EB	2.628	D	R1-1	30	30					1														ADAMS CROSSROAD (TH-34)	TRIM BRUSH RETAIN MM RETAIN POST				
		D	R1-1	30	30			6.25															X						
EB	2.653	A	W1-8L	18	24							1																	
		A	W1-8L	18	24			3.00																	X				
EB	2.653	B	W1-8R	18	24							1																	
		B	W1-8R	18	24			3.00																	X				
EB	2.665	A	M3-2	24	12		EAST					1																	
		A	M1-5	24	24		VERMONT ROUTE 9					1																	
EB	2.703	A	R2-1	24	30		SPEED LIMIT 50					1																	
EB	2.756	A	S3-1	36	36	FYG		9.00																INSTALL 125 FEET WEST OF EXISTING HIDDEN DRIVES RIGHT AND SBSA ASSEMBLY.	X				
EB	2.780	A	VW-133R	30	30		HIDDEN DRIVES RIGHT				1																		
		A	S3-1	30	30		SCHOOL BUS STOP AHEAD					1																	
EB	2.794	A	VW-133R	30	30		HIDDEN DRIVES RIGHT																	INSTALL 75+/- FEET EAST OF EXISTING HIDDEN DRIVES RIGHT LOCATION.					
SIGN SUMMARY SHEET							SHEET TOTALS	26.25	0.00	0	1	1	9	0	0	5	75	0	0.0	0.0	0.0	0.0	0.0	PROJECT NAME: WOODFORD-MARLBORO					
								SF	SF	EA	EA	EA	EA	EA	EA	EA	FT	EA	LB	LB	LB	LB	PROJECT NUMBER: STPG SIGN(35)						
VERMONT AGENCY OF TRANSPORTATION							TOWN DIRECTIONAL TOTALS	634.4	0.0	28.0	1.0	1.0	127	0.0	0.0	88	1320.0	0		0.0				FILE NAME: 10B336					
																							PLOT DATE: 4/10/2012						
																							PROJECT MANAGER: A. GAMBLE						
																							DRAWN BY: J. KELLY						
																							CHECKED BY: A. GAMBLE						
																							DESIGNED BY: J. KELLY						
																							MARLBORO EB SHEET 7						
																							SHEET 52 OF 80						





DIRECTION	MILEPOINT	LOCATION CODE (SHEET 2)	SIGN CODE	WIDTH (IN)	HEIGHT (IN)	SHEETING REMARKS	SIGN LEGEND	NEW SIGNS		EXISTING SIGNS				EXIST POST		NUMBER OF NEW POSTS	SQUARE STEEL (IN)			TUBULAR STEEL Ø (IN)				SIGN FRAME REQUIRED	REMARKS	SIGN DETAIL LOCATION			
								"A"	"B"	RETAIN	SALVAGE FROM	SALVAGE TO	REMOVE	RETAIN	REMOVE		1.75	2.00	2.50	FOUNDATION	3.0	3.50	4.00			5.00	SHSM	PROJECT SHEET #	STANDARD SHEET #
																	(LB / FT)				(LB / FT)								
MARLBORO EB							FY-FLUORESCENT YELLOW FYG-FLUORESCENT YELLOW GREEN															"SHSM"-STANDARD HIGHWAY SIGNS AND MARKINGS							
EB	2.852	A	W7-1	48	48							1		X															
		A	W7-1a	36	36			9.00										X							X	TRIM BRUSH			
EB	2.978	A	S3-1	30	30		SCHOOL BUS STOP AHEAD					1		X															
EB	3.016	A	W1-2L	30	30		LEFT CURVE					1		X															
		A	S3-1	36	36	FYG	 	9.00										X							X				
EB	3.054	A	W1-2L	30	30			6.25										X							X	INSTALL 200 FEET EAST OF EXISTING LEFT CURVE SIGN.			
EB	3.212 3.117	A	D1-1M	72	20							1		X												RELOCATE TO 3.117 PER DISTRICT REQUEST			
		A	VD1-1	72	20			10.00										X								6			
EB	3.585	A	VD-062AS	72	16		BUSINESS SIGN			1				X															
EB	3.636	A	D1-1A	72	10							1		X												RETAIN POST			
		A	D1-1A	72	10							1																	
		A	VD1-1A	72	12			6.00																		6			
		A	VD1-1A	72	12			6.00																		6			
EB	3.678	A	D17-2	42	42			12.25										X								INSTALL 225 FEET EAST OF DESTINATION SIGN ASSEMBLY.			
EB	3.747	A	R4-6	24	30		TRUCK LANE 500 FEET					1		X												RETAIN POST			
SIGN SUMMARY SHEET							SHEET TOTALS	58.50	0.00	1	0	0	7	0	0	9	135	0	0.0	0.0	0.0	0.0	PROJECT NAME: WOODFORD-MARLBORO						
								SF	SF	EA	EA	EA	EA	EA	EA	EA	FT	EA	LB	LB	LB	LB	PROJECT NUMBER: STPG SIGN(35)						
							TOWN DIRECTIONAL TOTALS	634.4	0.0	28.0	1.0	1.0	127	0.0	0.0	88	1320.0	0		0.0			FILE NAME: 10B336						
VERMONT AGENCY OF TRANSPORTATION																							PLOT DATE: 4/10/2012						
																						DRAWN BY: J. KELLY							
																						DESIGNED BY: J. KELLY							
																						CHECKED BY: A. GAMBLE							
																						MARLBORO EB SHEET 8							
																						SHEET 53 OF 80							



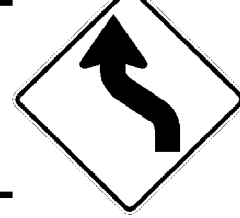


DIRECTION	MILEPOINT	LOCATION CODE (SHEET 2)	SIGN CODE	WIDTH (IN)	HEIGHT (IN)	SHEETING REMARKS	SIGN LEGEND	NEW SIGNS		EXISTING SIGNS				EXIST POST		NUMBER OF NEW POSTS	SQUARE STEEL (IN)			TUBULAR STEEL Ø (IN)				SIGN FRAME REQUIRED	REMARKS	SIGN DETAIL LOCATION			
								"A"	"B"	RETAIN	SALVAGE FROM	SALVAGE TO	REMOVE	RETAIN	REMOVE		1.75	2.00	2.50	FOUNDATION	3.0	3.50	4.00			5.00	SHSM	PROJECT SHEET #	STANDARD SHEET #
																	(LB / FT)				(LB / FT)								
MARLBORO EB							FY-FLUORESCENT YELLOW FYG-FLUORESCENT YELLOW GREEN															"SHSM"-STANDARD HIGHWAY SIGNS AND MARKINGS							
		A	M3-2	24	12			2.00																				E-136B	
		A	M1-5	24	24			4.00																				E-136B	
EB	3.789	A	M3-2	24	12		EAST					1	X									RETAIN POST						RETAIN POST	
		A	M1-5	24	24		VERMONT ROUTE 9 					1																	
		A	R2-1	24	30			5.00																		X			
EB	3.821	A	R2-1	24	30		SPEED LIMIT 50					1		X															
EB	3.854	A	R4-3	24	30							1	X	X															
		A	R4-3	24	30																					X			
EB	3.948	A	VW-133L	30	30		HIDDEN DRIVES LEFT					1		X															
EB	4.039	A	R4-3	24	30		SLOWER TRAFFIC KEEP RIGHT					1		X															
EB	4.086	A	W9-1R	36	36			9.00							2		X											INSTALL 300 FEET WEST OF LANE MERGE SYMBOL SIGN.	
EB	4.143	A	W4-2R	36	36							1		X															
		A	W4-2R	36	36			9.00							2		X									X			
EB	4.219	A	W1-2L	30	30	FY		6.25							1		X											INSTALL 400 FEET EAST OF RIGHT LANE REDUCTION SYMBOL SIGN.	
EB	4.288	A	W1-8L	24	30	FY		5.00							1		X											INSTALL 250 WEST OF EXISTING FIRST CHEVRON.	
SIGN SUMMARY SHEET							SHEET TOTALS	40.25	0.00	0	0	0	7	0	0	6	90	0	0.0	0.0	0.0	0.0	0.0	PROJECT NAME: WOODFORD-MARLBORO					
								SF	SF	EA	EA	EA	EA	EA	EA	EA	FT	EA	LB	LB	LB	LB	PROJECT NUMBER: STPG SIGN(35)						
							TOWN DIRECTIONAL TOTALS	634.4	0.0	28.0	1.0	1.0	127	0.0	0.0	88	1320.0	0			0.0			FILE NAME: 10B336 PLOT DATE: 4/10/2012					
																							PROJECT MANAGER: A. GAMBLE DRAWN BY: J. KELLY						
																							DESIGNED BY: J. KELLY CHECKED BY: A. GAMBLE						
																							MARLBORO EB SHEET 9 SHEET 54 OF 80						





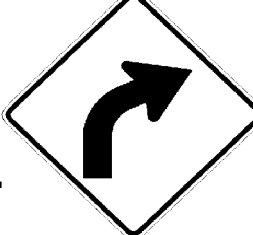


DIRECTION	MILEPOINT	LOCATION CODE (SHEET 2)	SIGN CODE	WIDTH (IN)	HEIGHT (IN)	SHEETING REMARKS	SIGN LEGEND	NEW SIGNS		EXISTING SIGNS				EXIST POST		NUMBER OF NEW POSTS	SQUARE STEEL (IN)			TUBULAR STEEL Ø (IN)				SIGN FRAME REQUIRED	REMARKS	SIGN DETAIL LOCATION			
								"A"	"B"	RETAIN	SALVAGE FROM	SALVAGE TO	REMOVE	RETAIN	REMOVE		1.75	2.00	2.50	FOUNDATION	3.0	3.50	4.00			5.00	SHSM	PROJECT SHEET #	STANDARD SHEET #
																	(LB / FT)				(LB / FT)								
MARLBORO EB							FY-FLUORESCENT YELLOW FYG-FLUORESCENT YELLOW GREEN															"SHSM"-STANDARD HIGHWAY SIGNS AND MARKINGS							
EB	4.322	C	VR-017	24	30							1	X									RETAIN POST		TOWN HILL RD (TH-4)		RETAIN POST			
		C	VR-017	24	30			5.00																		7			
EB	4.330	D	R1-1	30	30							1	X									RETAIN POST		TOWN HILL RD (TH-4)		RETAIN POST			
		D	R1-1	30	30		 	6.25																		X			
EB	4.335	A	W1-8L	18	24							1		X															
		A	W1-8L	24	30	FY		5.00						1		X										X			
EB	4.360	A	W1-8L	18	24		CHEVRON					1		X															
EB	4.385	A	W1-8L	18	24							1		X															
		A	W1-8L	24	30	FY		5.00						1		X										X			
EB	4.409	A	W1-8L	18	24		CHEVRON					1		X															
EB	4.654	A	VW-619	36	36							1		X															
		A	VW-619	36	36			9.00						2		X											8		
EB	4.827	A	M3-2	24	12							1	X									RETAIN POST				RETAIN POST			
		A	M1-5	24	24							1																	
		A	M3-2	24	12			2.00																			E-136B		
SIGN SUMMARY SHEET							SHEET TOTALS	32.25	0.00	0	0	0	9	0	0	4	60	0	0.0	0.0	0.0	0.0	0.0	PROJECT NAME: WOODFORD-MARLBORO					
VERMONT AGENCY OF TRANSPORTATION							TOWN DIRECTIONAL TOTALS	634.4	0.0	28.0	1.0	1.0	127	0.0	0.0	88	1320.0	0		0.0				PROJECT NUMBER: STPG SIGN(35)					
																							FILE NAME: 10B336						
																							PLOT DATE: 4/10/2012						
																							DRAWN BY: J. KELLY						
																							DESIGNED BY: J. KELLY						
																							CHECKED BY: A. GAMBLE						
																							MARLBORO EB SHEET 10						
																							SHEET 55 OF 80						


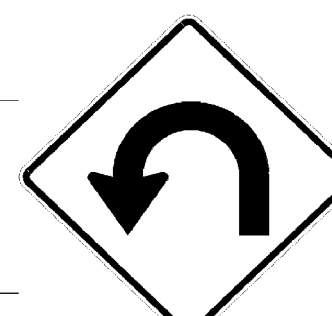





DIRECTION	MILEPOINT	LOCATION CODE (SHEET 2)	SIGN CODE	WIDTH (IN)	HEIGHT (IN)	SHEETING REMARKS	SIGN LEGEND	NEW SIGNS		EXISTING SIGNS				EXIST POST		NUMBER OF NEW POSTS	SQUARE STEEL (IN)			TUBULAR STEEL Ø (IN)				SIGN FRAME REQUIRED	REMARKS	SIGN DETAIL LOCATION			
								"A"	"B"	RETAIN	SALVAGE FROM	SALVAGE TO	REMOVE	RETAIN	REMOVE		1.75	2.00	2.50	FOUNDATION	3.0	3.50	4.00			5.00	SHSM	PROJECT SHEET #	STANDARD SHEET #
																	(LB / FT)				(LB / FT)								
MARLBORO EB							FY-FLUORESCENT YELLOW FYG-FLUORESCENT YELLOW GREEN																"SHSM"-STANDARD HIGHWAY SIGNS AND MARKINGS						
		A	M1-5	24	24			4.00																			E-136B		
		A	VM-120	18	24		MOLLY STARK BYWAY			1																			
EB	4.856	A	R2-1	24	30		SPEED LIMIT 50						1			X													
EB	4.903	A	W1-2R	30	30	FY		6.25						1			X										INSTALL 250 FEET EAST OF EXISTING SPEED LIMIT 50 ASSEMBLY.		
EB	5.065	A	VW-133R	30	30		HIDDEN DRIVES RIGHT			1					X														
EB	5.090	A	S3-1	30	30							1				X													
		A	S3-1	36	36	FYG		9.00						2			X										X		
EB	5.241	A	W1-10L	30	30		LEFT CURVE WITH SIDE ROAD RIGHT																						
		A	W13-1	18	18		35 MPH ADVISORY					1																	
		A	W1-10L	36	36	FY		9.00																			X		
		A	W16-8P	24	8	FY		1.33																			8		
EB	5.255	A	VD-062B	72	16		BUSINESS SIGN			1					X														
EB	5.293	A	W1-6L	48	24		LARGE ARROW			1					X														
EB	5.293	B	W1-8R	24	30		CHEVRON			1					X														
EB	5.307	A	VW-205	30	30		WATCH FOR TURNING VEHICLES					1				X													
SIGN SUMMARY SHEET							SHEET TOTALS	29.58	0.00	6	0	0	5 4	0	0	3	45	0	0.0	0.0	0.0	0.0	0.0	PROJECT NAME: WOODFORD-MARLBORO PROJECT NUMBER: STPG SIGN(35)					
VERMONT AGENCY OF TRANSPORTATION							TOWN DIRECTIONAL TOTALS	634.4	0.0	28.0	1.0	1.0	127	0.0	0.0	88	1320.0	0			0.0			FILE NAME: 10B336 PLOT DATE: 4/10/2012 PROJECT MANAGER: A. GAMBLE DRAWN BY: J. KELLY DESIGNED BY: J. KELLY CHECKED BY: A. GAMBLE MARLBORO EB SHEET 11 SHEET 56 OF 80					



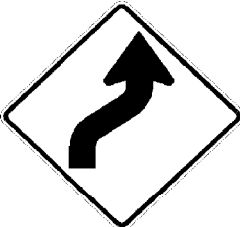







DIRECTION	MILEPOINT	LOCATION CODE (SHEET 2)	SIGN CODE	WIDTH (IN)	HEIGHT (IN)	SHEETING REMARKS	SIGN LEGEND	NEW SIGNS		EXISTING SIGNS				EXIST POST		NUMBER OF NEW POSTS	SQUARE STEEL (IN)			TUBULAR STEEL Ø (IN)				SIGN FRAME REQUIRED	REMARKS	SIGN DETAIL LOCATION										
								"A"	"B"	RETAIN	SALVAGE FROM	SALVAGE TO	REMOVE	RETAIN	REMOVE		1.75	2.00	2.50	FOUNDATION	3.0	3.50	4.00			5.00	SHSM	PROJECT SHEET #	STANDARD SHEET #							
																	(LB / FT)				(LB / FT)															
MARLBORO EB							FY-FLUORESCENT YELLOW FYG-FLUORESCENT YELLOW GREEN																"SHSM"-STANDARD HIGHWAY SIGNS AND MARKINGS													
EB	5.319	A	W1-8L	24	30		CHEVRON			1				X																						
EB	5.319	B	W1-8R	24	30		CHEVRON			1				X																						
EB	5.341	A	W1-8L	24	30		CHEVRON			1				X																						
EB	5.341	B	W1-8R	24	30		CHEVRON			1				X																						
EB	5.358	A	D1-1	72	10							1		X																						
		A	VD1-1A	72	12				6.00							2		X																	6	
EB	5.377	A	W1-8L	24	30		CHEVRON			1				X																						
EB	5.378	B	W1-8R	24	30		CHEVRON			1				X																						
EB	5.398	C	VR-017	24	30		(ASSEMBLY IS MISSING)																													
		C	VR-017	24	30		  INSTALL BELOW LLL 	5.00								1		X																		
EB	5.409	D	R1-1	30	30								1		X																					
		D	R1-1	30	30				6.25																											
EB	5.413	A	W1-8L	24	30		(ASSEMBLY IS MISSING)																													
		A	W1-8L	24	30	FY		5.00																												
EB	5.414	B	W1-6R	48	24		LARGE ARROW			1				X																						
SIGN SUMMARY SHEET							SHEET TOTALS	22.25	0.00	7	0	0	4	0	0	4		60		0	0.0	0.0	0.0	0.0												
								SF	SF	EA	EA	EA	EA	EA	EA	EA		FT		EA	LB	LB	LB	LB												
VERMONT AGENCY OF TRANSPORTATION							TOWN DIRECTIONAL TOTALS	634.4	0.0	28.0	1.0	1.0	127	0.0	0.0	88		1320.0		0					0.0											
													PROJECT NAME: WOODFORD-MARLBORO						PROJECT NUMBER: STPG SIGN(35)																	
													FILE NAME: 10B336						PLOT DATE: 4/10/2012																	
													PROJECT MANAGER: A. GAMBLE						DRAWN BY: J. KELLY																	
													DESIGNED BY: J. KELLY						CHECKED BY: A. GAMBLE																	
													MARLBORO EB SHEET 12						SHEET 57 OF 80																	


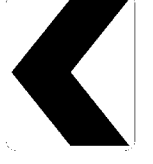




DIRECTION	MILEPOINT	LOCATION CODE (SHEET 2)	SIGN CODE	WIDTH (IN)	HEIGHT (IN)	SHEETING REMARKS	SIGN LEGEND	NEW SIGNS		EXISTING SIGNS				EXIST POST		NUMBER OF NEW POSTS	SQUARE STEEL (IN)			TUBULAR STEEL Ø (IN)				SIGN FRAME REQUIRED	REMARKS	SIGN DETAIL LOCATION									
								"A"	"B"	RETAIN	SALVAGE FROM	SALVAGE TO	REMOVE	RETAIN	REMOVE		1.75	2.00	2.50	FOUNDATION	3.0	3.50	4.00			5.00	SHSM	PROJECT SHEET #	STANDARD SHEET #						
																	(LB / FT)				(LB / FT)														
MARLBORO EB							FY-FLUORESCENT YELLOW FYG-FLUORESCENT YELLOW GREEN																"SHSM"-STANDARD HIGHWAY SIGNS AND MARKINGS												
EB	5.437	A	W1-8L	24	30		CHEVRON			1				X																					
EB	5.454	A	S1-1	36	36		SCHOOL PENTAGON			1				X																	RETAIN POSTS				
		A	W16-9	30	18		AHEAD						1																						
		A	S4-3P	36	12	FYG		3.00																							X	INSTALL BELOW EXISTING SCHOOL SYMBOL SIGN.			
EB	5.496	A	D1-1E	72	20			10.00					1	X																		RETAIN POSTS			
		A	VD1-1	72	20																											7			
EB	5.762	A	VW-092	36	36			9.00					1	X																		RETAIN POSTS			
		A	VW-092	36	36																											8			
EB	5.803	A	W1-4R	30	30		RIGHT REVERSE CURVE						1		X																				
EB	6.009	A	W1-8L	18	24		CHEVRON						1		X																				
EB	6.053	A	R2-1	24	30		SPEED LIMIT 50						1		X																				
EB	6.056	A	W1-8L	18	24		CHEVRON																												
		A	W1-6L	48	24	FY		8.00								2		X														X			
EB	6.084	A	W1-8L	18	24		CHEVRON						1		X																				
EB	6.324	A	VW-205	36	36		WATCH FOR TURNING VEHICLES						1		X																				
SIGN SUMMARY SHEET							SHEET TOTALS	30.00	0.00	2	0	0	9	0	0	2		30	0	0.0	0.0	0.0	0.0		PROJECT NAME: WOODFORD-MARLBORO PROJECT NUMBER: STPG SIGN(35)										
VERMONT AGENCY OF TRANSPORTATION							TOWN DIRECTIONAL TOTALS	SF	SF	EA	EA	EA	EA	EA	EA	EA	EA	EA	EA	EA	EA	EA	EA	EA	EA	EA	EA	EA	EA	EA	EA	EA	EA	EA	EA
							634.4	0.0	28.0	1.0	1.0	127	0.0	0.0	88		1320.0	0		0.0					FILE NAME: 10B336 PLOT DATE: 4/10/2012 PROJECT MANAGER: A. GAMBLE DRAWN BY: J. KELLY DESIGNED BY: J. KELLY CHECKED BY: A. GAMBLE MARLBORO EB SHEET 13 SHEET 58 OF 80										

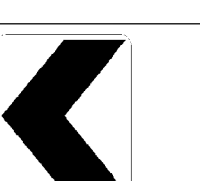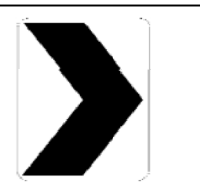





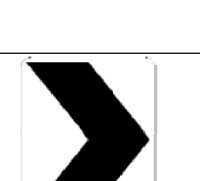
DIRECTION	MILEPOINT	LOCATION CODE (SHEET 2)	SIGN CODE	WIDTH (IN)	HEIGHT (IN)	SHEETING REMARKS	SIGN LEGEND	NEW SIGNS		EXISTING SIGNS				EXIST POST		NUMBER OF NEW POSTS	SQUARE STEEL (IN)			TUBULAR STEEL Ø (IN)				SIGN FRAME REQUIRED	REMARKS	SIGN DETAIL LOCATION			
								"A"	"B"	RETAIN	SALVAGE FROM	SALVAGE TO	REMOVE	RETAIN	REMOVE		1.75	2.00	2.50	FOUNDATION	3.0	3.50	4.00			5.00	SHSM	PROJECT SHEET #	STANDARD SHEET #
																	(LB / FT)				(LB / FT)								
MARLBORO EB							FY-FLUORESCENT YELLOW FYG-FLUORESCENT YELLOW GREEN																"SHSM"-STANDARD HIGHWAY SIGNS AND MARKINGS						
EB	6.377	A	VW-205	36	36			9.00							2		X							INSTALL 50 FEET WEST OF CURRENT RIGHT CURVE SIGN LOCATION.		8			
EB	6.387	A	W1-2R	30	30		RIGHT CURVE						1			X													
EB	6.415	A	W1-2R	30	30			6.25							1		X							INSTALL 150 FEET EAST OF CURRENT LOCATION.	X				
EB	6.606	A	S3-1	30	30							1				X											TRIM BRUSH		
		A	S3-1	36	36	FYG		9.00							2		X								X				
EB	6.819	A	W1-4L	30	30			6.25							1		X							INSTALL 75 FEET WEST OF EXISTING UNSAFE TO PASS ASSEMBLY.	X				
EB	6.833	A	VW-092	36	36		UNSAFE TO PASS					1				X													
EB	6.866	A	W1-2L	30	30		RIGHT LEFT CURVE					1				X											RIGHT CURVE		
		A	W13-1	18	18		40 MPH ADVISORY					1																	
		A	W1-6L	48	24			8.00							2		X								X				
EB	7.015	A	W1-4L	30	30		RIGHT REVERSE CURVE					1				X													
		A	W13-1	18	18		40 MPH ADVISORY					1																	
EB	7.080	A	W8-5	30	30		SLIPPERY WHEN WET CAR SYMBOL			1						X													
		A	VW-116	24	18		ICING MAY OCCUR			1																			
EB	7.157	A	S3-1	30	30							1				X													
SIGN SUMMARY SHEET							TOTALS	38.50	0.00	2	0	0	8	0	0	8		120	0	0.0	0.0	0.0	0.0		PROJECT NAME: WOODFORD-MARLBORO				
								SF	SF	EA	EA	EA	EA	EA	EA	EA		FT	EA	LB	LB	LB	LB		PROJECT NUMBER: STPG SIGN(35)				
							TOWN DIRECTIONAL TOTALS	634.4	0.0	28.0	1.0	1.0	127	0.0	0.0	88		1320.0	0			0.0			FILE NAME: 10B336				
VERMONT AGENCY OF TRANSPORTATION																								PLOT DATE: 4/10/2012					
																							DRAWN BY: J. KELLY						
																							DESIGNED BY: J. KELLY						
																							CHECKED BY: A. GAMBLE						
																							MARLBORO EB SHEET 14						
																							SHEET 59 OF 80						


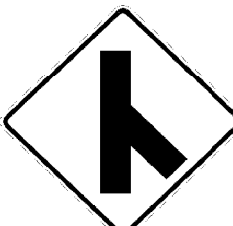



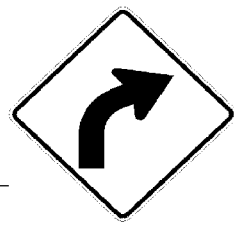


DIRECTION	MILEPOINT	LOCATION CODE (SHEET 2)	SIGN CODE	WIDTH (IN)	HEIGHT (IN)	SHEETING REMARKS	SIGN LEGEND	NEW SIGNS		EXISTING SIGNS				EXIST POST		NUMBER OF NEW POSTS	SQUARE STEEL (IN)			TUBULAR STEEL Ø (IN)				SIGN FRAME REQUIRED	REMARKS	SIGN DETAIL LOCATION			
								"A"	"B"	RETAIN	SALVAGE FROM	SALVAGE TO	REMOVE	RETAIN	REMOVE		1.75	2.00	2.50	FOUNDATION	3.0	3.50	4.00			5.00	SHSM	PROJECT SHEET #	STANDARD SHEET #
																	(LB / FT)				(LB / FT)								
MARLBORO EB							FY-FLUORESCENT YELLOW FYG-FLUORESCENT YELLOW GREEN															"SHSM"-STANDARD HIGHWAY SIGNS AND MARKINGS							
		A	S3-1	36	36	FYG		9.00							2	X								X					
EB	7.241	A	VD-062B	72	16		BUSINESS SIGN			1				X															
EB	7.309	C	VR-017	24	30							1	X						RETAIN POST						RETAIN POST				
		C	VR-017	24	30			5.00																	7				
EB	7.319	D	R1-1	30	30							1	X																
		D	R1-1	30	30			6.25							1	X								X					
EB	7.368	A	M3-2	24	12							1	X						RETAIN POST					RETAIN POST					
		A	M1-5	24	24							1																	
		A	M3-2	24	12			2.00																	E-136B				
		A	M1-5	24	24			4.00																	E-136B				
EB	7.406	A	R2-1	24	30							1	X						RETAIN POST					RETAIN POST					
		A	R2-1	24	30			5.00																X					
EB	7.515	A	W1-4R	30	30		RIGHT REVERSE CURVE					1	X																
		A	W13-1P	18	18		40 MPH ADVISORY					1																	
EB	7.535	A	W1-4R	30	30	FY		6.25							1	X									INSTALL 100+/- FEET EAST OF EXISTING REVERSE CURVE ASSEMBLY.				
SIGN SUMMARY SHEET							SHEET TOTALS	37.50	0.00	1	0	0	7	0	0	4	60	0	0.0	0.0	0.0	0.0	PROJECT NAME: WOODFORD-MARLBORO						
								SF	SF	EA	EA	EA	EA	EA	EA	EA	FT	EA	LB	LB	LB	LB	PROJECT NUMBER: STPG SIGN(35)						
							TOWN DIRECTIONAL TOTALS	634.4	0.0	28.0	1.0	1.0	127	0.0	0.0	88	1320.0	0		0.0				FILE NAME: 10B336 PLOT DATE: 4/10/2012					
VERMONT AGENCY OF TRANSPORTATION																							PROJECT MANAGER: A. GAMBLE DRAWN BY: J. KELLY						
																							DESIGNED BY: J. KELLY CHECKED BY: A. GAMBLE						
																							MARLBORO EB SHEET 15 SHEET 60 OF 80						



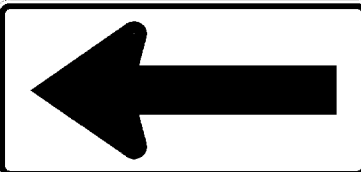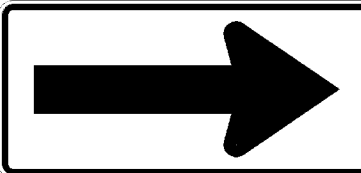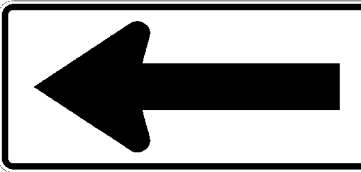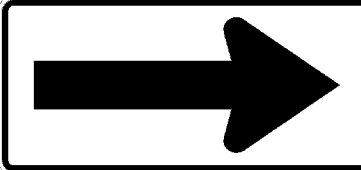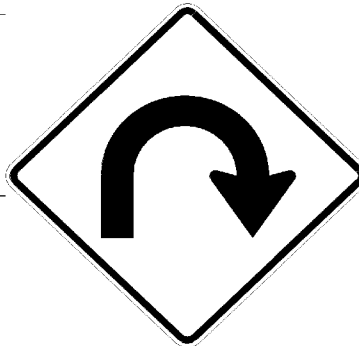


DIRECTION	MILEPOINT	LOCATION CODE (SHEET 2)	SIGN CODE	WIDTH (IN)	HEIGHT (IN)	SHEETING REMARKS	SIGN LEGEND	NEW SIGNS		EXISTING SIGNS				EXIST POST		NUMBER OF NEW POSTS	SQUARE STEEL (IN)			TUBULAR STEEL Ø (IN)				SIGN FRAME REQUIRED	REMARKS	SIGN DETAIL LOCATION			
								"A"	"B"	RETAIN	SALVAGE FROM	SALVAGE TO	REMOVE	RETAIN	REMOVE		1.75	2.00	2.50	FOUNDATION	3.0	3.50	4.00			5.00	SHSM	PROJECT SHEET #	STANDARD SHEET #
																	(LB / FT)				(LB / FT)								
MARLBORO EB							FY-FLUORESCENT YELLOW FYG-FLUORESCENT YELLOW GREEN															"SHSM"-STANDARD HIGHWAY SIGNS AND MARKINGS							
			W13-1P	18	18	FY		2.25																X					
EB	7.636	A	VW-537L	48	48		LEFT ACUTE CURVE					1		X															
		A	W13-1	18	18		30 MPH ADVISORY					1													TRIM BRUSH				
		A	W1-11L	36	36	FY		9.00							2		X						SEE SHEET 2.	X	SLIP BASES				
		A	W13-1P	24	24	FY		4.00																X					
EB	7.695	A	W1-8L	24	30							1		X															
		A	W1-8L	24	30	FY		5.00							1		X							X					
EB	7.695	B	W1-8R	24	30							1		X															
		B	W1-8R	24	30	FY		5.00							1		X							X					
EB	7.717	A	W1-8L	24	30							1		X															
		A	W1-8L	24	30	FY		5.00							1		X							X					
EB	7.717	B	W1-8R	24	30							1		X															
		B	W1-8R	24	30	FY		5.00							1		X							X					
EB	7.735	A	W1-1LM	30	30		LEFT TURN WITH LEFT SIDE ROAD					1		X															
		A	W13-1P	18	18		30 MPH ADVISORY					1																	
SIGN SUMMARY SHEET							SHEET TOTALS	35.25	0.00	0	0	0	8	0	0	6	90	0	0.0	0.0	0.0	0.0	PROJECT NAME: WOODFORD-MARLBORO PROJECT NUMBER: STPG SIGN(35)						
								SF	SF	EA	EA	EA	EA	EA	EA	EA	FT	EA	LB	LB	LB	LB	FILE NAME: 10B336 PLOT DATE: 4/10/2012 PROJECT MANAGER: A. GAMBLE DRAWN BY: J. KELLY DESIGNED BY: J. KELLY CHECKED BY: A. GAMBLE MARLBORO EB SHEET 16 SHEET 61 OF 80						
VERMONT AGENCY OF TRANSPORTATION							TOWN DIRECTIONAL TOTALS	634.4	0.0	28.0	1.0	1.0	127	0.0	0.0	88	1320.0	0		0.0									








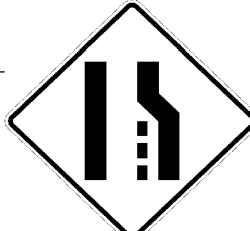
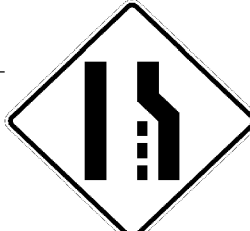
DIRECTION	MILEPOINT	LOCATION CODE (SHEET 2)	SIGN CODE	WIDTH (IN)	HEIGHT (IN)	SHEETING REMARKS	SIGN LEGEND	NEW SIGNS		EXISTING SIGNS				EXIST POST		NUMBER OF NEW POSTS	SQUARE STEEL (IN)			TUBULAR STEEL Ø (IN)				SIGN FRAME REQUIRED	REMARKS	SIGN DETAIL LOCATION			
								"A"	"B"	RETAIN	SALVAGE FROM	SALVAGE TO	REMOVE	RETAIN	REMOVE		1.75	2.00	2.50	FOUNDATION	3.0	3.50	4.00			5.00	SHSM	PROJECT SHEET #	STANDARD SHEET #
																	(LB / FT)				(LB / FT)								
MARLBORO EB							FY-FLUORESCENT YELLOW FYG-FLUORESCENT YELLOW GREEN																"SHSM"-STANDARD HIGHWAY SIGNS AND MARKINGS						
			A	W1-8L	24	30	FY		5.00																		X		
EB	7.735		B	W1-8R	24	30	FY		5.00																		X		
EB	7.763		A	W1-8L	24	30		CHEVRON					1		X														
			A	W1-1L	30	30	FY		6.25																		X		
			A	W13-1P	18	18	FY		2.25																		X		
EB	7.786		A	W1-8L	24	30							1		X														
			A	W1-8L	24	30	FY		5.00																		X		
EB	7.786		B	W1-8R	24	30							1		X														
			B	W1-8R	24	30	FY		5.00																		X		
EB	7.812		A	W1-8L	24	30							1		X												R/S MM		
			A	W1-8L	24	30	FY		5.00																		X		
EB	7.812		B	W1-8R	24	30							1		X														
			B	W1-8R	24	30	FY		5.00																		X		
EB	7.830		A	W1-8L	24	30							1		X														
			A	W1-8L	24	30	FY		5.00																		X		
SIGN SUMMARY SHEET							SHEET TOTALS	43.50	0.00	0	0	0	7	0	0	8	120	0	0.0	0.0	0.0	0.0	0.0	PROJECT NAME: WOODFORD-MARLBORO PROJECT NUMBER: STPG SIGN(35)					
								SF	SF	EA	EA	EA	EA	EA	EA	EA	FT	EA	LB	LB	LB	LB	FILE NAME: 10B336 PLOT DATE: 4/10/2012 PROJECT MANAGER: A. GAMBLE DRAWN BY: J. KELLY DESIGNED BY: J. KELLY CHECKED BY: A. GAMBLE MARLBORO EB SHEET 17 SHEET 62 OF 80						
VERMONT AGENCY OF TRANSPORTATION							TOWN DIRECTIONAL TOTALS	634.4	0.0	28.0	1.0	1.0	127	0.0	0.0	88	1320.0	0		0.0									










DIRECTION	MILEPOINT	LOCATION CODE (SHEET 2)	SIGN CODE	WIDTH (IN)	HEIGHT (IN)	SHEETING REMARKS	SIGN LEGEND	NEW SIGNS		EXISTING SIGNS				EXIST POST		NUMBER OF NEW POSTS	SQUARE STEEL (IN)			TUBULAR STEEL Ø (IN)				SIGN FRAME REQUIRED	REMARKS	SIGN DETAIL LOCATION				
								"A"	"B"	RETAIN	SALVAGE FROM	SALVAGE TO	REMOVE	RETAIN	REMOVE		1.75	2.00	2.50	FOUNDATION	3.0	3.50	4.00			5.00	SHSM	PROJECT SHEET #	STANDARD SHEET #	
																	(LB / FT)				(LB / FT)									
MARLBORO EB							FY-FLUORESCENT YELLOW FYG-FLUORESCENT YELLOW GREEN																"SHSM"-STANDARD HIGHWAY SIGNS AND MARKINGS							
EB	7.830	B	W1-8R	24	30																									
		B	W1-8R	24	30	FY		5.00																						X
EB	7.852	A	W1-8L	24	30																									
		A	W1-8L	24	30	FY		5.00																						X
EB	7.852	B	W1-8R	24	30																									
		B	W1-8R	24	30	FY	 	5.00																						X
EB	7.885	A	S3-1	36	36	FYG																								
EB	7.898	A	W1-2R	30	30		RIGHT CURVE																							
		A	W13-1P	18	18		35 MPH ADVISORY																							
EB	7.923	A	S3-1	30	30		SCHOOL BUS STOP AHEAD																							
		A	W1-2R	30	30	FY		6.25																						X
		A	W13-1P	18	18	FY		2.25																						X
EB	8.039	A	W1-2R	30	30		RIGHT CURVE																							
EB	8.088	A	M3-2	24	12		EAST																							
		A	M1-5	24	24		VERMONT ROUTE 9																							
SIGN SUMMARY SHEET							SHEET TOTALS		32.50	0.00	0	0	0	9	0	0	6	90	0	0.0	0.0	0.0	0.0	PROJECT NAME: WOODFORD-MARLBORO						
VERMONT AGENCY OF TRANSPORTATION							TOWN DIRECTIONAL TOTALS		634.4	0.0	28.0	1.0	1.0	127	0.0	0.0	88	1320.0	0		0.0				PROJECT NUMBER: STPG SIGN(35)					
																								FILE NAME: 10B336						
																								PLOT DATE: 4/10/2012						
																								DRAWN BY: J. KELLY						
																								CHECKED BY: A. GAMBLE						
																								MARLBORO EB SHEET 18						
																								SHEET 63 OF 80						






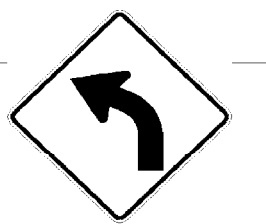

DIRECTION	MILEPOINT	LOCATION CODE (SHEET 2)	SIGN CODE	WIDTH (IN)	HEIGHT (IN)	SHEETING REMARKS	SIGN LEGEND	NEW SIGNS		EXISTING SIGNS				EXIST POST		NUMBER OF NEW POSTS	SQUARE STEEL (IN) (LB / FT)			TUBULAR STEEL Ø (IN) (LB / FT)				SIGN FRAME REQUIRED	REMARKS	SIGN DETAIL LOCATION									
								"A"	"B"	RETAIN	SALVAGE FROM	SALVAGE TO	REMOVE	RETAIN	REMOVE		1.75	2.00	2.50	FOUNDATION	3.0	3.50	4.00			5.00	SHSM	PROJECT SHEET #	STANDARD SHEET #						
																														1.88	2.42	3.35	7.6	9.00	10.80
MARLBORO WB							FY-FLUORESCENT YELLOW FYG-FLUORESCENT YELLOW GREEN																"SHSM"-STANDARD HIGHWAY SIGNS AND MARKINGS												
WB	8.104	F	W1-2L	30	30		LEFT CURVE																												
		F	W13-1P	18	18		35 MPH ADVISORY																												
WB	8.047	F	W1-2L	30	30	FY		6.25																	INSTALL 300 FEET WEST OF EXISTING LEFT CURVE SIGN ASSEMBLY.	X									
		F	W13-1P	18	18	FY		2.25																			X								
WB	8.005	F	W1-6L	48	24																														
		F	W1-6L	48	24	FY		8.00																			X								
WB	8.004	E	W1-6R	48	24																														
WB	8.003	E	W1-6R	48	24	FY		8.00																		MAINTAIN 10 FEET CLEAR SPACE BETWEEN SIGNS.	X								
WB	7.971	F	W1-6L	48	24																														
		F	W1-6L	48	24	FY		8.00																			X								
WB	7.970	E	W1-6R	48	24																														
WB	7.969	E	W1-6R	48	24	FY		8.00																		MAINTAIN 10 FEET CLEAR SPACE BETWEEN SIGNS.	X								
WB	7.945	F	VW-538RM	48	48		MODIFIED RIGHT ACUTE CURVE																												
		F	W13-1	24	24																														
		F	W1-11R	36	36	FY		9.00																		SEE SHEET 2.	X								
SIGN SUMMARY SHEET							SHEET TOTALS	49.50	0.00	0	0	0	8	0	0	11	165	0	0.0	0.0	0.0	0.0		PROJECT NAME: WOODFORD-MARLBORO PROJECT NUMBER: STPG SIGN(35)											
VERMONT AGENCY OF TRANSPORTATION							TOWN DIRECTIONAL TOTALS	607.1	0.0	23.0	1.0	1.0	117	0.0	0.0	70	1050.0	0			0.0			FILE NAME: 10B336 PROJECT MANAGER: A. GAMBLE DESIGNED BY: J. KELLY MARLBORO WB SHEET 1						PLOT DATE: 4/10/2012 DRAWN BY: J. KELLY CHECKED BY: A. GAMBLE SHEET 64 OF 80					


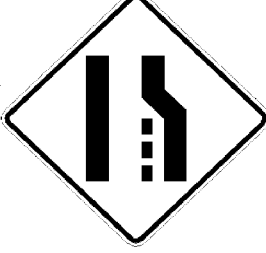


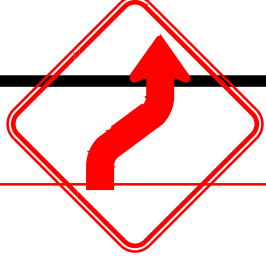

DIRECTION	MILEPOINT	LOCATION CODE (SHEET 2)	SIGN CODE	WIDTH (IN)	HEIGHT (IN)	SHEETING REMARKS	SIGN LEGEND	NEW SIGNS		EXISTING SIGNS				EXIST POST		NUMBER OF NEW POSTS	SQUARE STEEL (IN)			TUBULAR STEEL Ø (IN)				SIGN FRAME REQUIRED	REMARKS	SIGN DETAIL LOCATION			
								"A"	"B"	RETAIN	SALVAGE FROM	SALVAGE TO	REMOVE	RETAIN	REMOVE		1.75	2.00	2.50	FOUNDATION	3.0	3.50	4.00			5.00	SHSM	PROJECT SHEET #	STANDARD SHEET #
																	(LB / FT)				(LB / FT)								
MARLBORO WB							FY-FLUORESCENT YELLOW FYG-FLUORESCENT YELLOW GREEN																"SHSM"-STANDARD HIGHWAY SIGNS AND MARKINGS						
		F	W13-1	24	24	FY		4.00																	X				
WB	7.898	F	W2-3L	30	30	FY		6.25							1		X							INSTALL 250 FEET WEST OF RIGHT ACUTE CURVE SIGN ASSEMBLY.	X				
WB	7.821	G	VR-017	24	30									1		X								HAMILTON RD (TH-22)					
		G	VR-017	24	30			5.00							1		X										7		
WB	7.812	H	R1-1	30	30									1		X								HAMILTON RD (TH-22)					
		H	R1-1	30	30			6.25							1		X								X				
							TOWN'S STREET NAME SIGN				1	1	1											REINSTALL ABOVE STOP SIGN USING BRACKET.					
WB	7.789	F	W1-4R	30	30		RIGHT REVERSE CURVE							1		X													
		F	W13-1P	18	18		40 MPH ADVISORY							1															
WB	7.751	F	W1-2R	30	30	FY		6.25							1		X							INSTALL 200 FEET WEST OF EXISTING REVERSE CURVE SIGN ASSEMBLY.	X				
		F	W13-1P	18	18	FY		2.25																	X				
WB	7.736	F	M3-4	24	12		WEST							1		X													
		F	M1-5	24	24		VERMONT ROUTE 9							1															
WB	7.700	F	S3-1	30	30		SCHOOL BUS STOP AHEAD							1		X													
		F	S3-1	36	36			9.00							2		X							CUT BRUSH IN ADVANCE OF SIGN.	X	TRIM BRUSH			
SIGN SUMMARY SHEET							SHEET TOTALS	39.00	0.00	0	4 2	4 2	8 9	0	0	6	90	0	0.0	0.0	0.0	0.0		PROJECT NAME: WOODFORD-MARLBORO					
								SF	SF	EA	EA	EA	EA	EA	EA	EA	FT	EA	LB	LB	LB	LB		PROJECT NUMBER: STPG SIGN(35)					
VERMONT AGENCY OF TRANSPORTATION							TOWN DIRECTIONAL TOTALS	607.1	0.0	23.0	1.0	1.0	117	0.0	0.0	70	1050.0	0		0.0					FILE NAME: 10B336				
																								PLOT DATE: 4/10/2012					
																								PROJECT MANAGER: A. GAMBLE					
																								DESIGNED BY: J. KELLY					
																								CHECKED BY: A. GAMBLE					
																								MARLBORO WB SHEET 2					
																								SHEET 65 OF 80					






DIRECTION	MILEPOINT	LOCATION CODE (SHEET 2)	SIGN CODE	WIDTH (IN)	HEIGHT (IN)	SHEETING REMARKS	SIGN LEGEND	NEW SIGNS		EXISTING SIGNS				EXIST POST		NUMBER OF NEW POSTS	SQUARE STEEL (IN)			TUBULAR STEEL Ø (IN)				SIGN FRAME REQUIRED	REMARKS	SIGN DETAIL LOCATION			
								"A"	"B"	RETAIN	SALVAGE FROM	SALVAGE TO	REMOVE	RETAIN	REMOVE		1.75	2.00	2.50	FOUNDATION	3.0	3.50	4.00			5.00	SHSM	PROJECT SHEET #	STANDARD SHEET #
																	(LB / FT)				(LB / FT)								
MARLBORO WB							FY-FLUORESCENT YELLOW FYG-FLUORESCENT YELLOW GREEN															"SHSM"-STANDARD HIGHWAY SIGNS AND MARKINGS	TRIM BRUSH						
WB	7.517	F	D17-2	42	42			12.25							2		X							INSTALL 200 FEET EAST OF EXISTING BUSINESS SIGN.	6				
WB	7.479	F	VD-062B	72	16		BUSINESS SIGN			1																			
WB	7.451	F	VD-123	36	36		511 TRAVEL INFO			1																			
WB	7.390	F	R4-6	36	48		TRUCK LANE 500 FEET					1																	
WB	7.345	F	W1-4R	30	30							1																	
		F	W13-1P	18	18							1																	
		F	W1-4R	30	30			6.25																		X			
		F	W13-1P	18	18			2.25																		X			
WB	7.296	F	R4-3	24	30							1																	
		F	R4-3	24	30			5.00																		X			
WB	7.254	F	M3-4	24	12							1																	
		F	M1-5	24	12							1																	
		F	M3-4	24	12			2.00																		E-136B			
		F	M1-5	24	12			4.00																		E-136B			
WB	7.101	F	W1-2L	30	30		LEFT CURVE					1																	
SIGN SUMMARY SHEET							SHEET TOTALS	31.75	0.00	2	0	0	7	0	0	2	30	0	0.0	0.0	0.0	0.0	0.0	PROJECT NAME: WOODFORD-MARLBORO					
								SF	SF	EA	EA	EA	EA	EA	EA	EA	FT	EA	LB	LB	LB	LB	PROJECT NUMBER: STPG SIGN(35)						
VERMONT AGENCY OF TRANSPORTATION							TOWN DIRECTIONAL TOTALS	607.1	0.0	23.0	1.0	1.0	117	0.0	0.0	70	1050.0	0		0.0				FILE NAME: 10B336 PLOT DATE: 4/10/2012					
																							PROJECT MANAGER: A. GAMBLE DRAWN BY: J. KELLY						
																							DESIGNED BY: J. KELLY CHECKED BY: A. GAMBLE						
																							MARLBORO WB SHEET 3 SHEET 66 OF 80						


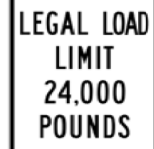




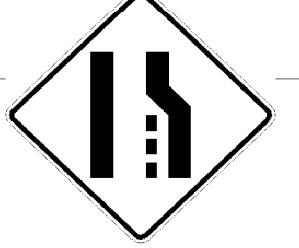

DIRECTION	MILEPOINT	LOCATION CODE (SHEET 2)	SIGN CODE	WIDTH (IN)	HEIGHT (IN)	SHEETING REMARKS	SIGN LEGEND	NEW SIGNS		EXISTING SIGNS				EXIST POST		NUMBER OF NEW POSTS	SQUARE STEEL (IN)			TUBULAR STEEL Ø (IN)				SIGN FRAME REQUIRED	REMARKS	SIGN DETAIL LOCATION			
								"A"	"B"	RETAIN	SALVAGE FROM	SALVAGE TO	REMOVE	RETAIN	REMOVE		1.75	2.00	2.50	FOUNDATION	3.0	3.50	4.00			5.00	SHSM	PROJECT SHEET #	STANDARD SHEET #
																(LB / FT)			(LB / FT)										
																1.88	2.42	3.35	7.6	9.00	10.80	14.60							
MARLBORO WB							FY-FLUORESCENT YELLOW FYG-FLUORESCENT YELLOW GREEN																"SHSM"-STANDARD HIGHWAY SIGNS AND MARKINGS						
			F	W13-1P	18	18	40 MPH ADVISORY									1													
WB	7.049		F	R2-1	24	30	SPEED LIMIT 50			1				X															
WB	7.003		F	W9-1R	36	36		9.00									2	X							INSTALL ON EASTERLY SIDE OF EXISTING CHEVRON.	X			
WB	7.002		E	W1-8R	18	24										1		X											
			E	W1-8R	24	30		5.00									1	X								X			
WB	6.977		F	W1-8L	18	24	CHEVRON									1		X							CURRENT CHEVRONS ARE ON AN ADJUSTABLE BRACKET.				
			E	W1-8R	18	24										1		X											
			E	W1-8R	24	30		5.00									1	X								X			
WB	6.954		F	W1-8L	18	24	CHEVRON									1		X							CURRENT CHEVRONS ARE ON AN ADJUSTABLE BRACKET.				
			E	W1-8R	18	24										1		X											
			E	W1-8R	24	30		5.00									1	X								X			
WB	6.941		F	W4-2R	36	36										1	X												
			F	W4-2R	36	36		9.00																		X			
WB	6.823		F	VR-186	24	30	TRUCK LANE ENDS									1		X											
WB	6.776		F	W1-10L	30	30	LEFT CURVE WITH SIDE ROAD RIGHT									1		X											
SIGN SUMMARY SHEET							SHEET TOTALS	33.00	0.00	1	0	0	9	0	0	5	75	0	0.0	0.0	0.0	0.0	0.0	PROJECT NAME: WOODFORD-MARLBORO					
								SF	SF	EA	EA	EA	EA	EA	EA	EA	FT	EA	LB	LB	LB	LB		PROJECT NUMBER: STPG SIGN(35)					
								607.1	0.0	23.0	1.0	1.0	117	0.0	0.0	70	1050.0	0		0.0				FILE NAME: 10B336					
VERMONT AGENCY OF TRANSPORTATION							TOWN DIRECTIONAL TOTALS	607.1	0.0	23.0	1.0	1.0	117	0.0	0.0	70	1050.0	0		0.0				PROJECT MANAGER: A. GAMBLE					
																							PLOT DATE: 4/10/2012						
																							DRAWN BY: J. KELLY						
																							DESIGNED BY: J. KELLY						
																							CHECKED BY: A. GAMBLE						
																							SHEET 67 OF 80						
																								MARLBORO WB SHEET 4					







DIRECTION	MILEPOINT	LOCATION CODE (SHEET 2)	SIGN CODE	WIDTH (IN)	HEIGHT (IN)	SHEETING REMARKS	SIGN LEGEND	NEW SIGNS		EXISTING SIGNS				EXIST POST		NUMBER OF NEW POSTS	SQUARE STEEL (IN)			TUBULAR STEEL Ø (IN)				SIGN FRAME REQUIRED	REMARKS	SIGN DETAIL LOCATION						
								"A"	"B"	RETAIN	SALVAGE FROM	SALVAGE TO	REMOVE	RETAIN	REMOVE		1.75	2.00	2.50	FOUNDATION	3.0	3.50	4.00			5.00	SHSM	PROJECT SHEET #	STANDARD SHEET #			
																	(LB / FT)				(LB / FT)											
MARLBORO WB							FY-FLUORESCENT YELLOW FYG-FLUORESCENT YELLOW GREEN																"SHSM"-STANDARD HIGHWAY SIGNS AND MARKINGS									
WB	6.727	F	VD-062B	72	16		WATCH FOR TURNING VEHICLES (MISSING)																									
		F	W1-10L	36	36			9.00																		X						
WB	6.661	G	VR-017	24	30																											
		G	VR-017	24	30			5.00																				TRIM BRUSH 7				
WB	6.654	H	R1-1	30	30																											
		H	R1-1	30	30			6.25																		X		TRIM BRUSH				
WB	6.619	F	VW-205	36	36			9.00																				INSTALL EAST OF SECOND UTILITY POLE WEST OF NORTH POND ROAD.				8
WB	6.549 6.558	F	S3-1	36	36	FYG		9.00																		X		INSTALL 50 FEET EAST OF EXISTING LEFT CURVE AND HIDDEN DRIVES SIGN ASSEMBLY.				INSTALL AT 6.549 ON EXISTING POSTS
WB	6.549	F	W1-2L	30	30		LEFT CURVE																									
		F	VW-133L	30	30		HIDDEN DRIVES LEFT																									
WB	6.525	F	S3-1	30	30		SCHOOL BUS STOP AHEAD																									
		F	W1-2L	30	30			6.25																								
		F	VW-133L	30	30			6.25																								
WB	6.438	F	D17-2	42	42			12.25																				INSTALL 200 FEET EAST OF 6.40 MILE MARKER.				6
WB	6.255	F	R4-6	24	30		TRUCK LANE 500 FEET																									
SIGN SUMMARY SHEET							SHEET TOTALS	63.00	0.00	1	0	0	0	0	0	10	150	0	0.0	0.0	0.0	0.0	0.0	PROJECT NAME: WOODFORD-MARLBORO PROJECT NUMBER: STPG SIGN(35)								
VERMONT AGENCY OF TRANSPORTATION							TOWN DIRECTIONAL TOTALS	607.1	0.0	23.0	1.0	1.0	117	0.0	0.0	70	1050.0	0				0.0		FILE NAME: 10B336 PLOT DATE: 4/10/2012 PROJECT MANAGER: A. GAMBLE DRAWN BY: J. KELLY DESIGNED BY: J. KELLY CHECKED BY: A. GAMBLE MARLBORO WB SHEET 5 SHEET 68 OF 80								


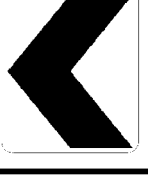


DIRECTION	MILEPOINT	LOCATION CODE (SHEET 2)	SIGN CODE	WIDTH (IN)	HEIGHT (IN)	SHEETING REMARKS	SIGN LEGEND	NEW SIGNS		EXISTING SIGNS				EXIST POST		NUMBER OF NEW POSTS	SQUARE STEEL (IN)			TUBULAR STEEL Ø (IN)				SIGN FRAME REQUIRED	REMARKS	SIGN DETAIL LOCATION			
								"A"	"B"	RETAIN	SALVAGE FROM	SALVAGE TO	REMOVE	RETAIN	REMOVE		1.75	2.00	2.50	FOUNDATION	3.0	3.50	4.00			5.00	SHSM	PROJECT SHEET #	STANDARD SHEET #
																	(LB / FT)				(LB / FT)								
MARLBORO WB							FY-FLUORESCENT YELLOW FYG-FLUORESCENT YELLOW GREEN																"SHSM"-STANDARD HIGHWAY SIGNS AND MARKINGS						
WB	6.201																									REMOVE AS PER JOE KELLY			
WB	6.161	F	R4-3	24	30																								
		F	R4-3	24	30			5.00																				X	
WB	6.124	F	VD-062B	72	16		BUSINESS SIGN			1																			
WB	5.991	G	VR-017	24	30																								
		G	VR-017	24	30			5.00																					7
WB	5.982	H	R1-1	30	30																								
		H	R1-1	30	30			6.25																				X	
WB	5.943	F	M3-4	24	12																								
		F	M1-5	24	24																								
		F	M3-4	24	12			2.00																					E-136B
		F	M1-5	24	24			4.00																					E-136B
WB	5.915	F	R4-3	24	30																								
		F	R4-3	24	30			5.00																				X	
WB	5.835	F	W9-1R	36	36			9.00																					
WB	5.797	F	S1-1	36	36		SCHOOL PENTAGON			1																			
SIGN SUMMARY SHEET							SHEET TOTALS	36.25	0.00	2	0	0	6	0	0	2	30	0	0.0	0.0	0.0	0.0	0.0	PROJECT NAME: WOODFORD-MARLBORO					
								SF	SF	EA	EA	EA	EA	EA	EA	EA	FT	EA	LB	LB	LB	LB	PROJECT NUMBER: STPG SIGN(35)						
							TOWN DIRECTIONAL TOTALS	607.1	0.0	23.0	1.0	1.0	117	0.0	0.0	70	1050.0	0			0.0				FILE NAME: 10B336 PLOT DATE: 4/10/2012				
																								PROJECT MANAGER: A. GAMBLE DRAWN BY: J. KELLY					
																								DESIGNED BY: J. KELLY CHECKED BY: A. GAMBLE					
																								MARLBORO WB SHEET 6 SHEET 69 OF 80					



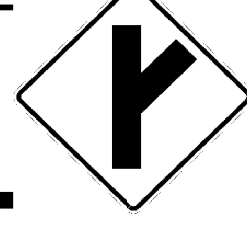
DIRECTION	MILEPOINT	LOCATION CODE (SHEET 2)	SIGN CODE	WIDTH (IN)	HEIGHT (IN)	SHEETING REMARKS	SIGN LEGEND	NEW SIGNS		EXISTING SIGNS				EXIST POST		NUMBER OF NEW POSTS	SQUARE STEEL (IN)			TUBULAR STEEL Ø (IN)				SIGN FRAME REQUIRED	REMARKS	SIGN DETAIL LOCATION			
								"A"	"B"	RETAIN	SALVAGE FROM	SALVAGE TO	REMOVE	RETAIN	REMOVE		1.75	2.00	2.50	FOUNDATION	3.0	3.50	4.00			5.00	SHSM	PROJECT SHEET #	STANDARD SHEET #
																	(LB / FT)				(LB / FT)								
MARLBORO WB							FY-FLUORESCENT YELLOW FYG-FLUORESCENT YELLOW GREEN																"SHSM"-STANDARD HIGHWAY SIGNS AND MARKINGS						
		F	W16-9	30	18		AHEAD						1																
		F	S4-3P	36	12	FYG		3.00																	INSTALL BELOW SCHOOL SYMBOL SIGN.	X			
WB	5.760	F	W4-2R	36	36							1	X							RETAIN POST							X		
		F	W4-2R	36	36			9.00																				X	
WB	5.708	F	D1-1E	72	20							1	X							RETAIN POST									
		F	VD1-1	72	20			10.00																				7	
WB	5.617	F	VR-186	24	30		TRUCK LANE ENDS					1		X															
WB	5.599	F	VD-062B	72	16		BUSINESS SIGN			1			X																
WB	5.496	F	W1-10R	30	30							1		X															
		F	W13-1	24	24		35 MPH ADVISORY					1																	
		F	W1-10R	36	36	FY		9.00							2		X										X		
		F	W16-8P	24	8	FY		1.33																				8	
WB	5.438	F	D1-1A	72	10							1	X	*						RETAIN POST									
		F	VD1-1A	72	12			6.00							2		*											6	
WB	5.364	F	M3-4	24	12							1	X																
SIGN SUMMARY SHEET							SHEET TOTALS	38.33	0.00	1	0	0	8	0	0	4	60	0	0.0	0.0	0.0	0.0	0.0	PROJECT NAME: WOODFORD-MARLBORO					
								SF	SF	EA	EA	EA	EA	EA	EA	EA	EA	EA	EA	EA	EA	EA	EA	PROJECT NUMBER: STPG SIGN(35)					
																								FILE NAME: 10B336					
VERMONT AGENCY OF TRANSPORTATION							TOWN DIRECTIONAL TOTALS	607.1	0.0	23.0	1.0	1.0	117	0.0	0.0	70	1050.0	0			0.0			PLOT DATE: 4/10/2012					
																							DRAWN BY: J. KELLY						
																							DESIGNED BY: J. KELLY						
																							CHECKED BY: A. GAMBLE						
																							MARLBORO WB SHEET 7						
																							SHEET 70 OF 80						

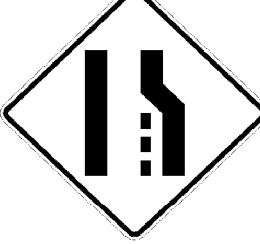DIRECTION	MILEPOINT	LOCATION CODE (SHEET 2)	SIGN CODE	WIDTH (IN)	HEIGHT (IN)	SHEETING REMARKS	SIGN LEGEND	NEW SIGNS		EXISTING SIGNS				EXIST POST		NUMBER OF NEW POSTS	SQUARE STEEL (IN)			TUBULAR STEEL Ø (IN)				SIGN FRAME REQUIRED	REMARKS	SIGN DETAIL LOCATION			
								"A"	"B"	RETAIN	SALVAGE FROM	SALVAGE TO	REMOVE	RETAIN	REMOVE		1.75	2.00	2.50	FOUNDATION	3.0	3.50	4.00			5.00	SHSM	PROJECT SHEET #	STANDARD SHEET #
																	(LB / FT)				(LB / FT)								
MARLBORO WB							FY-FLUORESCENT YELLOW FYG-FLUORESCENT YELLOW GREEN															"SHSM"-STANDARD HIGHWAY SIGNS AND MARKINGS							
WB	4.335	F	R4-3	24	30																								
		F	R4-3	24	30			5.00																X					
WB	4.288	F	VW-133R	30	30		HIDDEN DRIVES RIGHT																						
WB	4.212	F	W9-1R	36	36			9.00															INSTALL 200 FEET EAST OF LANE MERGE SYMBOL SIGN.	X					
WB	4.174	F	W4-2R	36	36			9.00																					
		F	W4-2R	36	36																			X					
WB	4.130	F	VR-020	24	30		NO PARKING ON TRAVEL LANE SIGN MISSING - REMOVE POST																		SIGN MISSING - REMOVE POST				
WB	4.073	F	VR-020	24	30		NO PARKING ON TRAVEL LANE																						
WB	4.052	F	VR-186	24	30		TRUCK LANE ENDS																						
WB	3.858	F	VD-062B	72	16		BUSINESS SIGN			1																			
		F	VD-062AS	72	16		BUSINESS SIGN			1																			
WB	3.795	F	D1-1A	72	10																								
		F	D1-1A	72	10																								
		F	VD1-1A	72	12			6.00																	6				
		F	VD1-1A	72	12			6.00																	6				
SIGN SUMMARY SHEET							SHEET TOTALS	35.00	0.00	2	0	0	8	0	0	2	30	0	0.0	0.0	0.0	0.0	0.0	PROJECT NAME: WOODFORD-MARLBORO PROJECT NUMBER: STPG SIGN(35)					
								SF	SF	EA	EA	EA	EA	EA	EA	EA	FT	EA	LB	LB	LB	LB	FILE NAME: 10B336 PLOT DATE: 4/10/2012 PROJECT MANAGER: A. GAMBLE DRAWN BY: J. KELLY DESIGNED BY: J. KELLY CHECKED BY: A. GAMBLE MARLBORO WB SHEET 9 SHEET 72 OF 80						
VERMONT AGENCY OF TRANSPORTATION							TOWN DIRECTIONAL TOTALS	607.1	0.0	23.0	1.0	1.0	117	0.0	0.0	70	1050.0	0			0.0								

DIRECTION	MILEPOINT	LOCATION CODE (SHEET 2)	SIGN CODE	WIDTH (IN)	HEIGHT (IN)	SHEETING REMARKS	SIGN LEGEND	NEW SIGNS		EXISTING SIGNS				EXIST POST		NUMBER OF NEW POSTS	SQUARE STEEL (IN)			TUBULAR STEEL Ø (IN)				SIGN FRAME REQUIRED	REMARKS	SIGN DETAIL LOCATION			
								"A"	"B"	RETAIN	SALVAGE FROM	SALVAGE TO	REMOVE	RETAIN	REMOVE		1.75	2.00	2.50	FOUNDATION	3.0	3.50	4.00			5.00	SHSM	PROJECT SHEET #	STANDARD SHEET #
																	(LB / FT)				(LB / FT)								
MARLBORO WB							FY-FLUORESCENT YELLOW FYG-FLUORESCENT YELLOW GREEN															"SHSM"-STANDARD HIGHWAY SIGNS AND MARKINGS							
WB	3.757	A	D17-2	42	42			12.25										X						INSTALL 200 FEET WEST OF DESTINATION SIGN ASSEMBLY.		6			
WB	3.720	G	VR-017	24	30							1	X											AUGER HOLE RD (TH-1)					
		G	VR-017	24	30			5.00																		7			
WB	3.711	H	R1-1	30	30							1	X											AUGER HOLE RD (TH-1)					
		H	R1-1	30	30			6.25																			X		
WB	3.698	F	M3-4	24	12							1	X																
		F	M1-5	24	24							1																	
		F	M3-4	24	12			2.00																				E-136B	
		F	M1-5	24	24			4.00																				E-136B	
WB	3.634	F	R4-6	24	30		TRUCK LANE 500 FEET					1	X																
WB	3.590	F	R2-1	24	30							1	X																
		F	R2-1	24	30			5.00																			X		
WB	3.533	F	R4-3	24	30							1	X																
		F	R4-3	24	30			5.00																			X		
WB	3.426	F	D1-1M	72	20							1	X																
SIGN SUMMARY SHEET							TOTALS	39.50	0.00	0	0	0	8	0	0	2	30	0	0.0	0.0	0.0	0.0	0.0	PROJECT NAME: WOODFORD-MARLBORO					
								SF	SF	EA	EA	EA	EA	EA	EA	EA	FT	EA	LB	LB	LB	LB	PROJECT NUMBER: STPG SIGN(35)						
																							FILE NAME: 10B336						
VERMONT AGENCY OF TRANSPORTATION							TOWN DIRECTIONAL TOTALS	607.1	0.0	23.0	1.0	1.0	117	0.0	0.0	70	1050.0	0			0.0			PLOT DATE: 4/10/2012					
																							DRAWN BY: J. KELLY						
																							DESIGNED BY: J. KELLY						
																							CHECKED BY: A. GAMBLE						
																							MARLBORO WB SHEET 10						
																							SHEET 73 OF 80						

DIRECTION	MILEPOINT	LOCATION CODE (SHEET 2)	SIGN CODE	WIDTH (IN)	HEIGHT (IN)	SHEETING REMARKS	SIGN LEGEND	NEW SIGNS		EXISTING SIGNS				EXIST POST		NUMBER OF NEW POSTS	SQUARE STEEL (IN)			TUBULAR STEEL Ø (IN)				SIGN FRAME REQUIRED	REMARKS	SIGN DETAIL LOCATION			
								"A"	"B"	RETAIN	SALVAGE FROM	SALVAGE TO	REMOVE	RETAIN	REMOVE		1.75	2.00	2.50	FOUNDATION	3.0	3.50	4.00			5.00	SHSM	PROJECT SHEET #	STANDARD SHEET #
																	(LB / FT)				(LB / FT)								
MARLBORO WB							FY-FLUORESCENT YELLOW FYG-FLUORESCENT YELLOW GREEN															"SHSM"-STANDARD HIGHWAY SIGNS AND MARKINGS							
		F	VD1-1	72	20			10.00							2		X									6			
WB	3.337	F	R4-3	24	30		SLOWER TRAFFIC KEEP RIGHT						1			X													
WB	3.324	F	W9-1R	36	36			9.00							2		X							INSTALL 300 FEET WEST ^{EAST} OF EXISTING MERGE SYMBOL SIGN.	X		INSTALL EAST		
WB	3.267	F	W4-2R	36	36								1			X								RETAIN POST					
		F	W4-2R	36	36			9.00																	X				
WB	3.141	F	VR-186	24	30		TRUCK LANE ENDS						1			X													
WB	2.905	F	VW-054R	30	30		HIDDEN DRIVES RIGHT						1			X													
WB	2.840	F	W2-1R	30	30		RIGHT CURVE						1			X													
		F	VW-054R	30	30			6.25							1		X									TRIM BRUSH	8		
WB	2.774	F	VR-023B	24	30		\$500 FINE FOR THROWING TRASH						1			X													
WB	2.714	F	W1-2R	30	30								1			X													
		F	W13-1P	18	18								1																
		F	W1-2R	30	30			6.25							1		X								X		PUT OLD SIGNS ON NEW POST. CHANGED ON 9-7-12		
		F	W13-1P	18	18			2.25																		X			
WB	2.618	F	M3-4	24	12		WEST						1			X													
SIGN SUMMARY SHEET							SHEET TOTALS	42.75	0.00	0	0	0	9	0	0	6		90	0	0.0	0.0	0.0	0.0	PROJECT NAME: WOODFORD-MARLBORO PROJECT NUMBER: STPG SIGN(35)					
VERMONT AGENCY OF TRANSPORTATION							TOWN DIRECTIONAL TOTALS	607.1	0.0	23.0	1.0	1.0	117	0.0	0.0	70		1050.0	0			0.0		FILE NAME: 10B336 PROJECT MANAGER: A. GAMBLE DESIGNED BY: J. KELLY MARLBORO WB SHEET 11					
																							PLOT DATE: 4/10/2012 DRAWN BY: J. KELLY CHECKED BY: A. GAMBLE SHEET 74 OF 80						

DIRECTION	MILEPOINT	LOCATION CODE (SHEET 2)	SIGN CODE	WIDTH (IN)	HEIGHT (IN)	SHEETING REMARKS	SIGN LEGEND	NEW SIGNS		EXISTING SIGNS				EXIST POST		NUMBER OF NEW POSTS	SQUARE STEEL (IN)			TUBULAR STEEL Ø (IN)				SIGN FRAME REQUIRED	REMARKS	SIGN DETAIL LOCATION								
								"A"	"B"	RETAIN	SALVAGE FROM	SALVAGE TO	REMOVE	RETAIN	REMOVE		1.75	2.00	2.50	FOUNDATION	3.0	3.50	4.00			5.00	SHSM	PROJECT SHEET #	STANDARD SHEET #					
																	(LB / FT)				(LB / FT)													
MARLBORO WB							FY-FLUORESCENT YELLOW FYG-FLUORESCENT YELLOW GREEN															"SHSM"-STANDARD HIGHWAY SIGNS AND MARKINGS												
WB	1.860	E	W1-8R	24	30		CHEVRON			1				X																				
WB	1.846	F	R4-3	36	48																													
		F	R4-3	24	30			5.00								1		X									X							
WB	1.844	E	W1-8R	24	30		CHEVRON			1				X																				
WB	1.823	F	W1-8L	24	30		CHEVRON			1				X																				
WB	1.823	E	W1-8R	24	30		CHEVRON			1				X																				
WB	1.799	F	W1-8L	24	30		CHEVRON			1				X																				
WB	1.799	E	W1-8R	24	30		CHEVRON			1				X																				
WB	1.776	F	W1-8L	24	30																													
		F	W1-8L	24	30	FY		5.00																				X						
WB	1.776	E	W1-8R	24	30		CHEVRON			1				X																				
WB	1.752	F	W1-8L	24	30																													
		F	W1-8L	24	30	FY		5.00																				X						
WB	1.752	E	W1-8R	24	30																													
		E	W1-8R	24	30	FY		-5.00																										
SIGN SUMMARY SHEET							SHEET TOTALS	15.00 20.00	0.00	8 7	0	1 0	3 4	0	0	1	15	0	0.0	0.0	0.0	0.0	0.0	PROJECT NAME: WOODFORD-MARLBORO										
								SF	SF	EA	EA	EA	EA	EA	EA	EA	FT	EA	LB	LB	LB	LB	PROJECT NUMBER: STPG SIGN(35)											
VERMONT AGENCY OF TRANSPORTATION							TOWN DIRECTIONAL TOTALS	607.1	0.0	23.0	1.0	1.0	117	0.0	0.0	70	1050.0	0			0.0				FILE NAME: 10B336									
																								PLOT DATE: 4/10/2012										
																								DRAWN BY: J. KELLY										
																								DESIGNED BY: J. KELLY										
																								CHECKED BY: A. GAMBLE										
																								MARLBORO WB SHEET 13										
																								SHEET 76 OF 80										

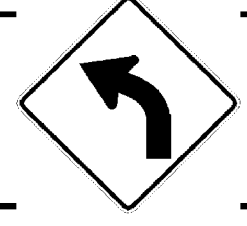DIRECTION	MILEPOINT	LOCATION CODE (SHEET 2)	SIGN CODE	WIDTH (IN)	HEIGHT (IN)	SHEETING REMARKS	SIGN LEGEND	NEW SIGNS		EXISTING SIGNS				EXIST POST		NUMBER OF NEW POSTS	SQUARE STEEL (IN)			TUBULAR STEEL Ø (IN)				SIGN FRAME REQUIRED	REMARKS	SIGN DETAIL LOCATION							
								"A"	"B"	RETAIN	SALVAGE FROM	SALVAGE TO	REMOVE	RETAIN	REMOVE		1.75	2.00	2.50	FOUNDATION	3.0	3.50	4.00			5.00	SHSM	PROJECT SHEET #	STANDARD SHEET #				
																	(LB / FT)				(LB / FT)												
MARLBORO WB							FY-FLUORESCENT YELLOW FYG-FLUORESCENT YELLOW GREEN															"SHSM"-STANDARD HIGHWAY SIGNS AND MARKINGS											
WB	0.589	F		30	30		CENTERLINE RUMBLE STRIPS			X					X																		
		F		24	12		END			X																							
WB	0.477	F	VR-020	24	30		NO PARKING ON TRAVELED LANES						1		X																		
WB	0.424	F	VR-020	24	30		NO PARKING ON TRAVELED LANES						1		X																		
WB	0.356	F	VR-020	24	30		NO PARKING ON TRAVELED LANES						1		X																		
WB	0.211	F	VD-062AS	72	16		BUSINESS SIGN			1					X																		
		F	VD-062BRN	72	16		BUSINESS SIGN			1																							
WB	0.178	F	W1-2L	30	30			6.25								1		X												INSTALL 175 FEET WEST OF EXISTING BUSINESS SIGNS.	X		
WB	0.093	G	VR-017	24	30		LEGAL LOAD 24,000 LBS						1		X														OLD HOGBACK RD (TH-33)				
WB	0.093	H	R1-1	30	30		STOP 						1		X														OLD HOGBACK RD (TH-33)			REMOVE MILE MARKER AS PER JOE KELLY	
WB	0.070	F	W2-3R	30	30			6.25								1		X											INSTALL BETWEEN OLD HOGBACK RD AND GRAVEL DRIVE TO WEST.	X			
SIGN SUMMARY SHEET							SHEET TOTALS	12.50	0.00	2	0	0	0	0	0	2	30	0	0.0	0.0	0.0	0.0	0.0	PROJECT NAME: WOODFORD-MARLBORO PROJECT NUMBER: STPG SIGN(35)									
VERMONT AGENCY OF TRANSPORTATION							TOWN DIRECTIONAL TOTALS	607.1	0.0	23.0	1.0	1.0	117	0.0	0.0	70	1050.0	0			0.0			FILE NAME: 10B336 PROJECT MANAGER: A. GAMBLE DESIGNED BY: J. KELLY MARLBORO WB SHEET 16	PLOT DATE: 4/10/2012 DRAWN BY: J. KELLY CHECKED BY: A. GAMBLE SHEET 79 OF 80								

