

GPS CONTROL POINTS

HVCTRL #1

"D 14 RESET "
 N = 138636.34
 E = 1587856.07
 ELEV. = 1360.39

HVCTRL #8




" TURNER "
 N = 137154.88
 E = 1590676.52
 ELEV. = 1271.37

TO REACH FROM THE EAST END OF THE VT ROUTE 9 BRIDGE OVER I-91 IN BRATTLEBORO GO WEST ALONG VT ROUTE 9 FOR 6.8 MI (10.9 KM) TO THE INTERSECTION OF ASPEN DRIVE OR WOLF ROAD RIGHT AND MCARTHUR ROAD LEFT. TURN RIGHT AND GO NORTH ALONG ASPEN DRIVE FOR 0.15 MI (0.24 KM) TO MR ESAUS 2 STORY WOOD FRAME HOUSE AND SITE OF MARK ON LEFT. THE MARK IS SET IN THE TOP OF A 4.8 M (15.7 FT) X 1.0 M (3.3 FT) ROCK OUTCROP WHICH PROJECTS 0.5 M (1.6 FT) ABOVE GROUND SURFACE IN A FLOWER BED. IT IS 26.8 M (87.9 FT) WEST OF AND ABOUT 2 M (6.6 FT) HIGHER THAN THE CENTERLINE OF ASPEN DRIVE, 7.1 M (23.3 FT) WEST OF THE CENTERLINE OF GRAVEL DRIVE TO THE HOUSE, 26.3 M (86.3 FT) SOUTH OF THE SOUTHEAST CORNER OF THE HOUSE, AND 4.4 M (14.4 FT) NORTHEAST OF THE NORTHEAST CORNER OF A GARAGE.

TO REACH FROM WEST END OF THE VT. ROUTE 9 BRIDEGS OVER I-91 GO WEST ALONG VT. ROUTE 9 FOR 6.4 MI (10.3 KM) TO THE INTERSECTION OF HAMILTON ROAD RIGHT. CONTINUE WEST TO FIND A SAFE TURN AROUND AND RETURN TO THE INTERSECTION OF HAMILTON ROAD LEFT. TURN LEFT AND GO NORTH ALONG HAMILTON ROAD FOR 0.05 MI (0.08 KM) TO THE MARK ON THE LEFT IN A LAWN. THE MARK IS SET IN THE TOP OF A 0.4 M (1.3 FT.) X 0.4 M (1.3 FT) ROCK OUTCROP WHICH IS FLUSH WITH THE GROUND SURFACE. IT IS 6.6 M (21.7 FT) WEST OF AND ABOUT 1.0 M (3.3 FT) HIGHER THAN THE CENTERLINE OF HAMILTON ROAD, 16.0 M (52.5 FT) SOUTHEAST OF A 35 CM MAPLE, 29.6 M (97.1 FT) NORTH OF THE END OF A STONEWALL, 39.0 M (128.0 FT) NORTHEAST OF THE NORTHEAST CORNER OF AN ATTACHED GARAGE, 11.0 M (36.1 FT) WEST OF A FIBERGLASS WITNESS POST.

• Description provided by Vermont Agency of Transportation Geodetic Unit

TRAVERSE TIES

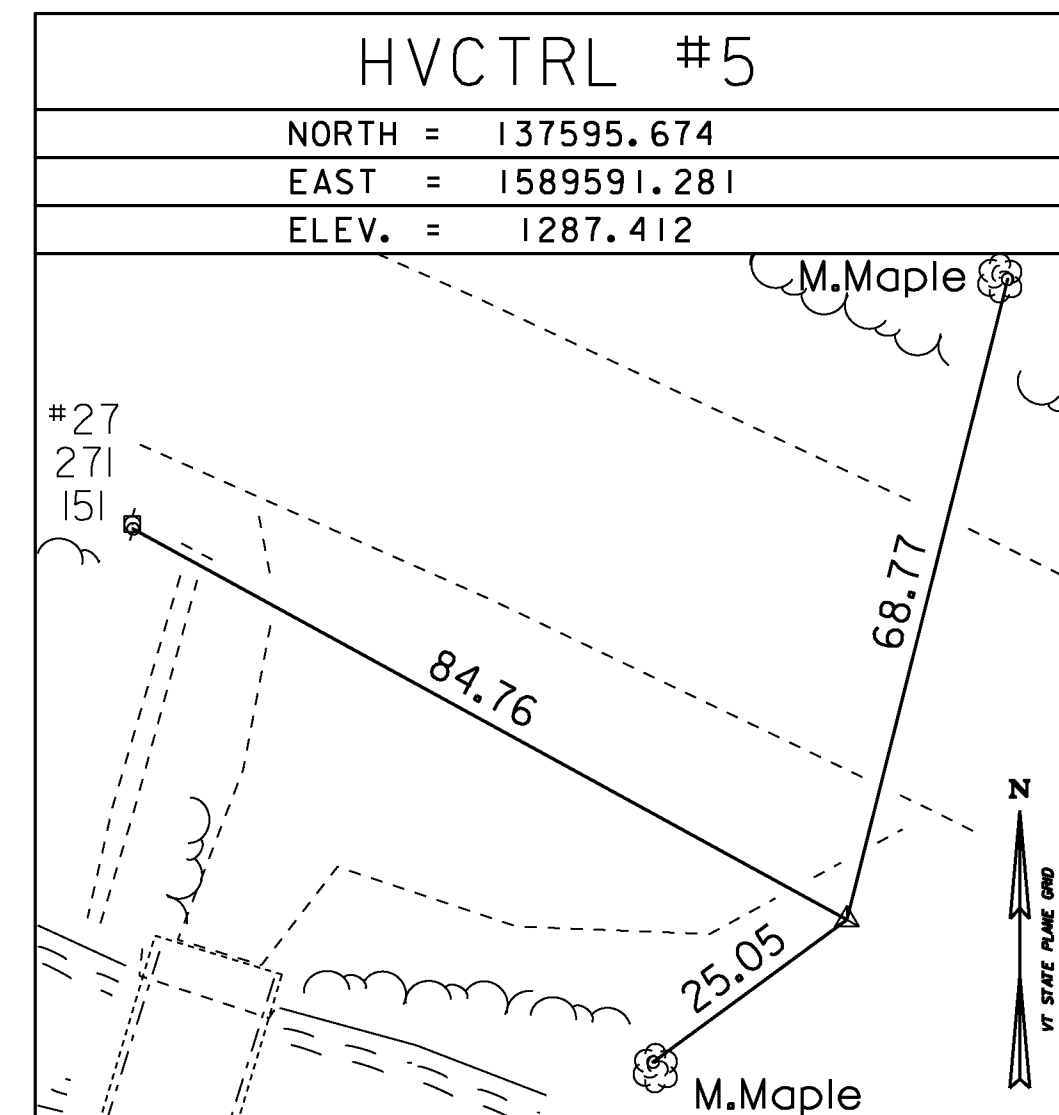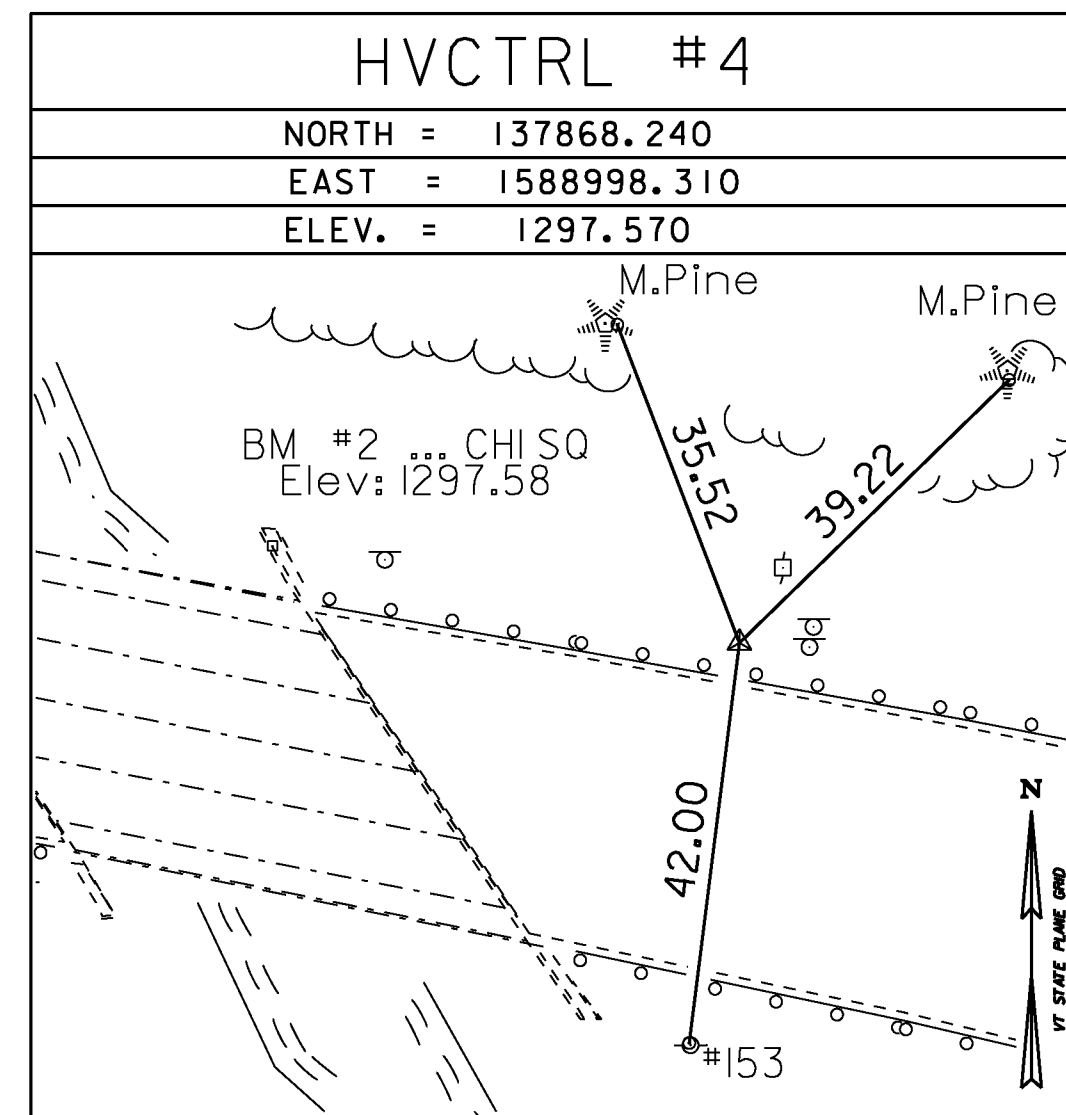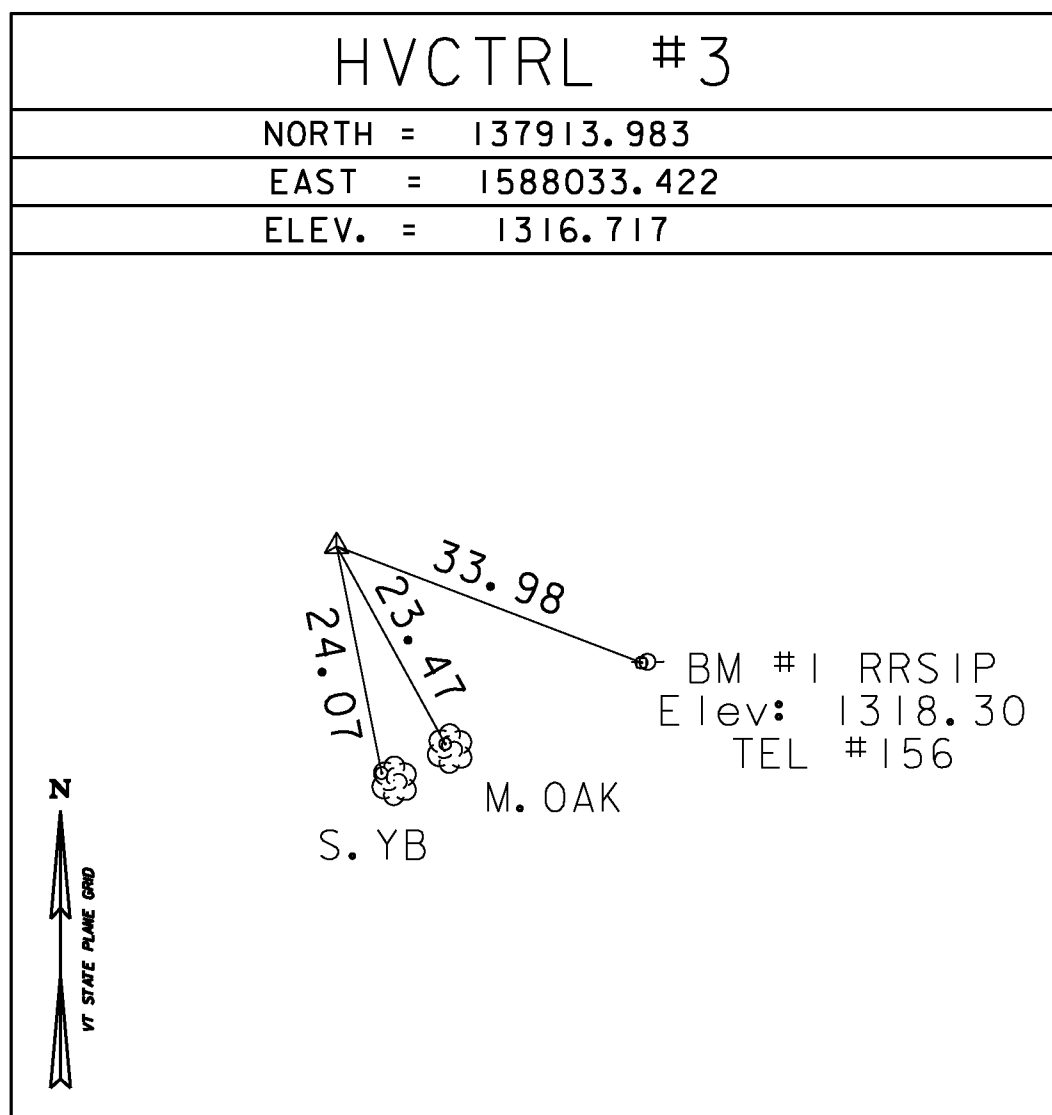

• Main Traverse Completed 10/27/98 by R. Gilman P.C. & T. Companion & G. Hitchcock [83b100]

ALIGNMENT TIES

DATUM	
VERTICAL	NAVD 88
HORIZONTAL	NAD 83 (96)
ADJUSTMENT	Compass

PROJECT NAME:	MARLBORO
PROJECT NUMBER:	BRF 010-1(43)
FILE NAME:	survey\10b4141.dgn
PROJECT LEADER:	K. HIGGINS
DESIGNED BY:	R. KLINEFELTER
TIE SHEET	
PLOT DATE:	28-AUG-2013
DRAWN BY:	R. BULLOCK
CHECKED BY:	G. LAROCHE
SHEET	9 OF 50