


EXISTING BRIDGE DATA
 SINGLE SPAN ROLLED BEAM, CONCRETE DECK
 CONCRETE ABUTMENTS
 OVERALL LENGTH = 54'
 OVERALL WIDTH = 31.3'

EXISTING CONDITIONS

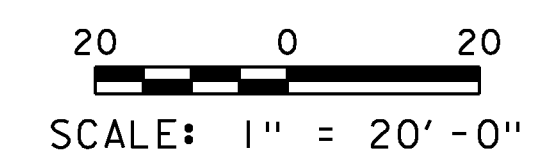

PROJECT NAME:	MARLBORO	PROJECT NUMBER:	BRF 010-1(43)
FILE NAME:	si0b414existing_conditions.dgn	PLOT DATE:	28-AUG-2013
PROJECT LEADER:	K. HIGGINS	DRAWN BY:	K. FRIEDLAND
DESIGNED BY:	R. KLINEFELTER	CHECKED BY:	J. SALVATORI
EXISTING CONDITIONS		SHEET	10 OF 50