


PROPOSED UTILITY LAYOUT

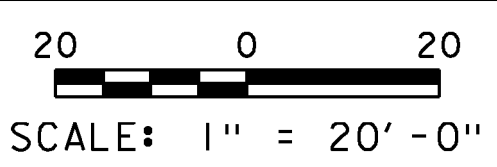

PROJECT NAME: MARLBORO	
PROJECT NUMBER: BRF 010-1(43)	
FILE NAME: sl0b414bdr.dgn	PLOT DATE: 28-AUG-2013
PROJECT LEADER: K. HIGGINS	DRAWN BY: K. FRIEDLAND
DESIGNED BY: R. KLINEFELTER	CHECKED BY: G. LAROCHE
PROPOSED UTILITY LAYOUT	SHEET 17 OF 50

EXISTING BRIDGE DATA
 SINGLE SPAN ROLLED BEAM, CONCRETE DECK
 CONCRETE ABUTMENTS
 OVERALL LENGTH = 54'
 OVERALL WIDTH = 31.3'