



INSET "A" 
NOT TO SCALE

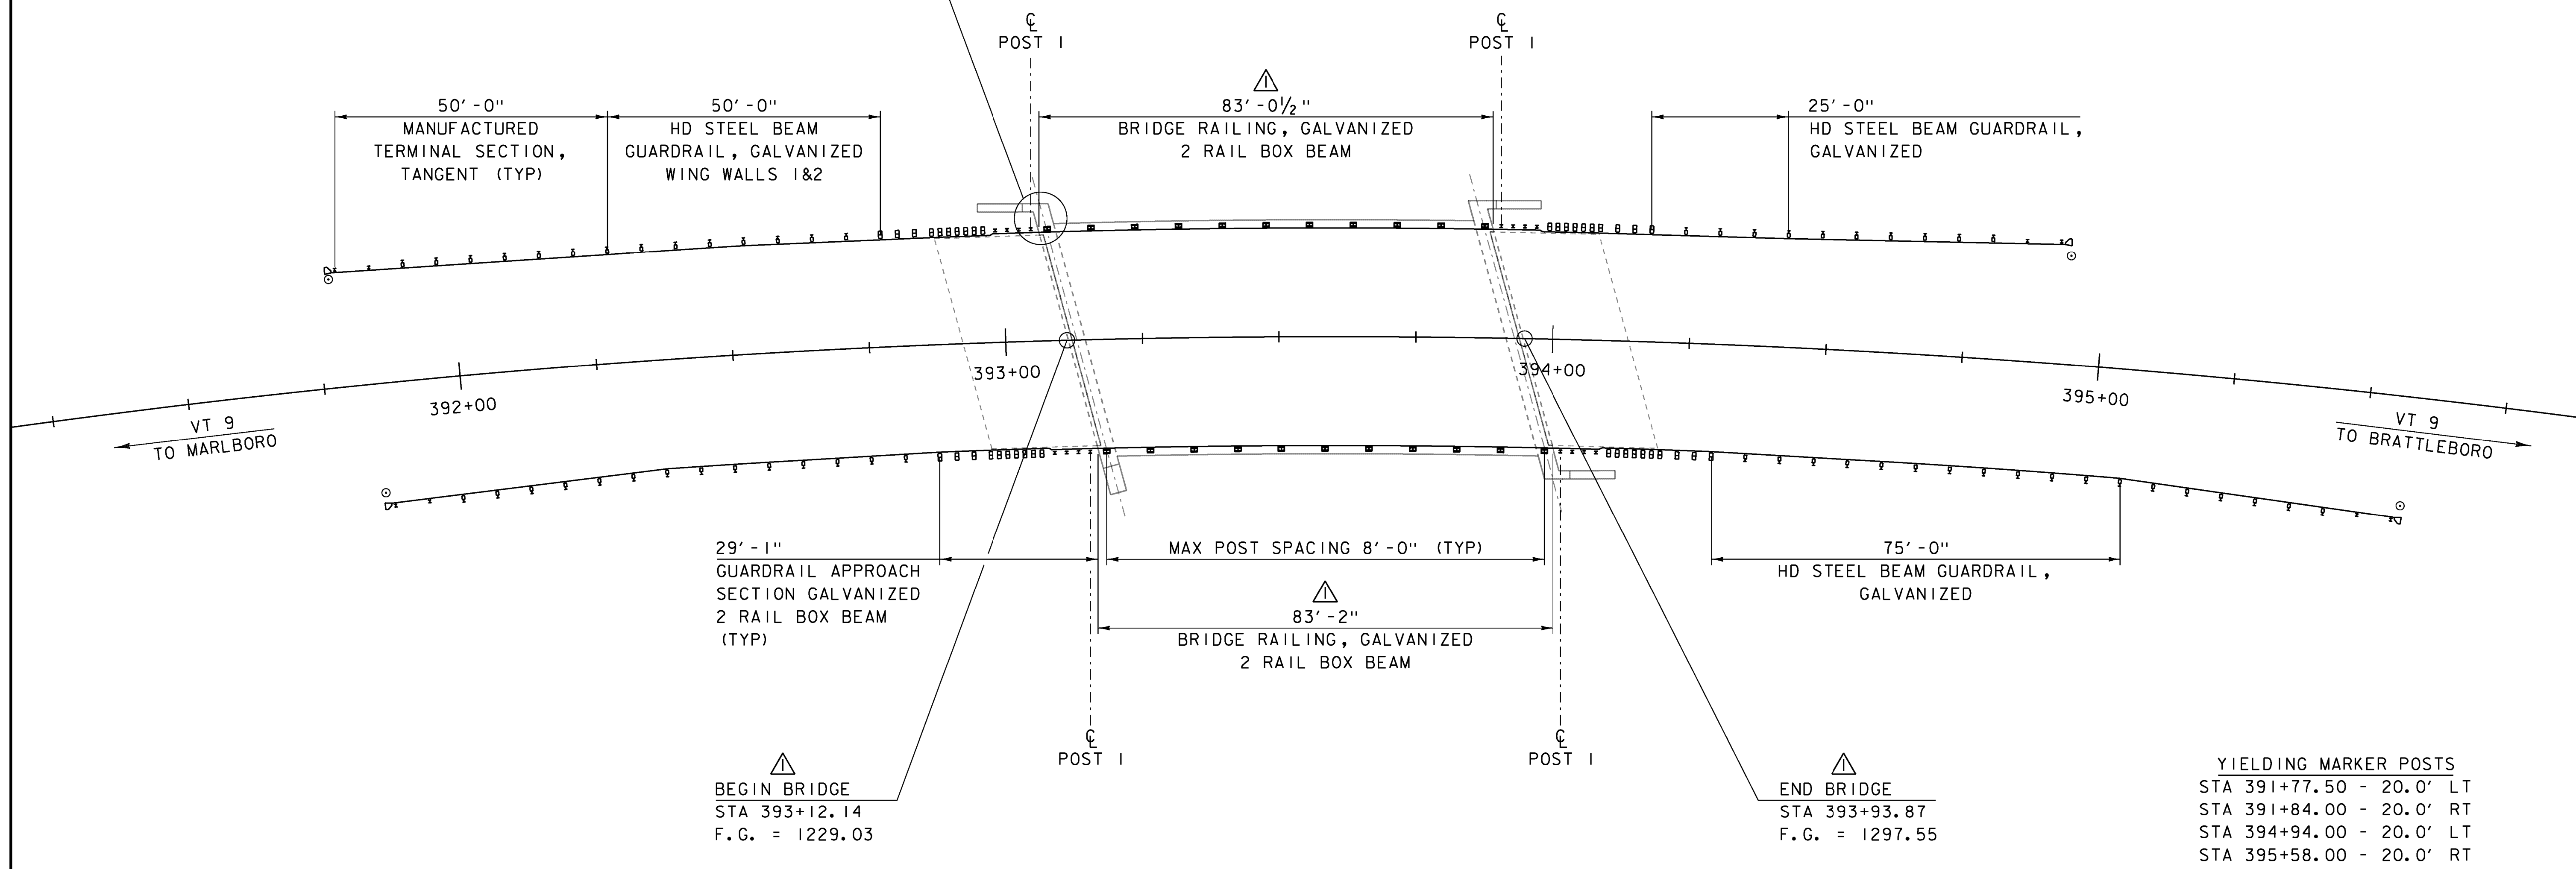

NOTES:

- 1. SEE STANDARDS S-360A, S-360B, S-363, G-1 AND G-19.

RAIL LAYOUT SHEET
SCALE: 1" = 15'-0"

 -REVISED 4/25/2014.
REPLACES SHEET 20 IN CONTRACT PLANS.

PROJECT NAME: MARLBORO	
PROJECT NUMBER: BRF 010-1(43)	
FILE NAME: sl0b414rail.dgn	PLOT DATE: 25-APR-2014
PROJECT LEADER: K. HIGGINS	DRAWN BY: K. FRIEDLAND
DESIGNED BY: R. KLINEFELTER	CHECKED BY: J. SALVATORI
RAIL LAYOUT SHEET	SHEET 20 OF 50