



26C WESTBURY  
FINE SANDY LOAMS  
WITH 8% TO 15% SLOPES  
"K FACTOR" = .37  
VERY STONEY

46D BERKSHIRE AND MONADNOCK  
FINE SANDY LOAMS  
WITH 15%-25% SLOPES  
"K FACTOR" = .24 -.28  
VERY STONEY

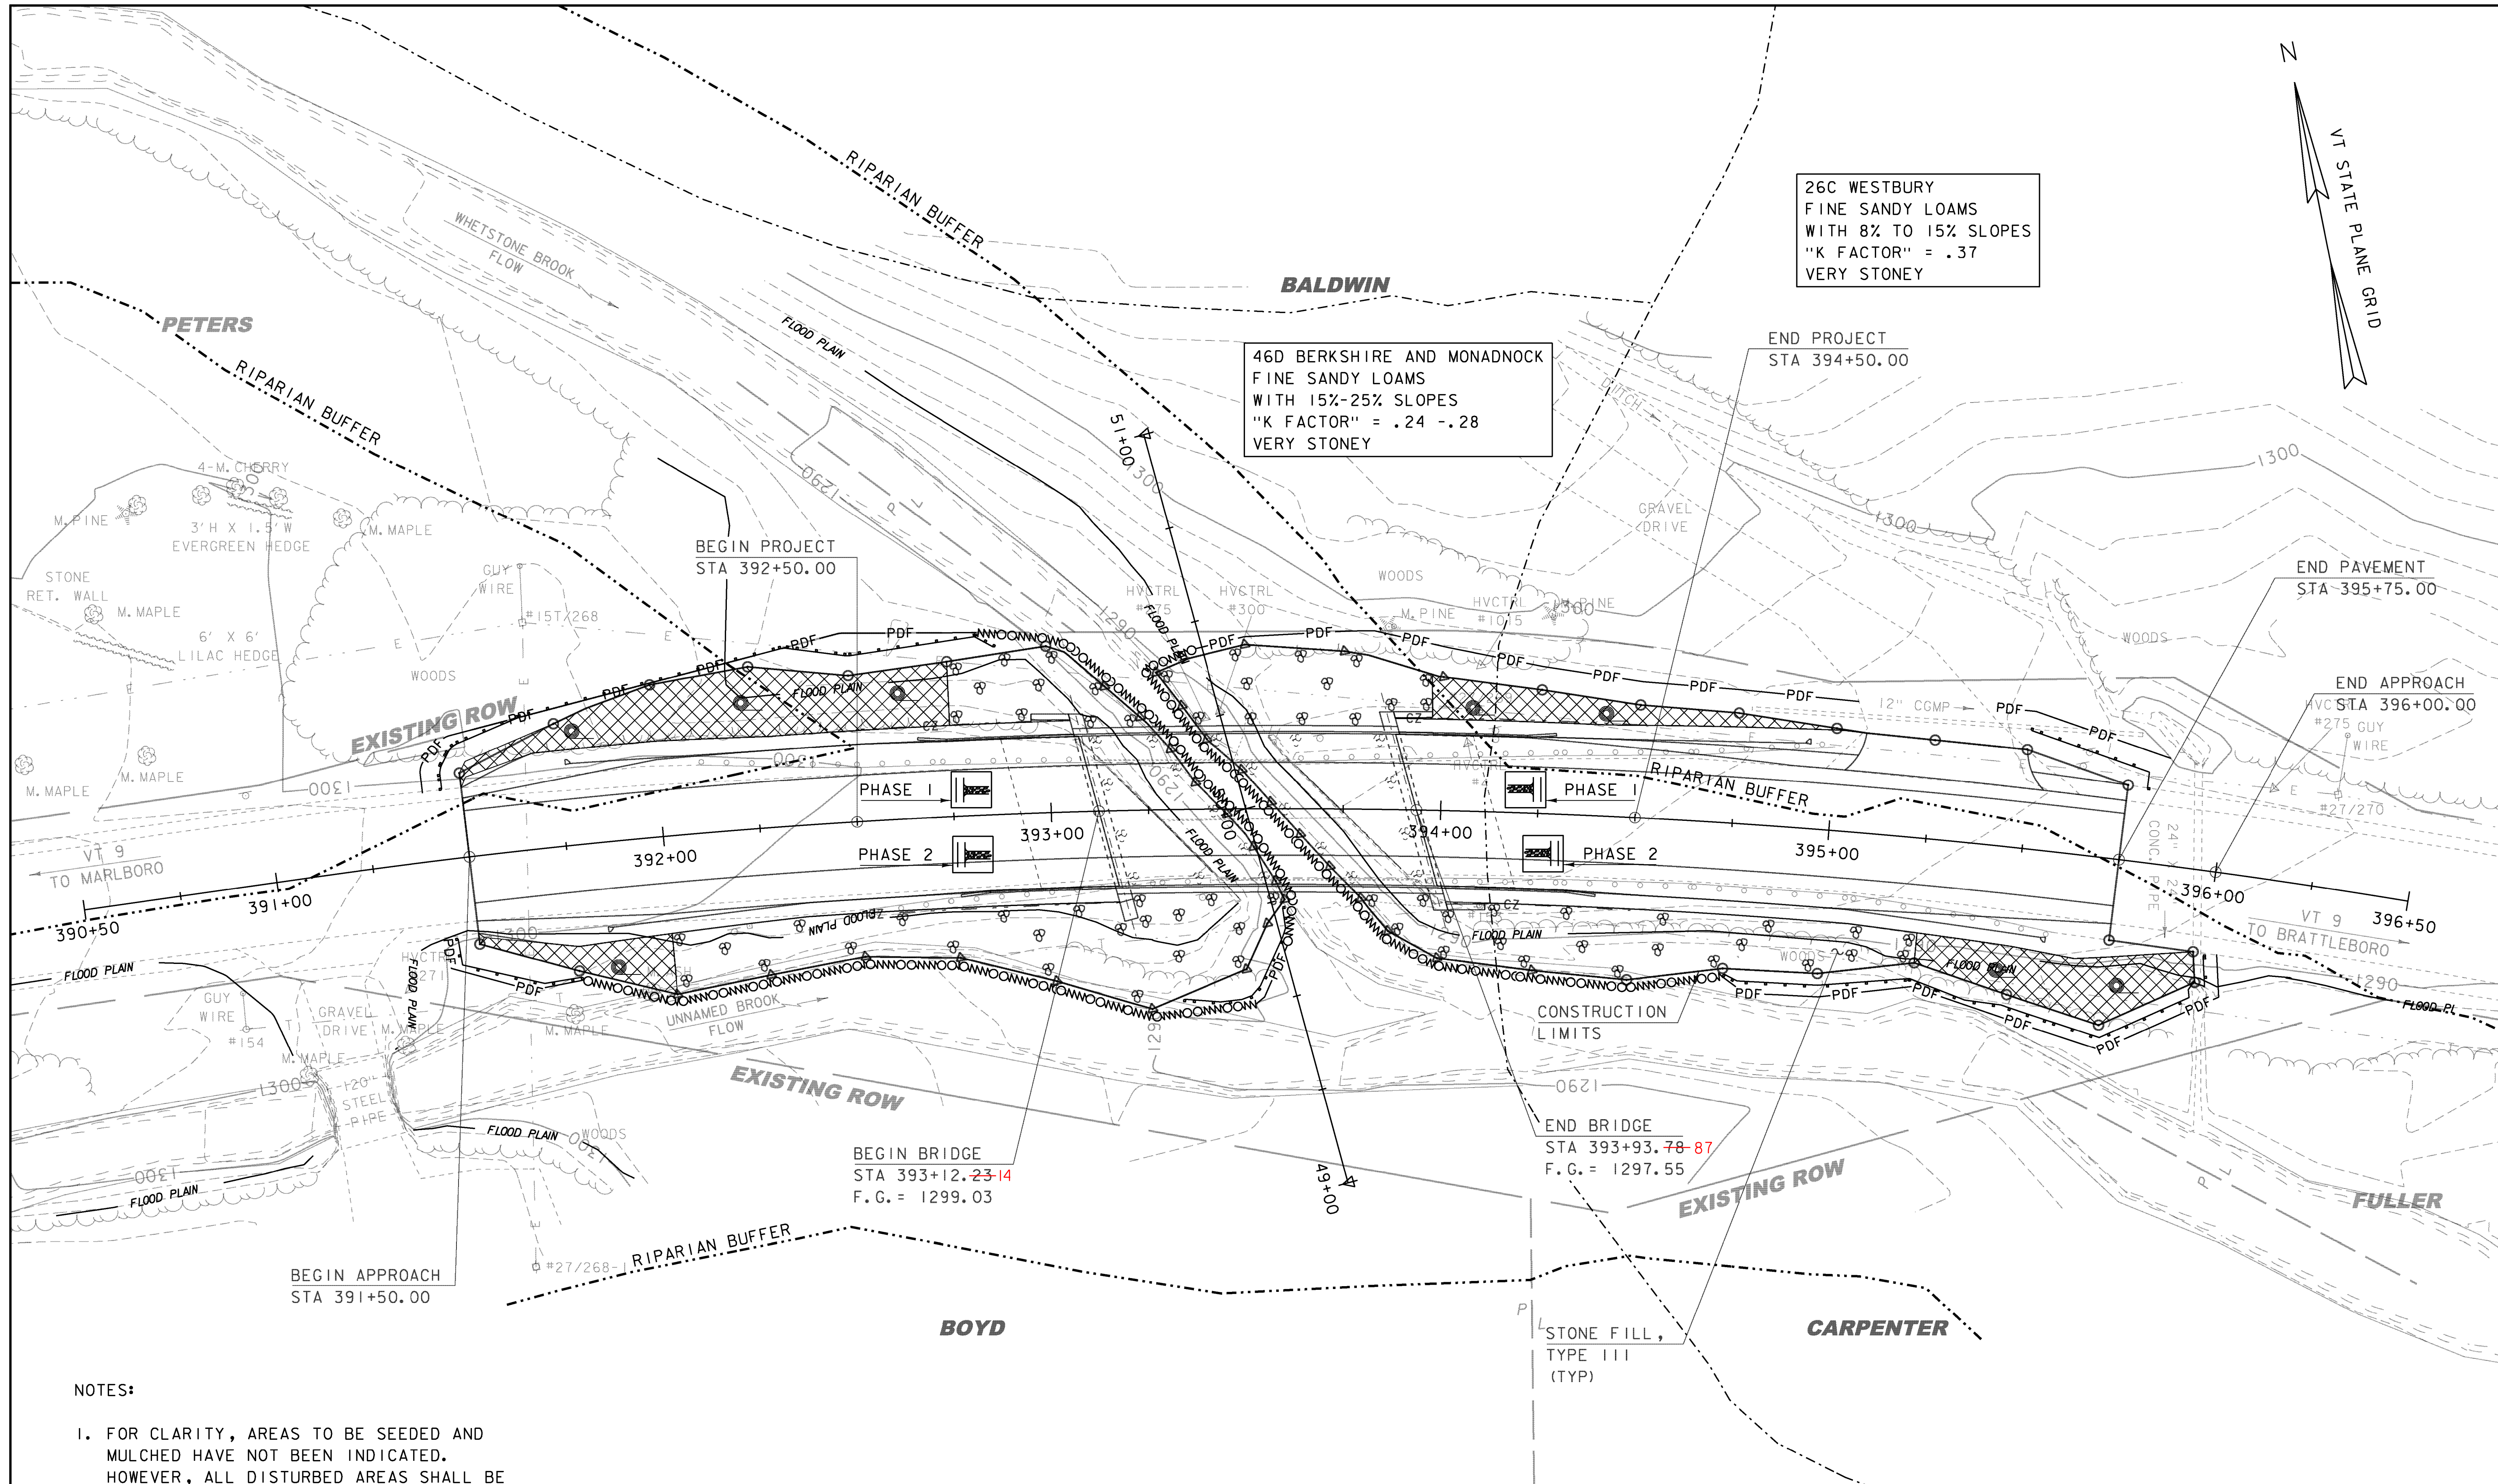

- NOTES:
- FOR CLARITY, AREAS TO BE SEEDED AND MULCHED HAVE NOT BEEN INDICATED. HOWEVER, ALL DISTURBED AREAS SHALL BE SEEDED AND MULCHED AS APPLICABLE.
  - EXISTING CONTOURS SHOWN. SEE CROSS SECTIONS FOR FINAL CONDITIONS.

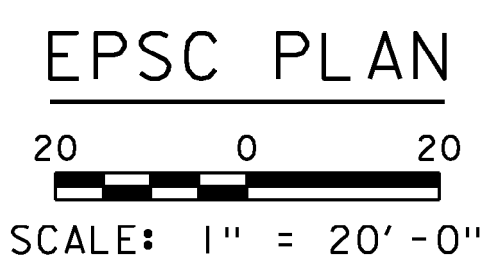

PROJECT NAME:	MARLBORO	FILE NAME:	sl0b414ero_bdr.dgn	PLOT DATE:	28-AUG-2013
PROJECT NUMBER:	BRF 010-1(43)	PROJECT LEADER:	K. HIGGINS	DRAWN BY:	K. FRIEDLAND
		DESIGNED BY:	R. KLINEFELTER	CHECKED BY:	G. LAROCHE
		EPSC PLAN			SHEET 37 OF 50