




391+50
BEGIN APPROACH

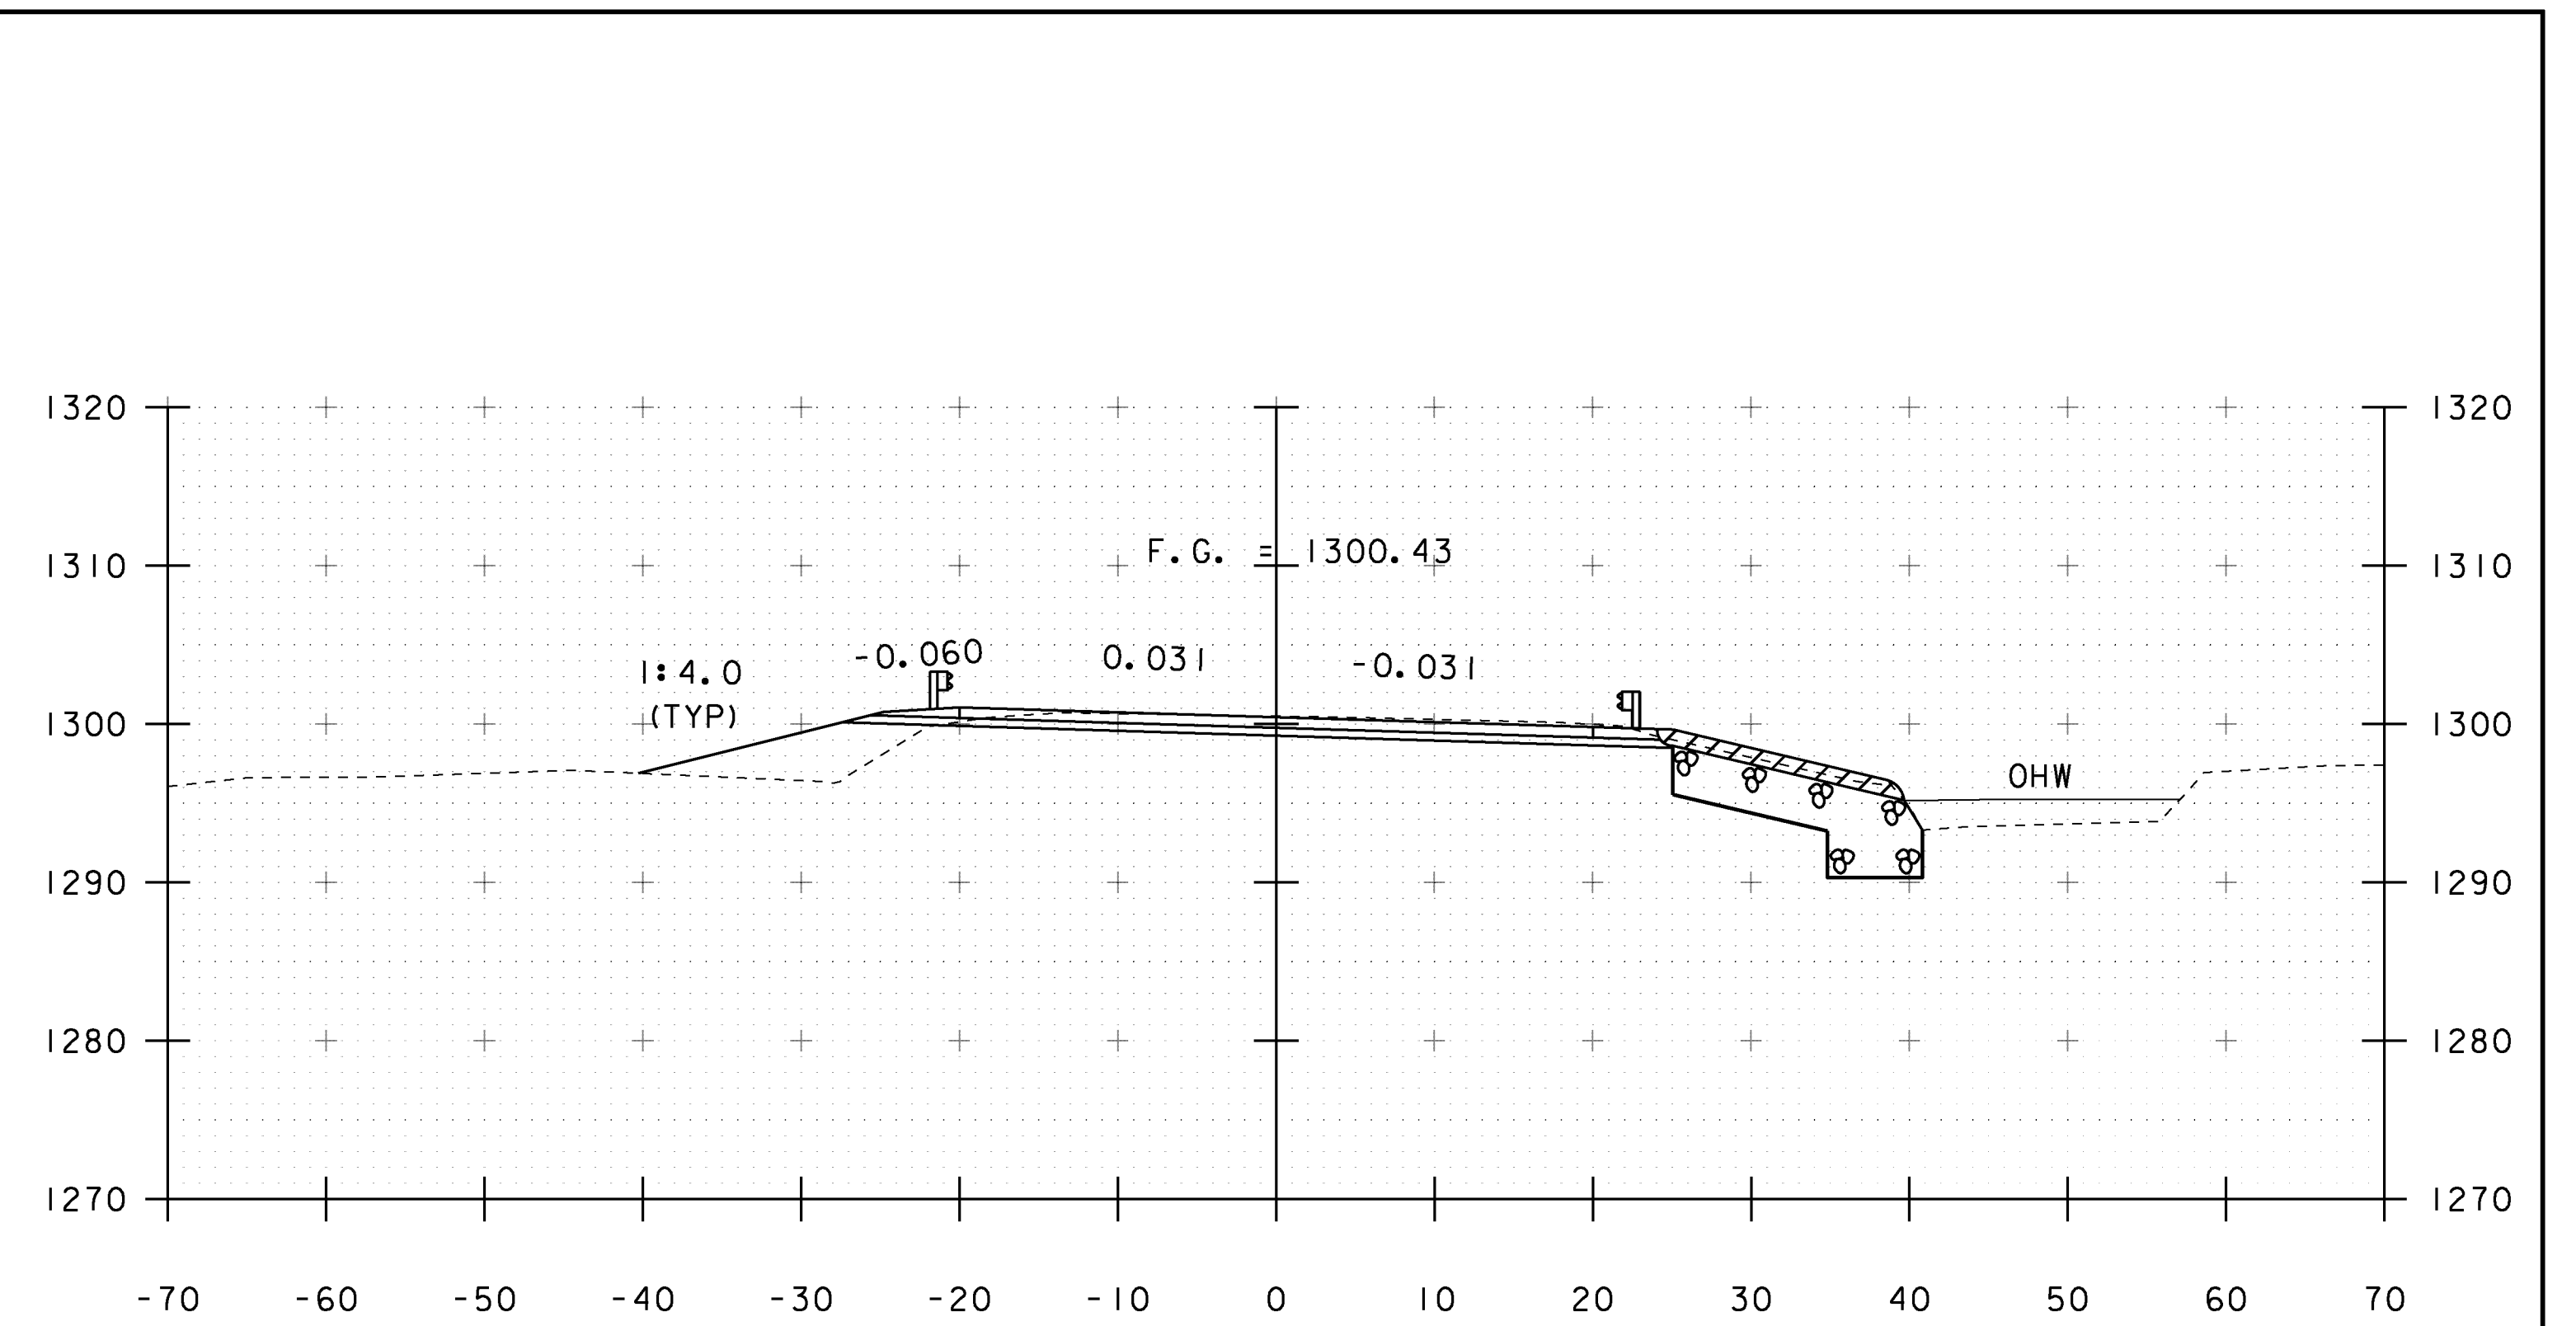

392+00

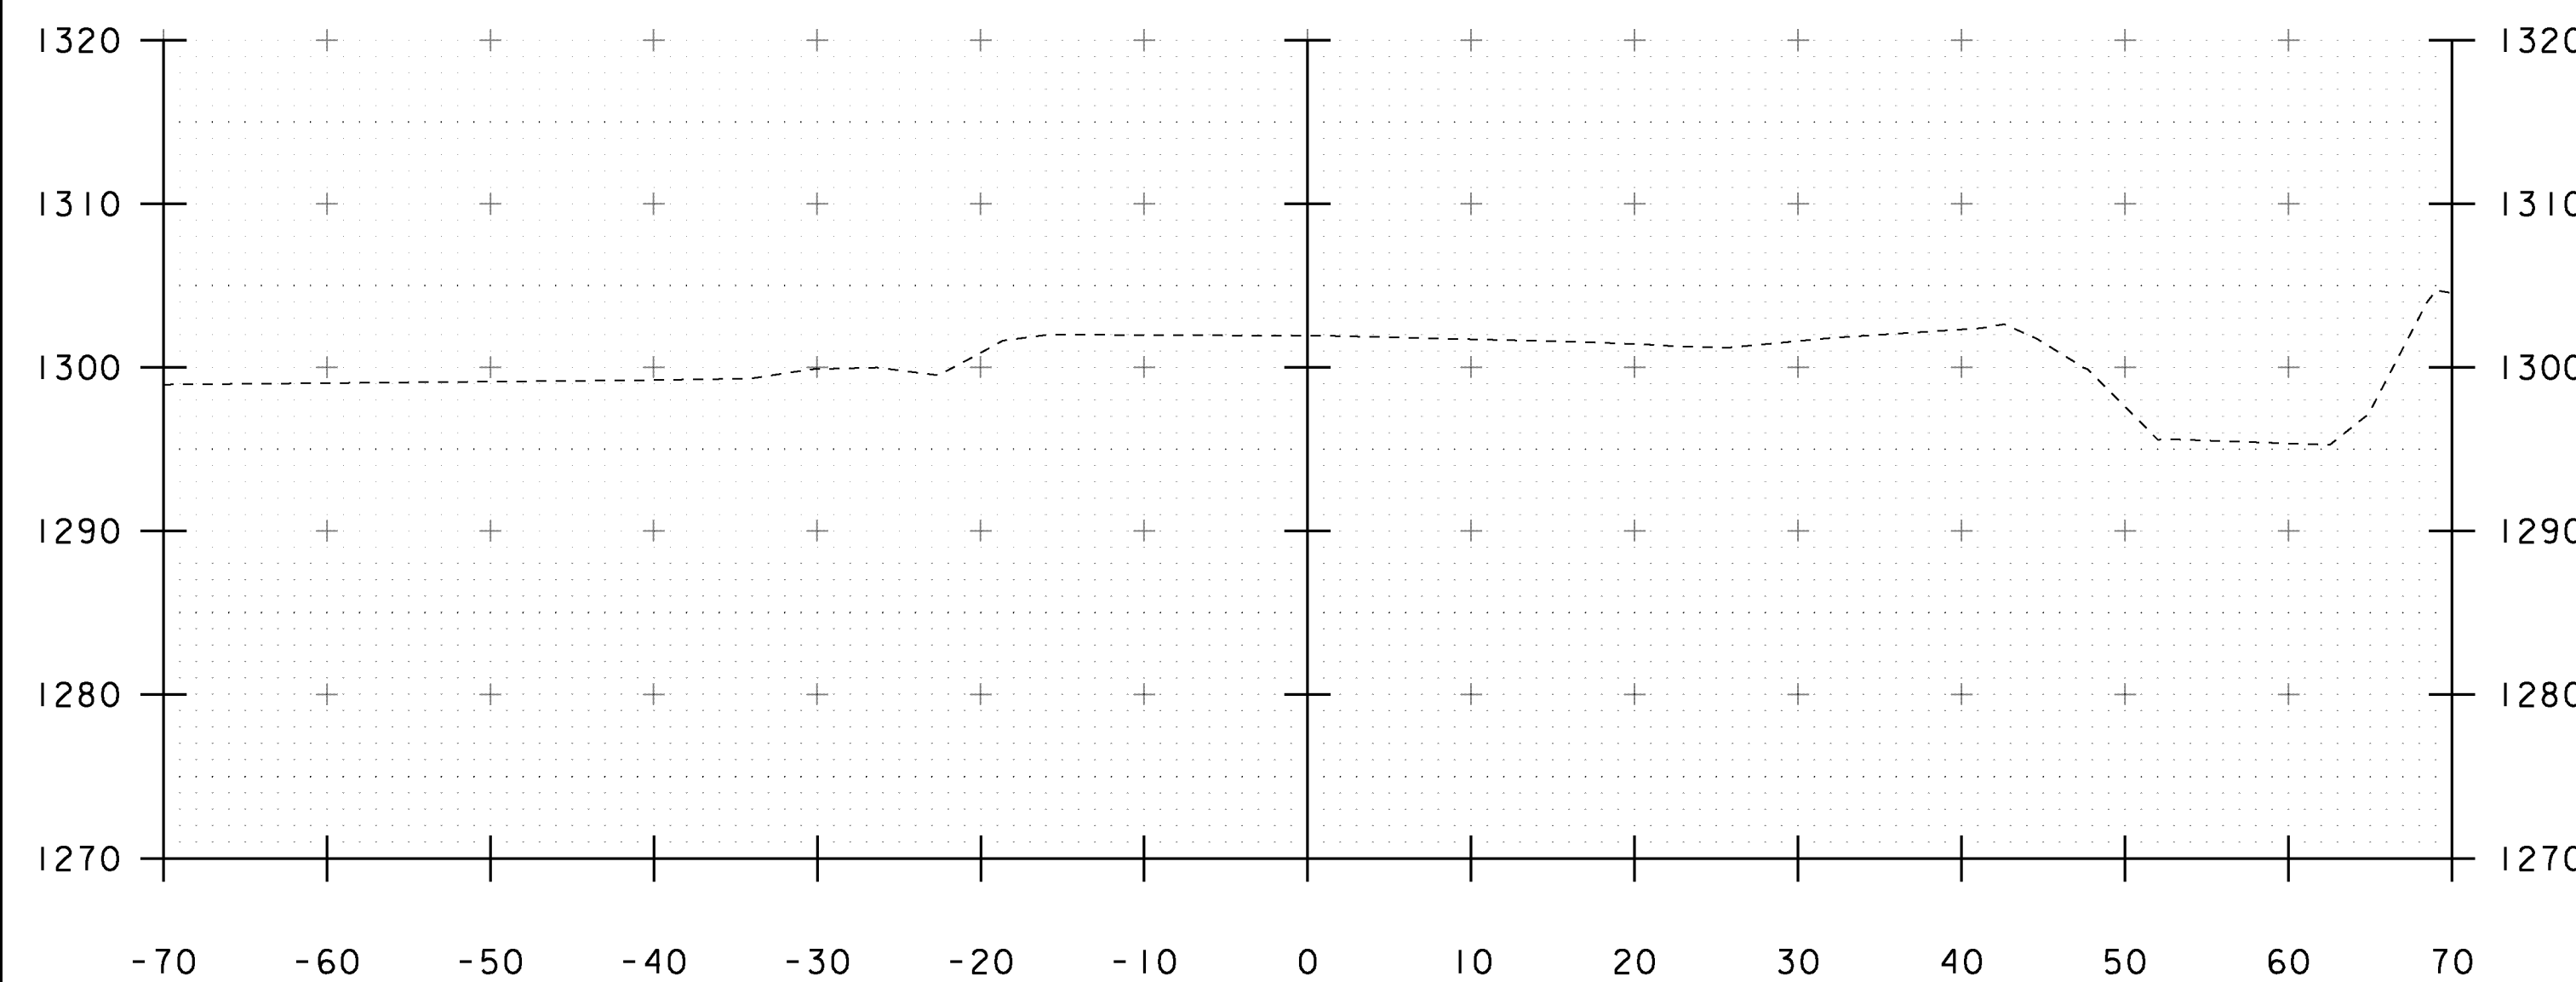

391+25

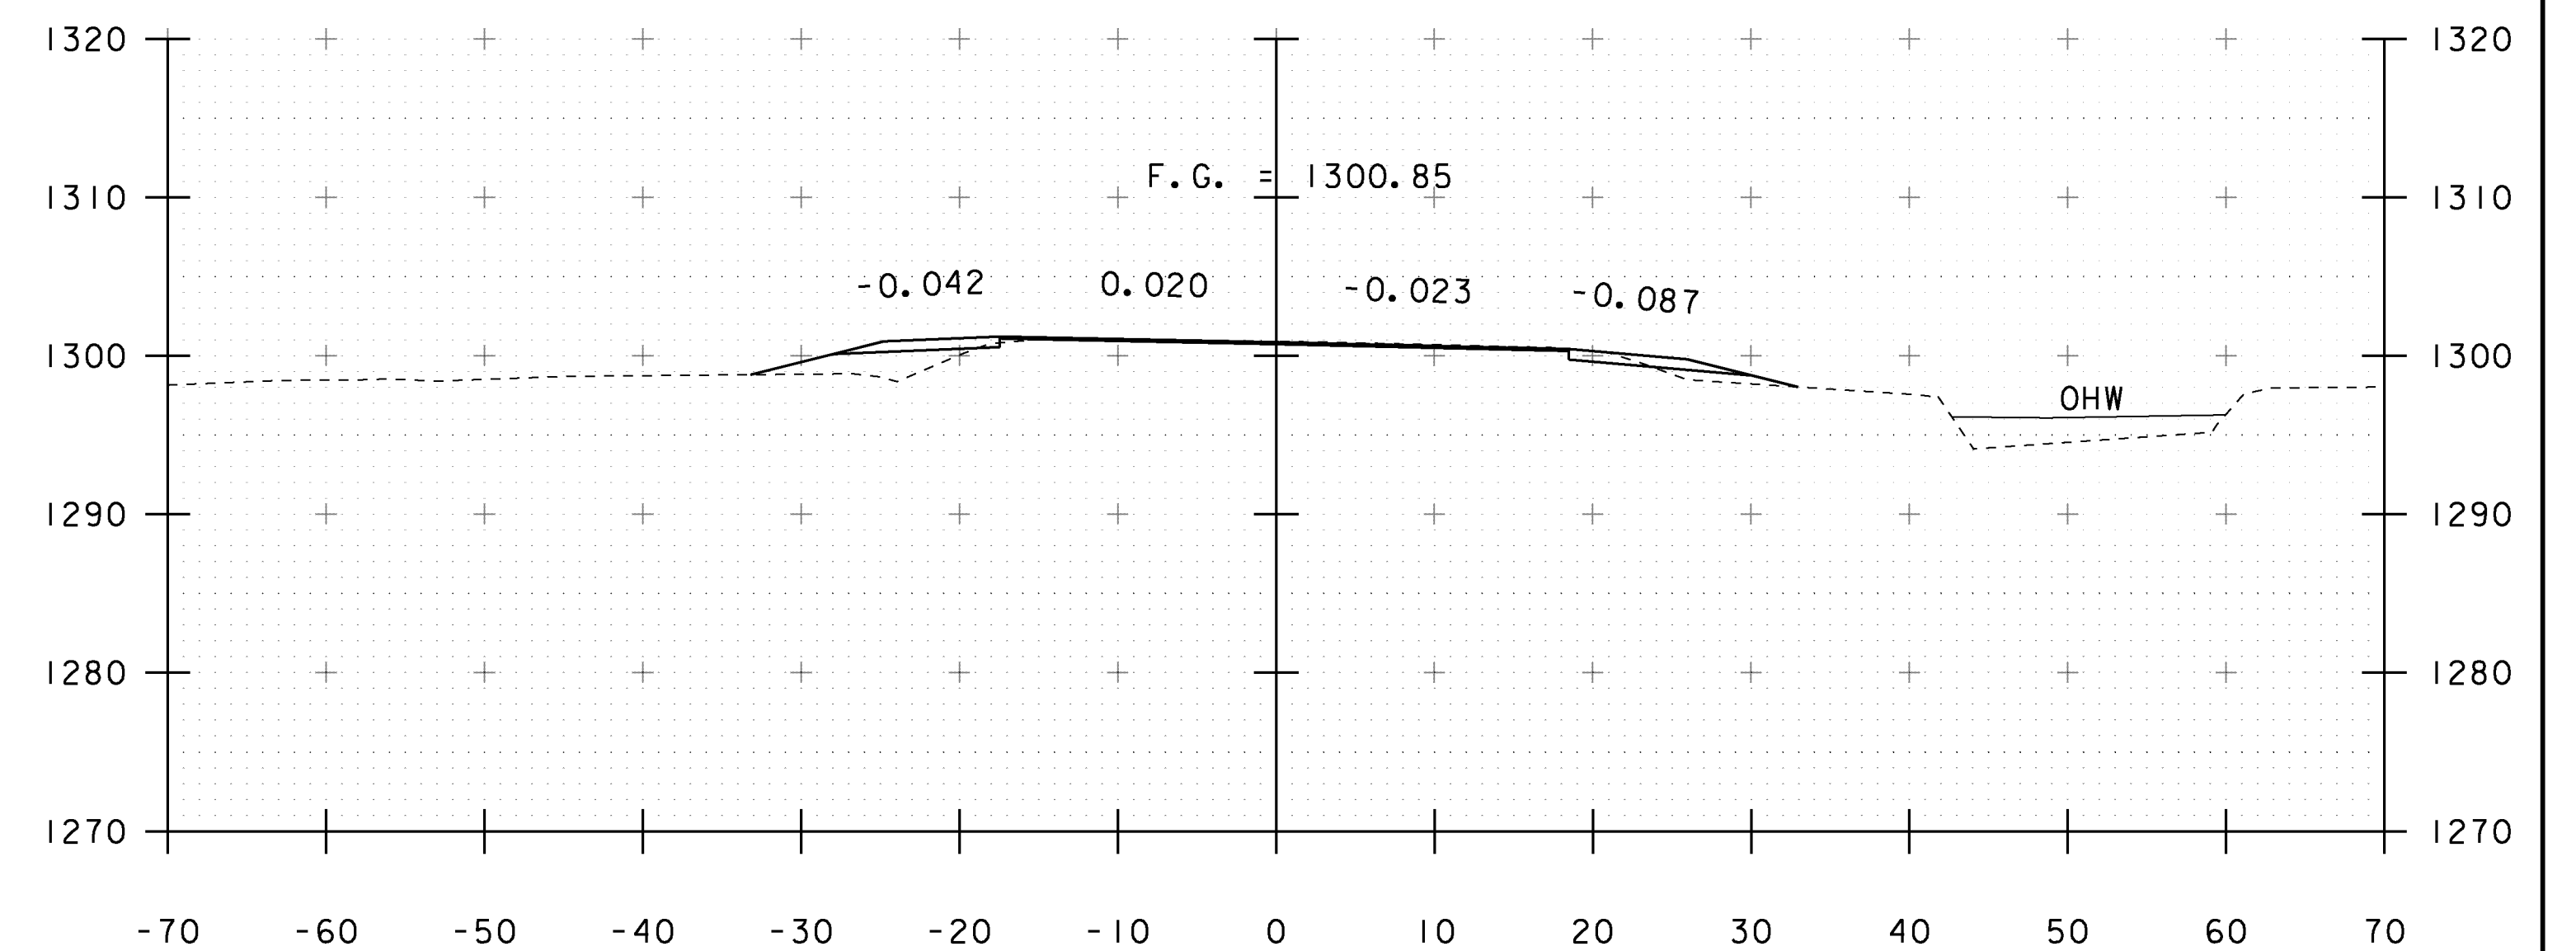

391+75

STA. 391+25 TO STA. 392+00

PROJECT NAME: MARLBORO	PLOT DATE: 28-AUG-2013
PROJECT NUMBER: BRF 010-1(43)	DRAWN BY: K. FRIEDLAND
FILE NAME: si0b414xsl.dgn	CHECKED BY: G. LAROCHE
PROJECT LEADER: K. HIGGINS	SHEET 41 OF 50
DESIGNED BY: R. KLINEFELTER	
MAINLINE SECTIONS 1	