




392+50
BEGIN PROJECT

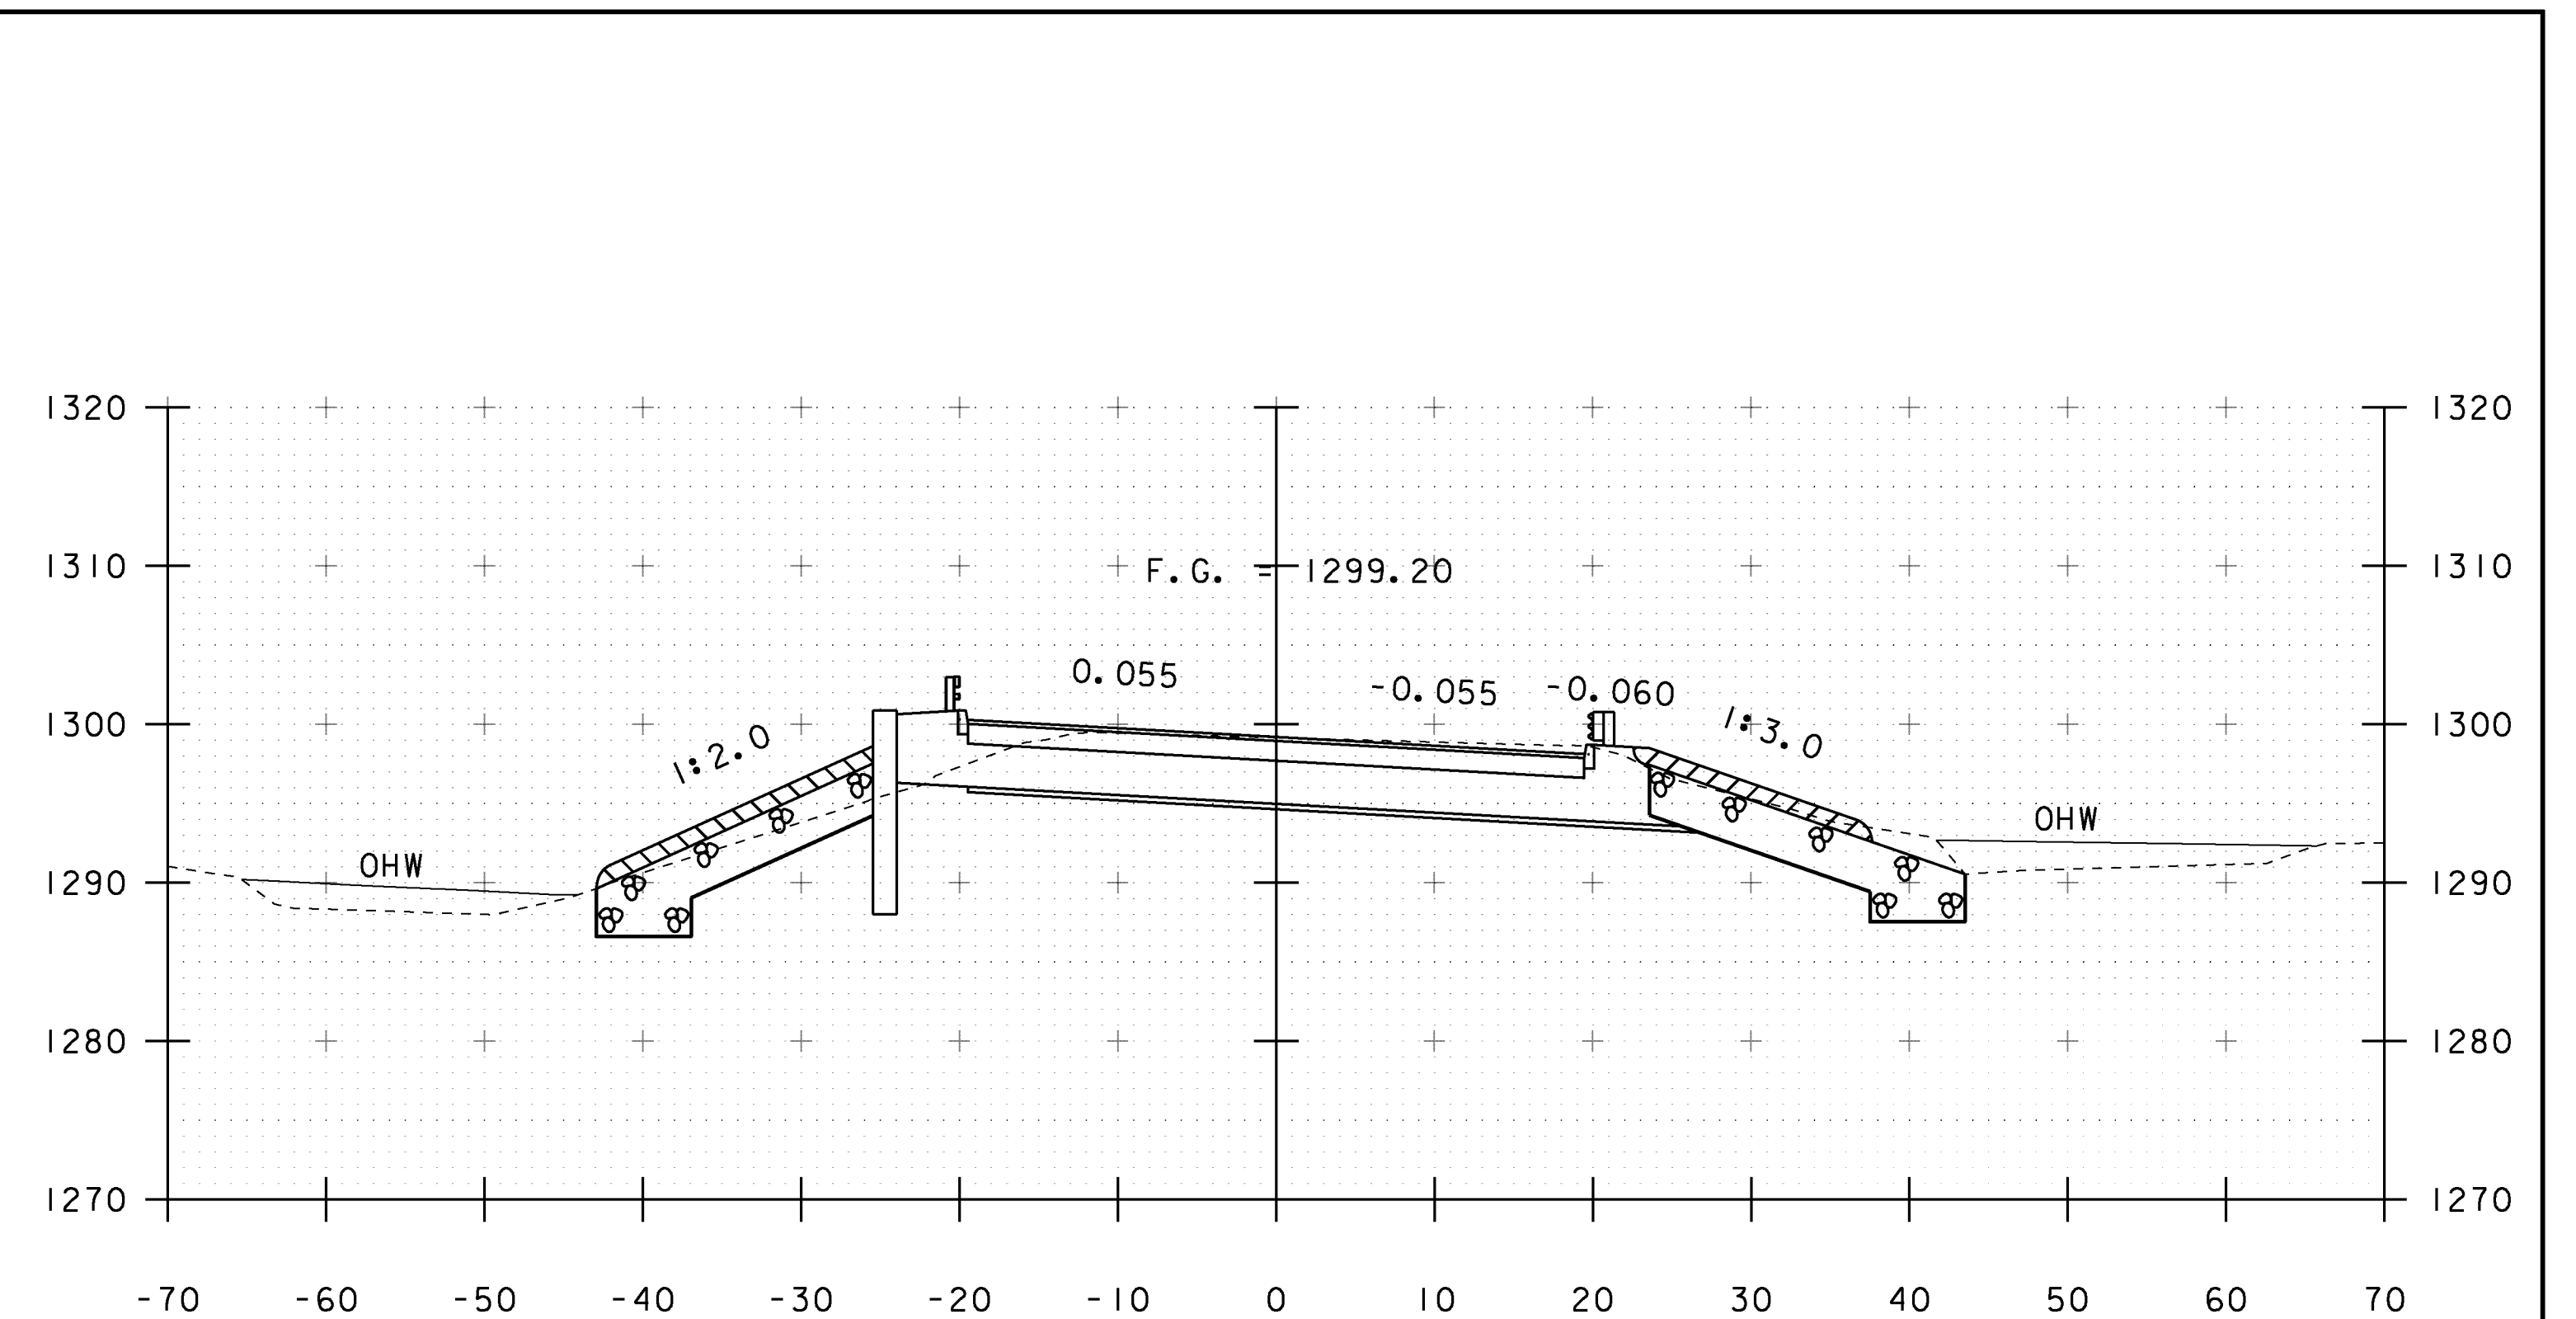

393+00

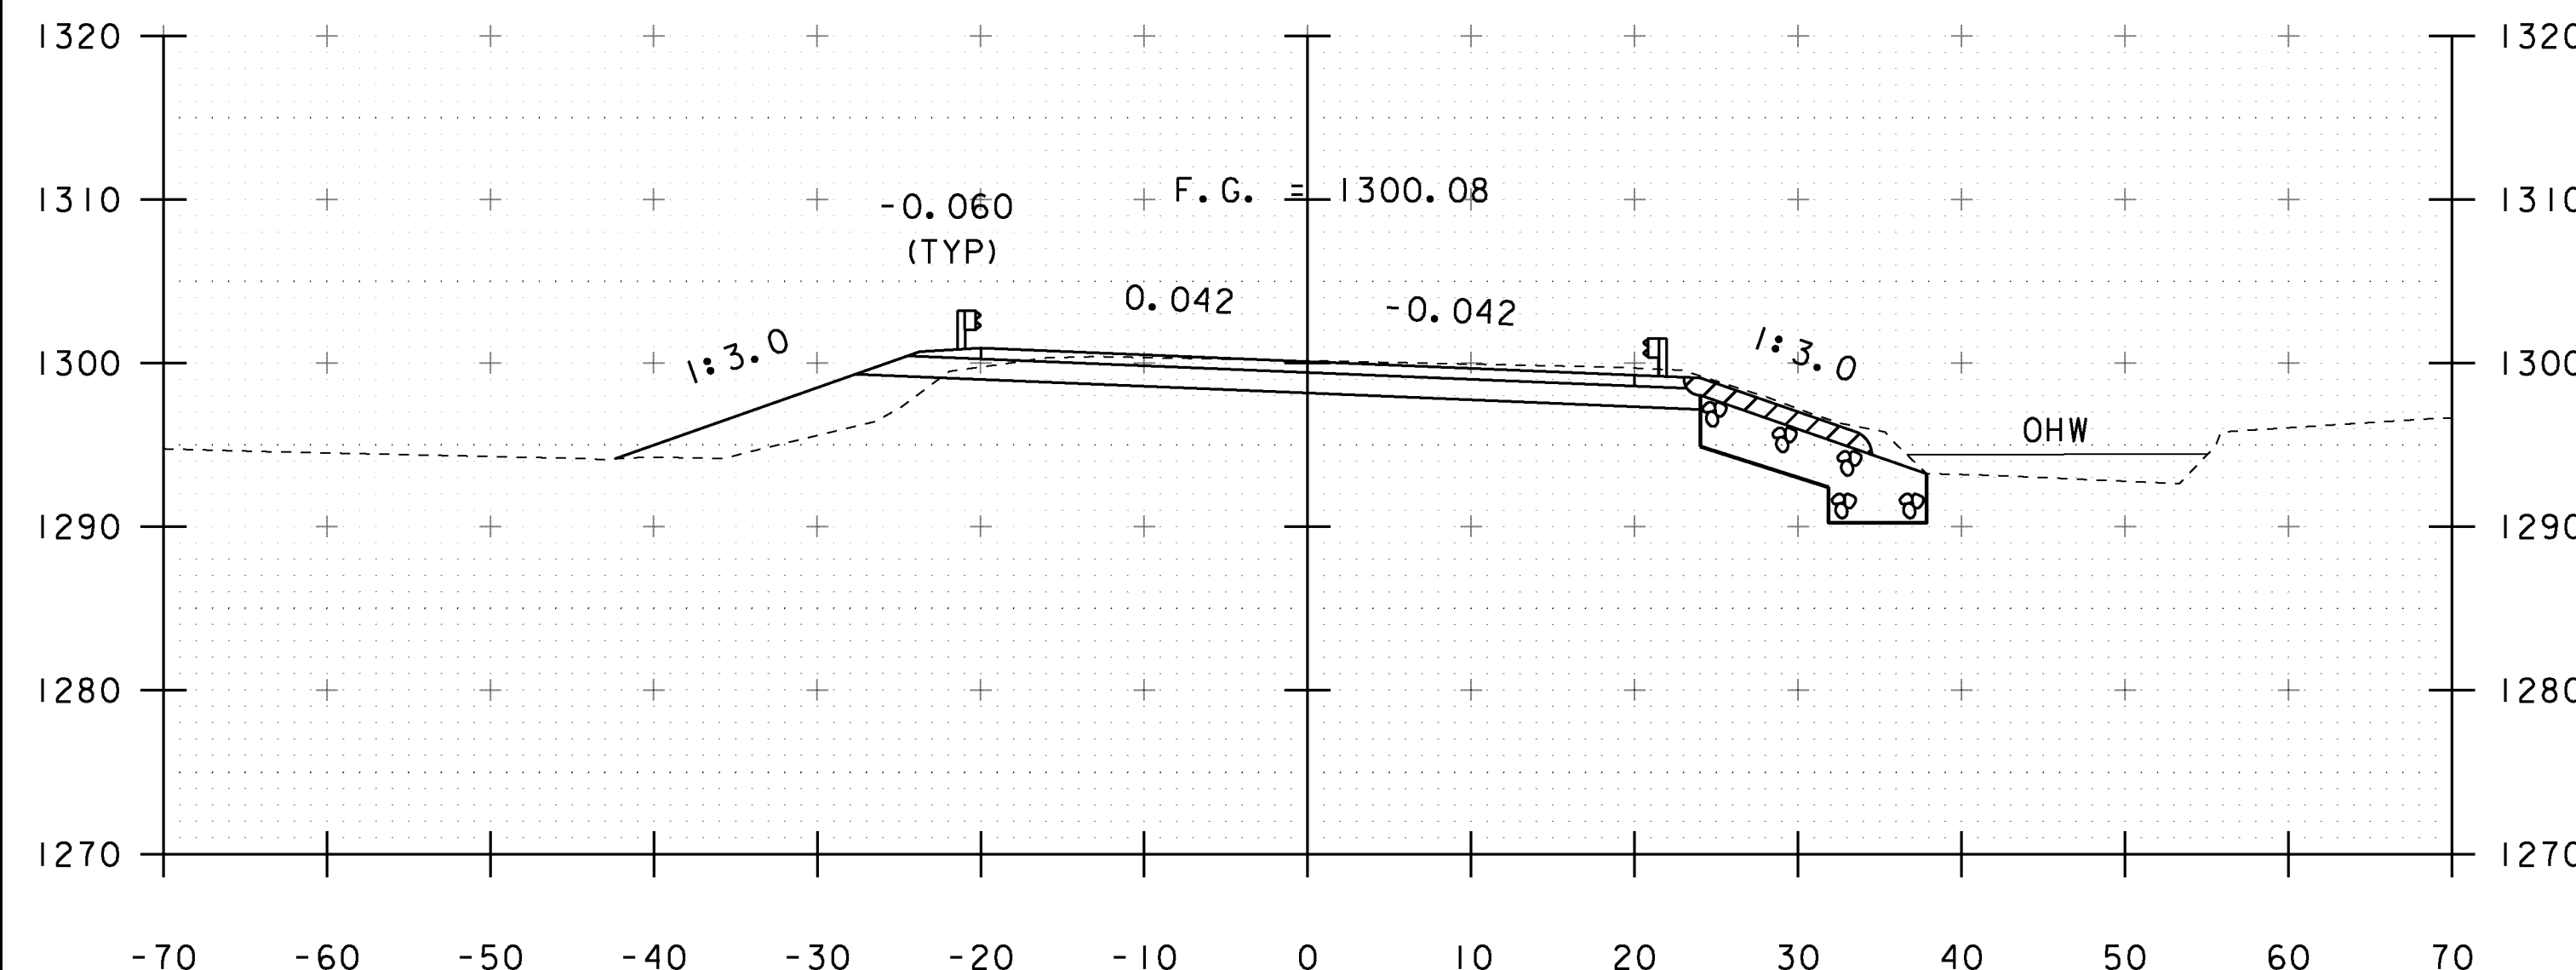

392+25

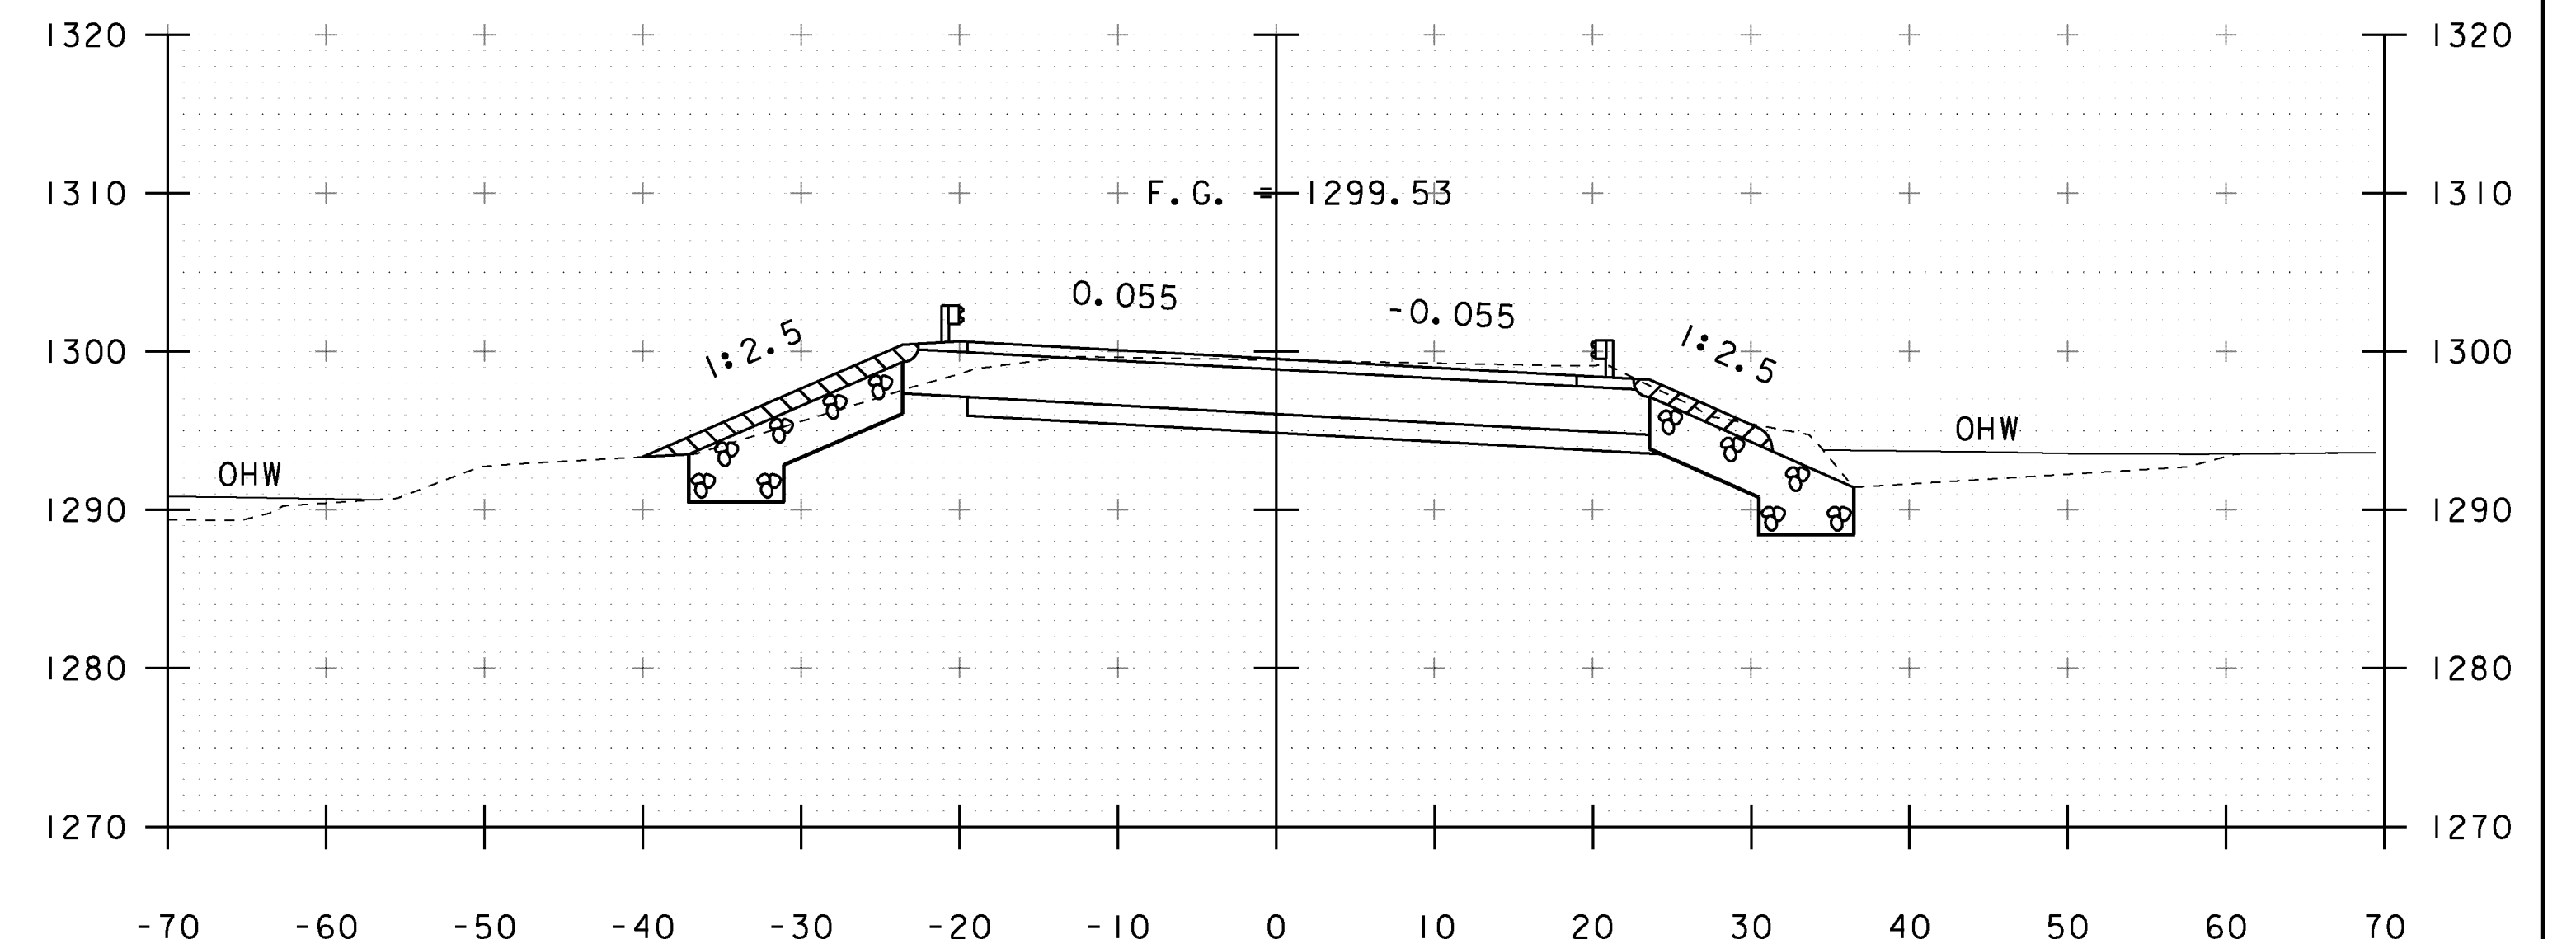

392+75

STA. 392+25 TO STA. 393+00

PROJECT NAME: MARLBORO	PLOT DATE: 28-AUG-2013
PROJECT NUMBER: BRF 010-1(43)	DRAWN BY: K. FRIEDLAND
FILE NAME: si0b414xsl.dgn	CHECKED BY: G. LAROCHE
PROJECT LEADER: K. HIGGINS	SHEET 42 OF 50
DESIGNED BY: R. KLINEFELTER	
MAINLINE SECTIONS 2	