




393+50 • REVISED BRIDGE HAS 6 GIRDERS

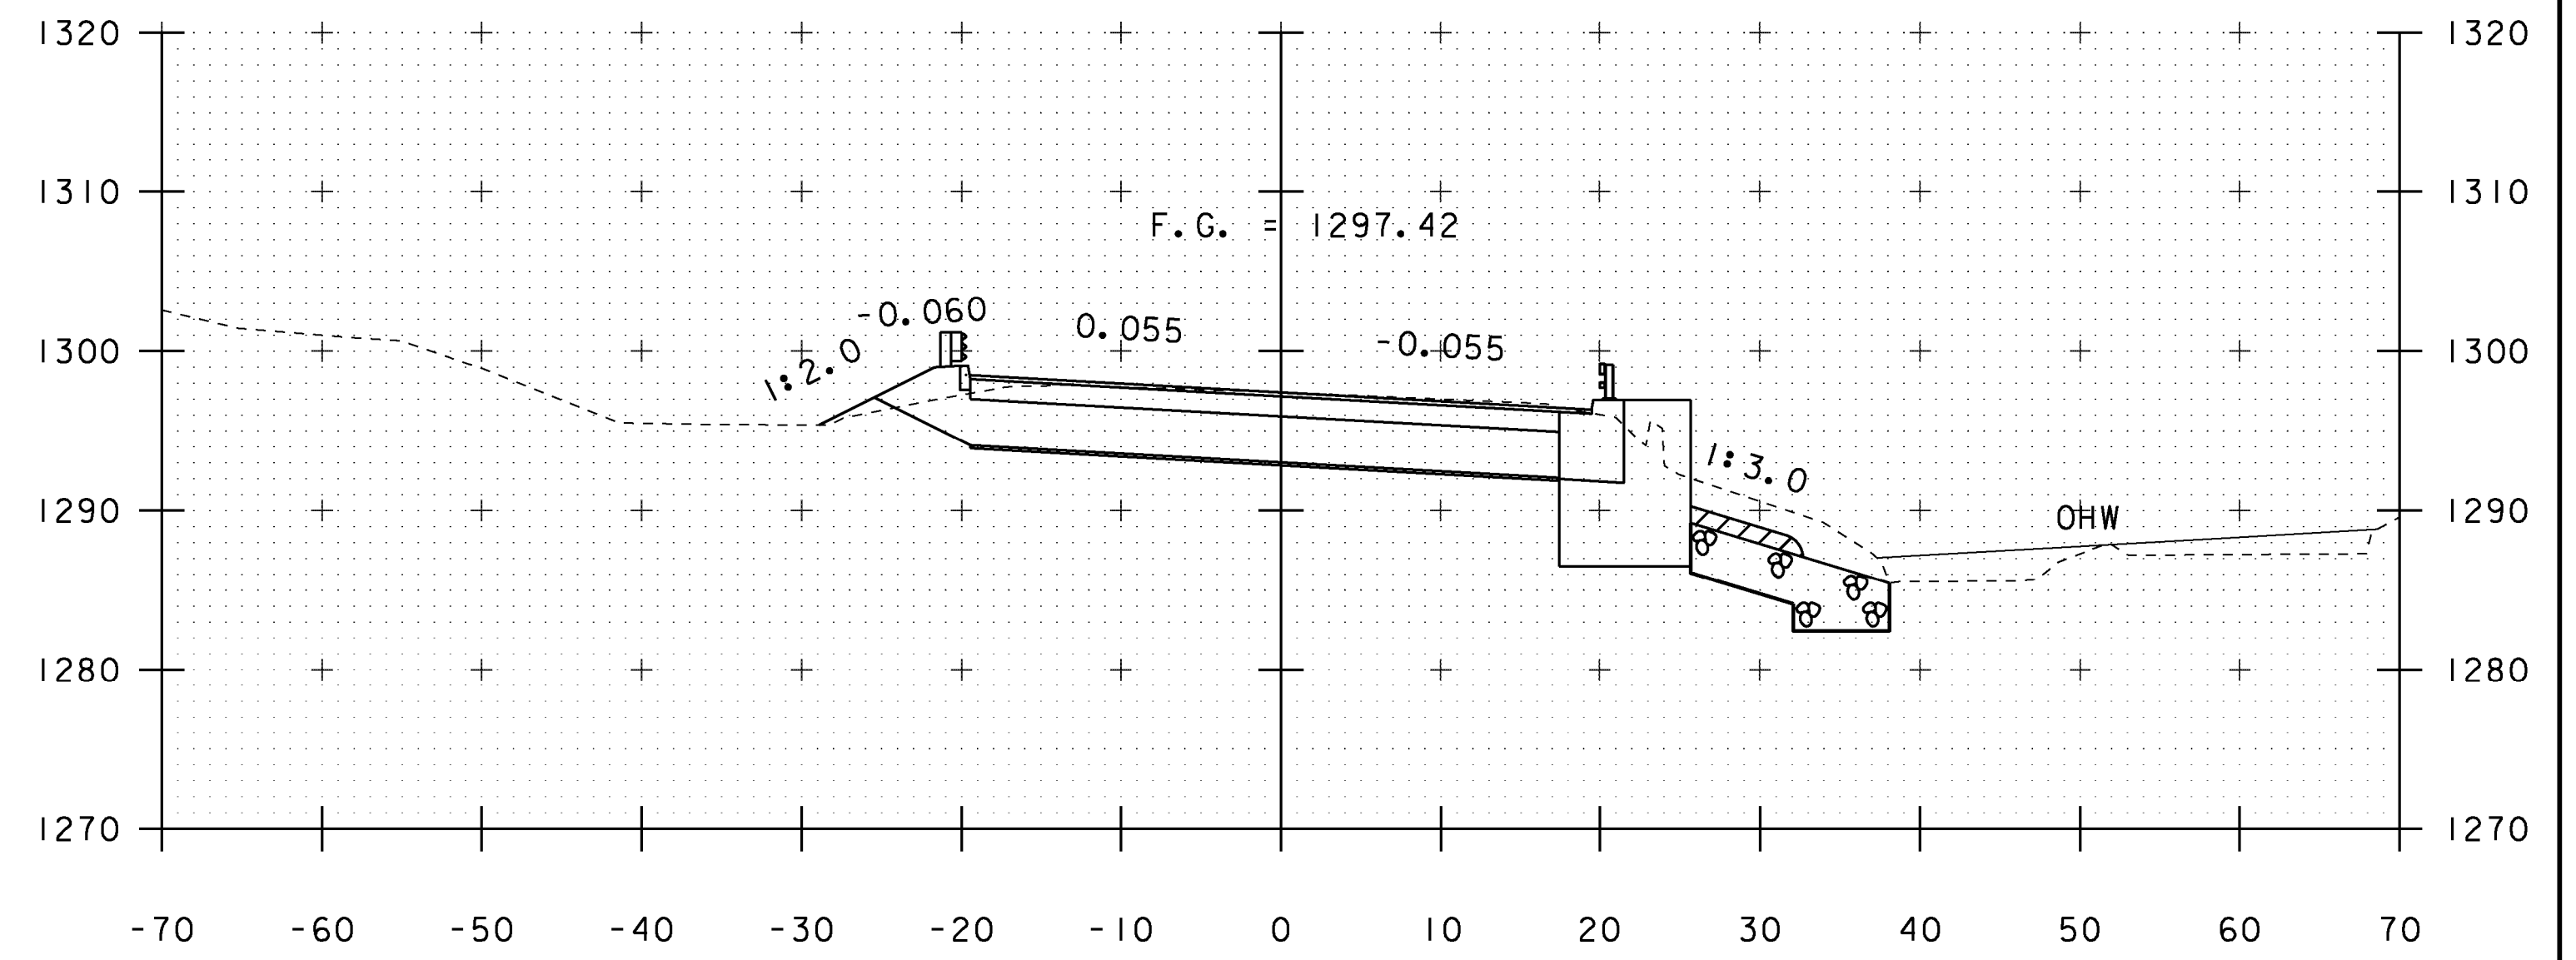

394+00
 END BRIDGE STA ~~393+93.78~~
 393+93.87

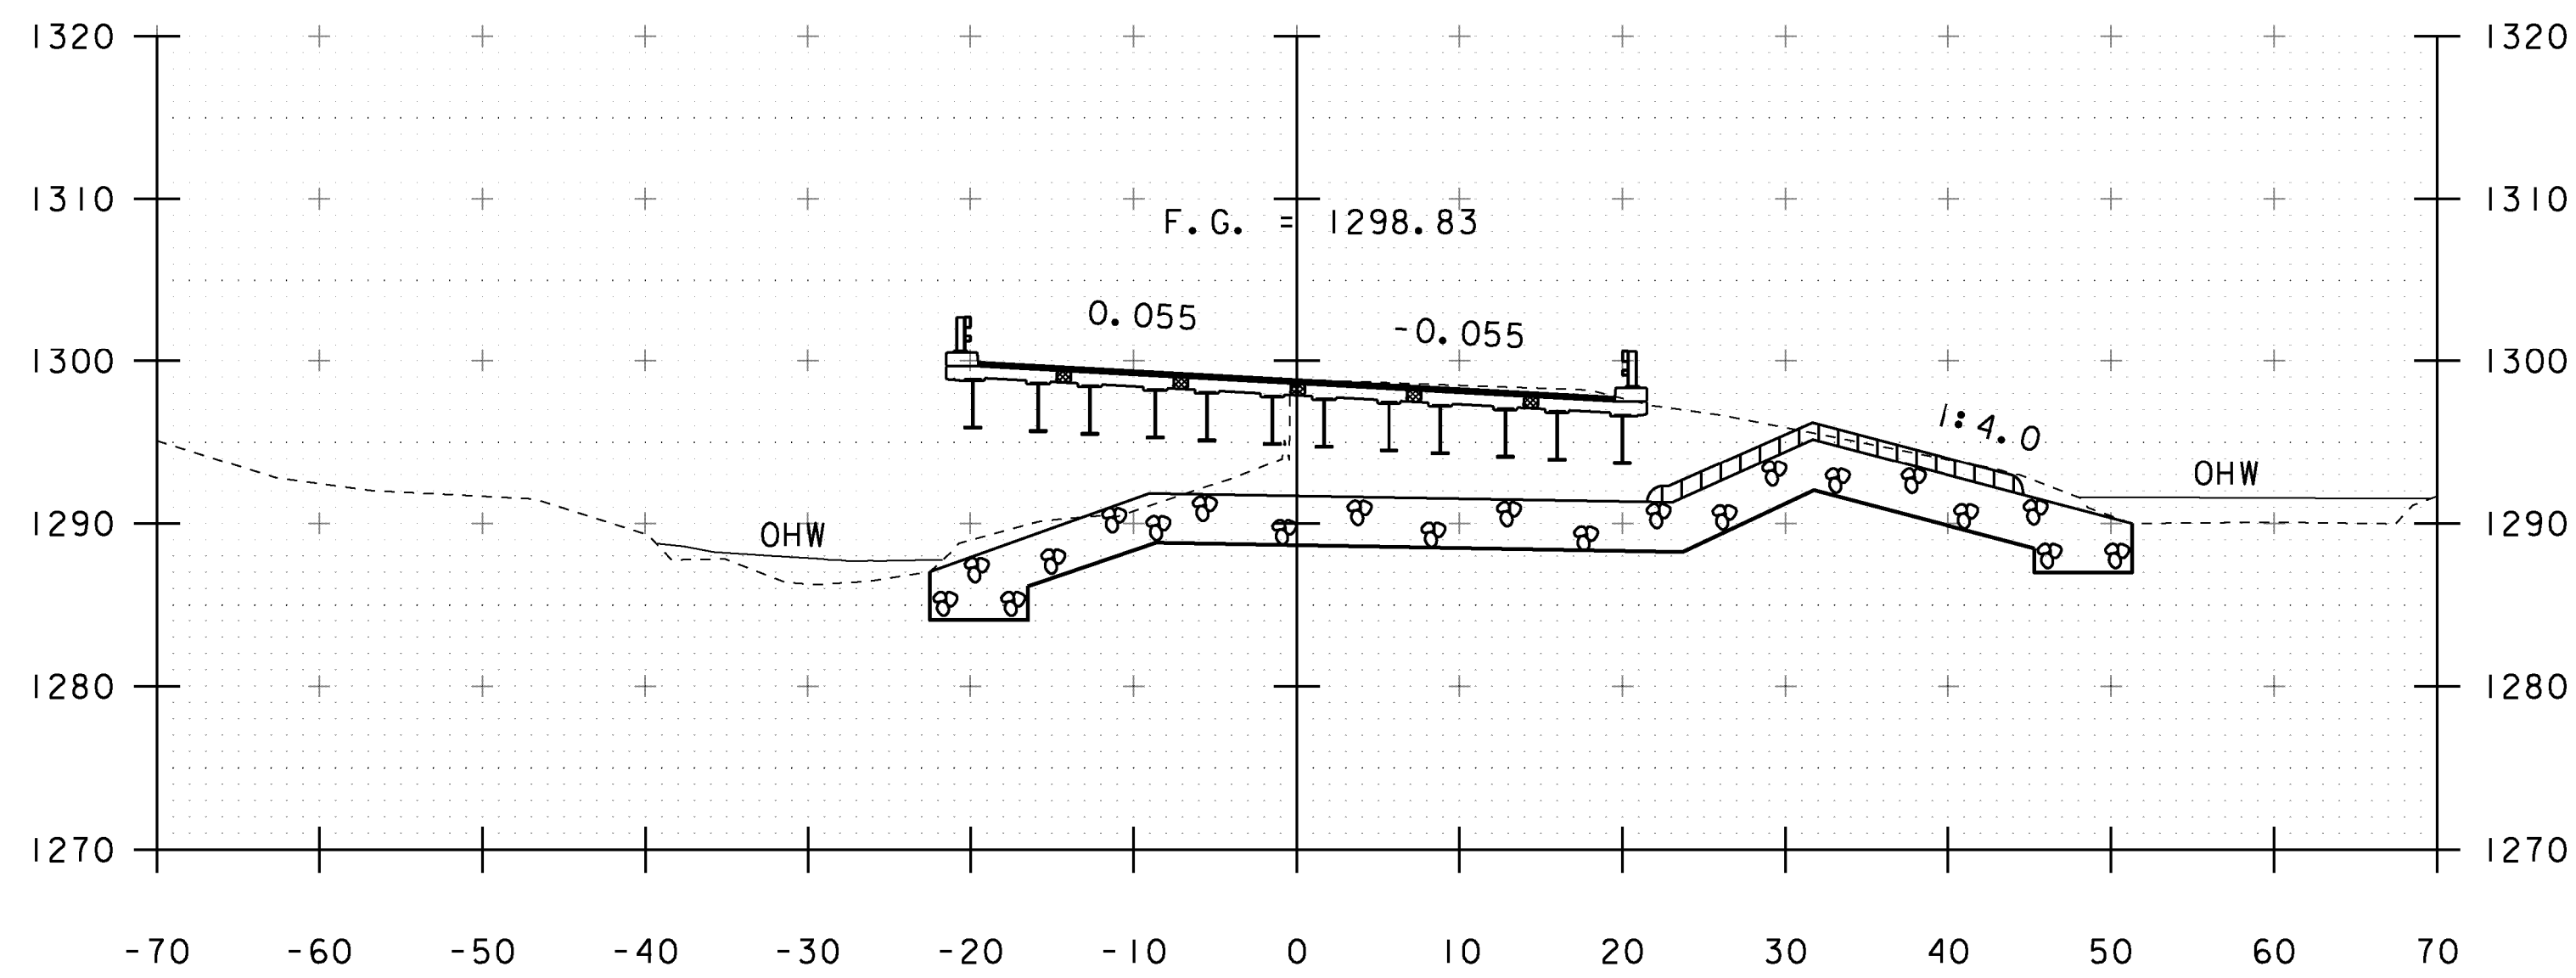

393+25
 BEGIN BRIDGE STA ~~393+12.23~~
 393+12.14

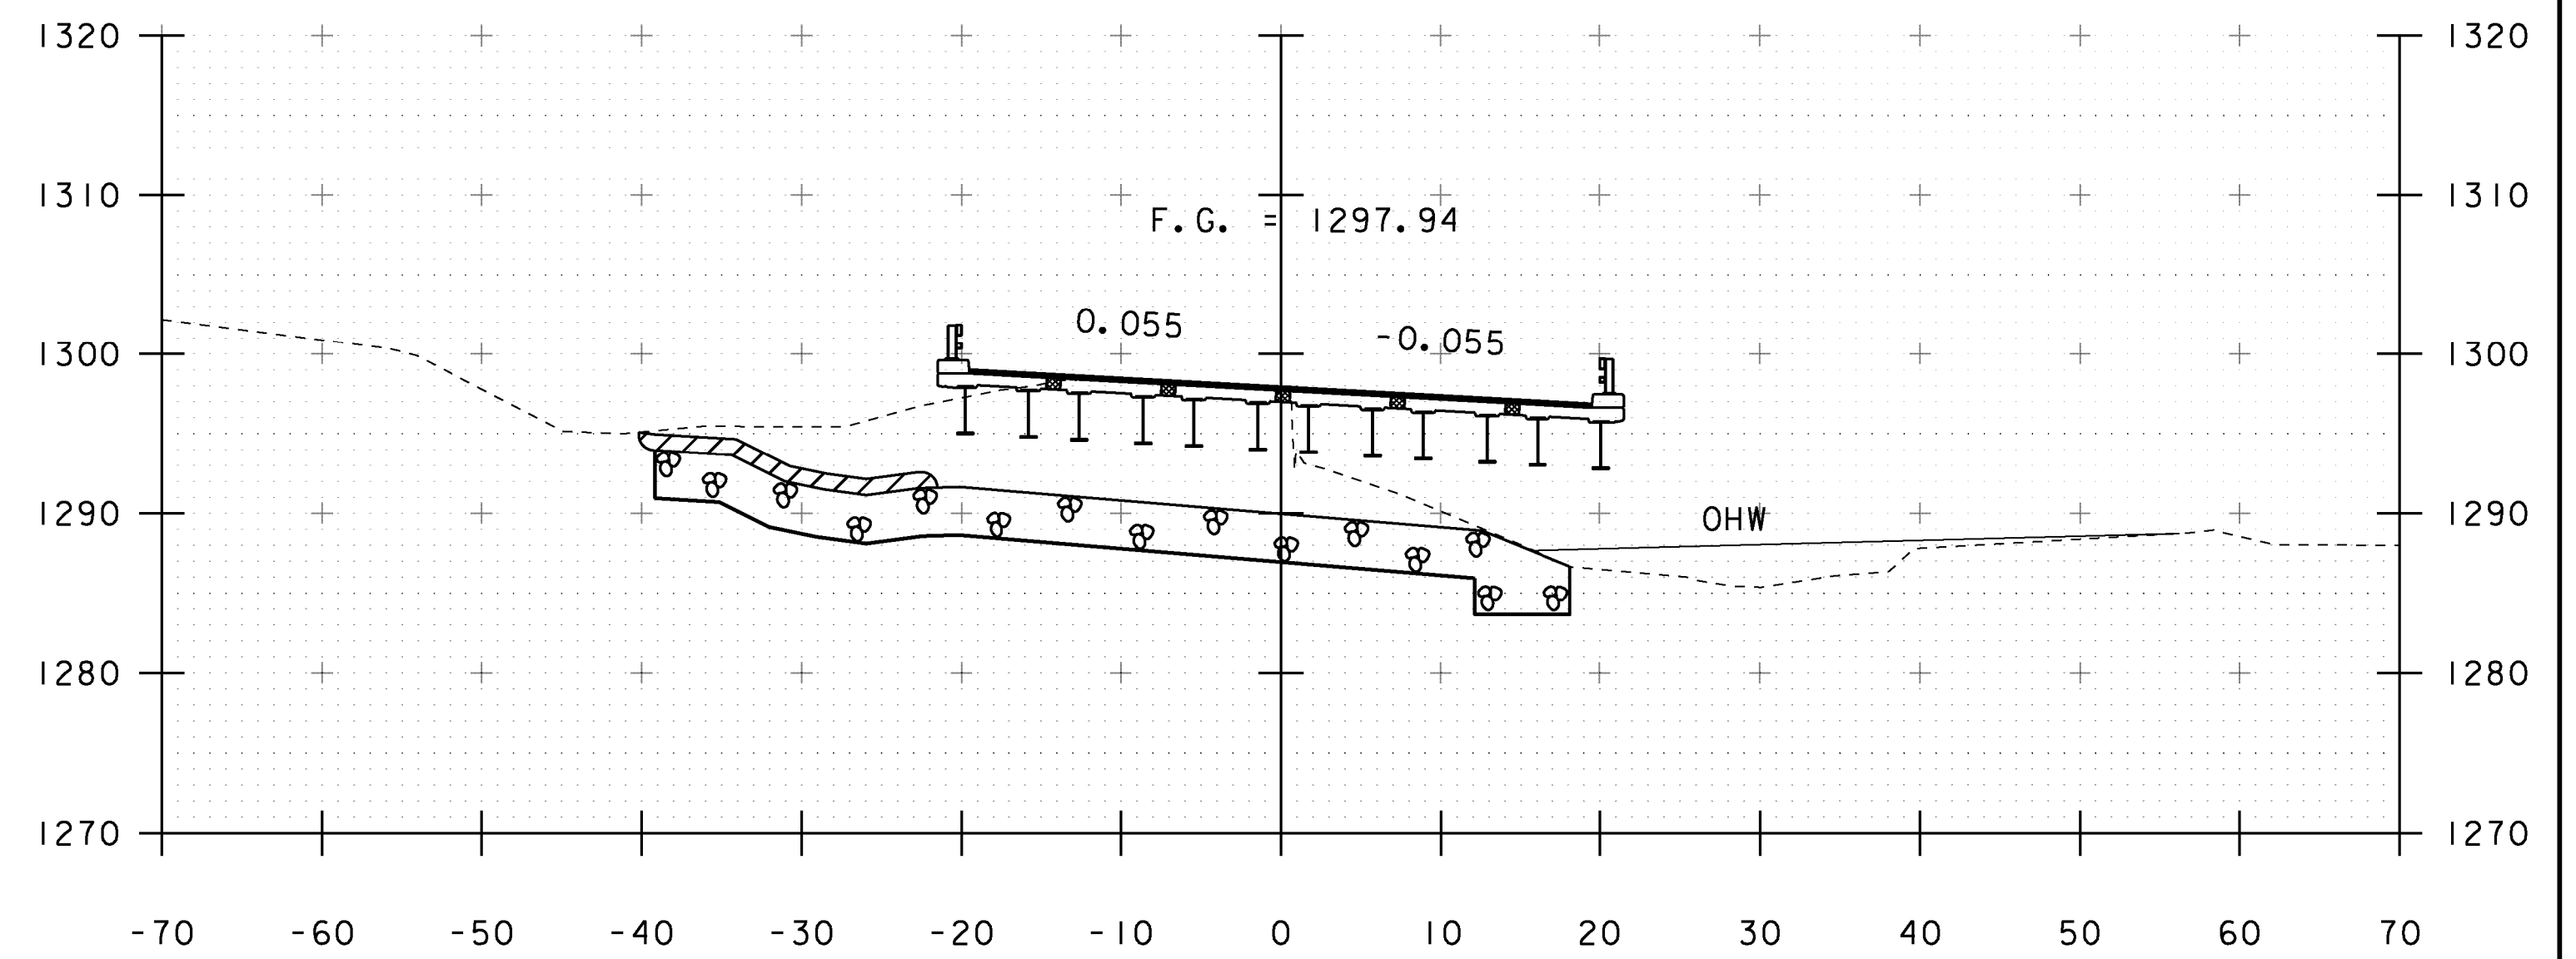

393+75

STA. 393+25 TO STA. 394+00

PROJECT NAME: MARLBORO	
PROJECT NUMBER: BRF 010-1(43)	
FILE NAME: s10b414xsl.dgn	PLOT DATE: 28-AUG-2013
PROJECT LEADER: K. HIGGINS	DRAWN BY: K. FRIEDLAND
DESIGNED BY: R. KLINEFELTER	CHECKED BY: G. LAROCHE
MAINLINE SECTIONS 3	SHEET 43 OF 50