




394+50  
END PROJECT

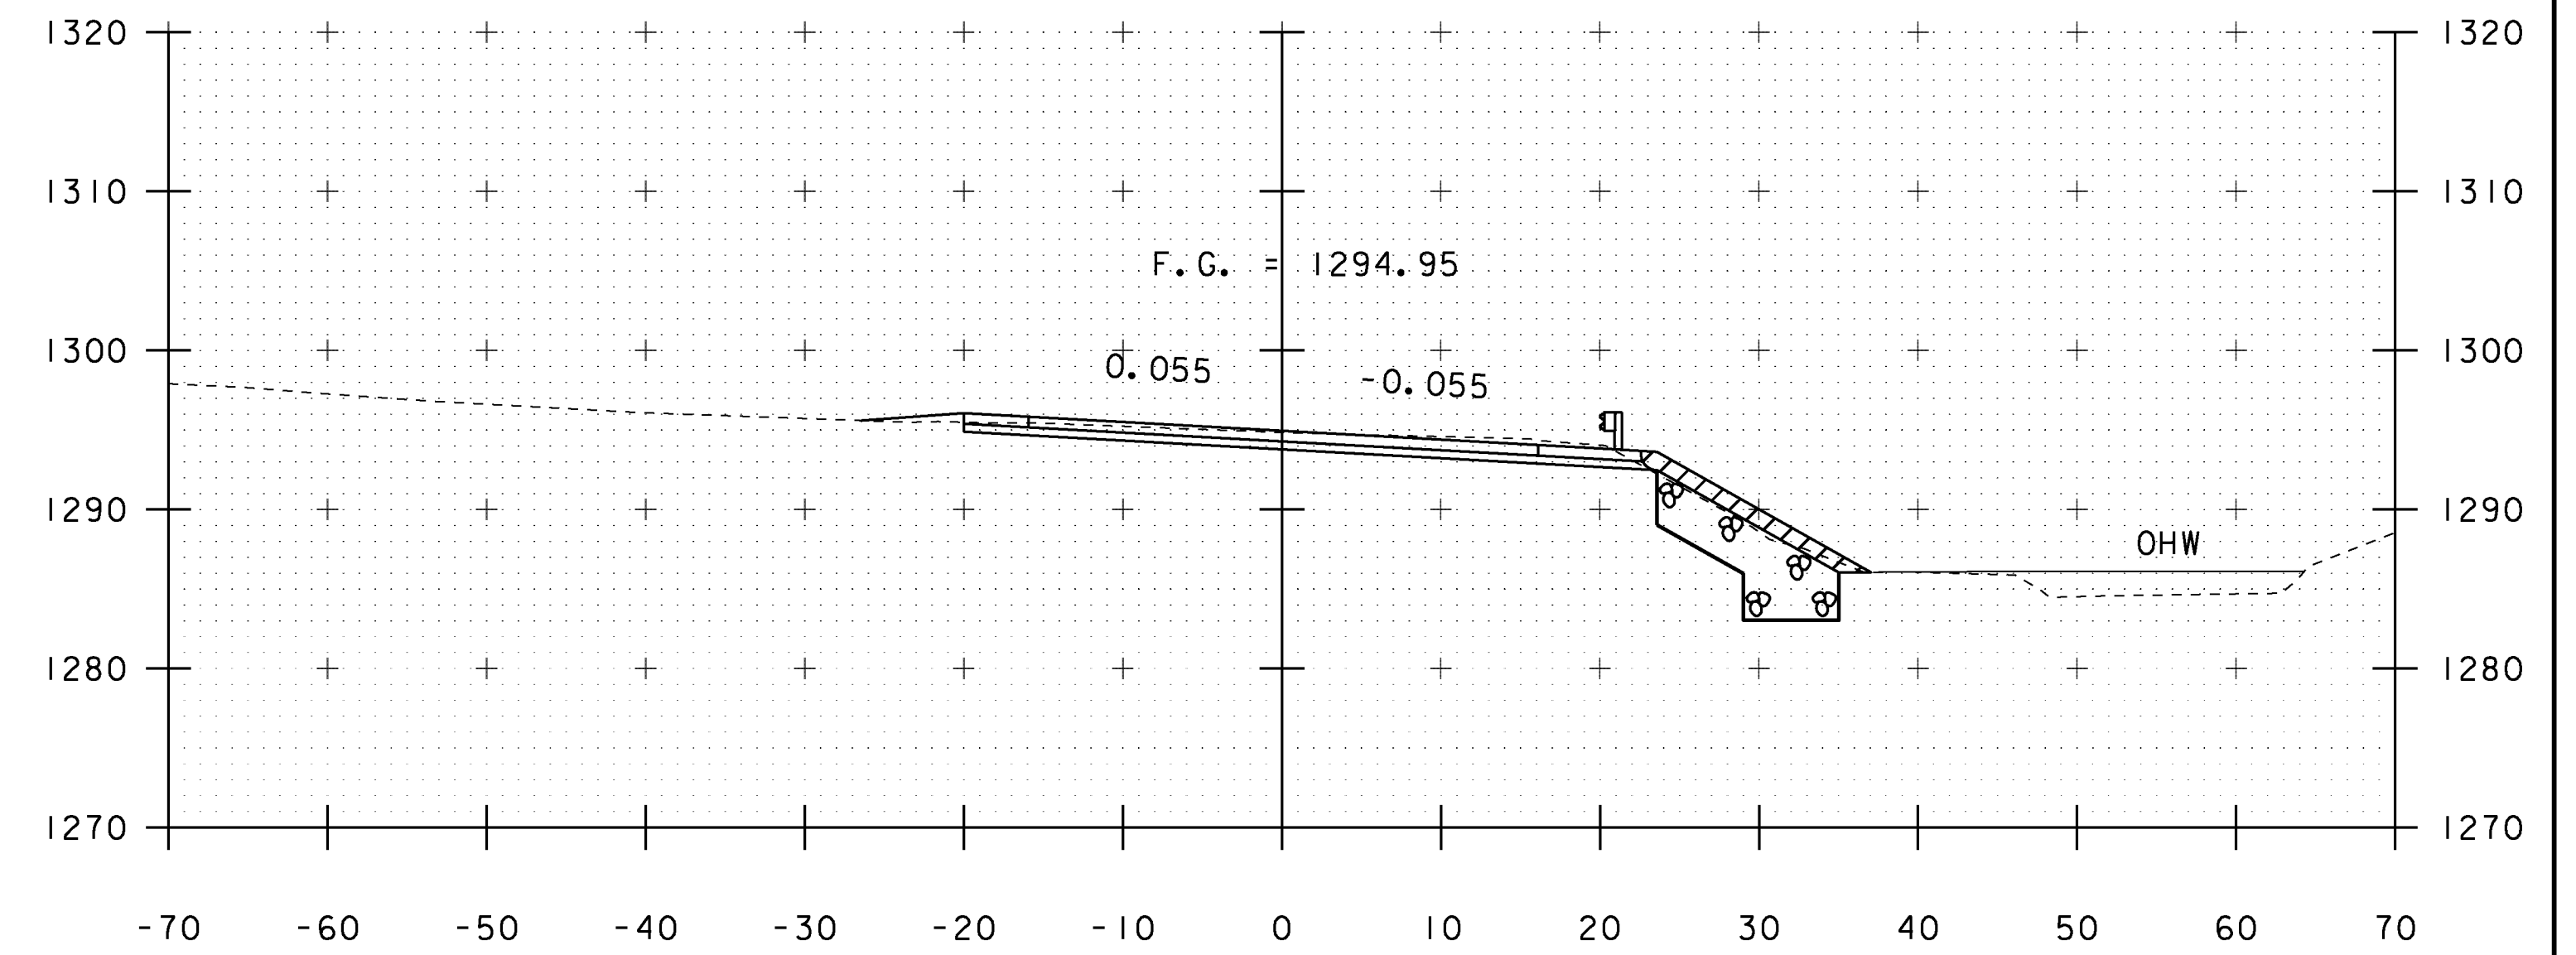

395+00

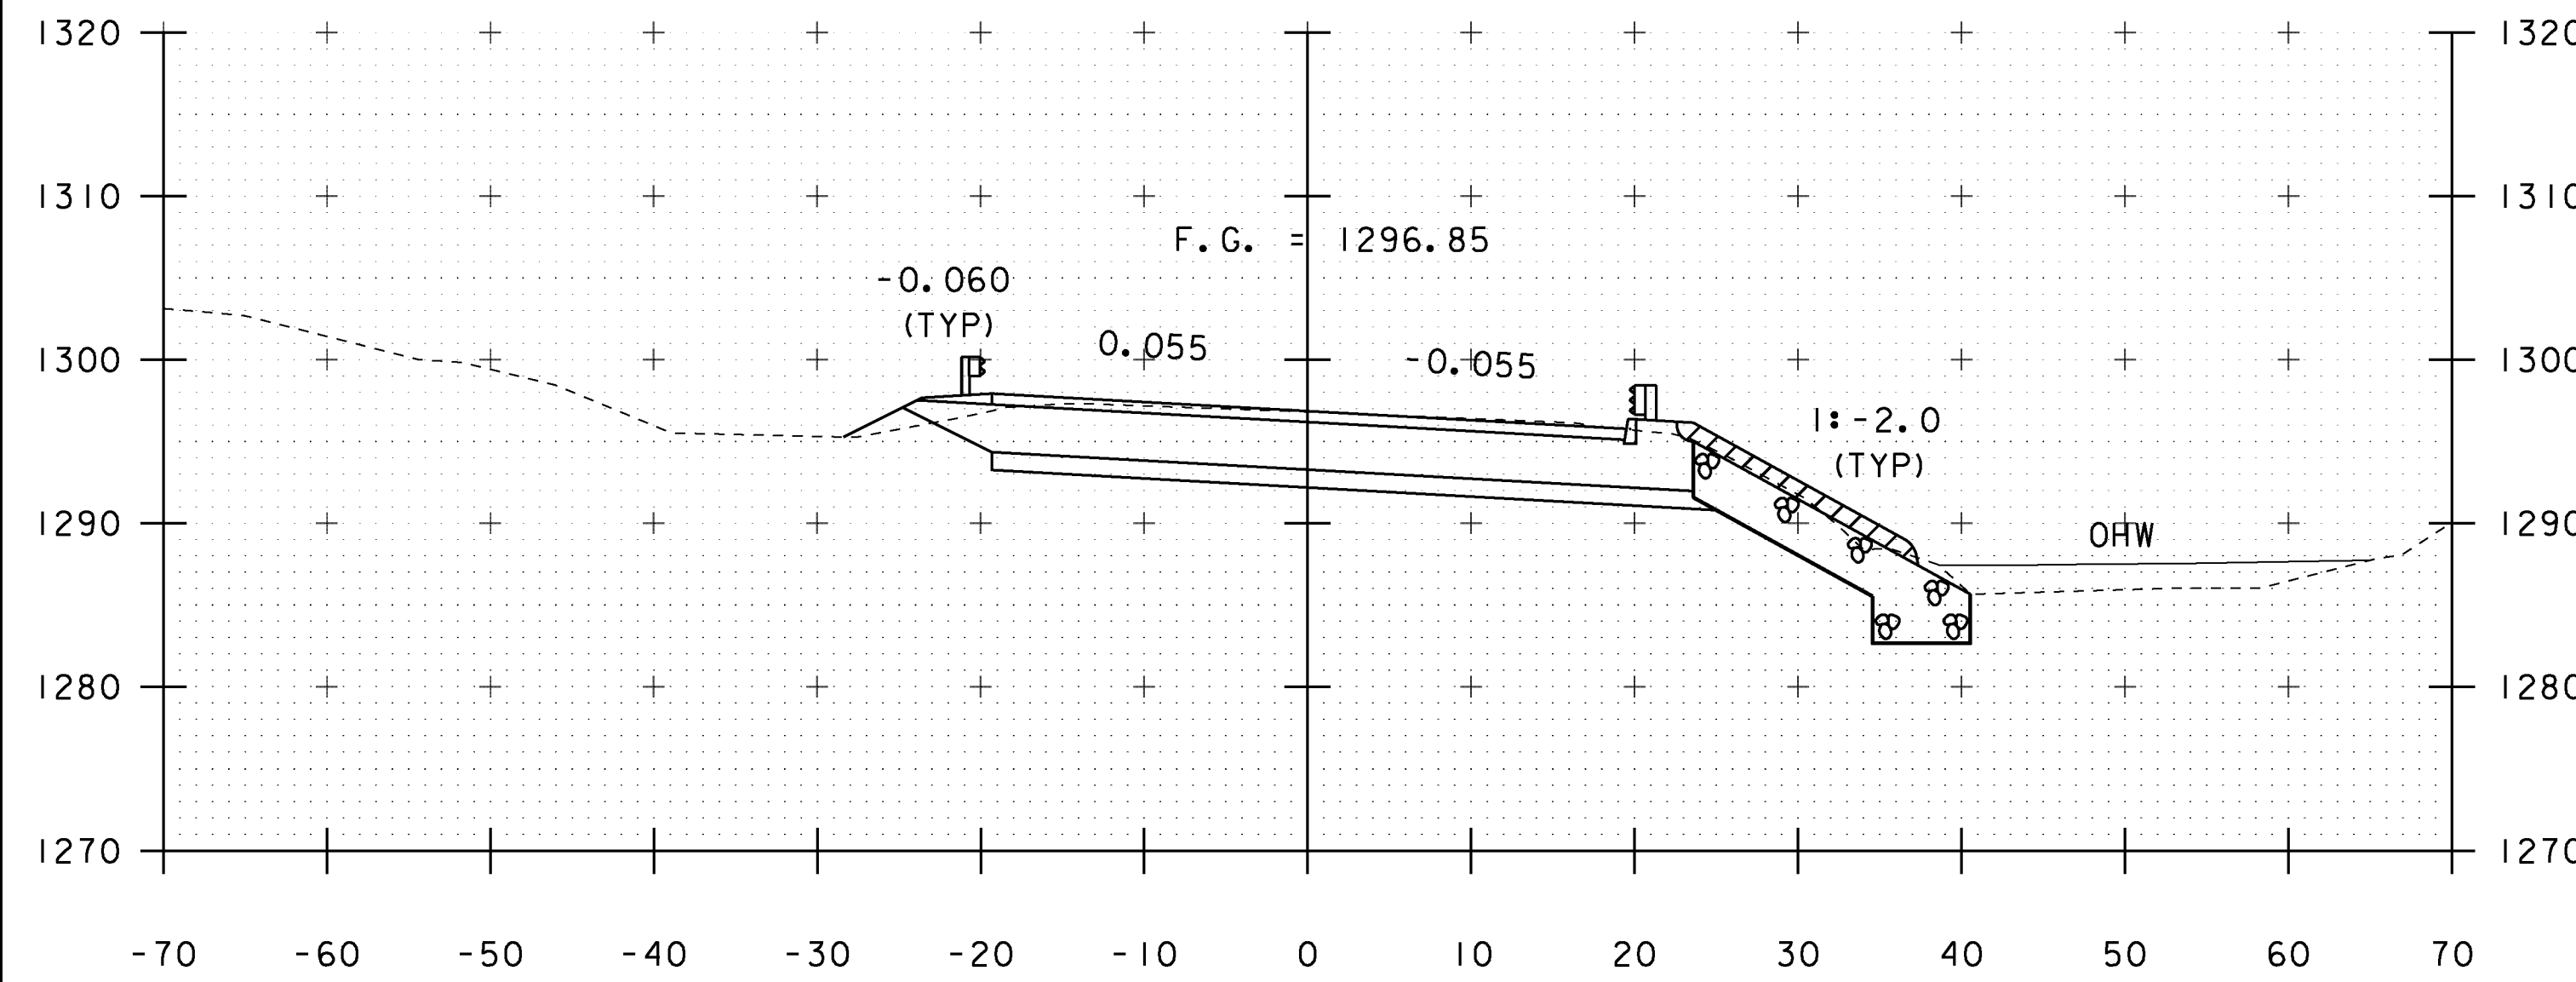

394+25

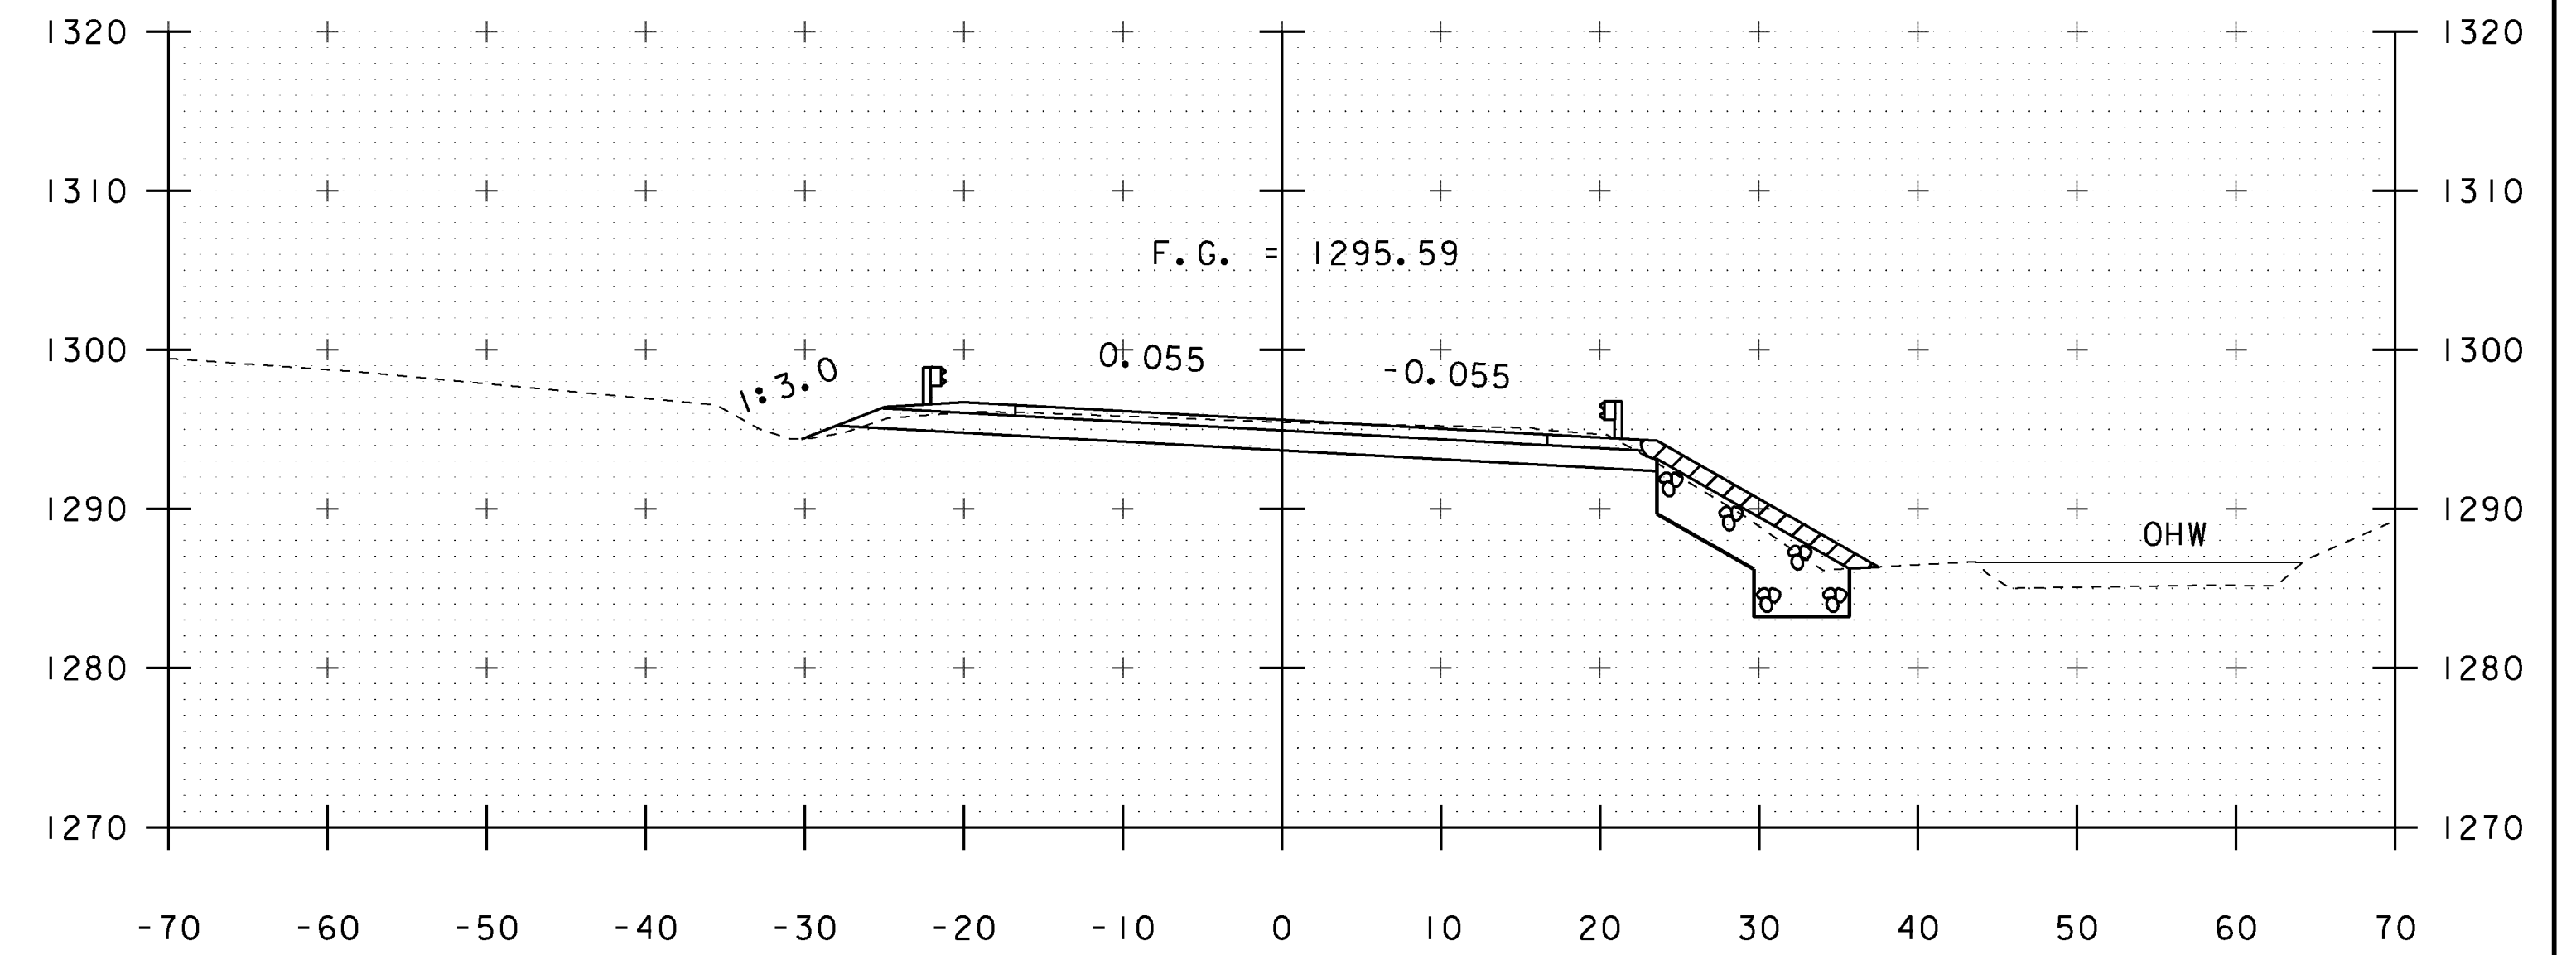

394+75

STA. 394+25 TO STA. 395+00

PROJECT NAME: MARLBORO	PLOT DATE: 28-AUG-2013
PROJECT NUMBER: BRF 010-1(43)	DRAWN BY: K. FRIEDLAND
FILE NAME: si0b414xsl.dgn	CHECKED BY: G. LAROCHE
PROJECT LEADER: K. HIGGINS	SHEET 44 OF 50
DESIGNED BY: R. KLINEFELTER	
MAINLINE SECTIONS 4	