



49+40

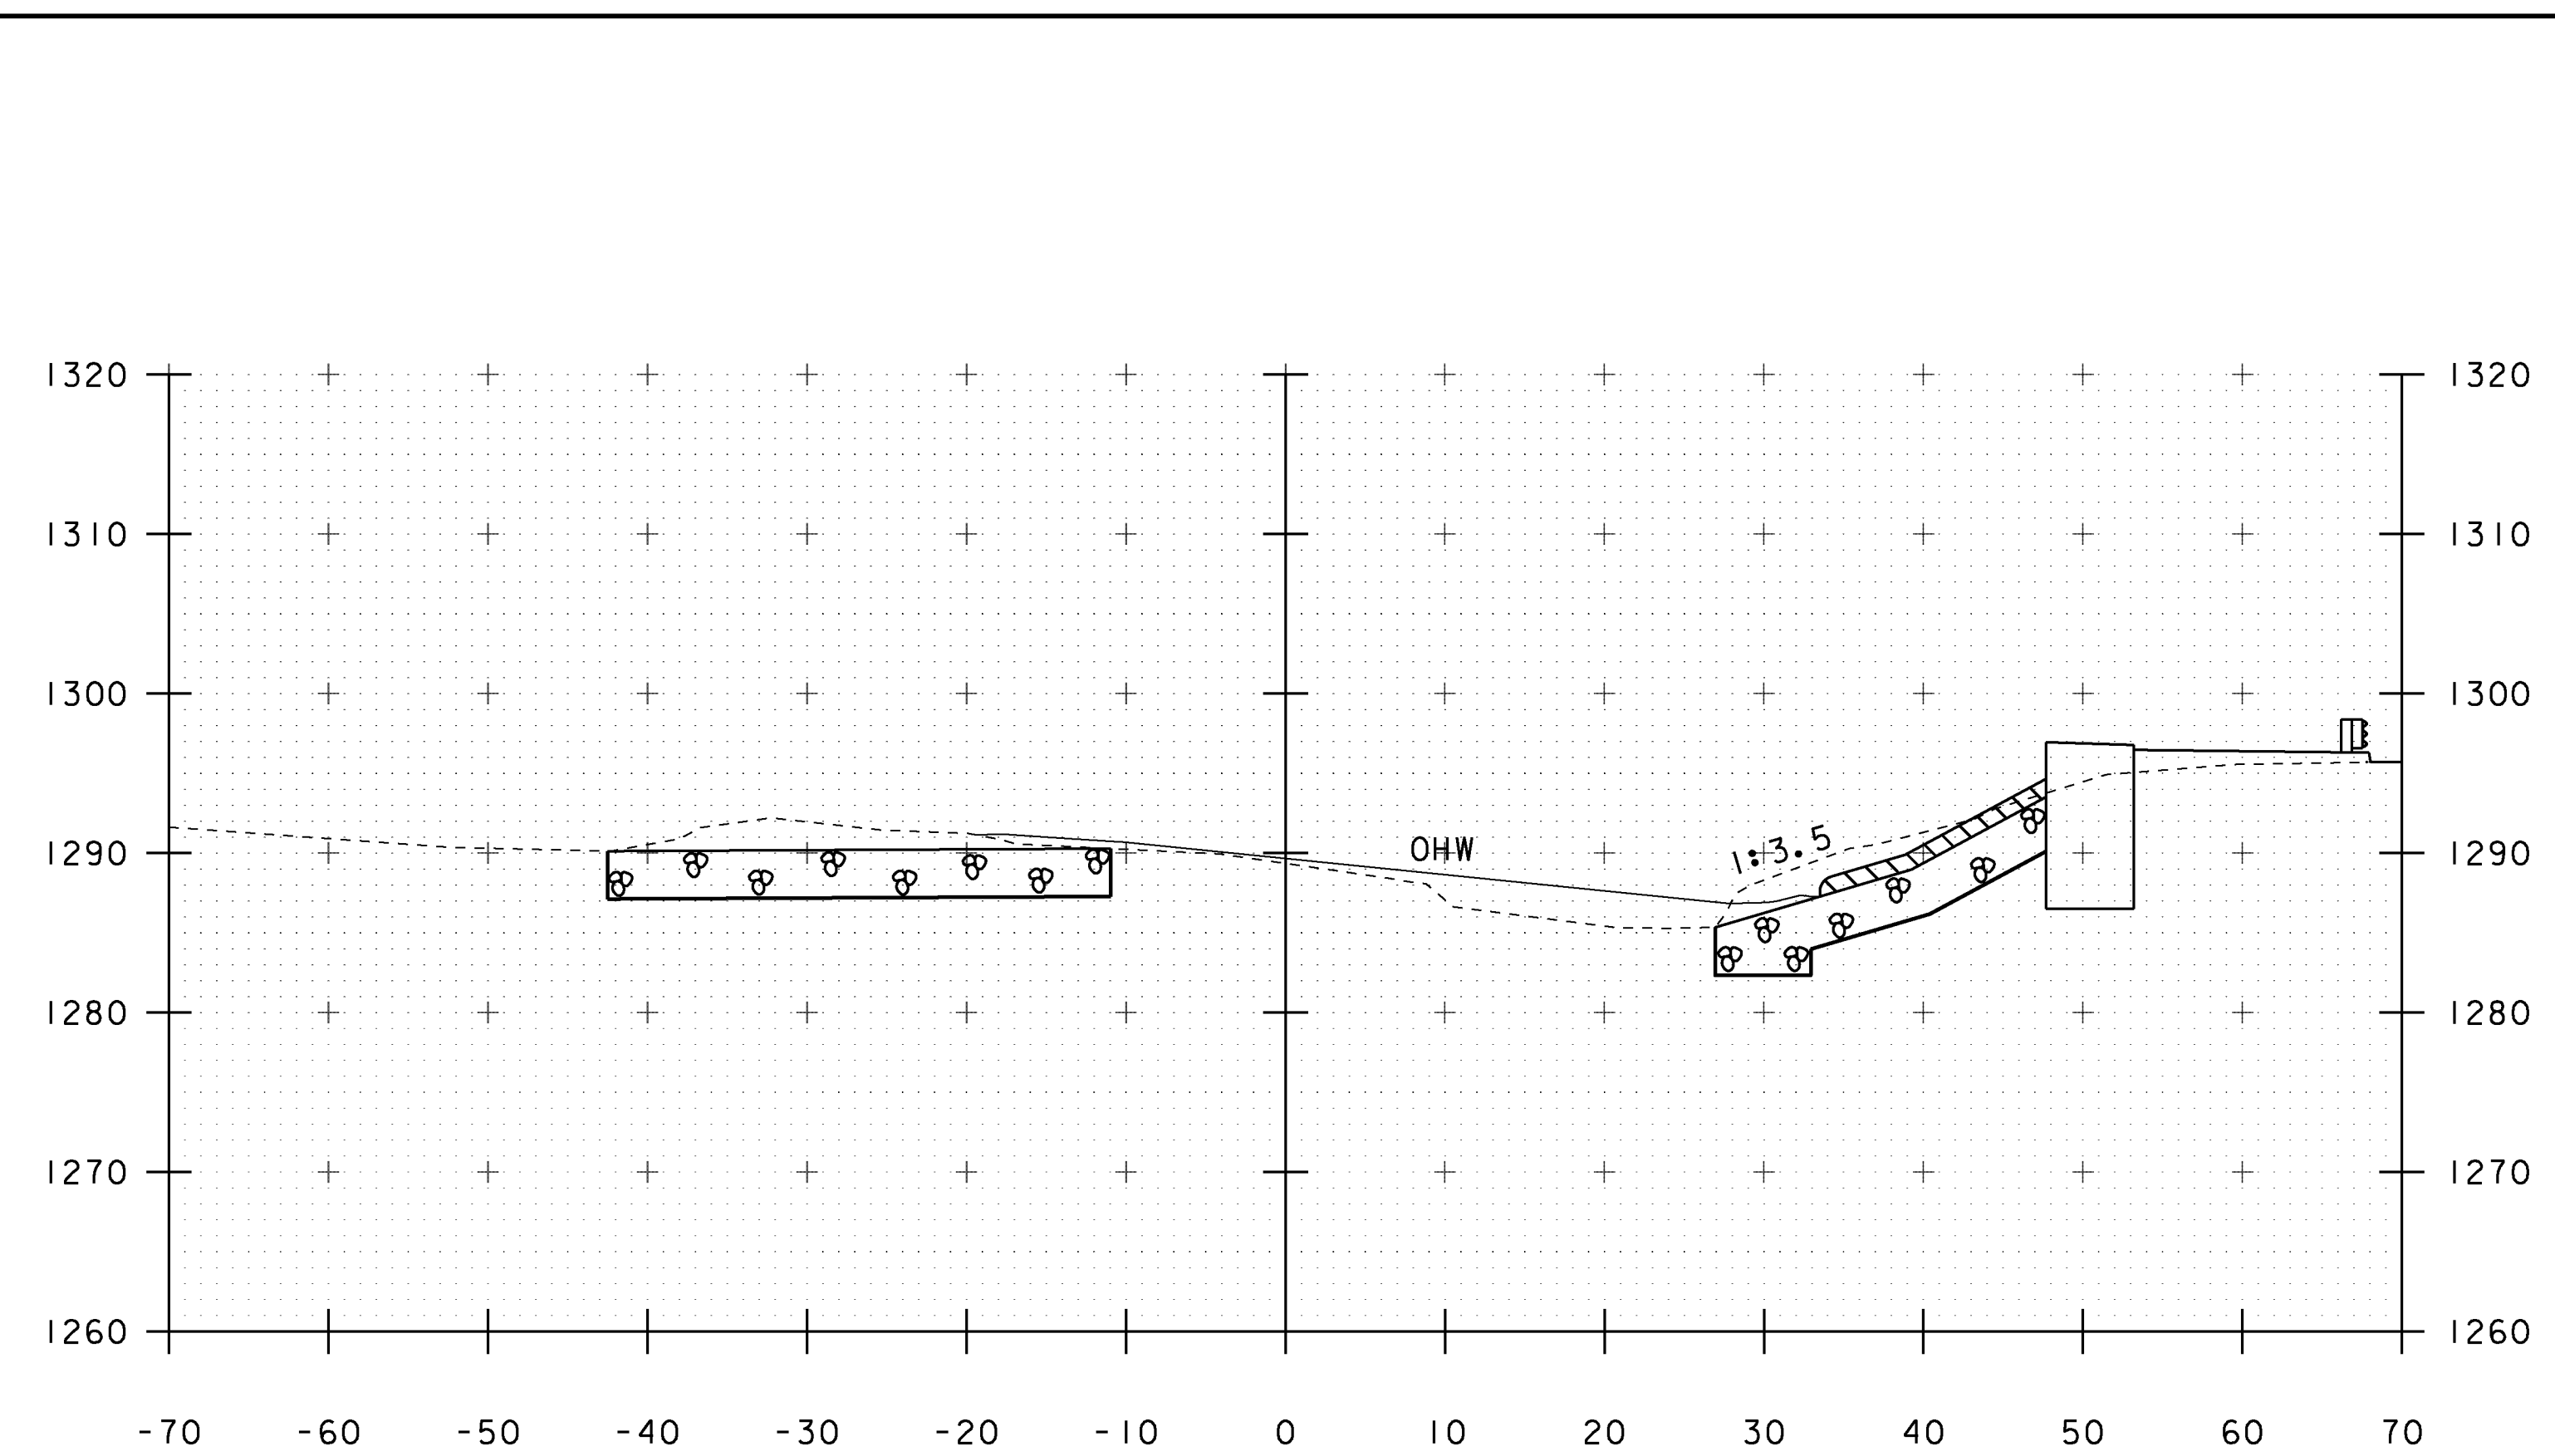


49+60

STA 49+56 LT  
 BEGIN UNCLASSIFIED CHANNEL EXCAVATION  
 GEOTEXTILE UNDER STONE FILL  
 STONE FILL, TYPE III  
 GRUBBING MATERIAL

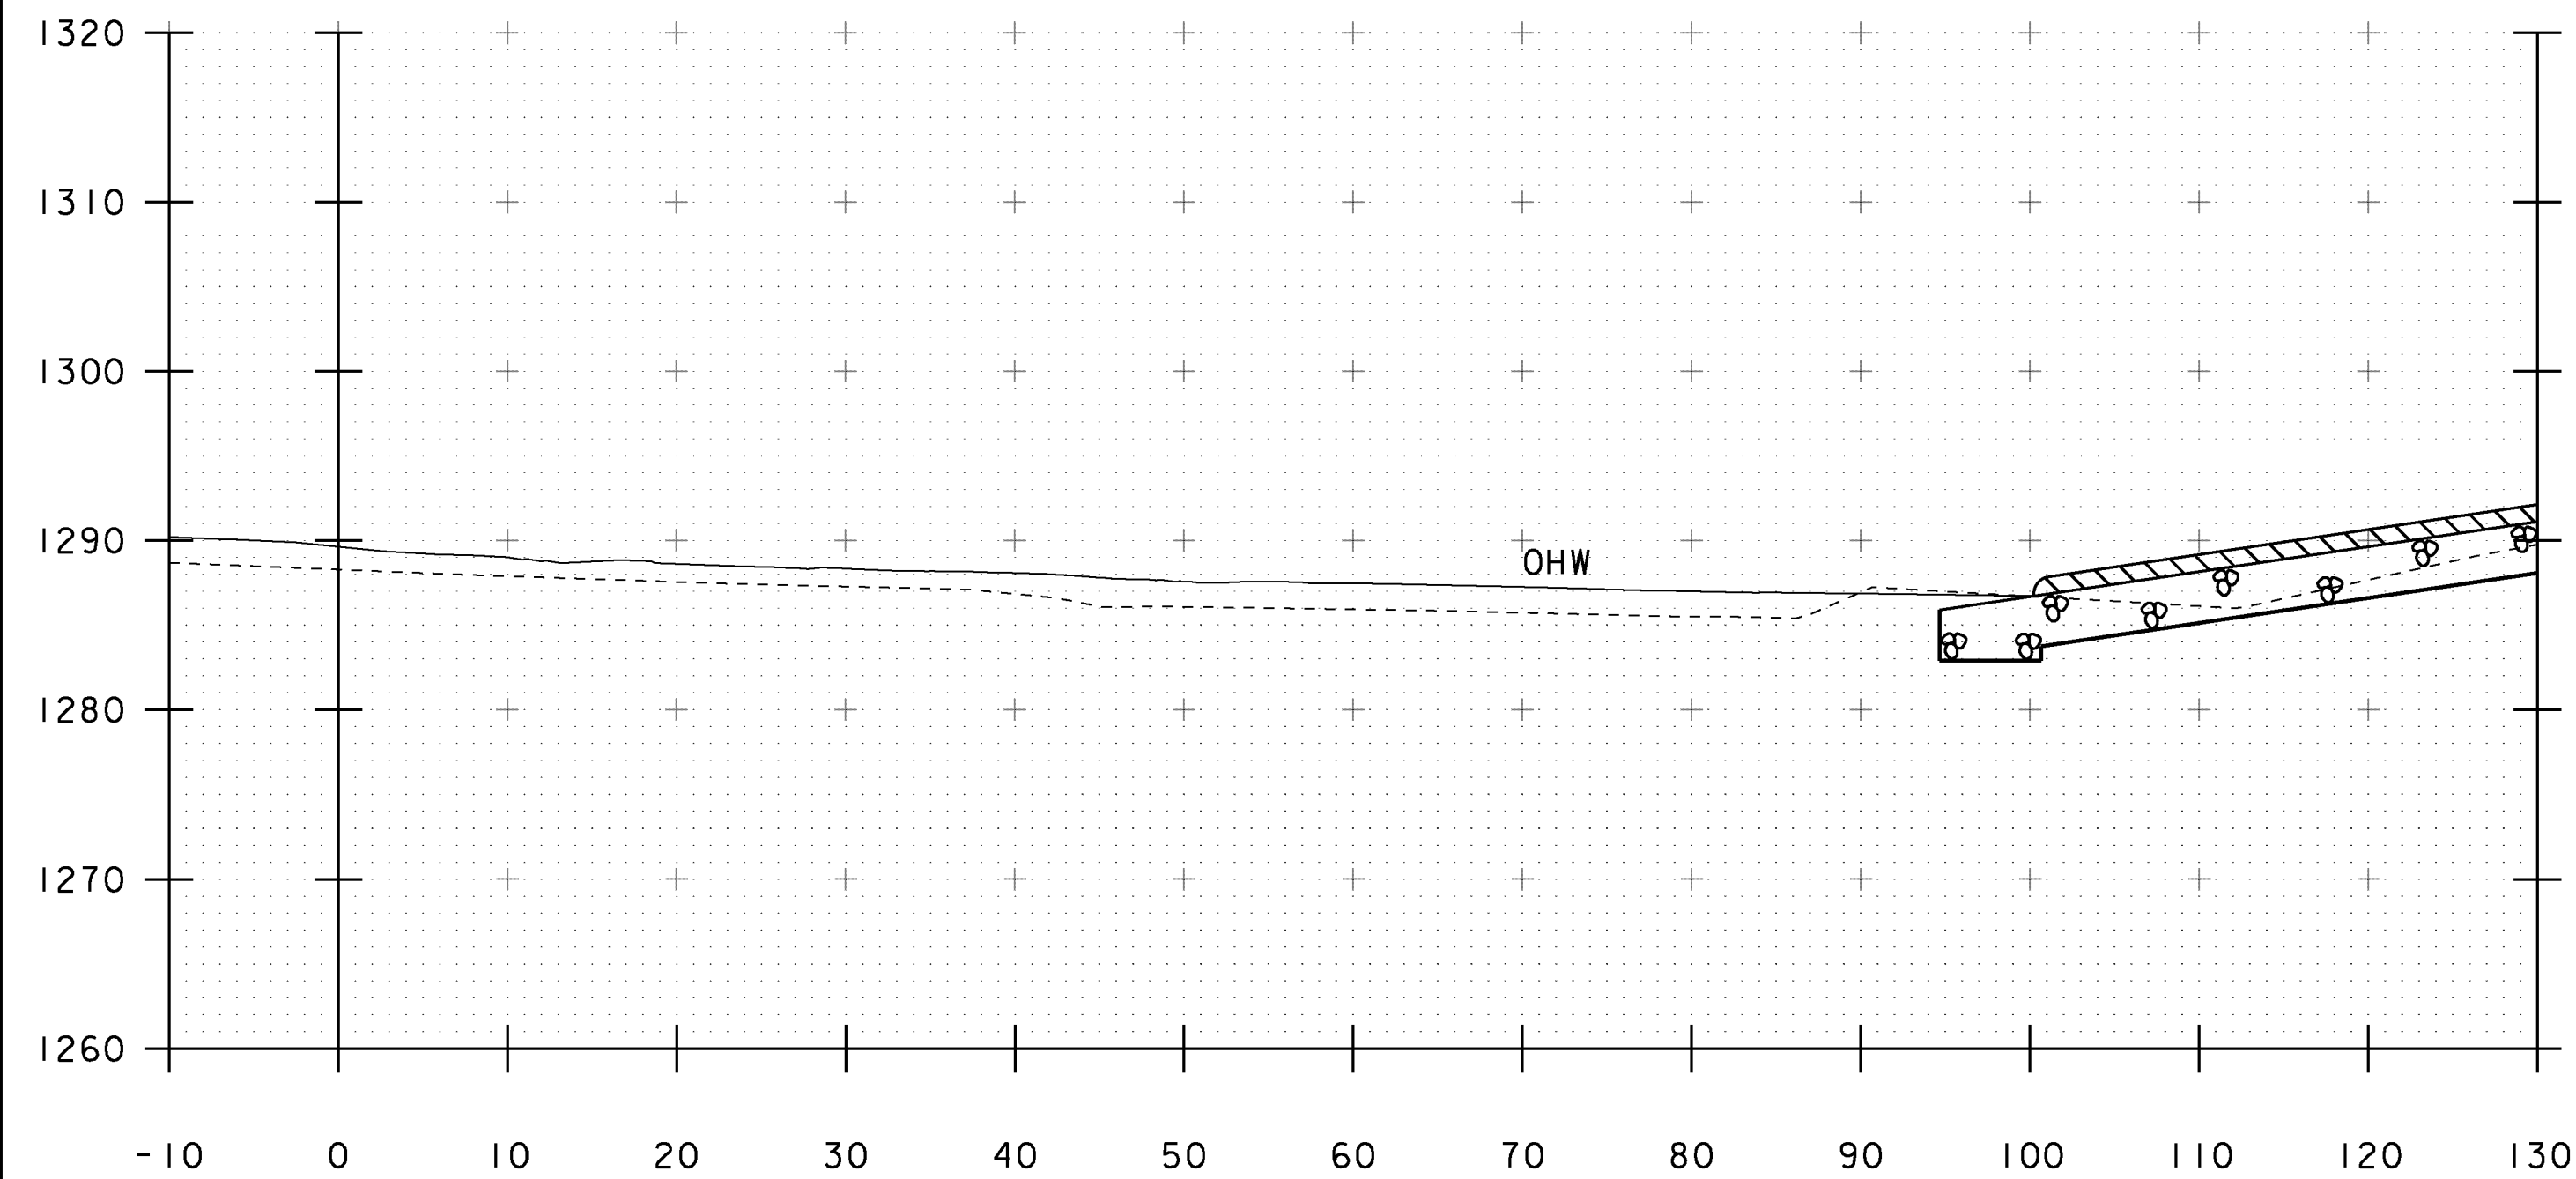

49+30

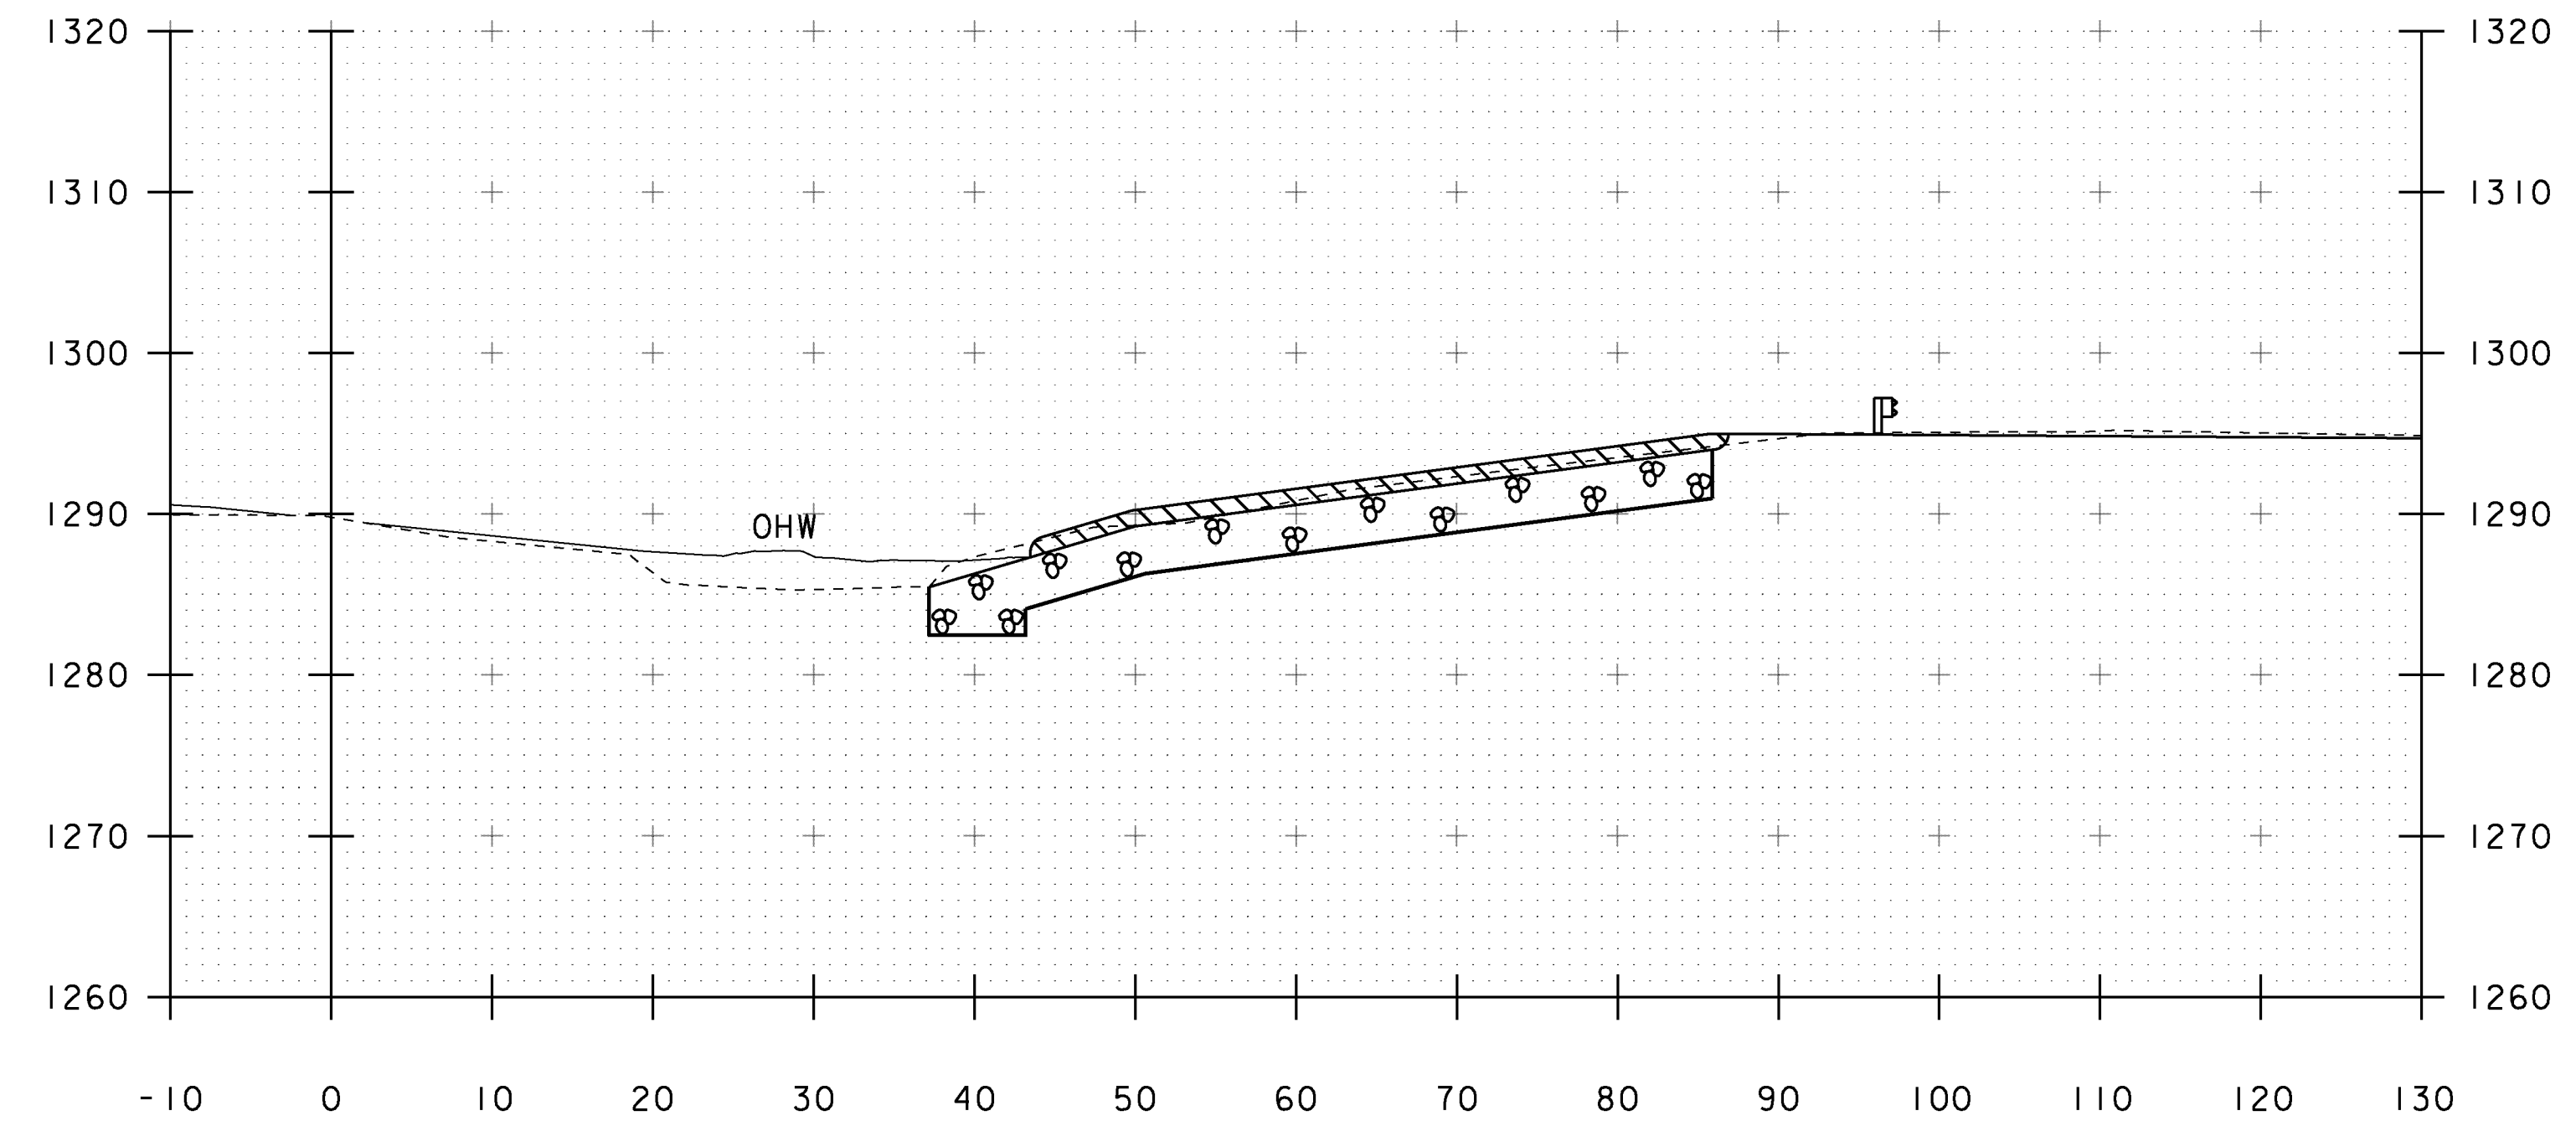

49+50

STA. 49+30 TO STA. 49+60

PROJECT NAME: MARLBORO	PLOT DATE: 28-AUG-2013
PROJECT NUMBER: BRF 010-1(43)	DRAWN BY: K. FRIEDLAND
FILE NAME: sl0b414xsl.dgn	CHECKED BY: G. LAROCHE
PROJECT LEADER: K. HIGGINS	SHEET 47 OF 50
DESIGNED BY: R. KLINEFELTER	
CHANNEL SECTIONS 2	