




49+80

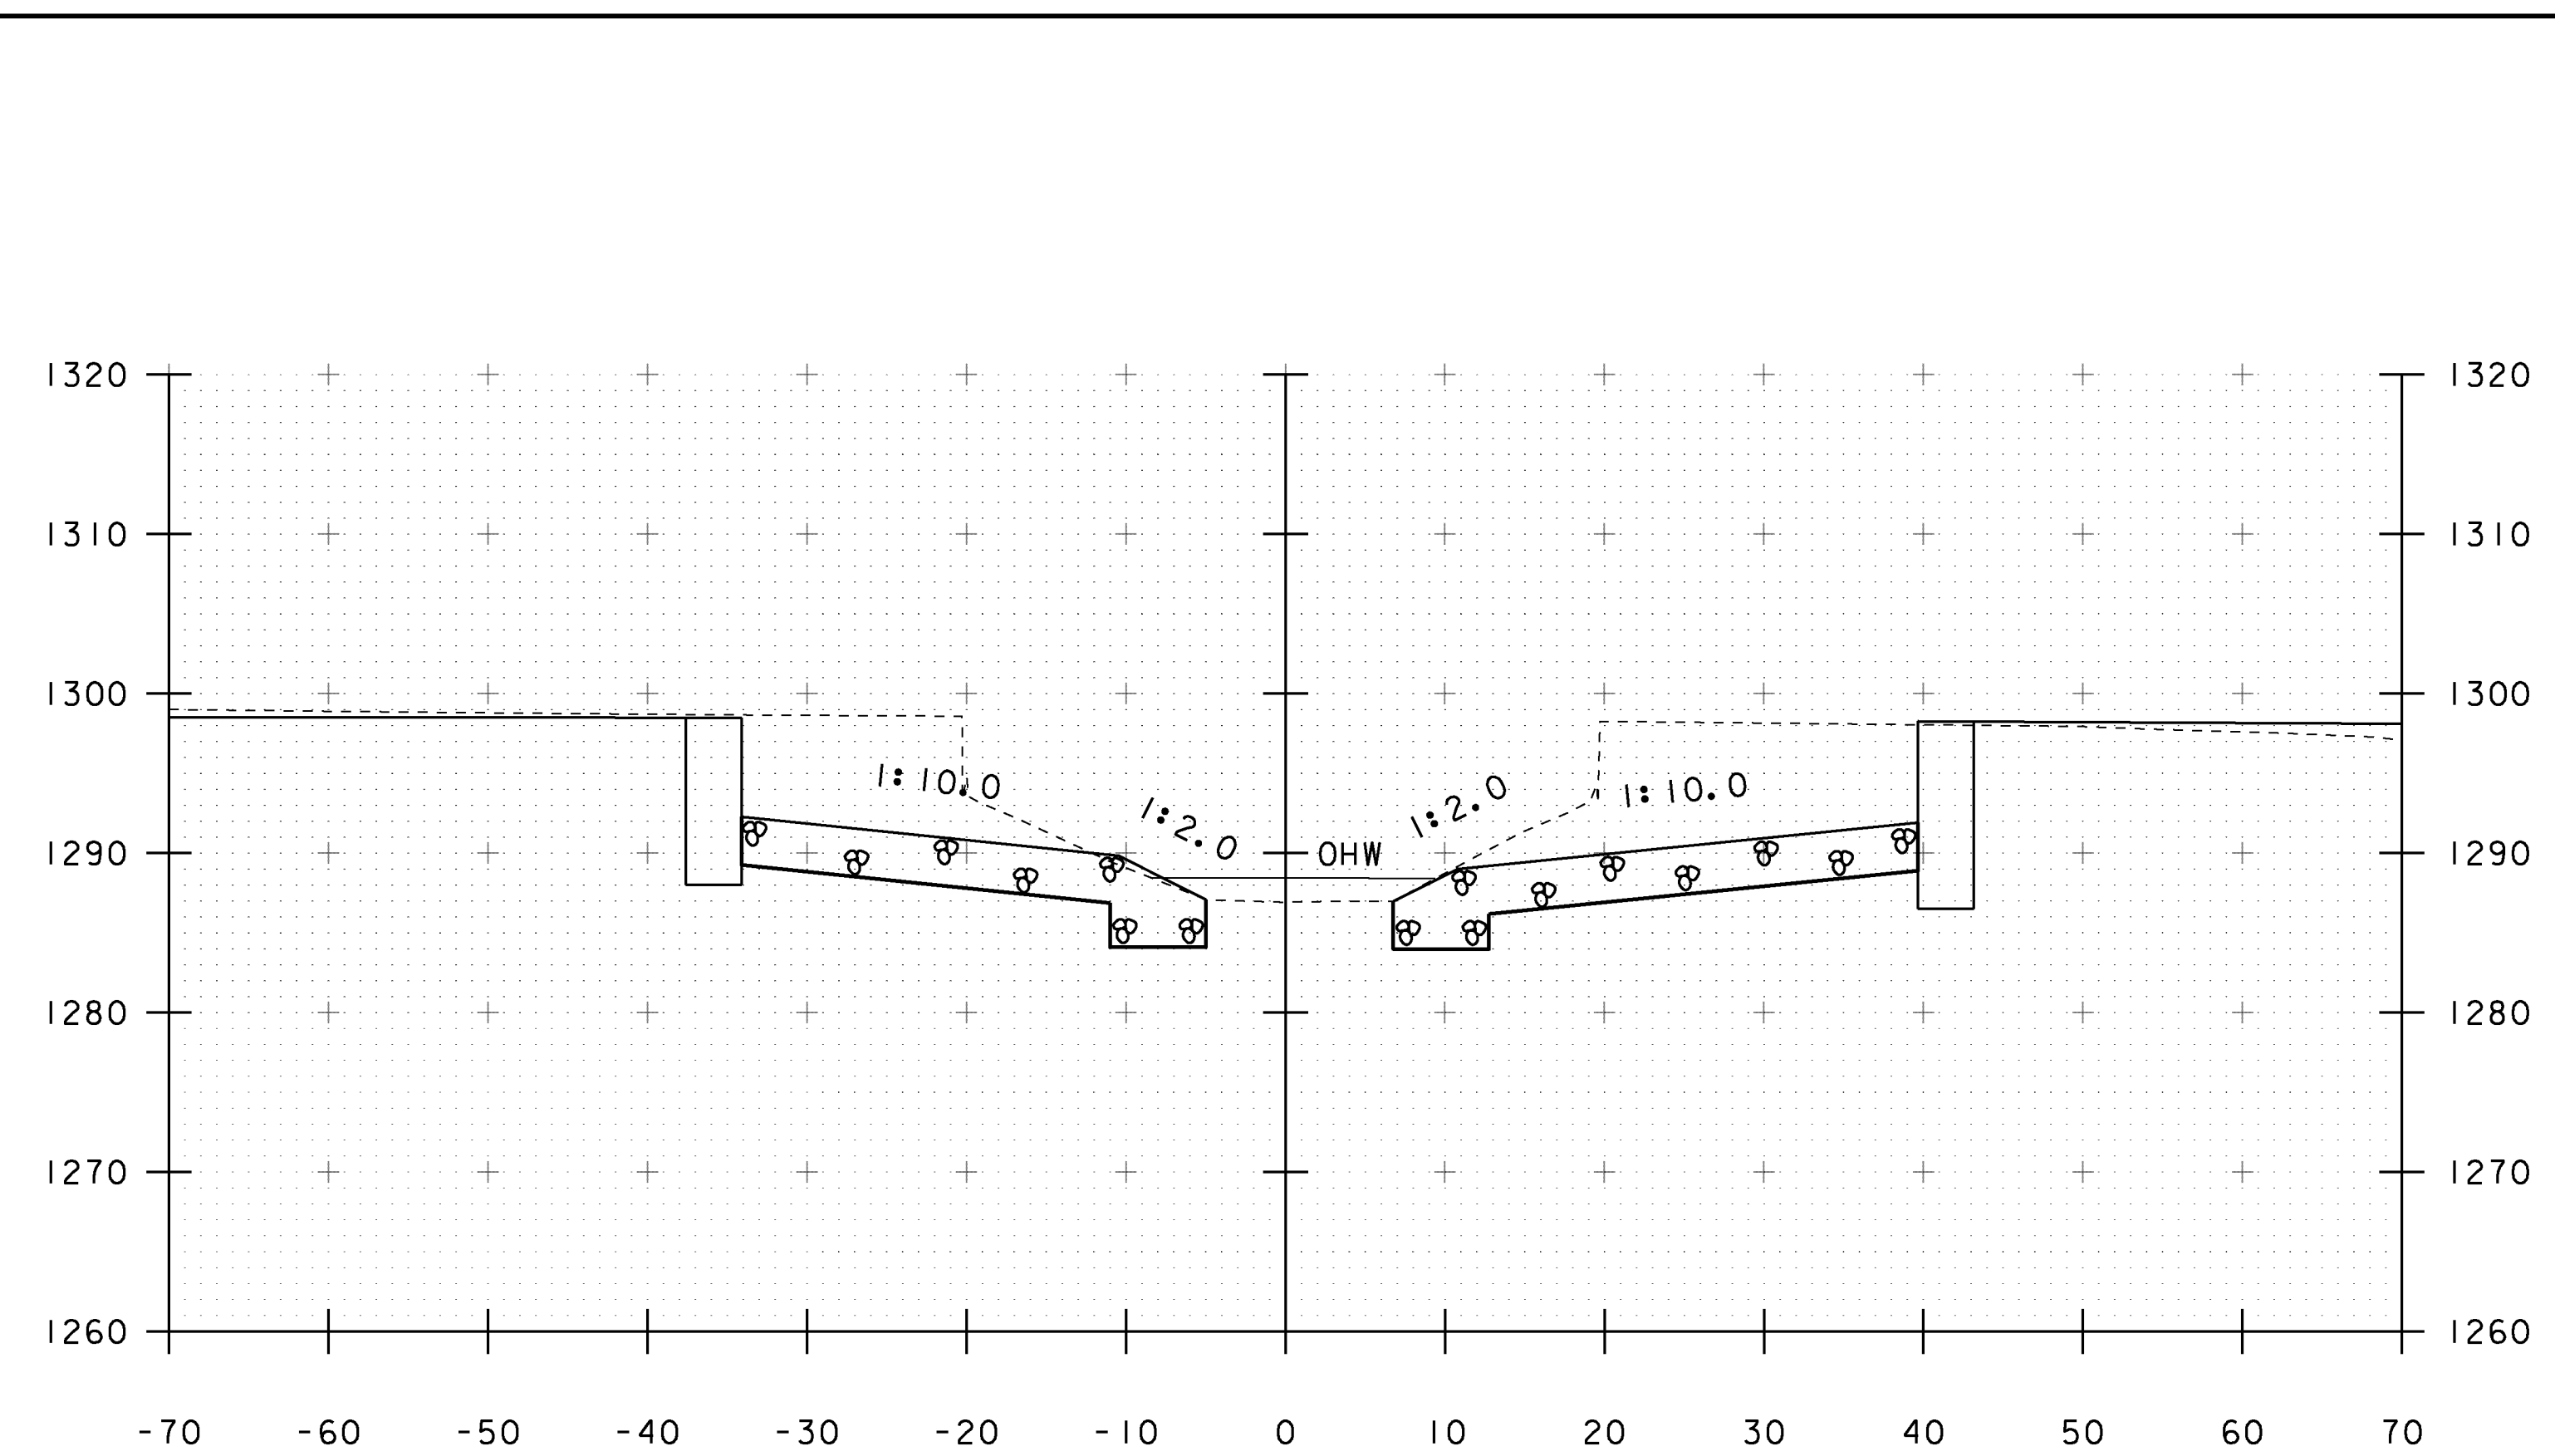

50+00

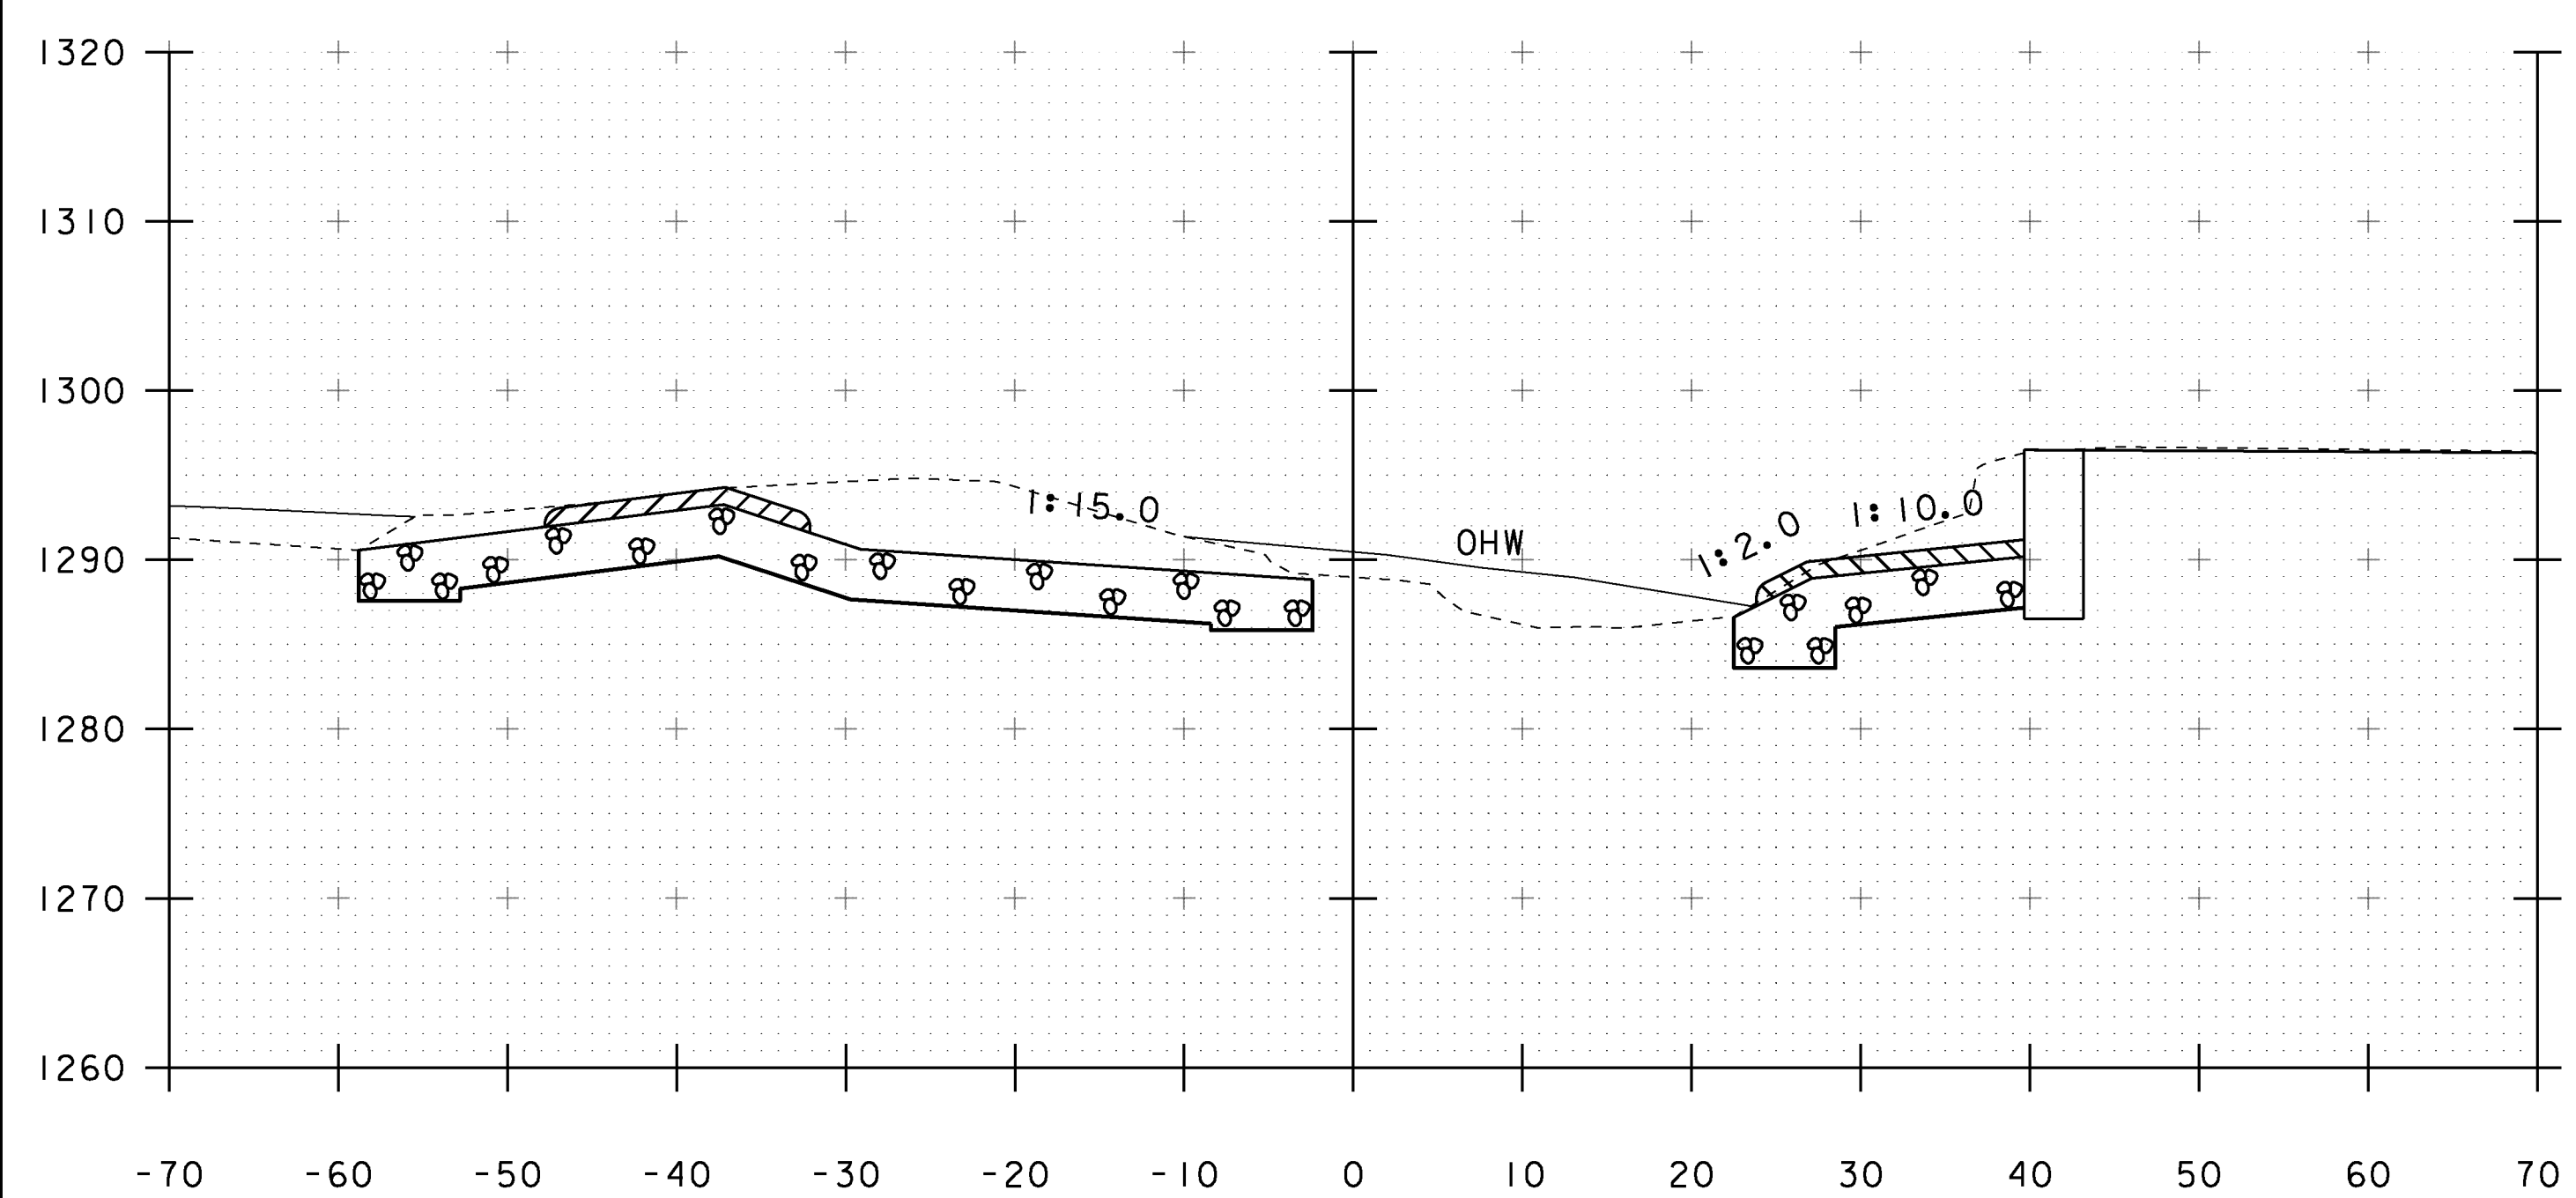

49+70

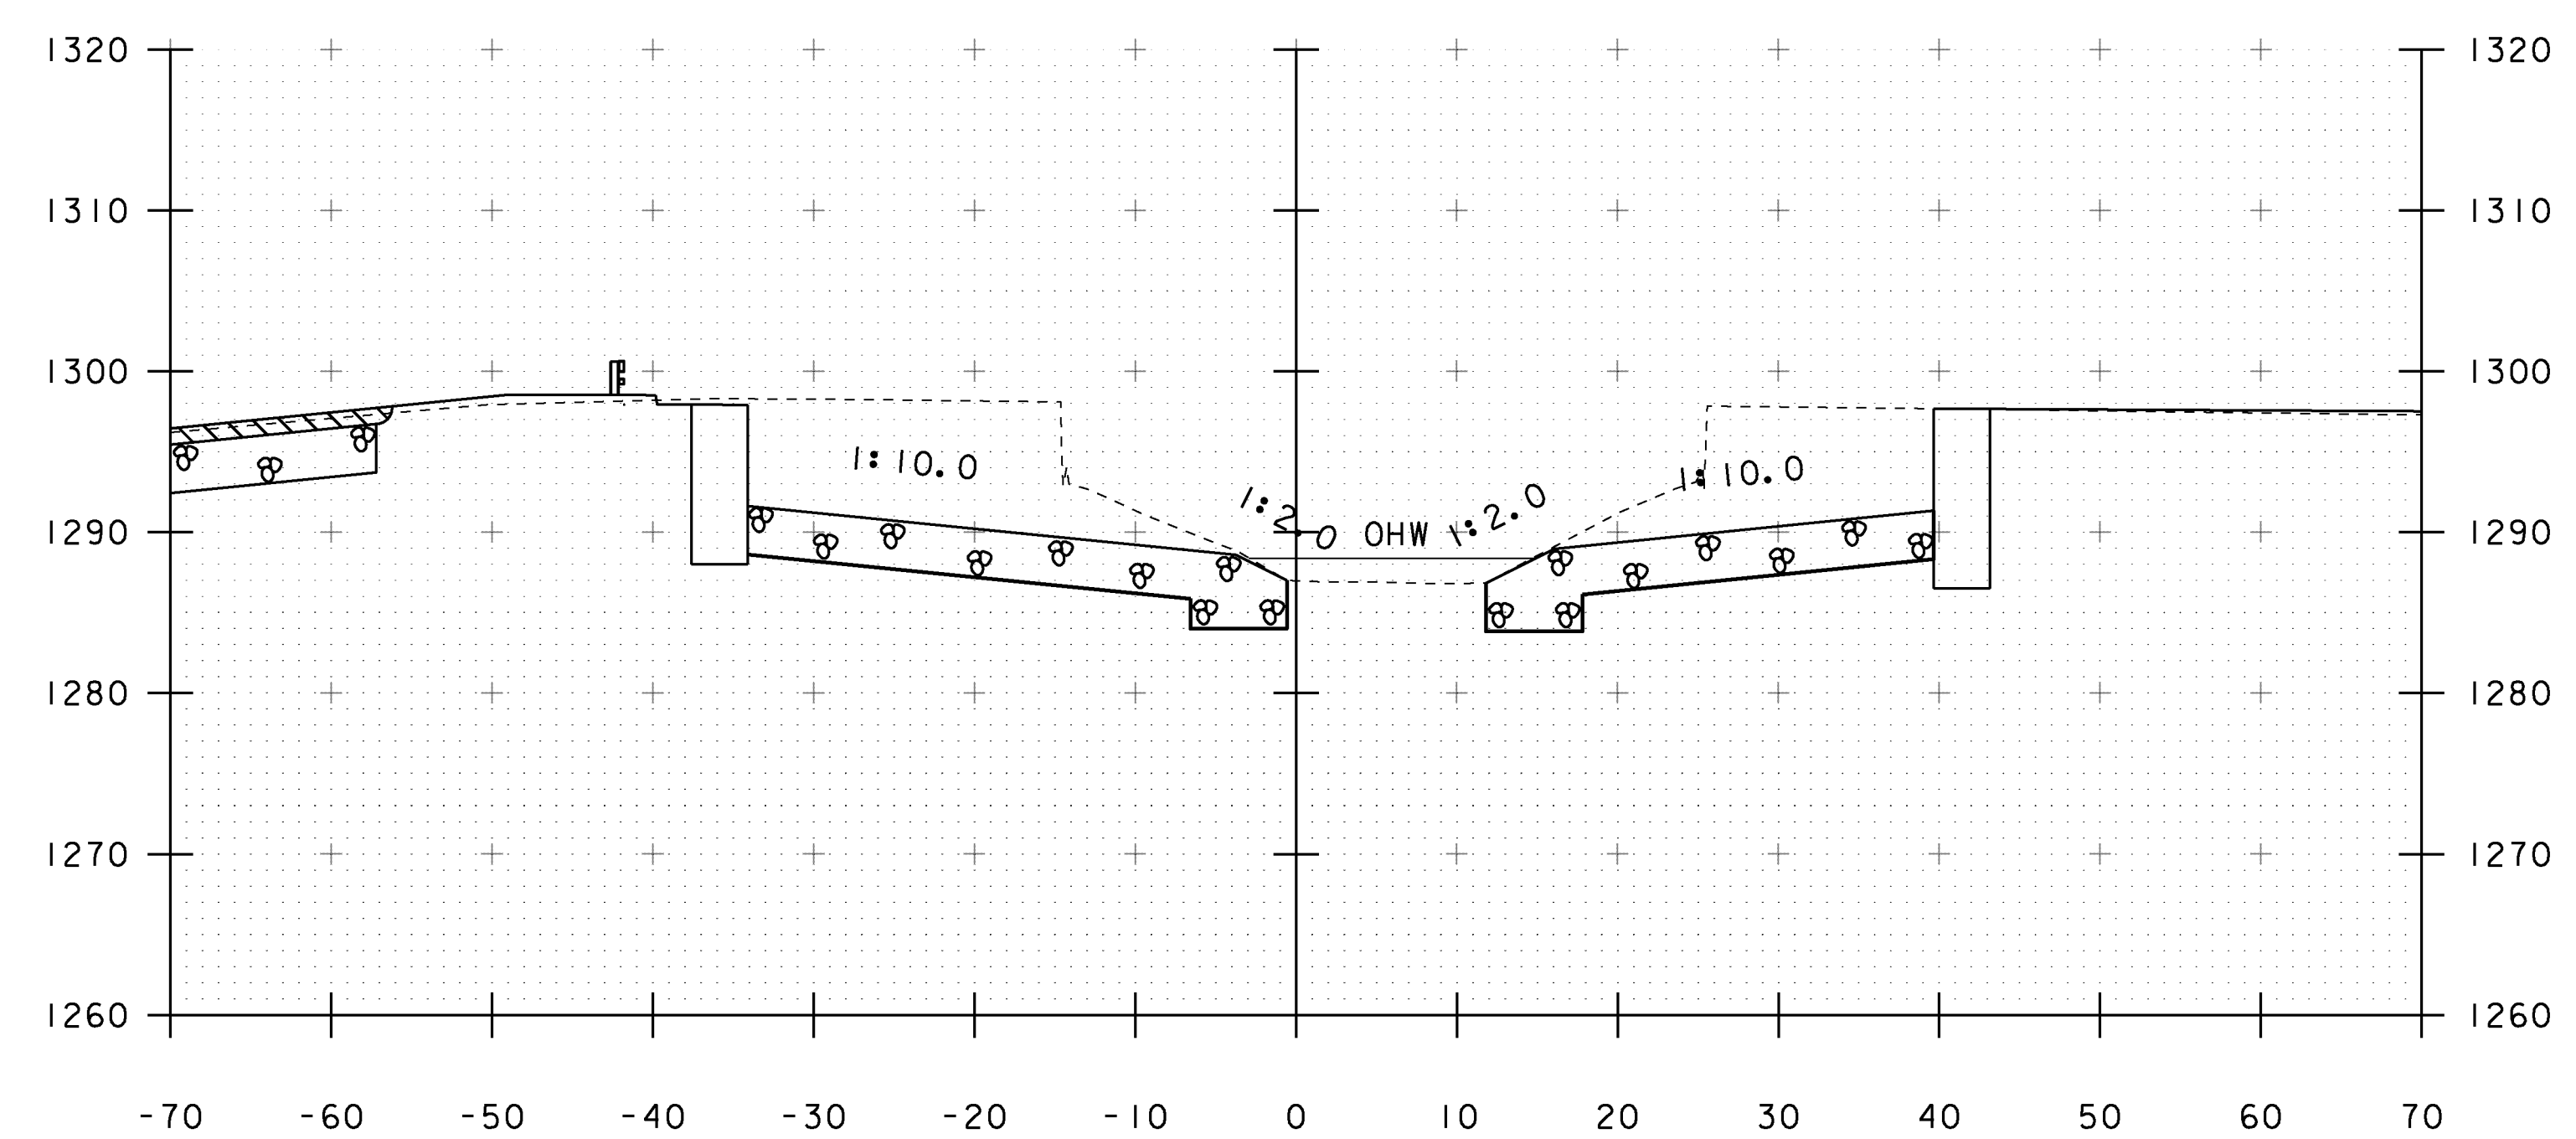

49+90

PROJECT NAME: MARLBORO	PLOT DATE: 28-AUG-2013
PROJECT NUMBER: BRF 010-1(43)	DRAWN BY: K. FRIEDLAND
FILE NAME: s10b414xsl.dgn	CHECKED BY: G. LAROCHE
PROJECT LEADER: K. HIGGINS	SHEET 48 OF 50
DESIGNED BY: R. KLINEFELTER	
CHANNEL SECTIONS 3	

STA. 49+70 TO STA. 50+00