



50+20

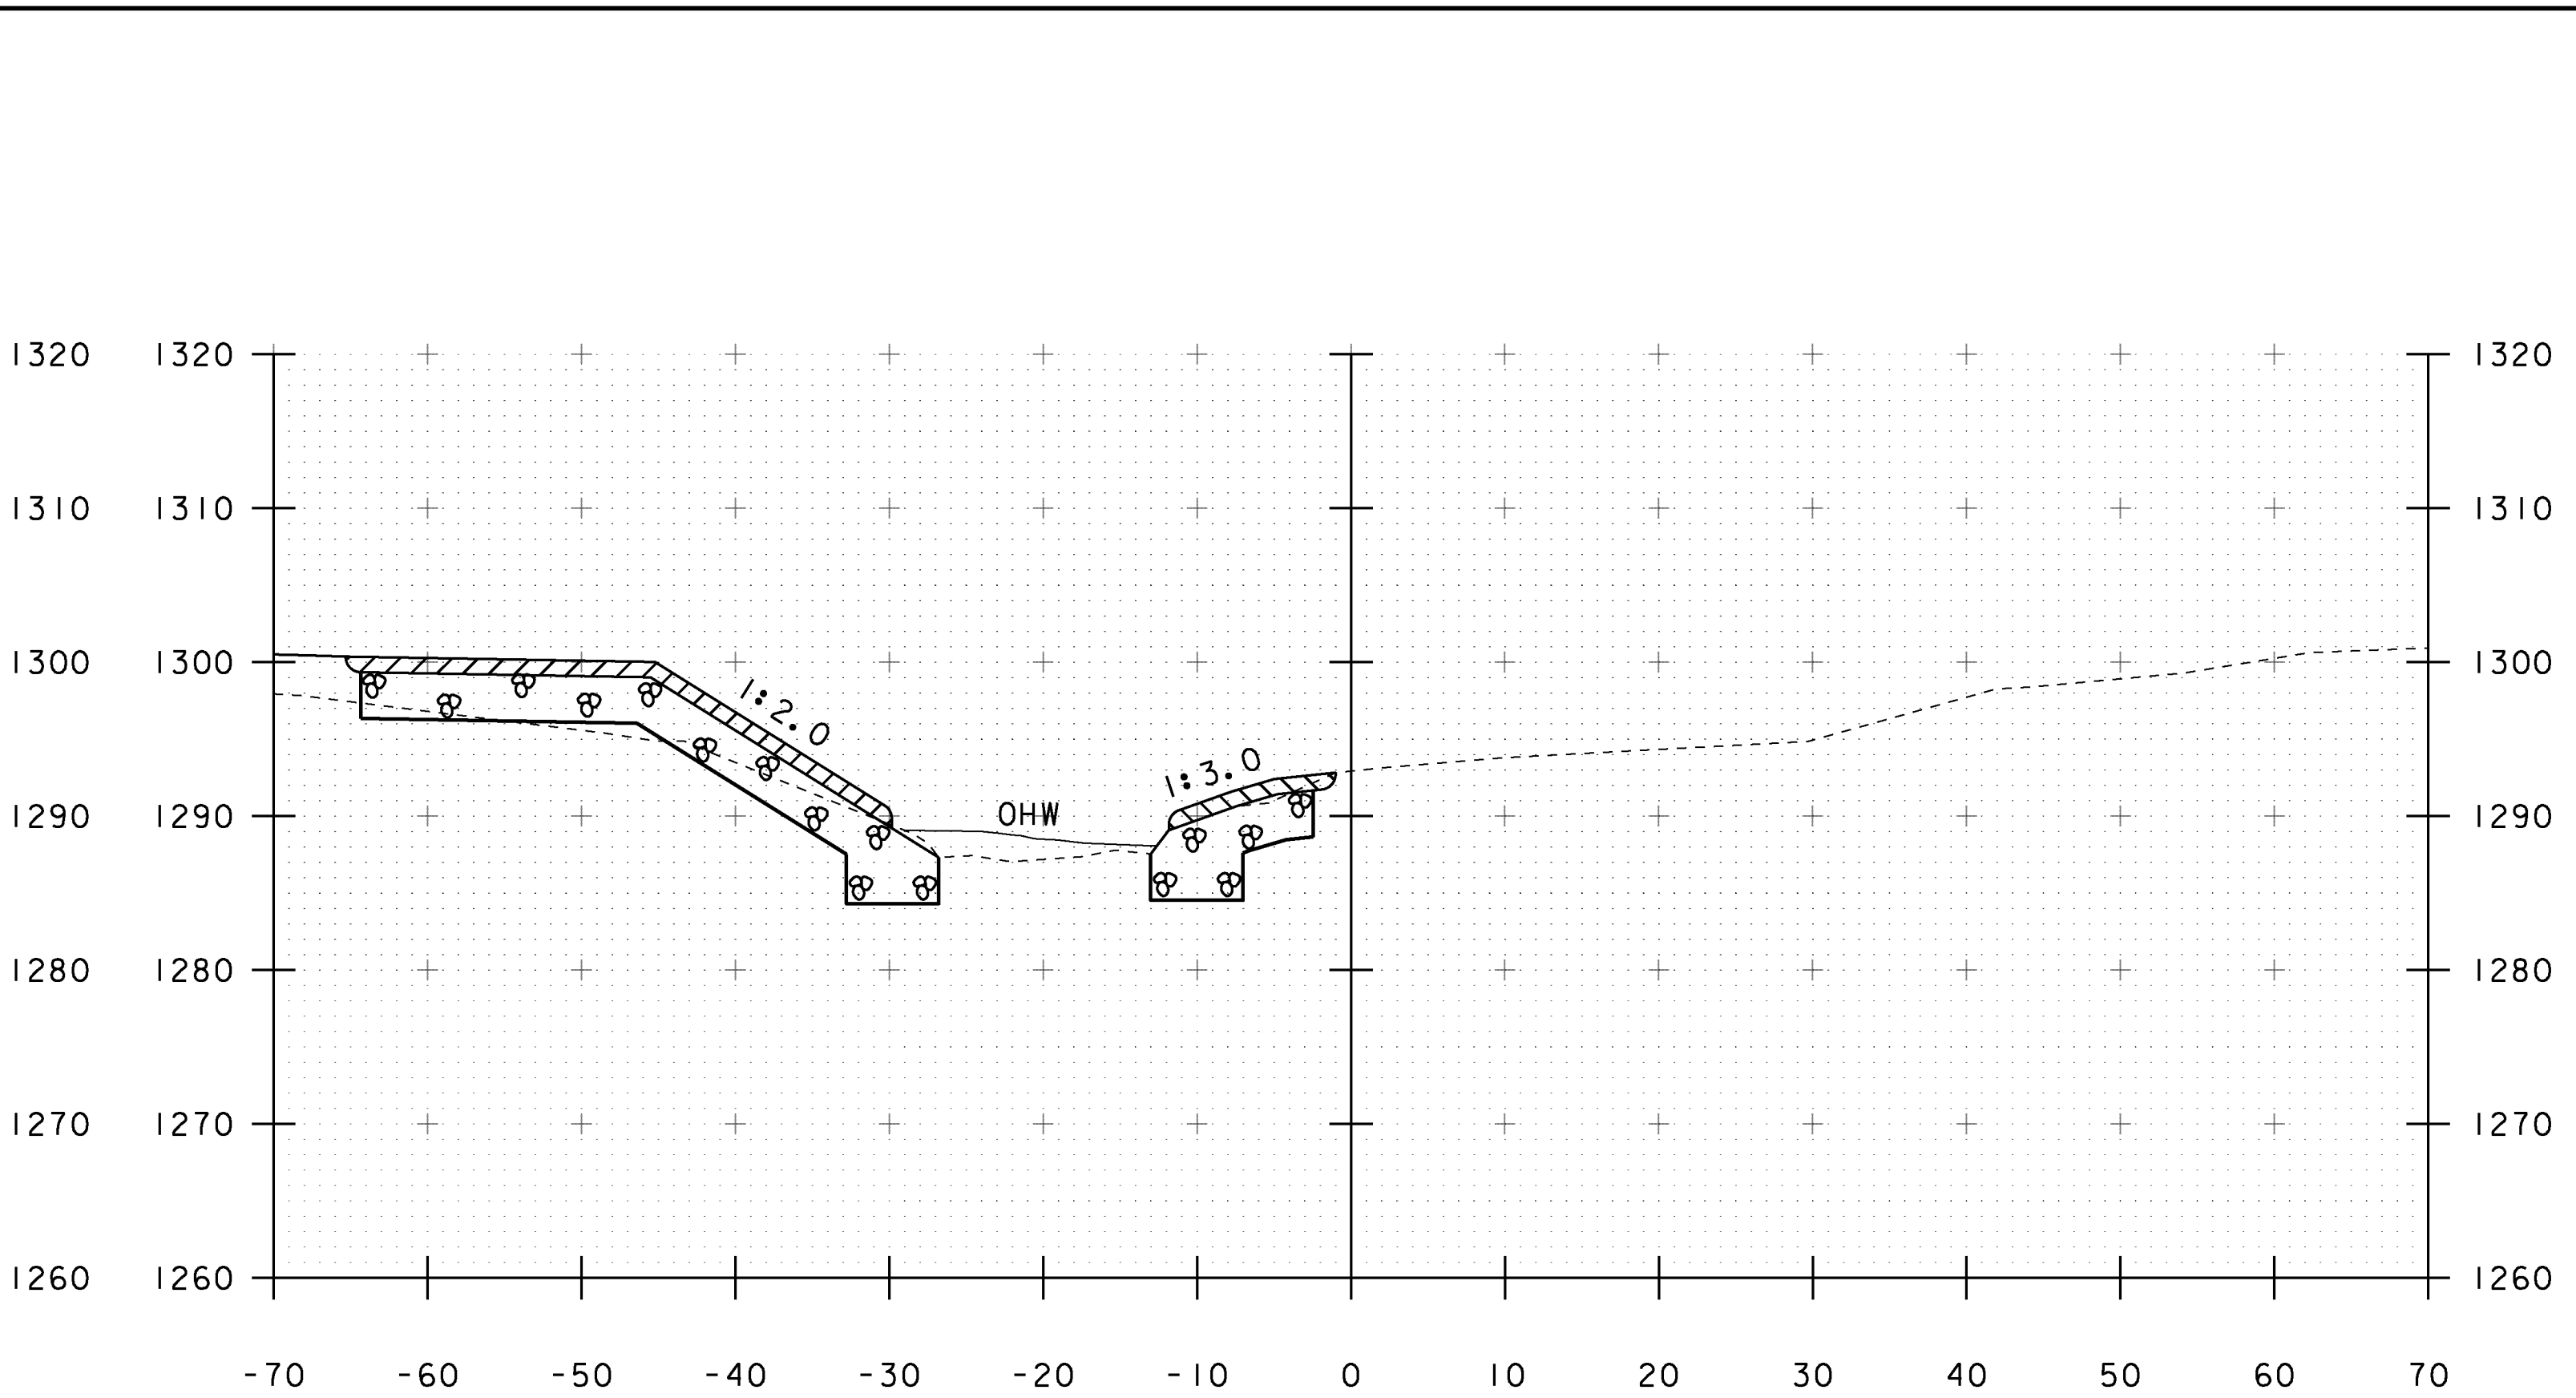


50+40

STA 50+41 LT
 END UNCLASSIFIED CHANNEL EXCAVATION
 GEOTEXTILE UNDER STONE FILL
 STONE FILL, TYPE III
 GRUBBING MATERIAL

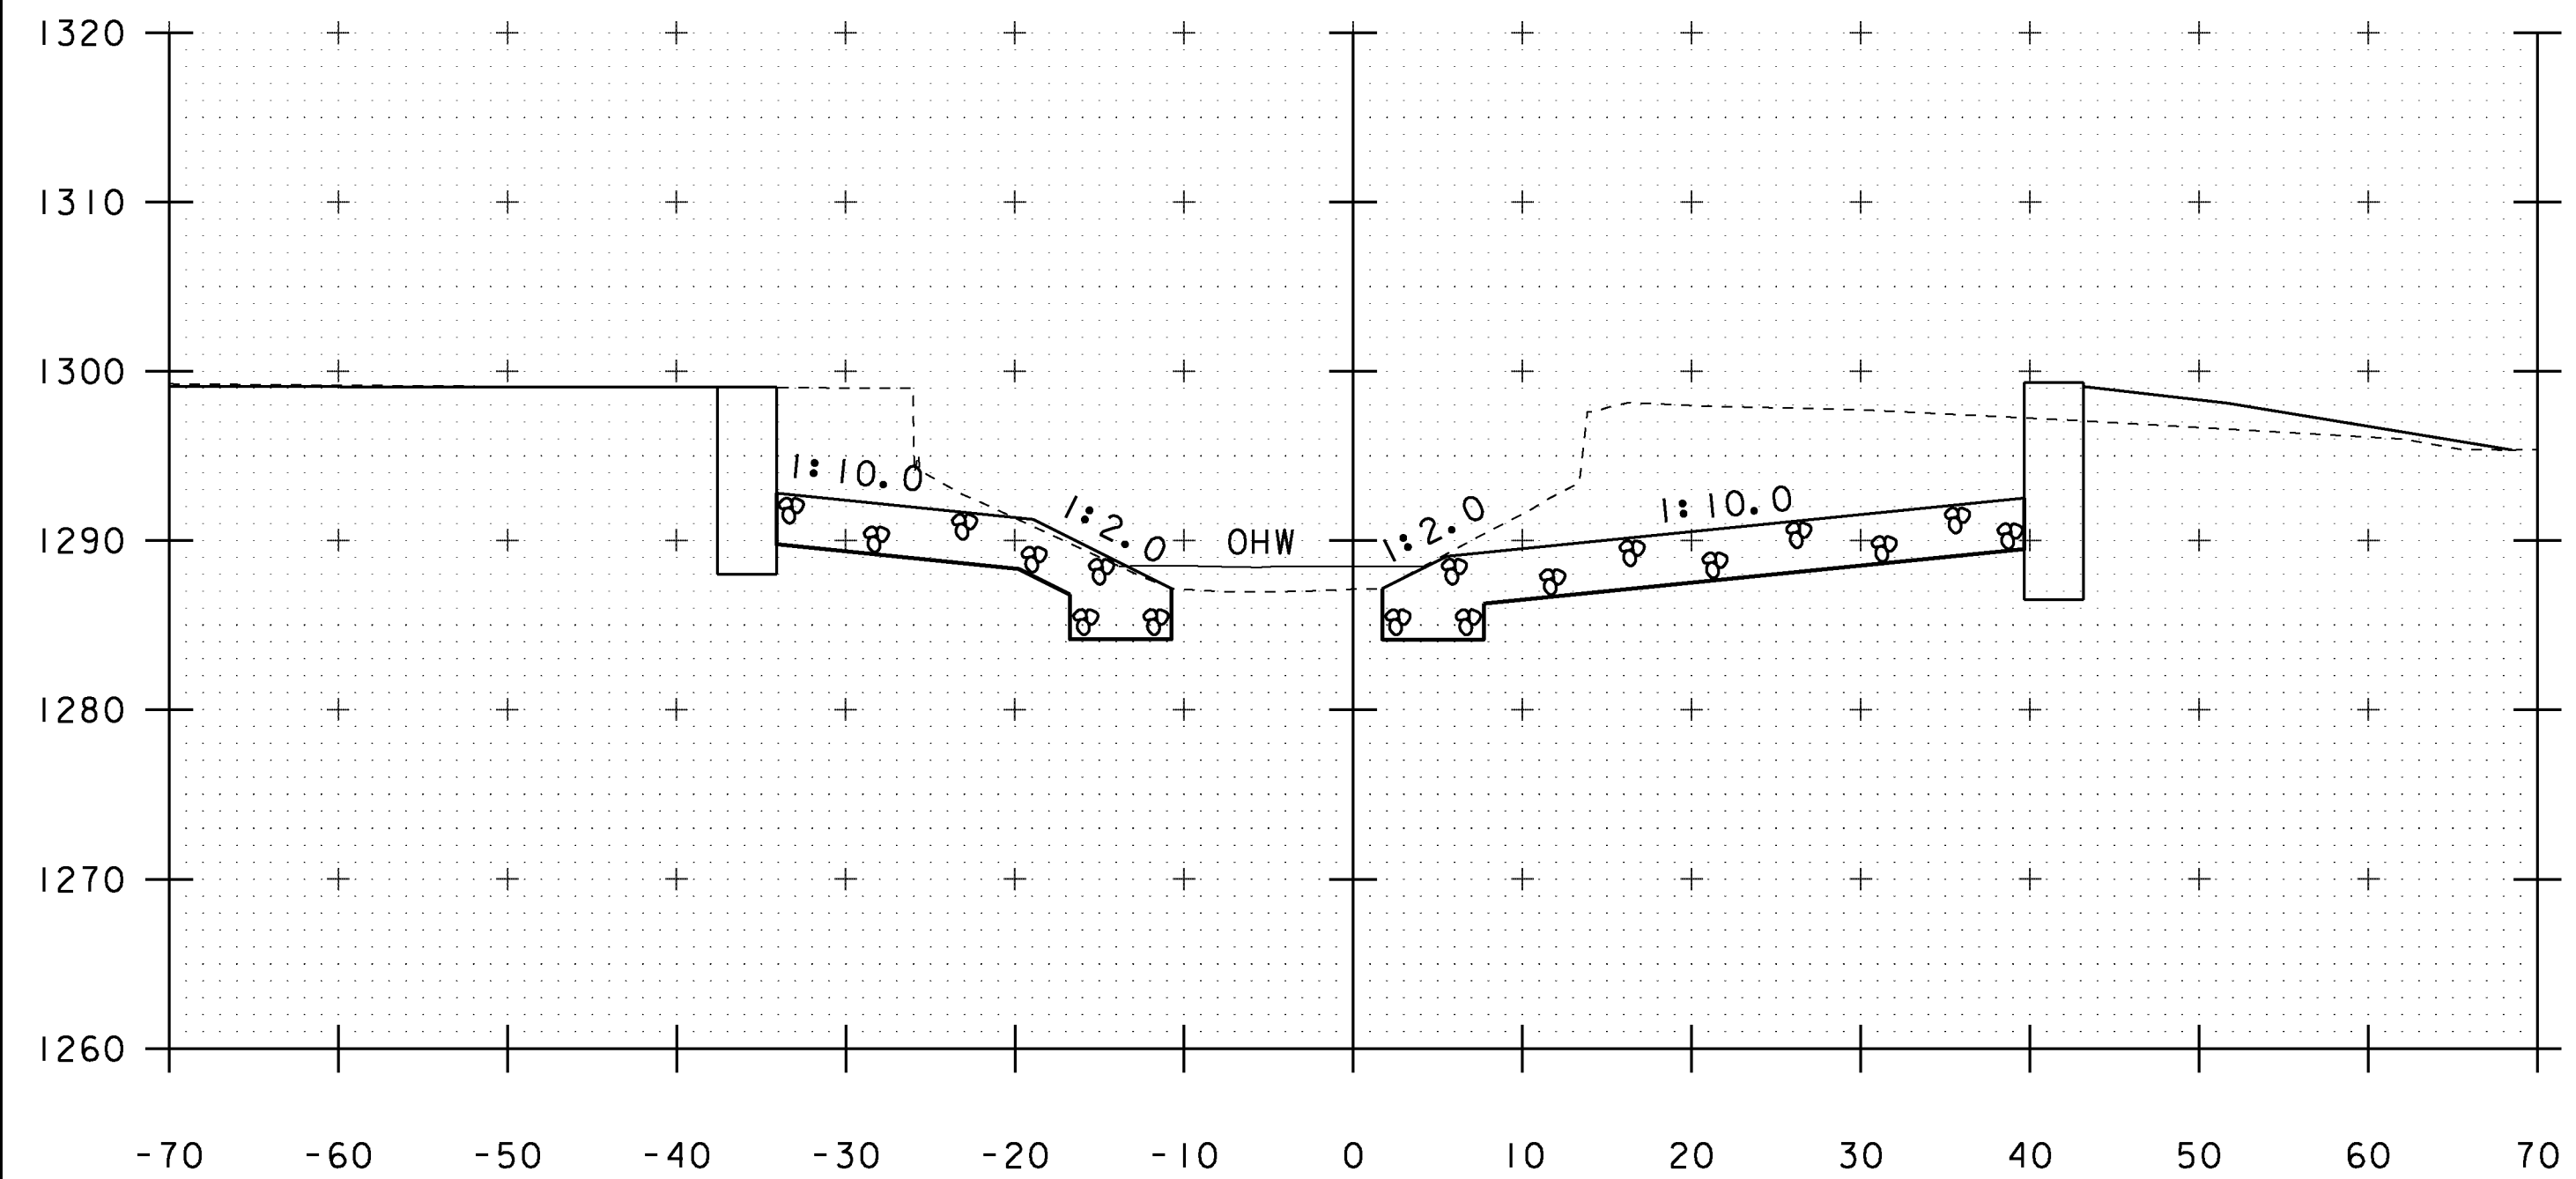

50+10

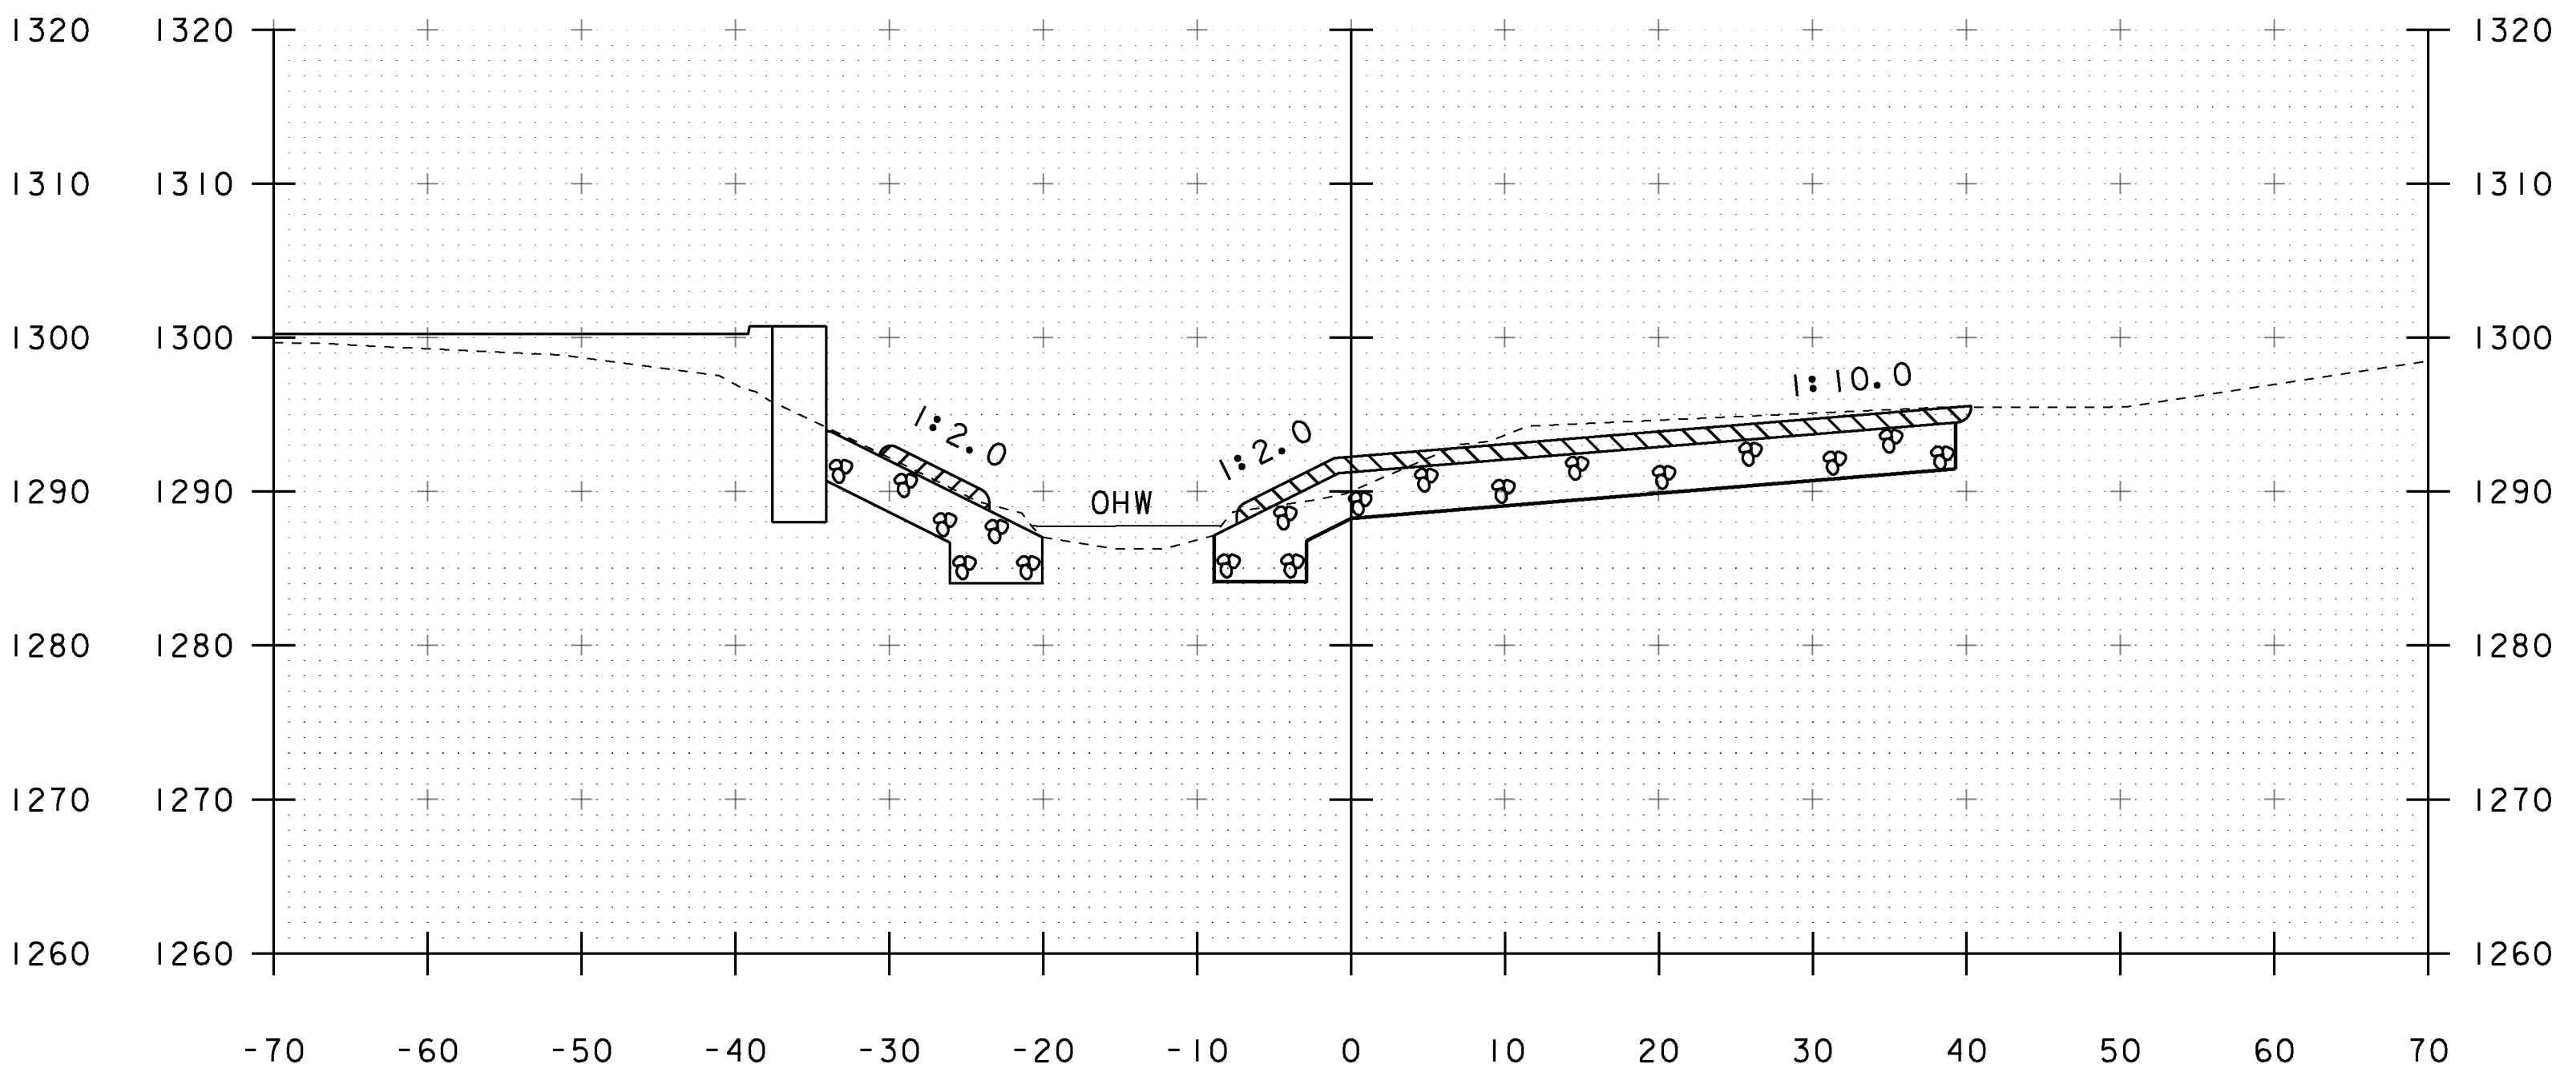

50+30

STA. 50+10 TO STA. 50+40

PROJECT NAME:	MARLBORO	PLOT DATE:	28-AUG-2013
PROJECT NUMBER:	BRF 010-1(43)	DRAWN BY:	K. FRIEDLAND
FILE NAME:	sl0b414xsl.dgn	DESIGNED BY:	R. KLINEFELTER
PROJECT LEADER:	K. HIGGINS	CHECKED BY:	G. LAROCHE
CHANNEL SECTIONS:	4	SHEET:	49 OF 50