


STA 50+57 FAR LT
 END UNCLASSIFIED CHANNEL EXCAVATION
 GEOTEXTILE UNDER STONE FILL
 STONE FILL, TYPE III
 GRUBBING MATERIAL

50+60

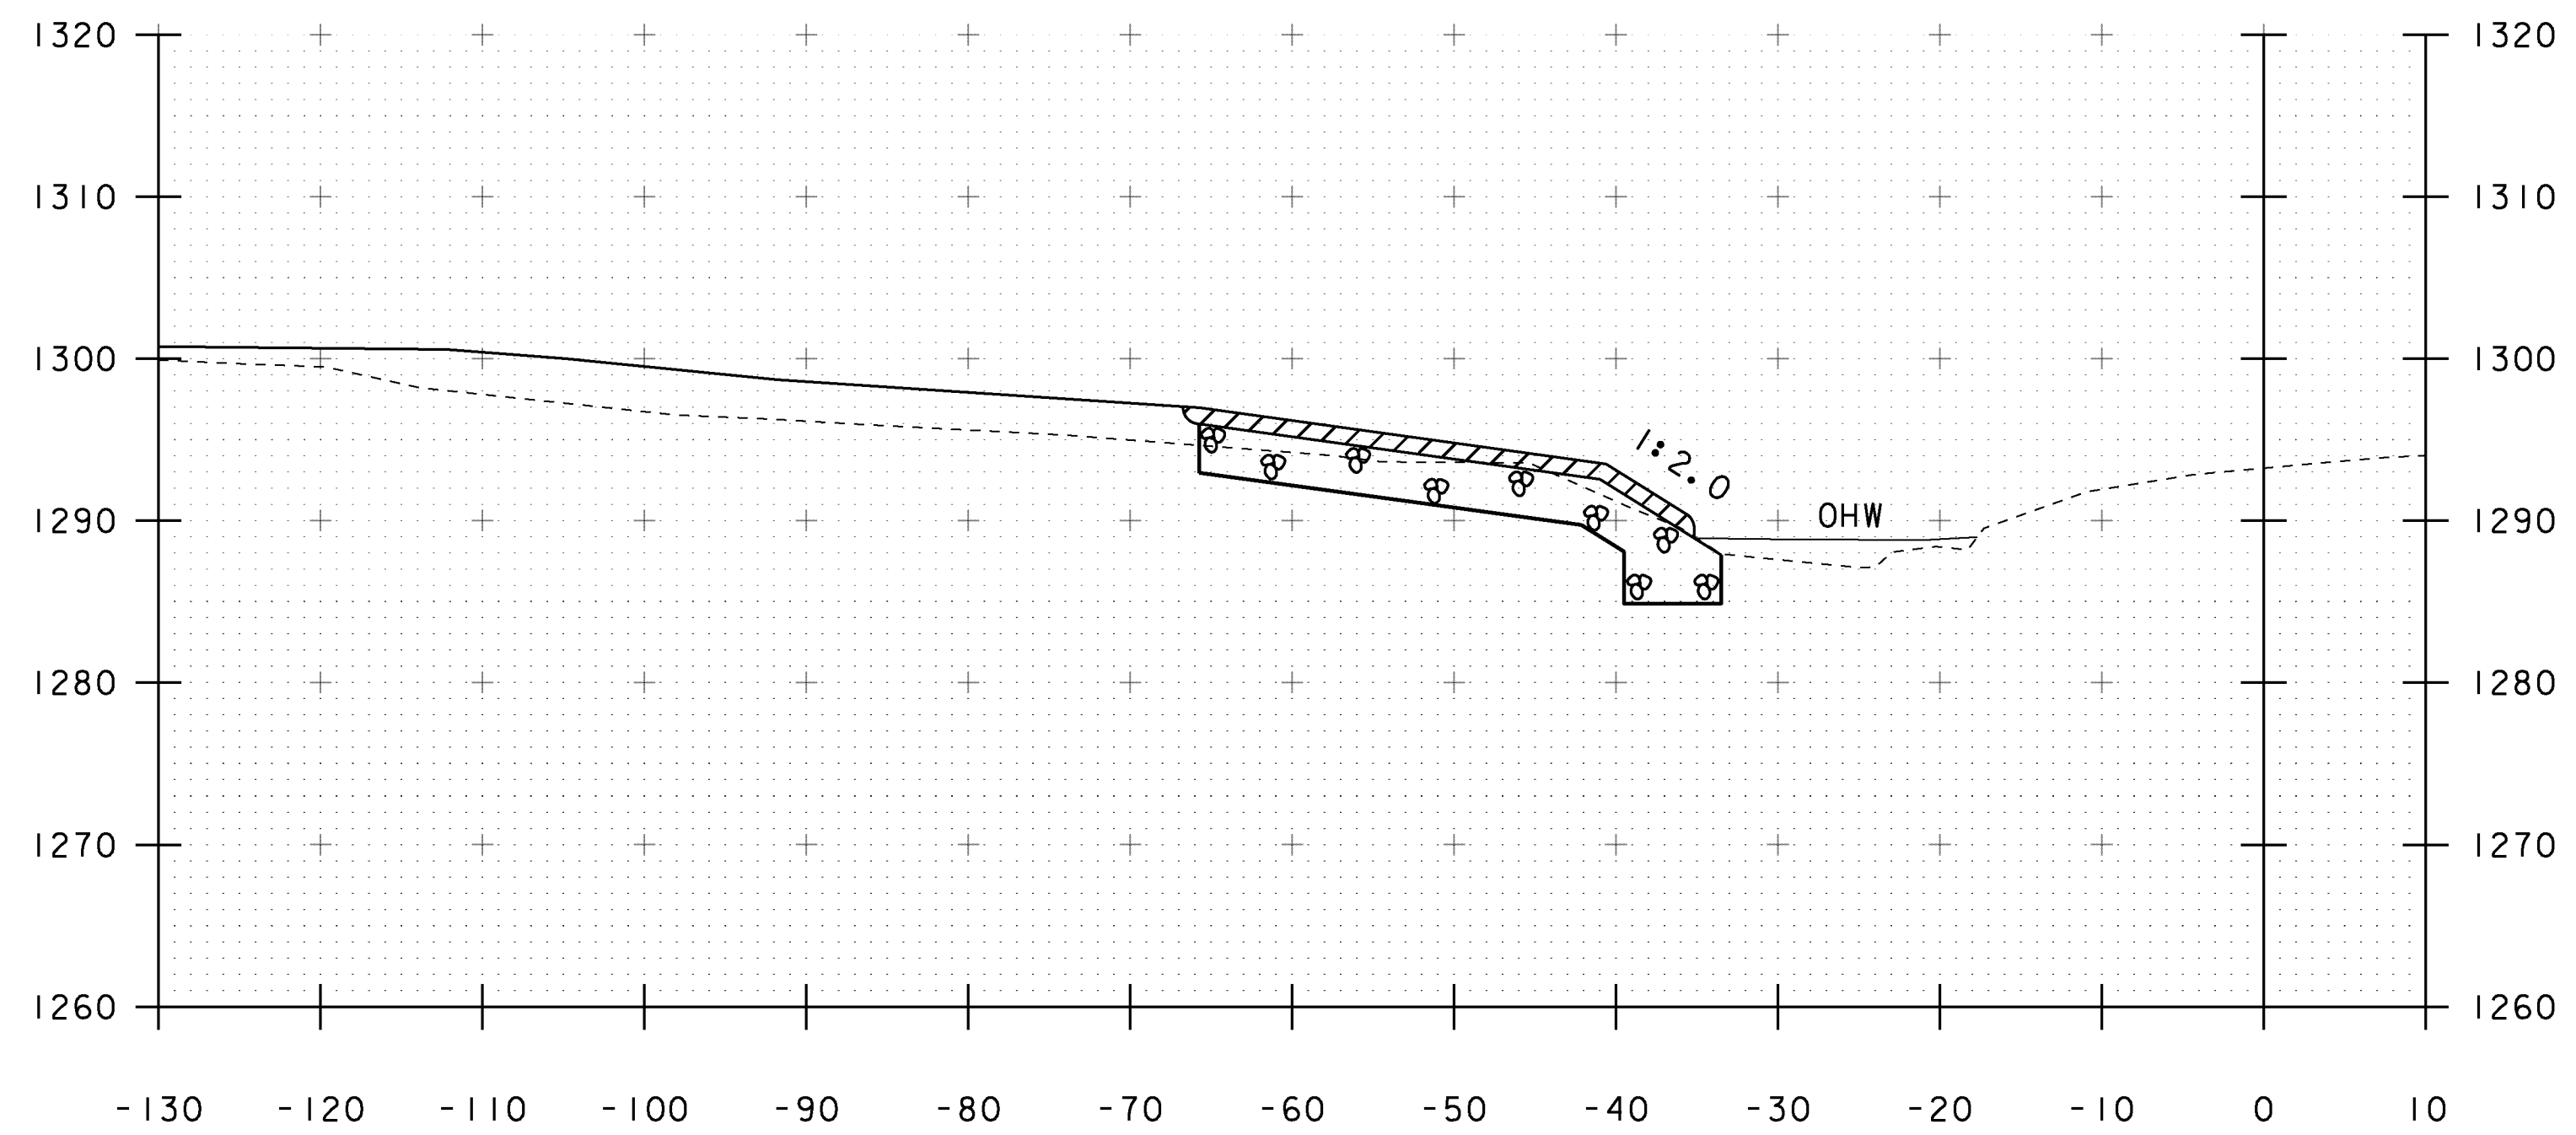

50+50

PROJECT NAME: MARLBORO	PLOT DATE: 28-AUG-2013
PROJECT NUMBER: BRF 010-1(43)	DRAWN BY: K. FRIEDLAND
FILE NAME: sl0b414xsl.dgn	CHECKED BY: G. LAROCHE
PROJECT LEADER: K. HIGGINS	SHEET 50 OF 50
DESIGNED BY: R. KLINEFELTER	
CHANNEL SECTIONS 5	

STA. 50+50 TO STA. 50+60