



STATE OF VERMONT AGENCY OF TRANSPORTATION

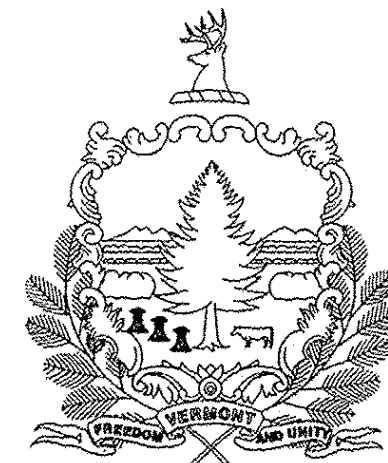

PROPOSED IMPROVEMENT BRIDGE PROJECT

TOWN OF WARREN
COUNTY OF WASHINGTON

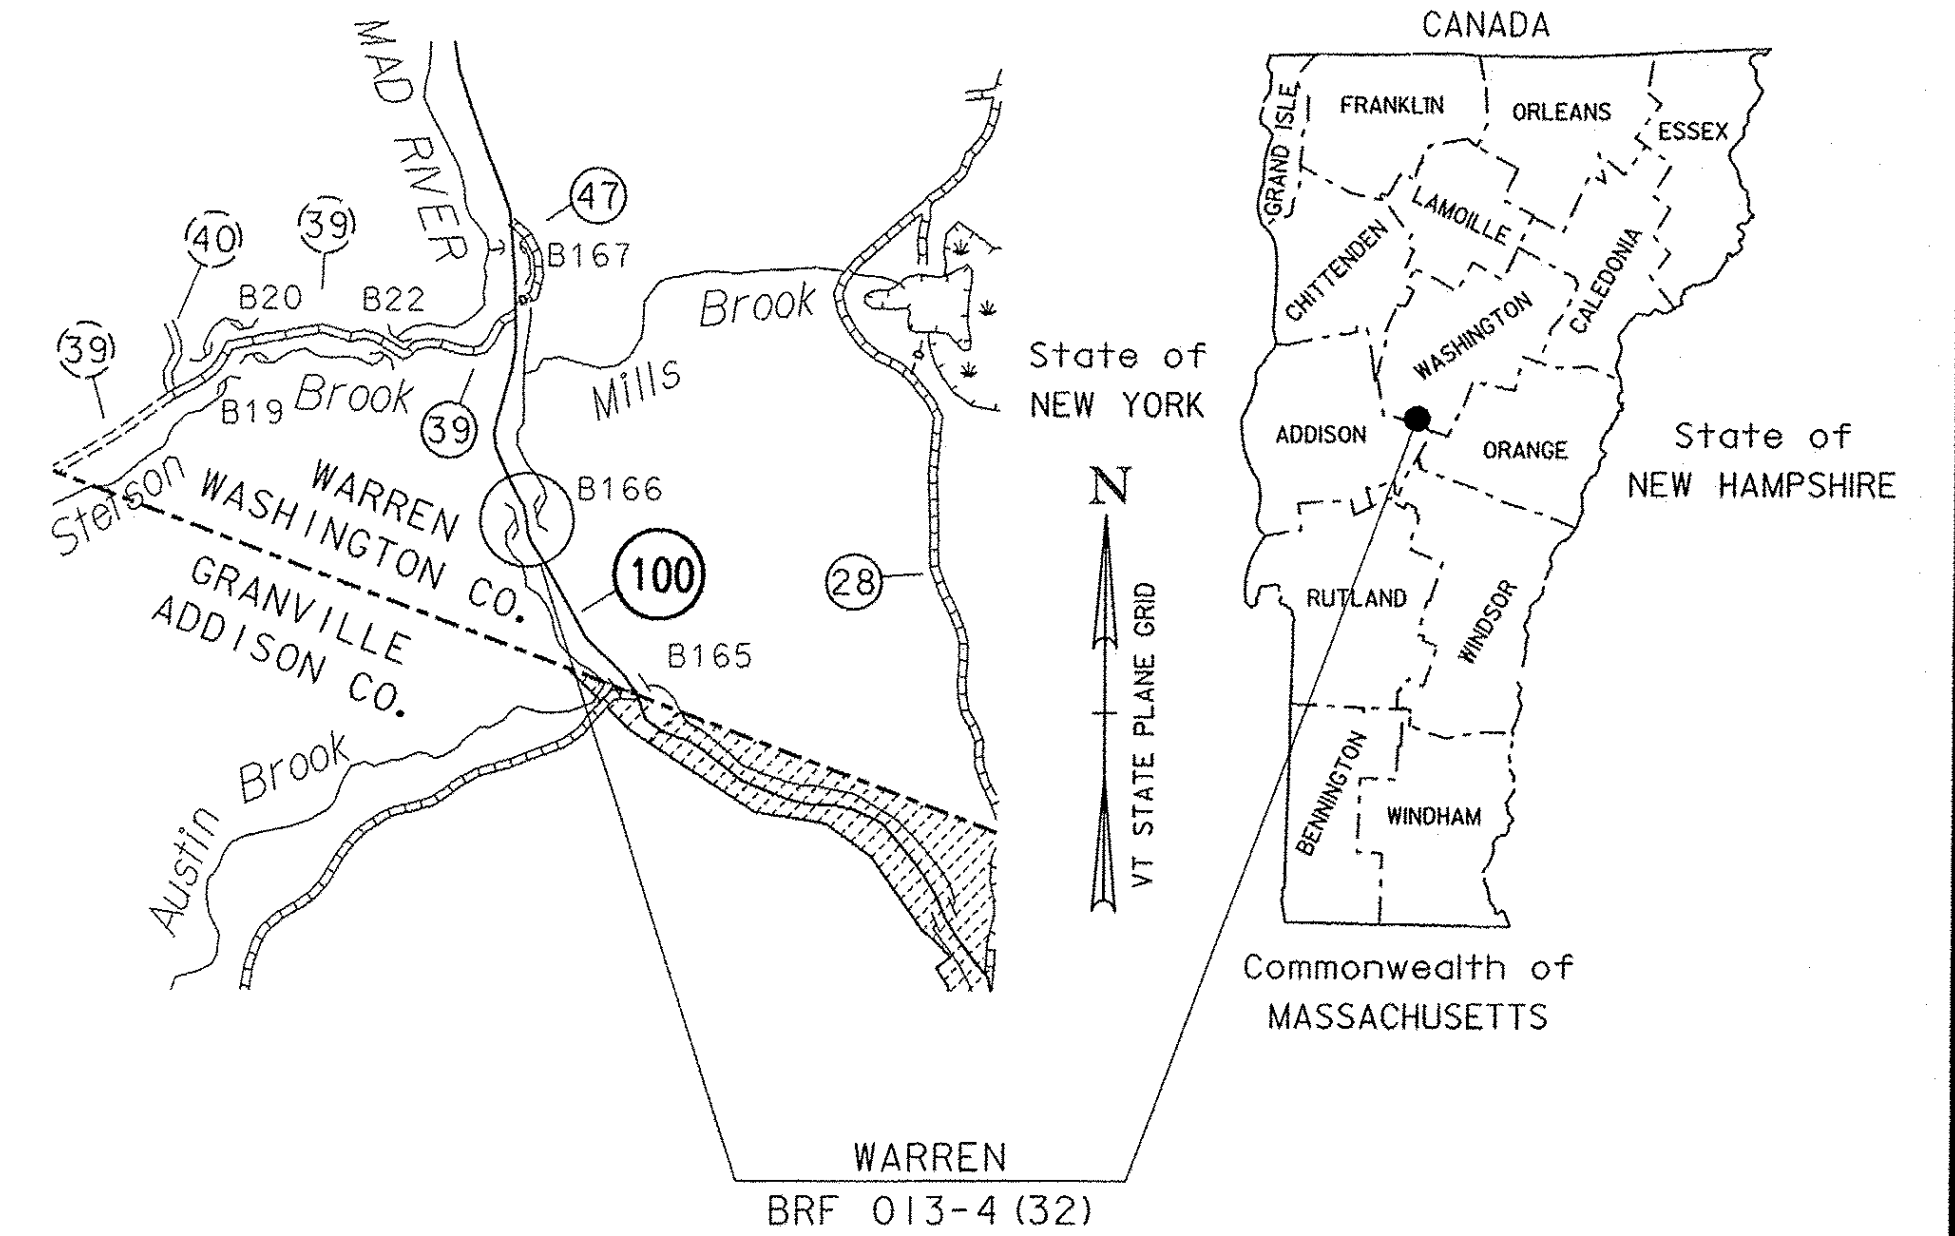


RECORD PLANS	
CONTRACTOR:	LUCK BROTHERS, INC. - PLATTSBURGH, NY
RESIDENT ENGINEER:	RICK HALE
CONSTRUCTION BEGAN:	APRIL 30, 2014
CONSTRUCTION COMPLETE:	SEPTEMBER 11, 2014
RECORD PLANS BY:	RICK HALE & KEVIN KING
I HEREBY CERTIFY THAT ALL THE CONSTRUCTION REQUIRED BY THIS SET OF DRAWINGS HAS BEEN ACCOMPLISHED AS INDICATED HEREIN.	
BY <u>Chad Hale</u>	RESIDENT ENGINEER
DATE <u>2/15/16</u>	
NOTE: Any further information concerning final quantities, amounts or other details relative to this project may be found at Central Files in the electronic archives.	

VT ROUTE 100 (MINOR ARTERIAL) BRIDGE NO : 166

BEGINNING AT A POINT APPROXIMATELY 8.3 MILES SOUTH OF JUNCTION OF VT ROUTE 100 WITH VT ROUTE 17 AND EXTENDING NORTHERLY 250 FEET ALONG VT ROUTE 100


WORK TO BE PERFORMED UNDER THIS PROJECT INCLUDES REPLACEMENT OF THE EXISTING BRIDGE WITH A NEW BRIDGE ON THE EXISTING ALIGNMENT WITH NECESSARY ROADWAY AND CHANNEL WORK.

LENGTH OF STRUCTURE: 103.80 FEET
LENGTH OF ROADWAY: 146.20 FEET
LENGTH OF PROJECT: 250.00 FEET

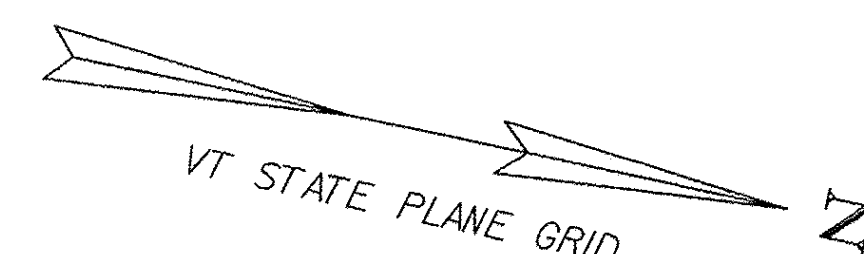



QUALITY ASSURANCE PROGRAM: LEVEL 2

CONVENTIONAL SYMBOLS	
COUNTY LINE	
TOWN LINE	
LIMITS OF ACCESS	
POINT OF ACCESS	
FENCE LINE	
STONE WALL	
TRAVELED WAY	
GUARD RAIL	
RAILROAD	
SURVEY LINE	
CULVERT	
POWER POLE	
TELEPHONE POLE	
TREES	
CONTROL OF ACCESS	
PROPERTY LINE	
R.O.W. TAKING LINE	
SLOPE RIGHTS	
TOP OF CUT	
TOE OF SLOPE	

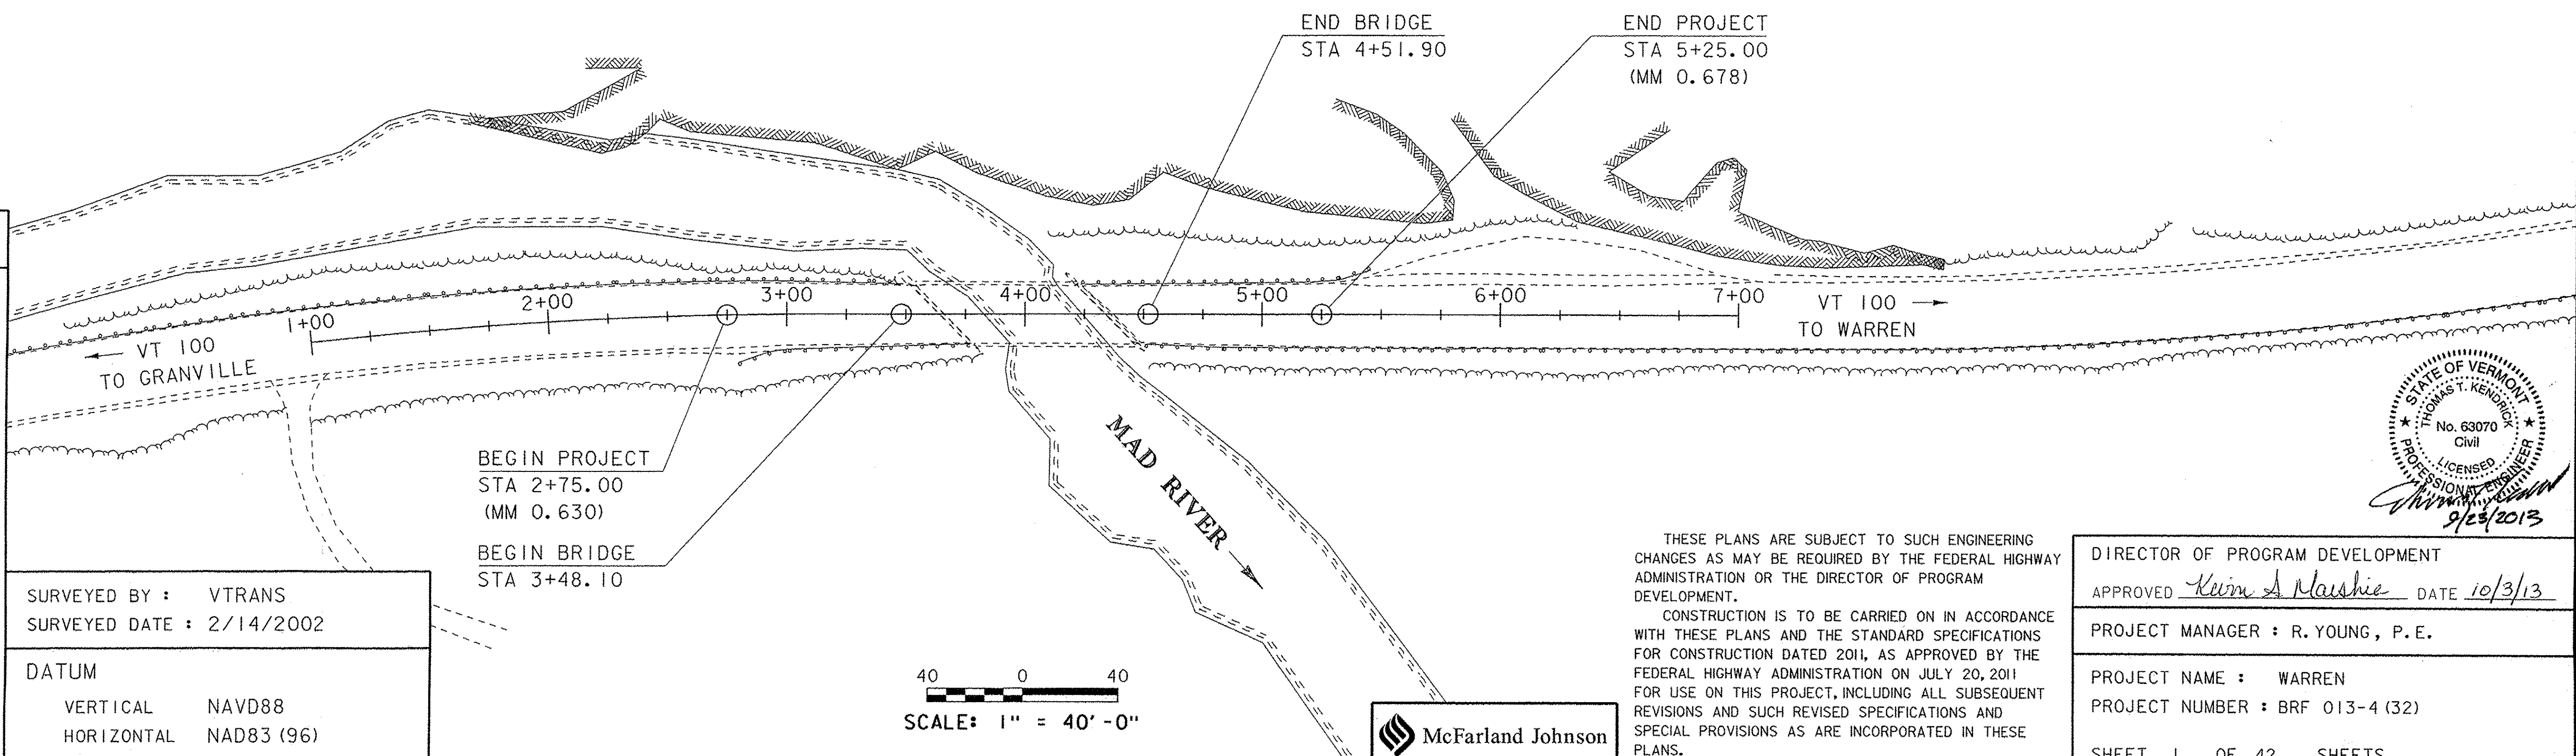

SURVEYED BY : VTRANS
SURVEYED DATE : 2/14/2002

DATUM
VERTICAL NAVD88
HORIZONTAL NAD83 (96)

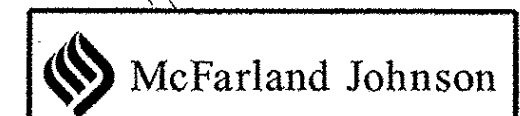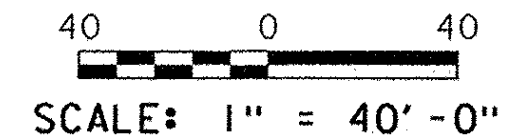

THESE PLANS ARE SUBJECT TO SUCH ENGINEERING CHANGES AS MAY BE REQUIRED BY THE FEDERAL HIGHWAY ADMINISTRATION OR THE DIRECTOR OF PROGRAM DEVELOPMENT.

CONSTRUCTION IS TO BE CARRIED ON IN ACCORDANCE WITH THESE PLANS AND THE STANDARD SPECIFICATIONS FOR CONSTRUCTION DATED 2011, AS APPROVED BY THE FEDERAL HIGHWAY ADMINISTRATION ON JULY 20, 2011 FOR USE ON THIS PROJECT, INCLUDING ALL SUBSEQUENT REVISIONS AND SUCH REVISED SPECIFICATIONS AND SPECIAL PROVISIONS AS ARE INCORPORATED IN THESE PLANS.

DIRECTOR OF PROGRAM DEVELOPMENT APPROVED <u>Kevin A. Mashie</u> DATE <u>10/3/13</u>
PROJECT MANAGER : R. YOUNG, P. E.
PROJECT NAME : WARREN PROJECT NUMBER : BRF 013-4 (32)
SHEET 1 OF 42 SHEETS