



PLAN

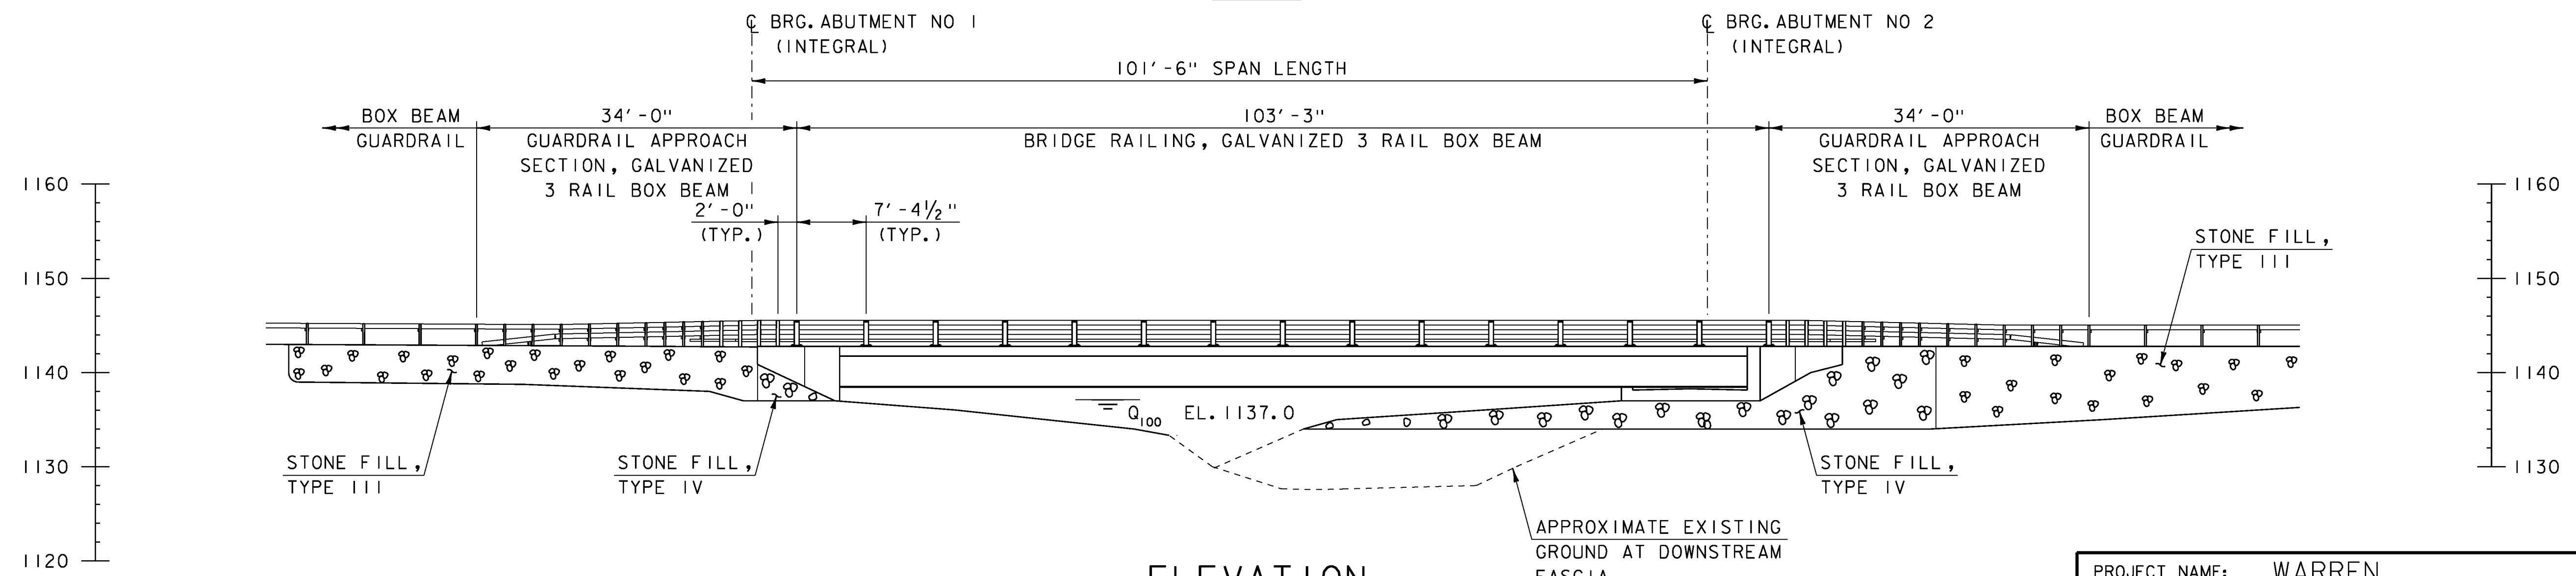

ELEVATION

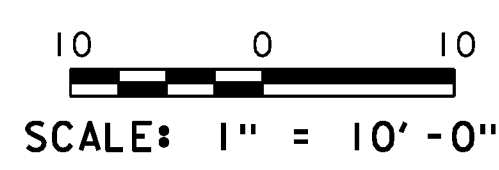

PROJECT NAME:	WARREN	PLOT DATE:	03-OCT-2013
PROJECT NUMBER:	BRF 013-4(32)	DRAWN BY:	P. DUSTIN
FILE NAME:	z10b424pe.dgn	CHECKED BY:	T. KENDRICK
PROJECT LEADER:	R. YOUNG	PLAN AND ELEVATION	SHEET 18 OF 42