




50+25

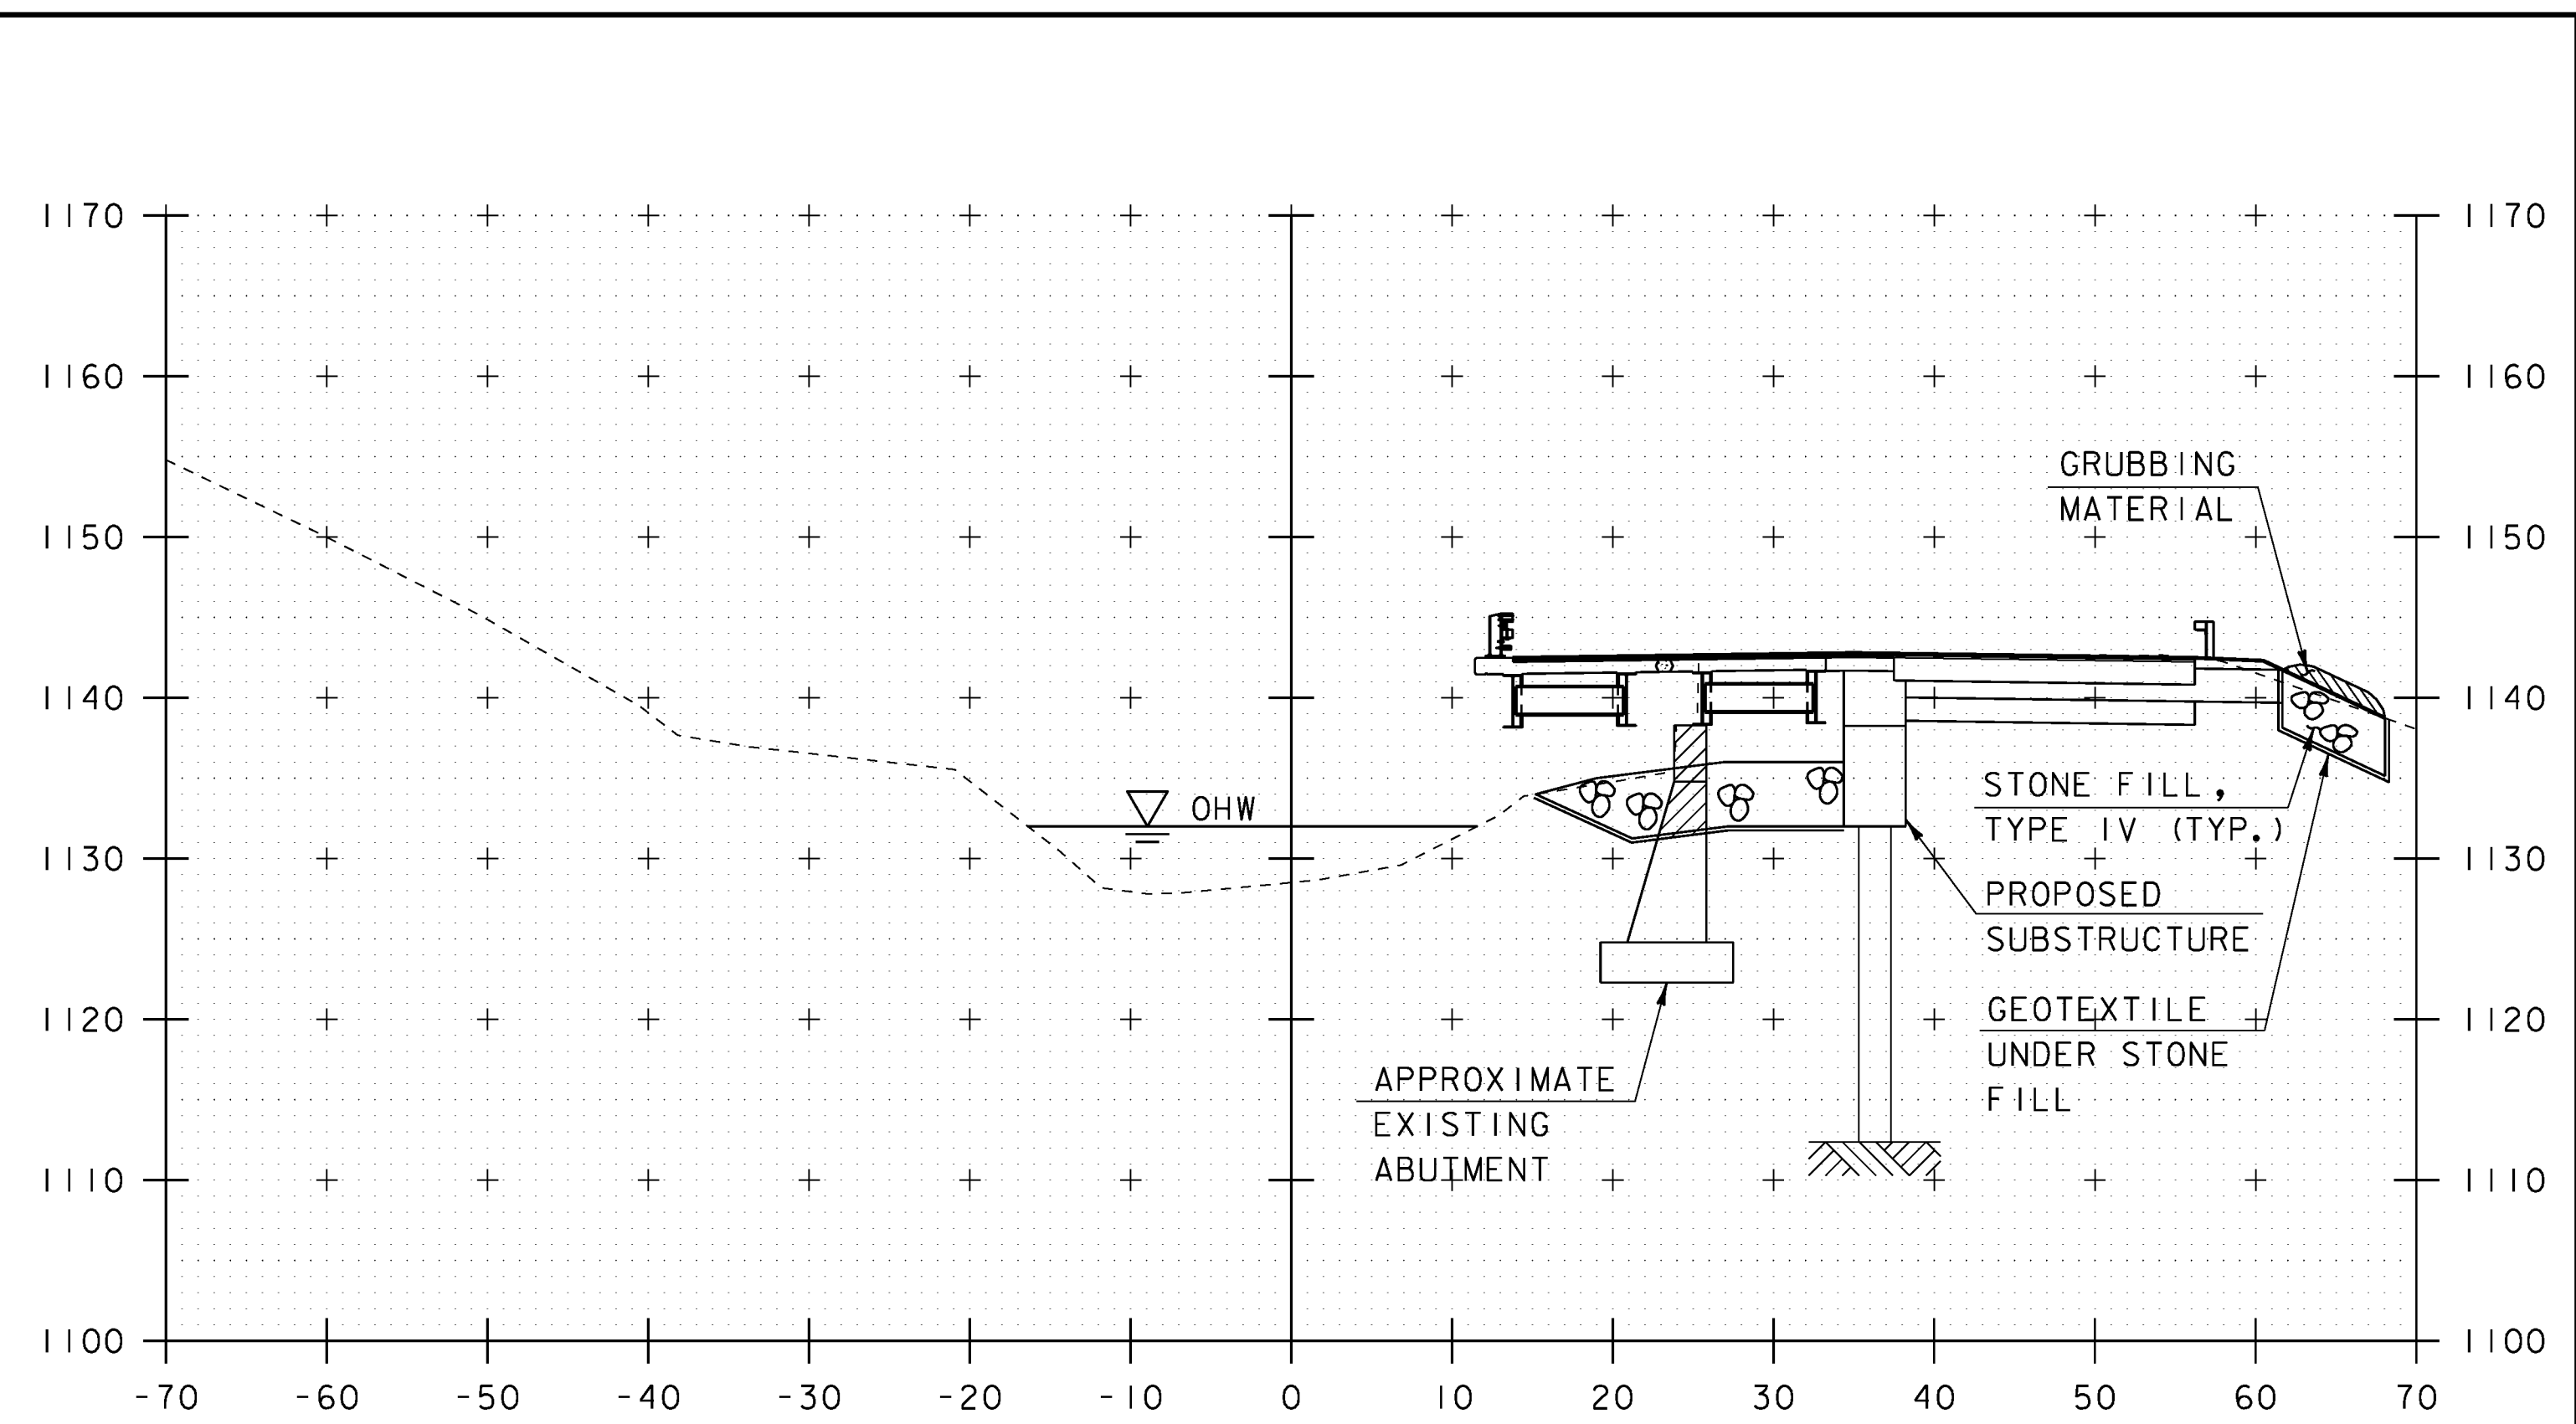

50+65

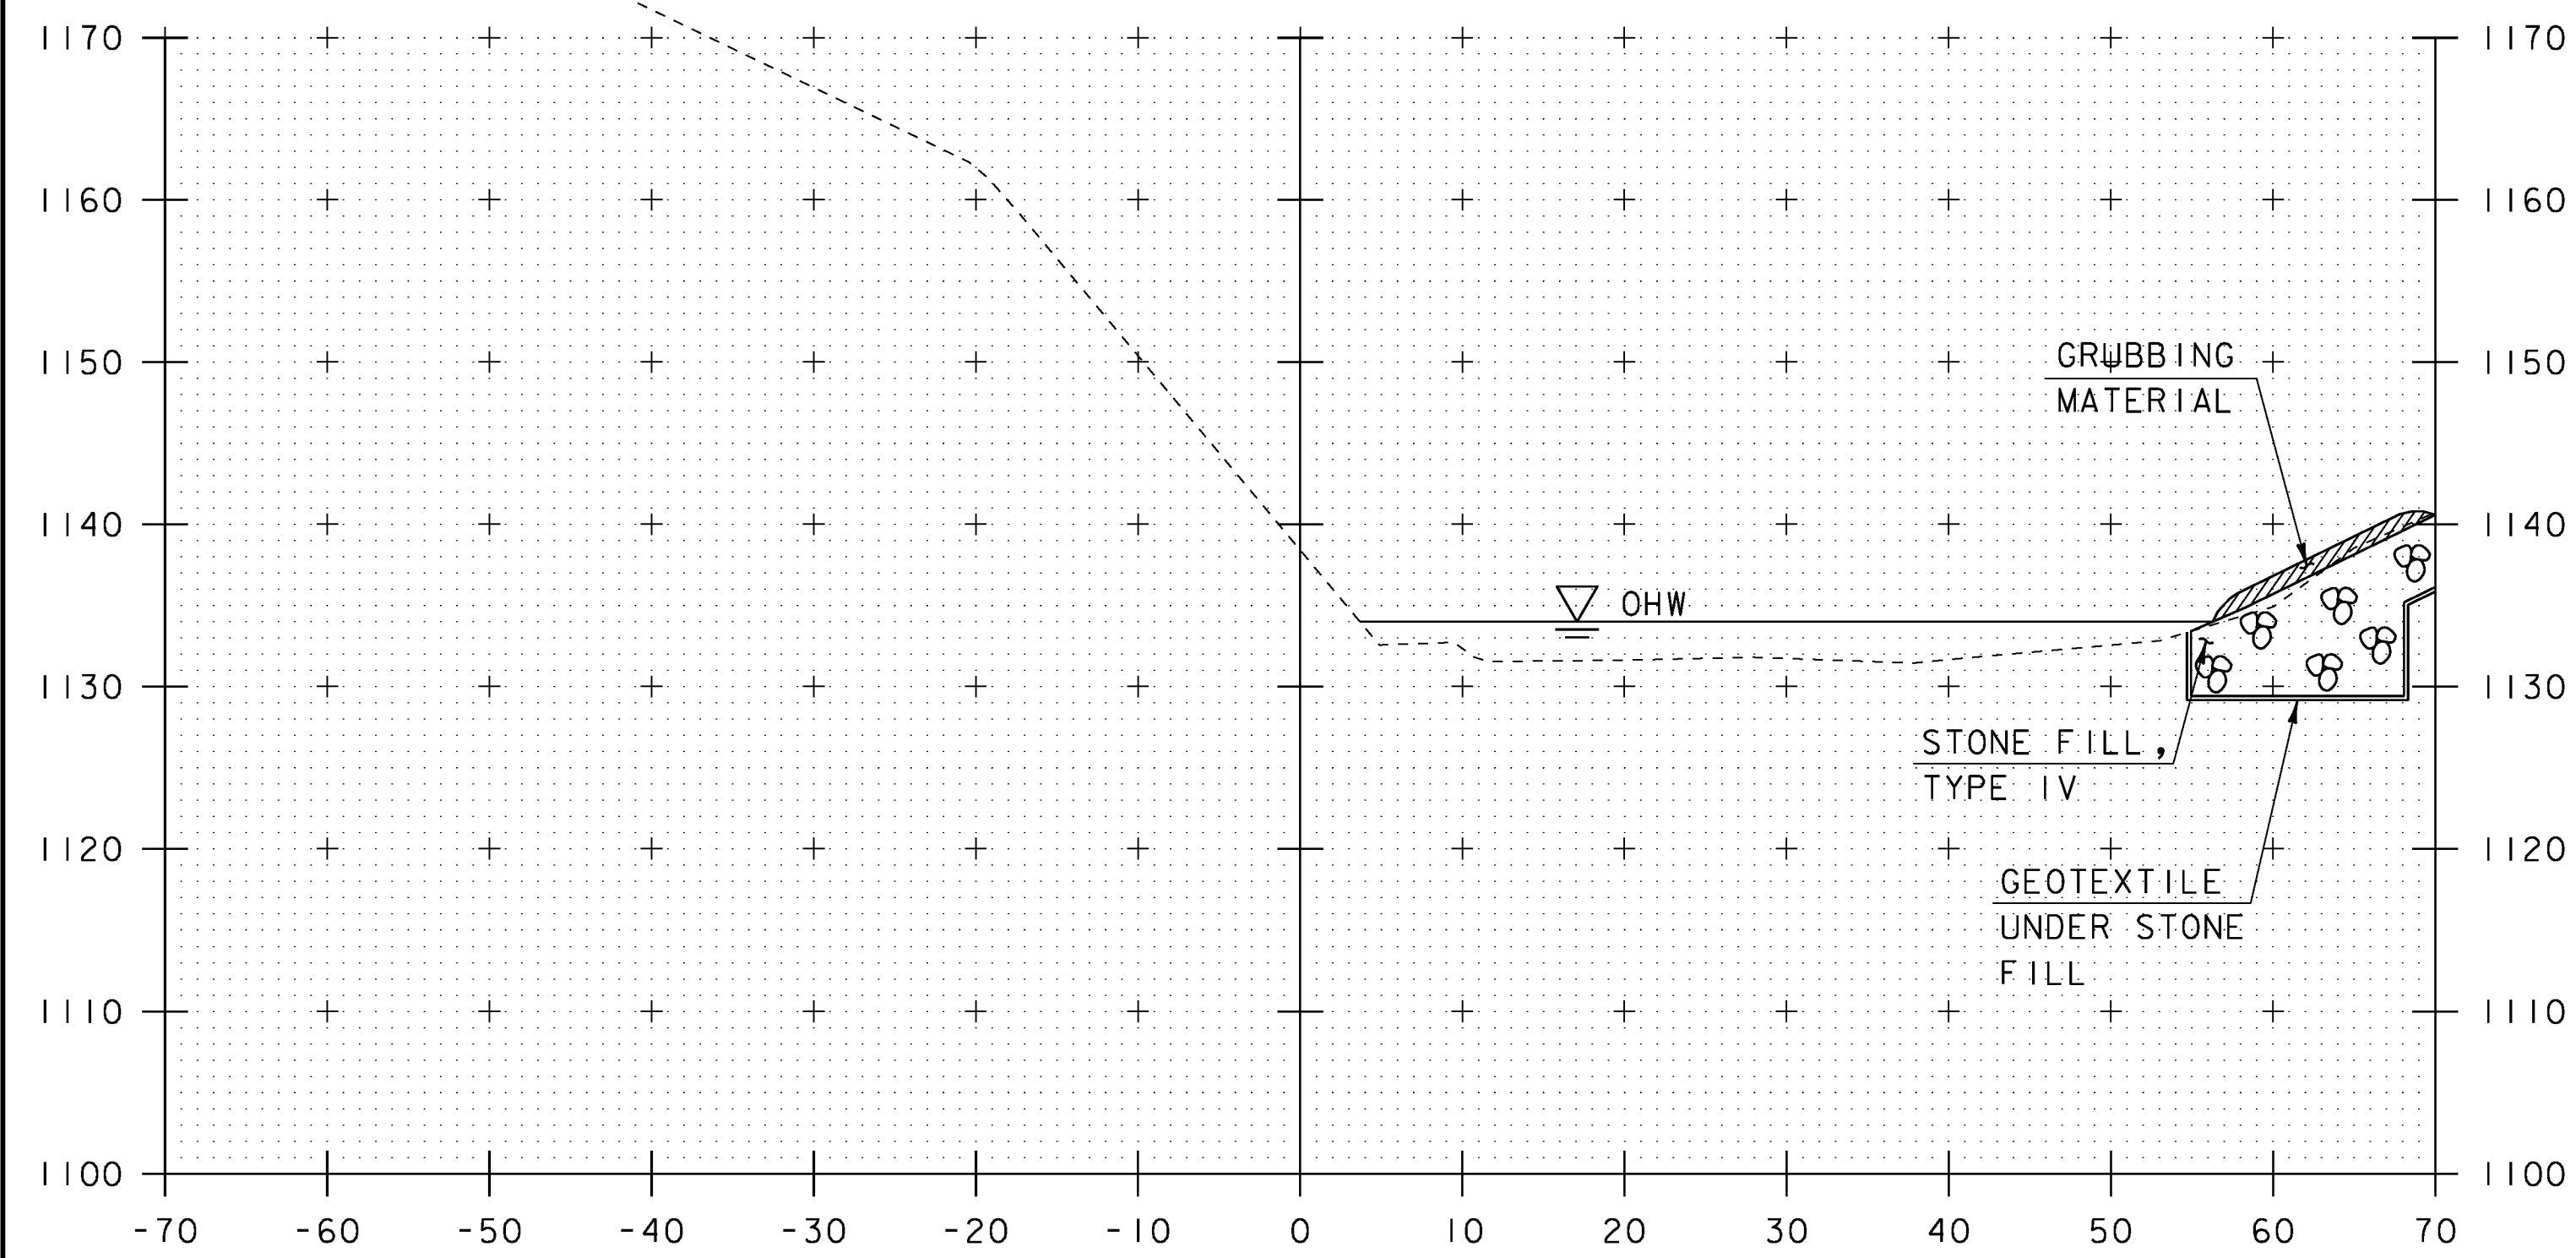

50+00

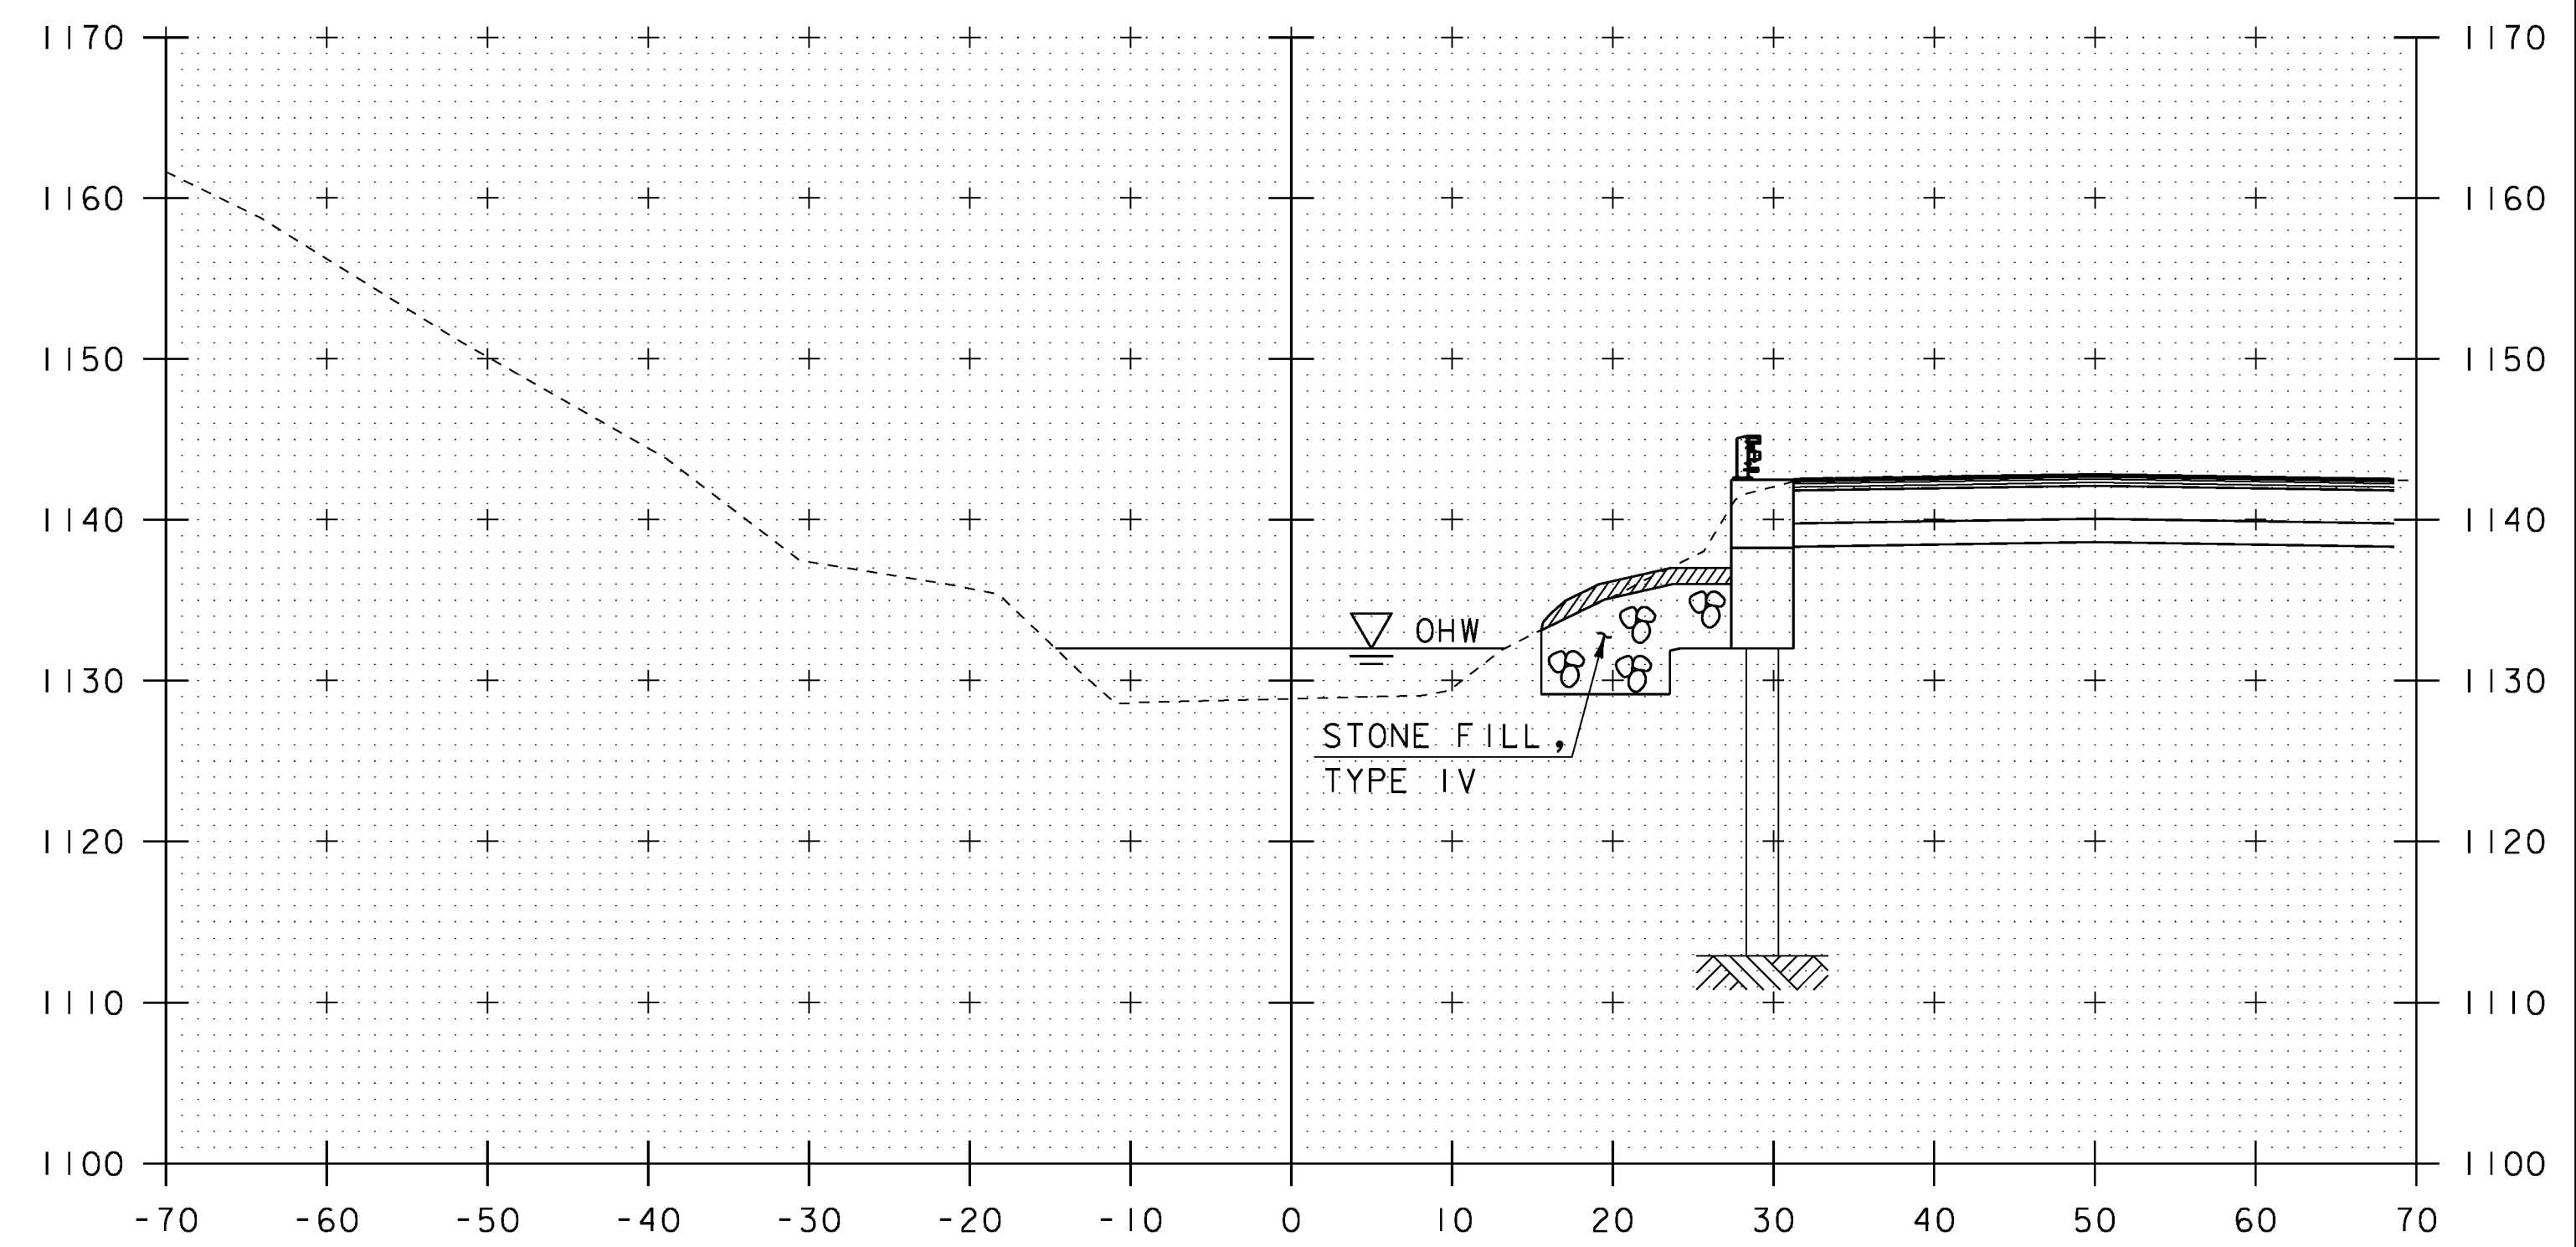

50+50

NOTE:
FOR STONE FILL AND
GRUBBING MATERIAL
LIMITS, SEE LAYOUT SHEET

SCALE 1" = 10' - 0"
10 0 10



PROJECT NAME: WARREN
PROJECT NUMBER: BRP 013-4(32)

FILE NAME: z10b424xsl.dgn
PROJECT LEADER: R. YOUNG
DESIGNED BY: D. KULL
CHANNEL CROSS SECTIONS (1 OF 4)

PLOT DATE: 03-OCT-2013
DRAWN BY: S. MERKWAN
CHECKED BY: T. KENDRICK
SHEET 33 OF 42

STA. 50+00 TO STA. 50+65