




52+00

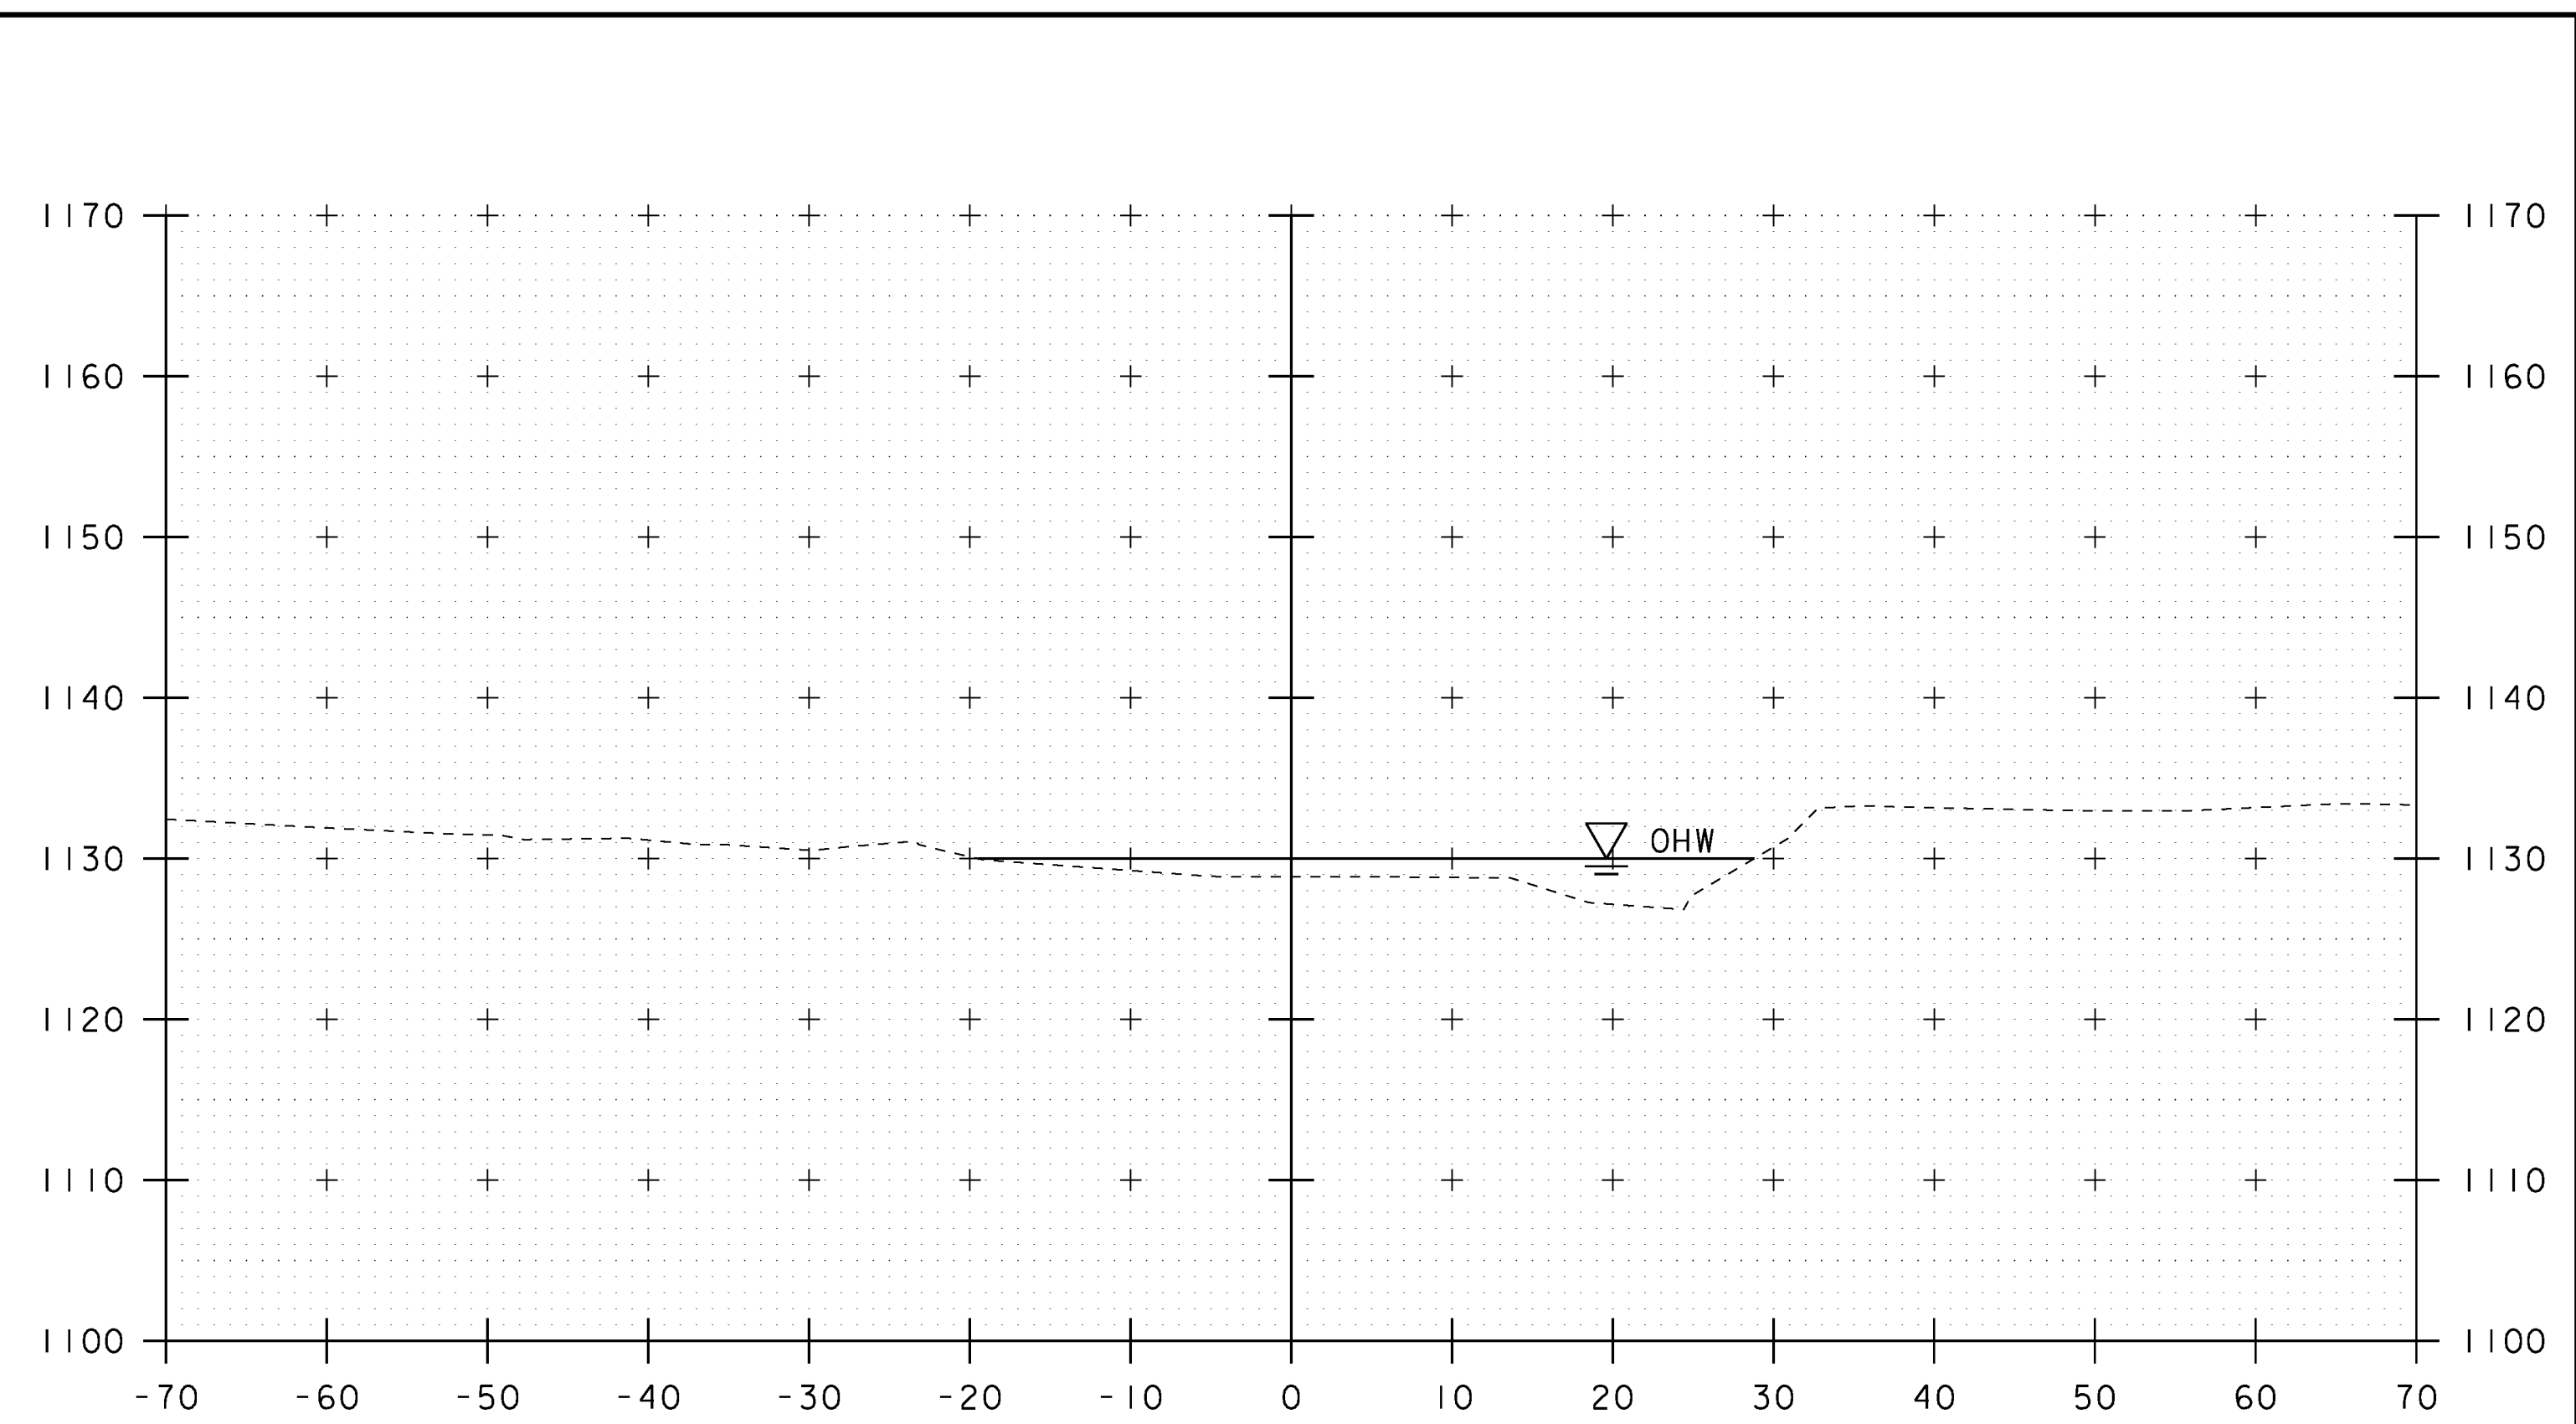

52+50

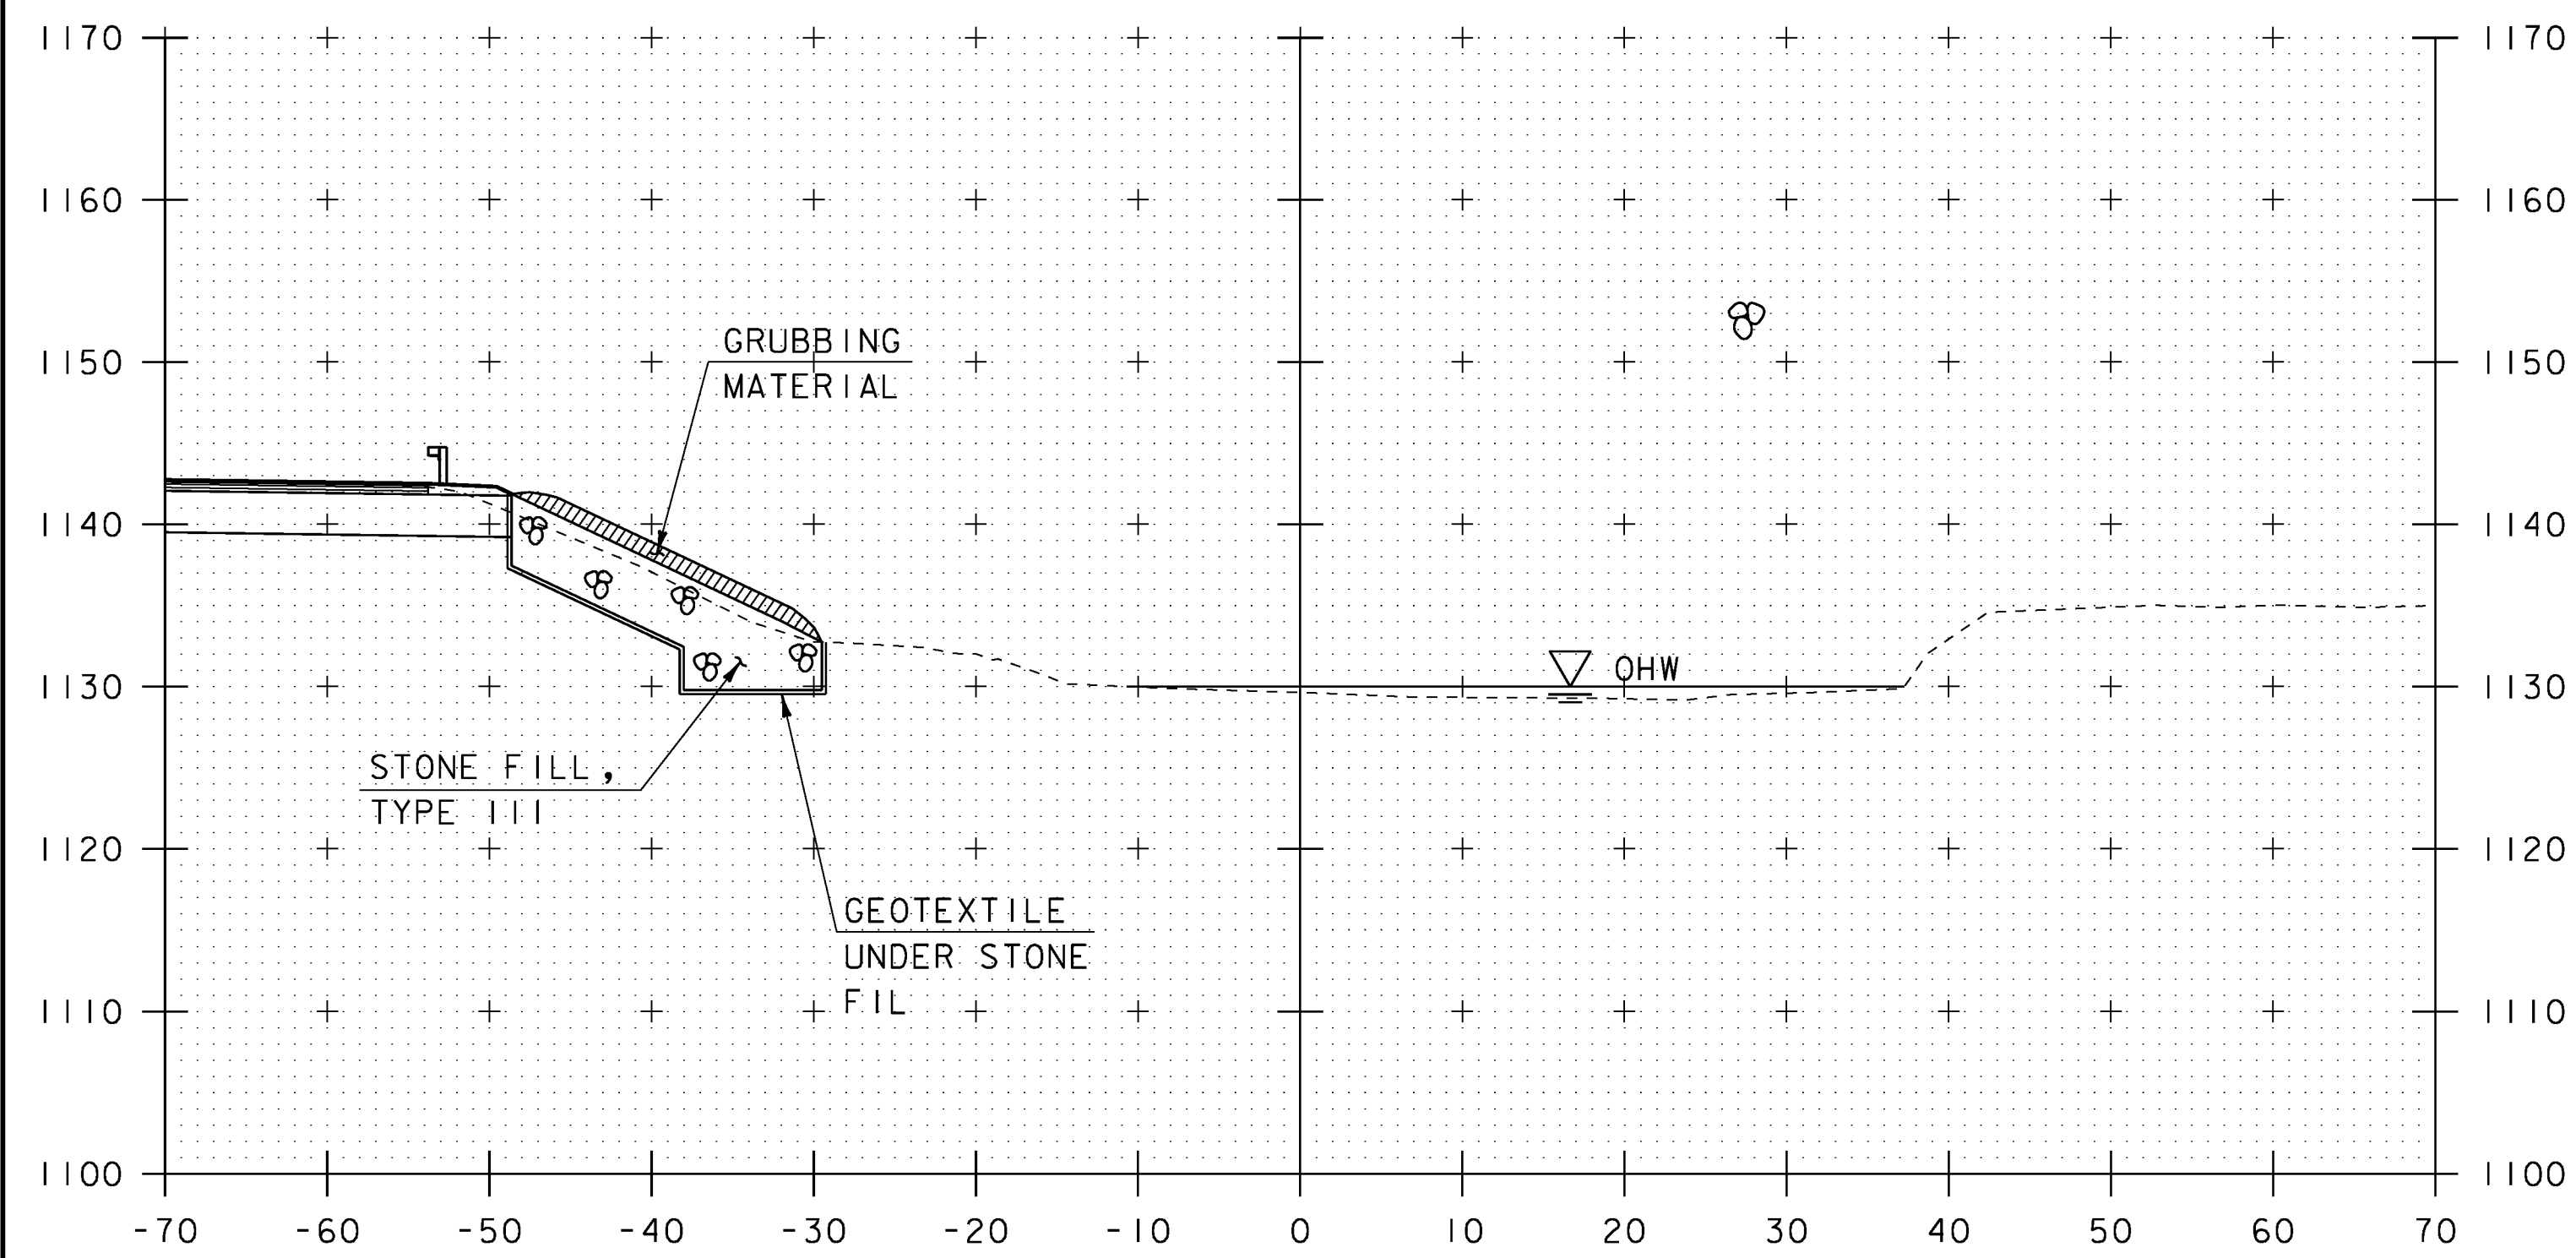

51+75

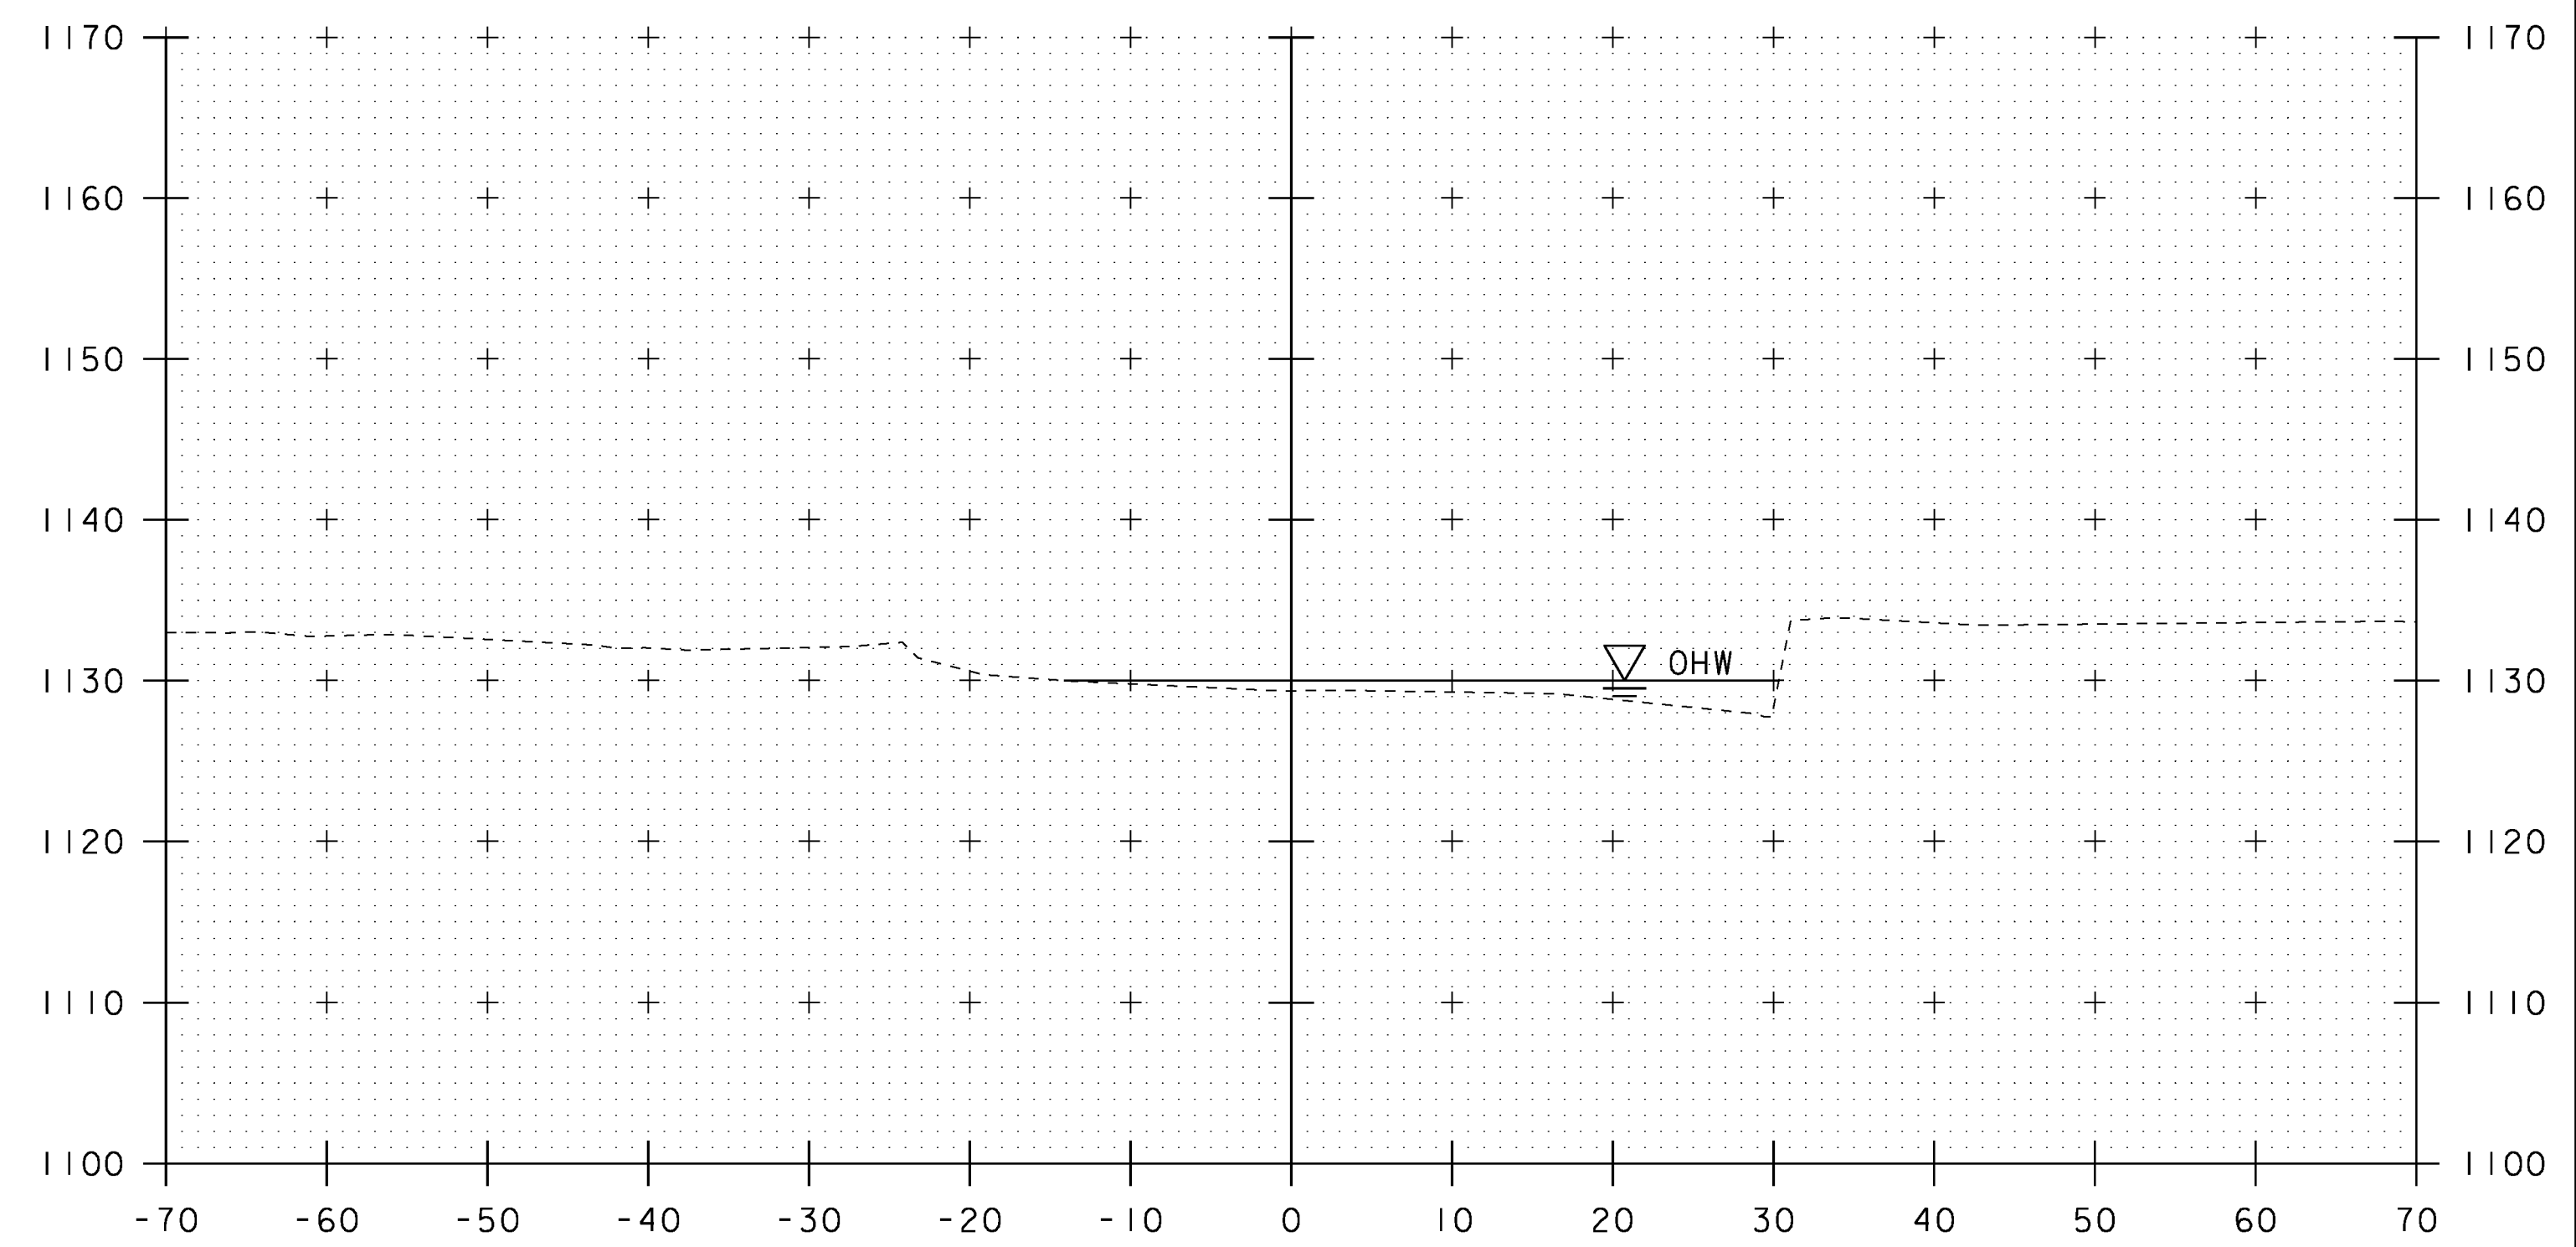

52+25

NOTE:
FOR STONE FILL AND
GRUBBING MATERIAL
LIMITS, SEE LAYOUT SHEET

SCALE 1" = 10' - 0"
10 0 10



PROJECT NAME: WARREN	PLOT DATE: 03-OCT-2013
PROJECT NUMBER: BRF 013-4(32)	DRAWN BY: S. MERKWAN
FILE NAME: z10b424xsl.dgn	CHECKED BY: T. KENDRICK
PROJECT LEADER: R. YOUNG	SHEET 36 OF 42
DESIGNED BY: D. KULL	
CHANNEL CROSS SECTIONS (4 OF 4)	

STA. 51+75 TO STA. 52+50