


Plan View

Girder Elevation	
Girder	Elevation
G1	1137.88
G2	1137.98
G3	1138.04
G4	1138.13
G5	1138.13
G6	1138.03
G7	1137.97
G8	1137.87

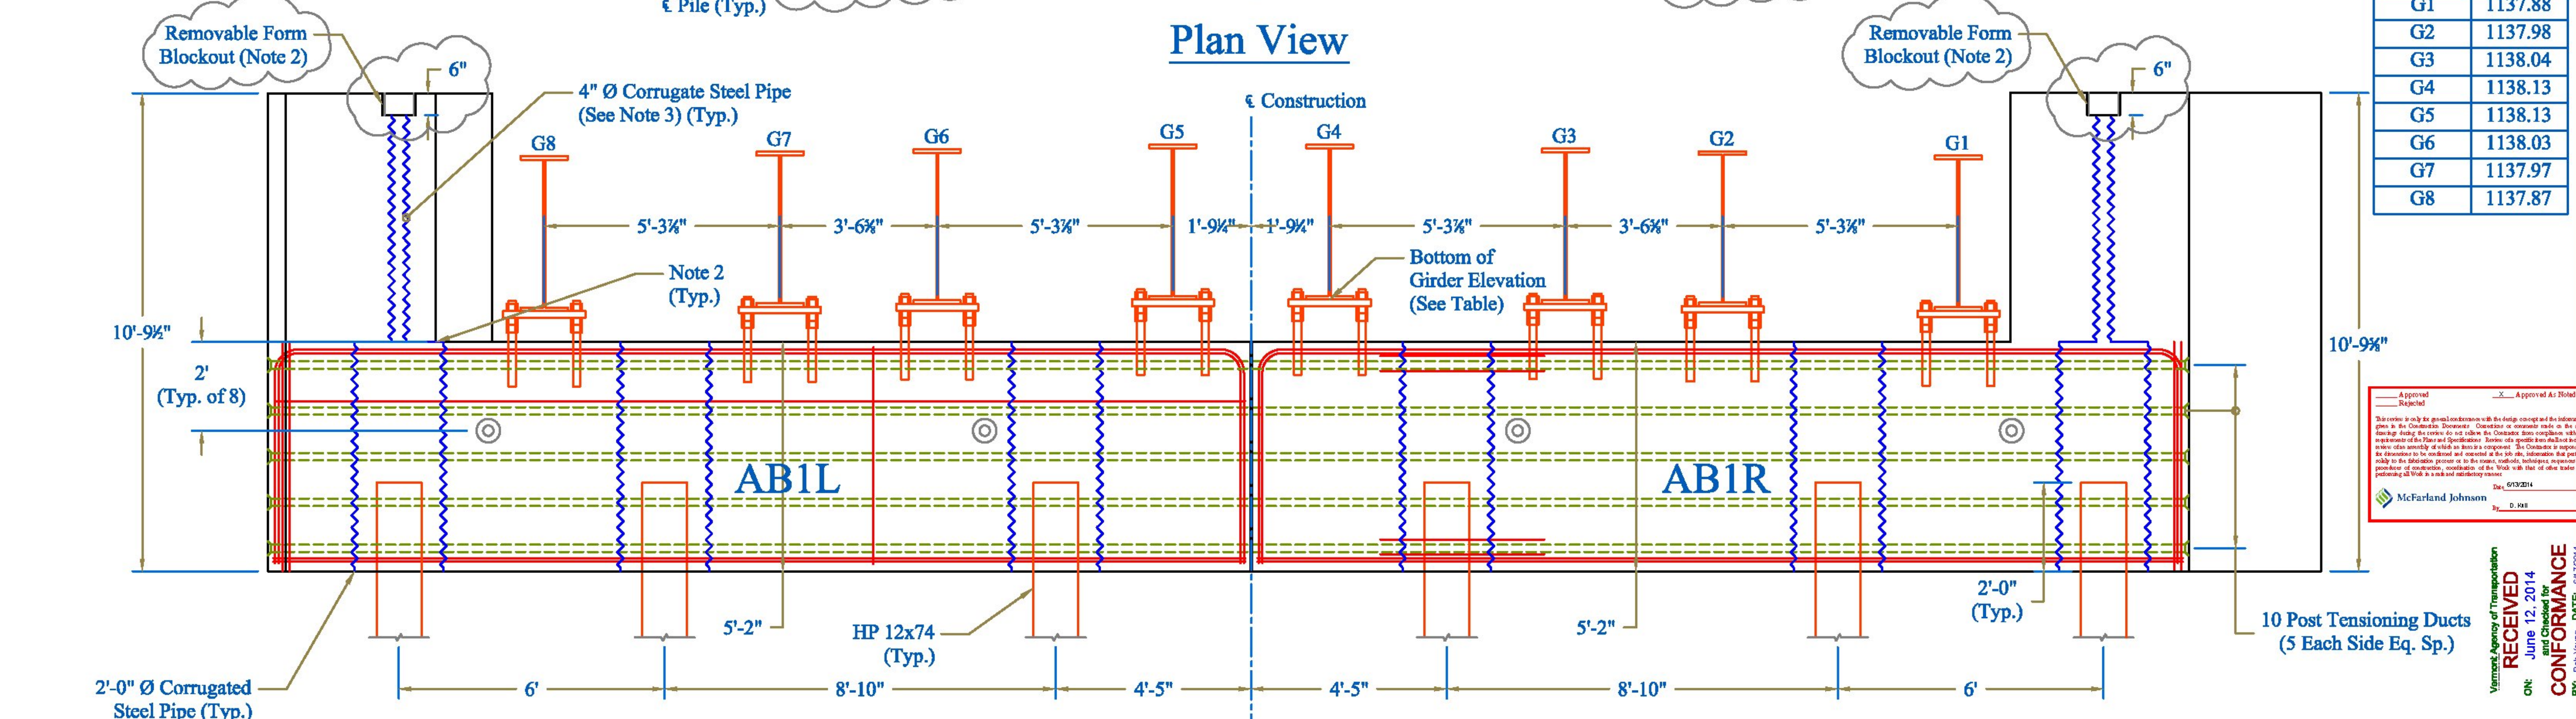

Elevation View

Approved
 Rejected
 Approved As Noted

This review is only the government's review of the design and the information provided in the Construction Documents. It does not constitute an approval of the design or construction. The Contractor is responsible for the design and construction of the project. The Contractor is responsible for the safety of the project. The Contractor is responsible for the quality of the project. The Contractor is responsible for the completion of the project.

Date: 01/23/14
 By: D. Hill
 McFarland Johnson

Vermont Agency of Transportation
RECEIVED
 ON: June 12, 2014
 and Checked for
CONFORMANCE
 BY: Bob Johnson DATE: 06/12/2014

AB1L Weight = 76,790 lbs
 AB1R Weight = 77,140 lbs

CONTRACTORS VISPE: NOTES:

1. Use 24" Galvanized Corrugated Steel Pipe for Pile Pockets Conforming to Subsection 711.01.
2. Form Top 6" with Removable Form to Eliminate Exposed Corrugated Steel on the Top of The Abutment
3. 4" Galvanized Corrugated Steel Pipe to Conform to Subsection 711.01.
4. Richmond ties, 2 part epoxy paint any portion of ties outside the clear area plus 1" deeper and any broken section. Patch hole per manufacturers directions to achieve the correct perimeter edge conditions.

PRECAST CONCRETE ABUTMENT SHOP DRAWINGS (SDI JOB #14046)
 SUPERVISOR: M. WHEELER
 DETAILER: I. ADAMS
 CHECKER: E. Barendse
 ENGINEER: N/A

Luck Brothers, Inc
 73 Trade Road
 Plattsburg, NY, 12901
 Ph: (518)-561-4321
 04/08/2014

FABRICATOR:
 193 INDUSTRIAL AVE.
 WILLISTON, VT 05495
 Ph: (802) 658-0201



Abutment 1