


# Abutment Plan View

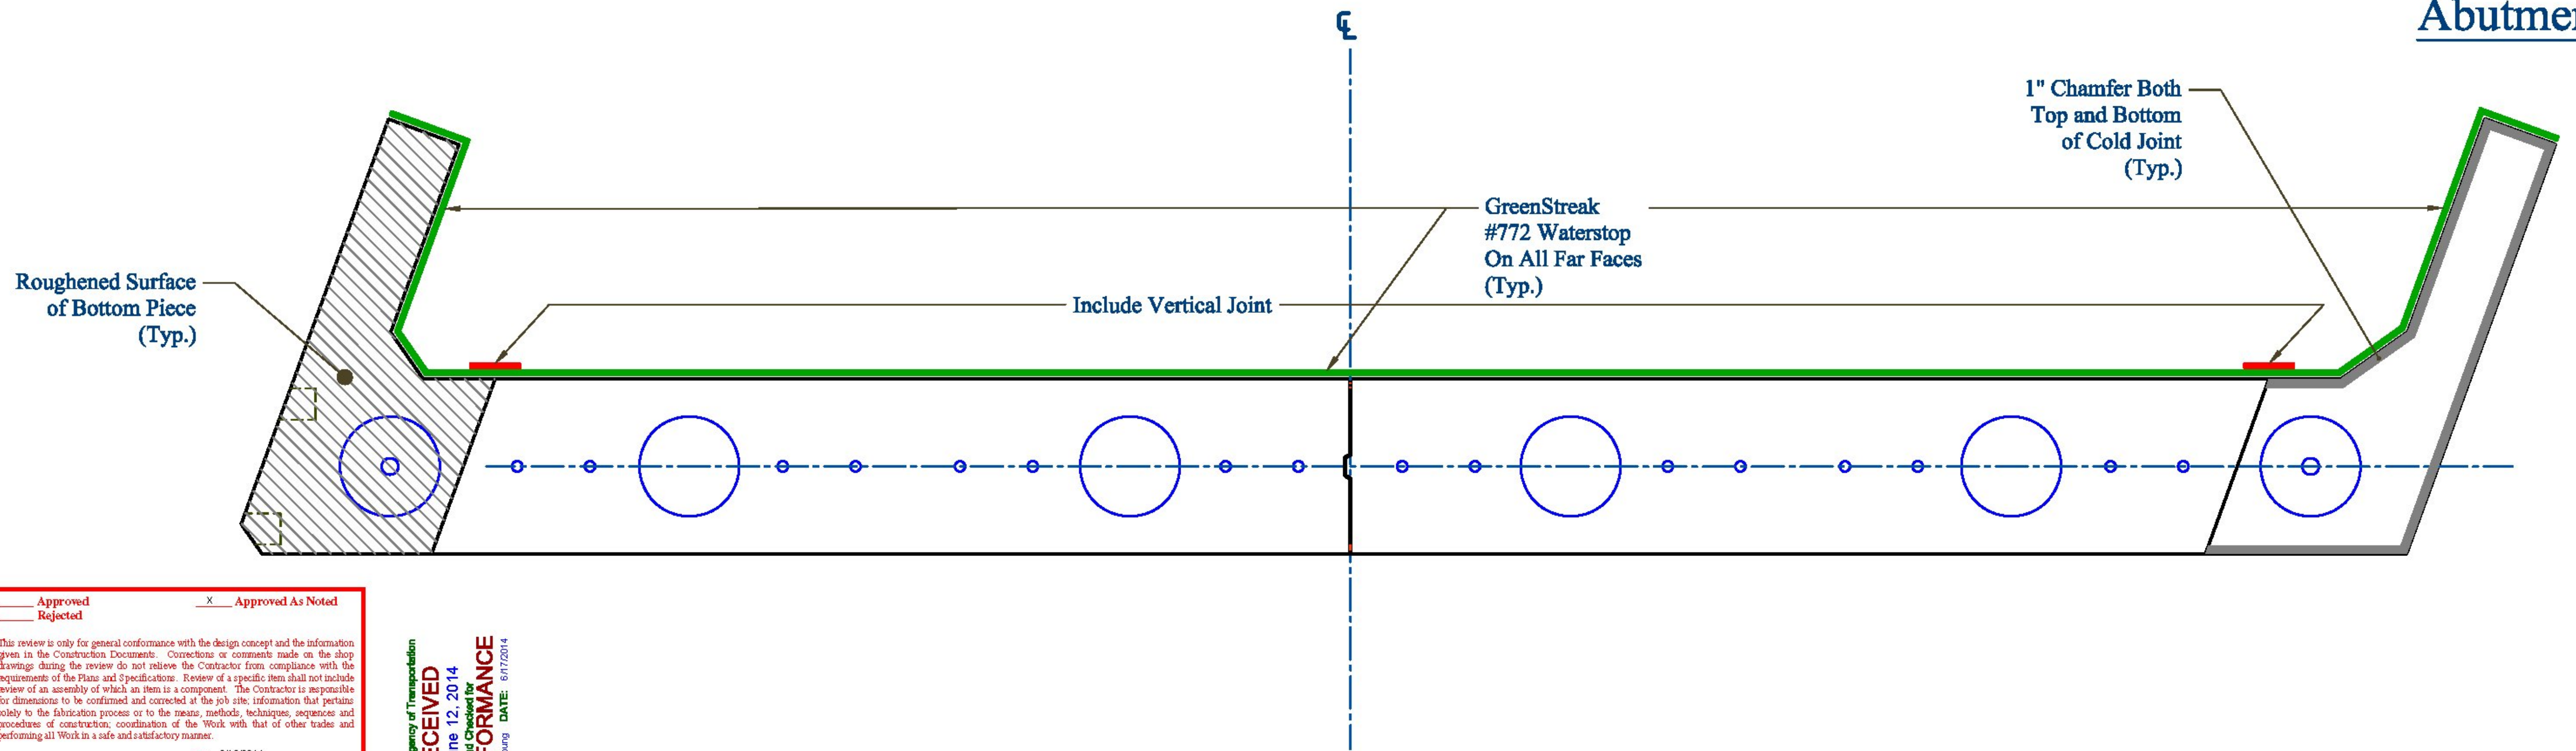

Approved  
 Rejected


Approved As Noted

This review is only for general conformance with the design concept and the information given in the Construction Documents. Comments or comments made on the shop drawings during the review do not relieve the Contractor from compliance with the requirements of the Plans and Specifications. Review of a specific item shall not include review of an assembly of which an item is a component. The Contractor is responsible for dimensions to be confirmed and corrected at the job site, information that pertains solely to the fabrication process or to the means, methods, techniques, sequences and procedures of construction; coordination of the Work with that of other trades and performing all Work in a safe and satisfactory manner.


Date: 6/13/2014  
 By: D. Huff

Vermont Agency of Transportation  
**RECEIVED**  
 On: June 12, 2014  
 and Checked for  
**CONFORMANCE**  
 BY: Rob Young DATE: 6/17/2014

# Upper Piece Plan View

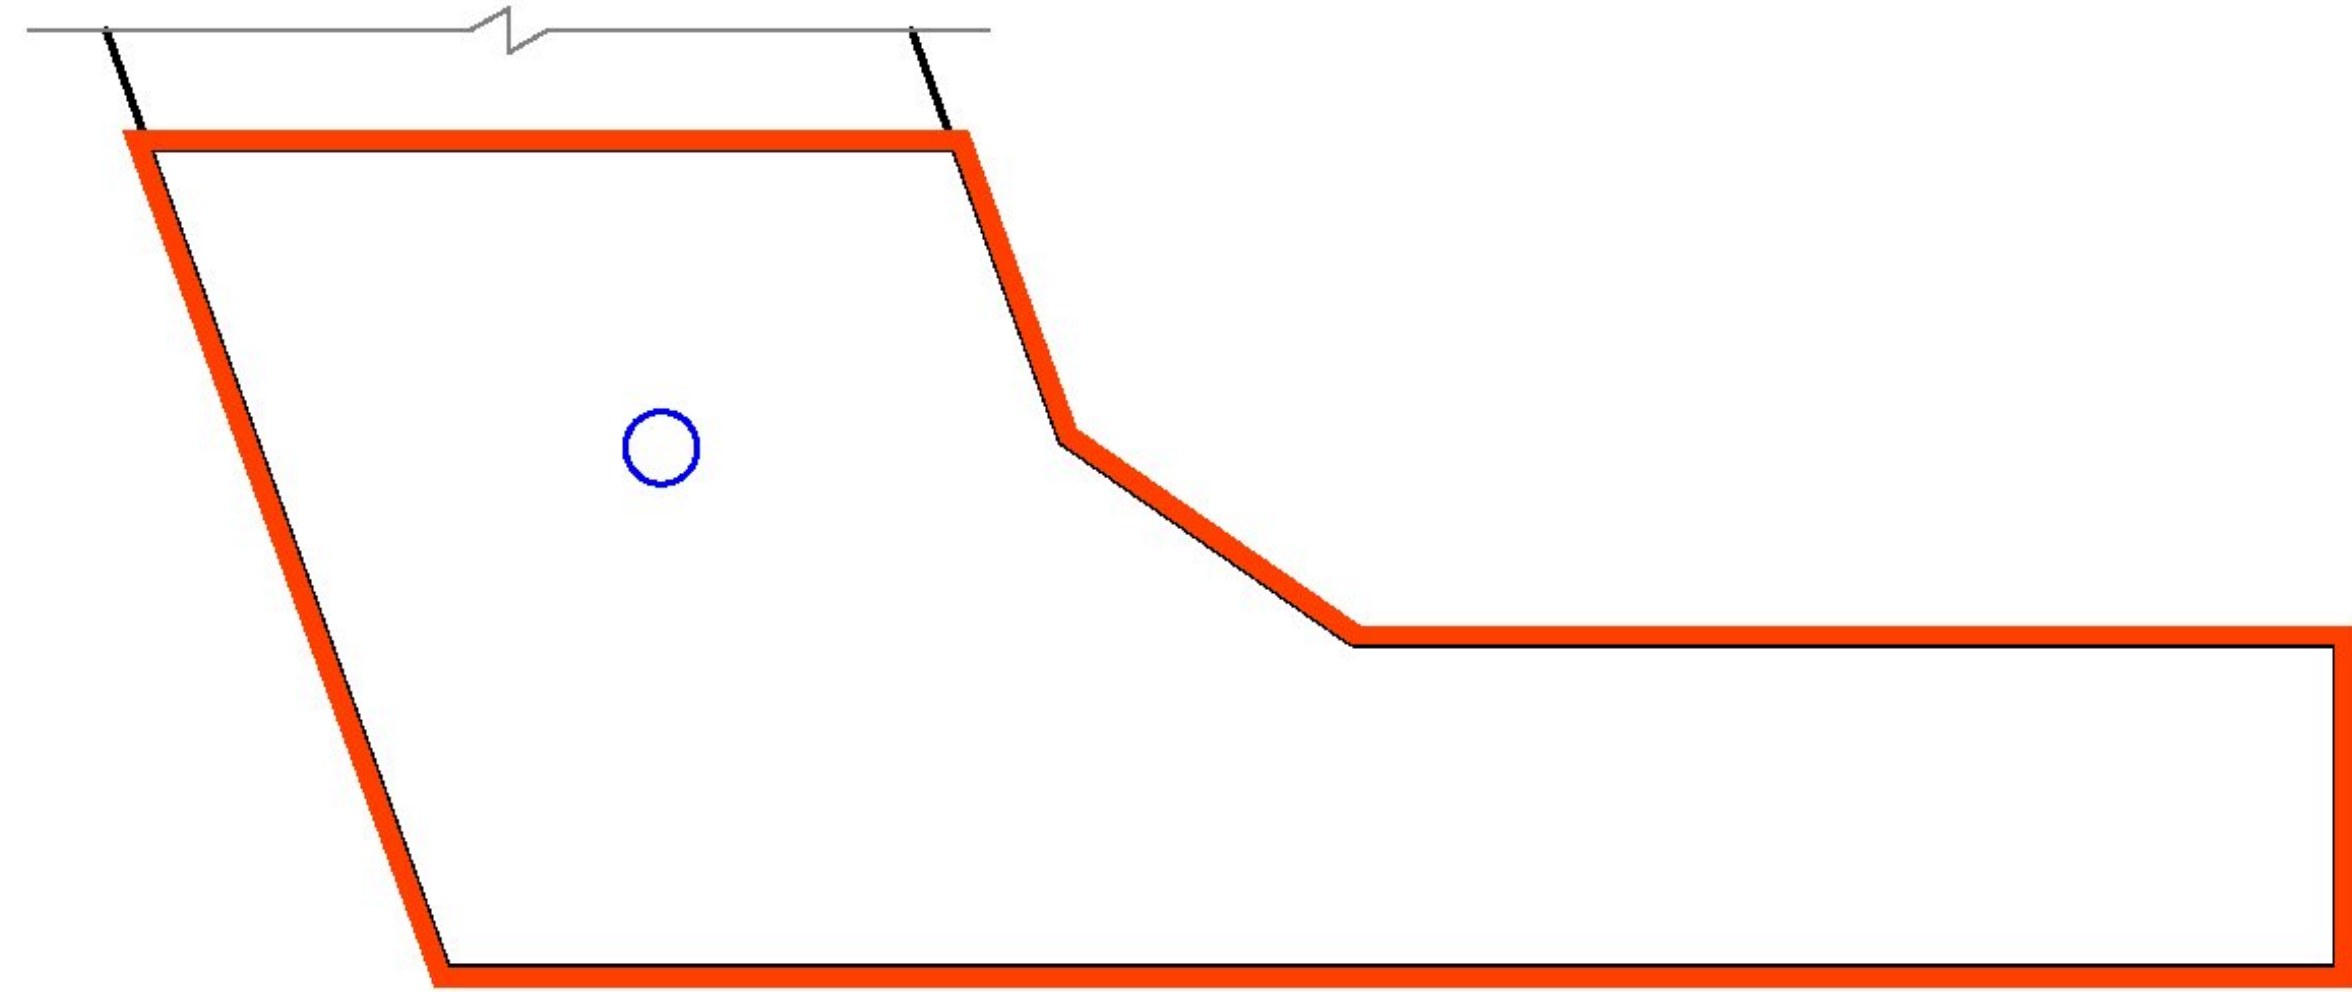

# Water Stop Joint Detail

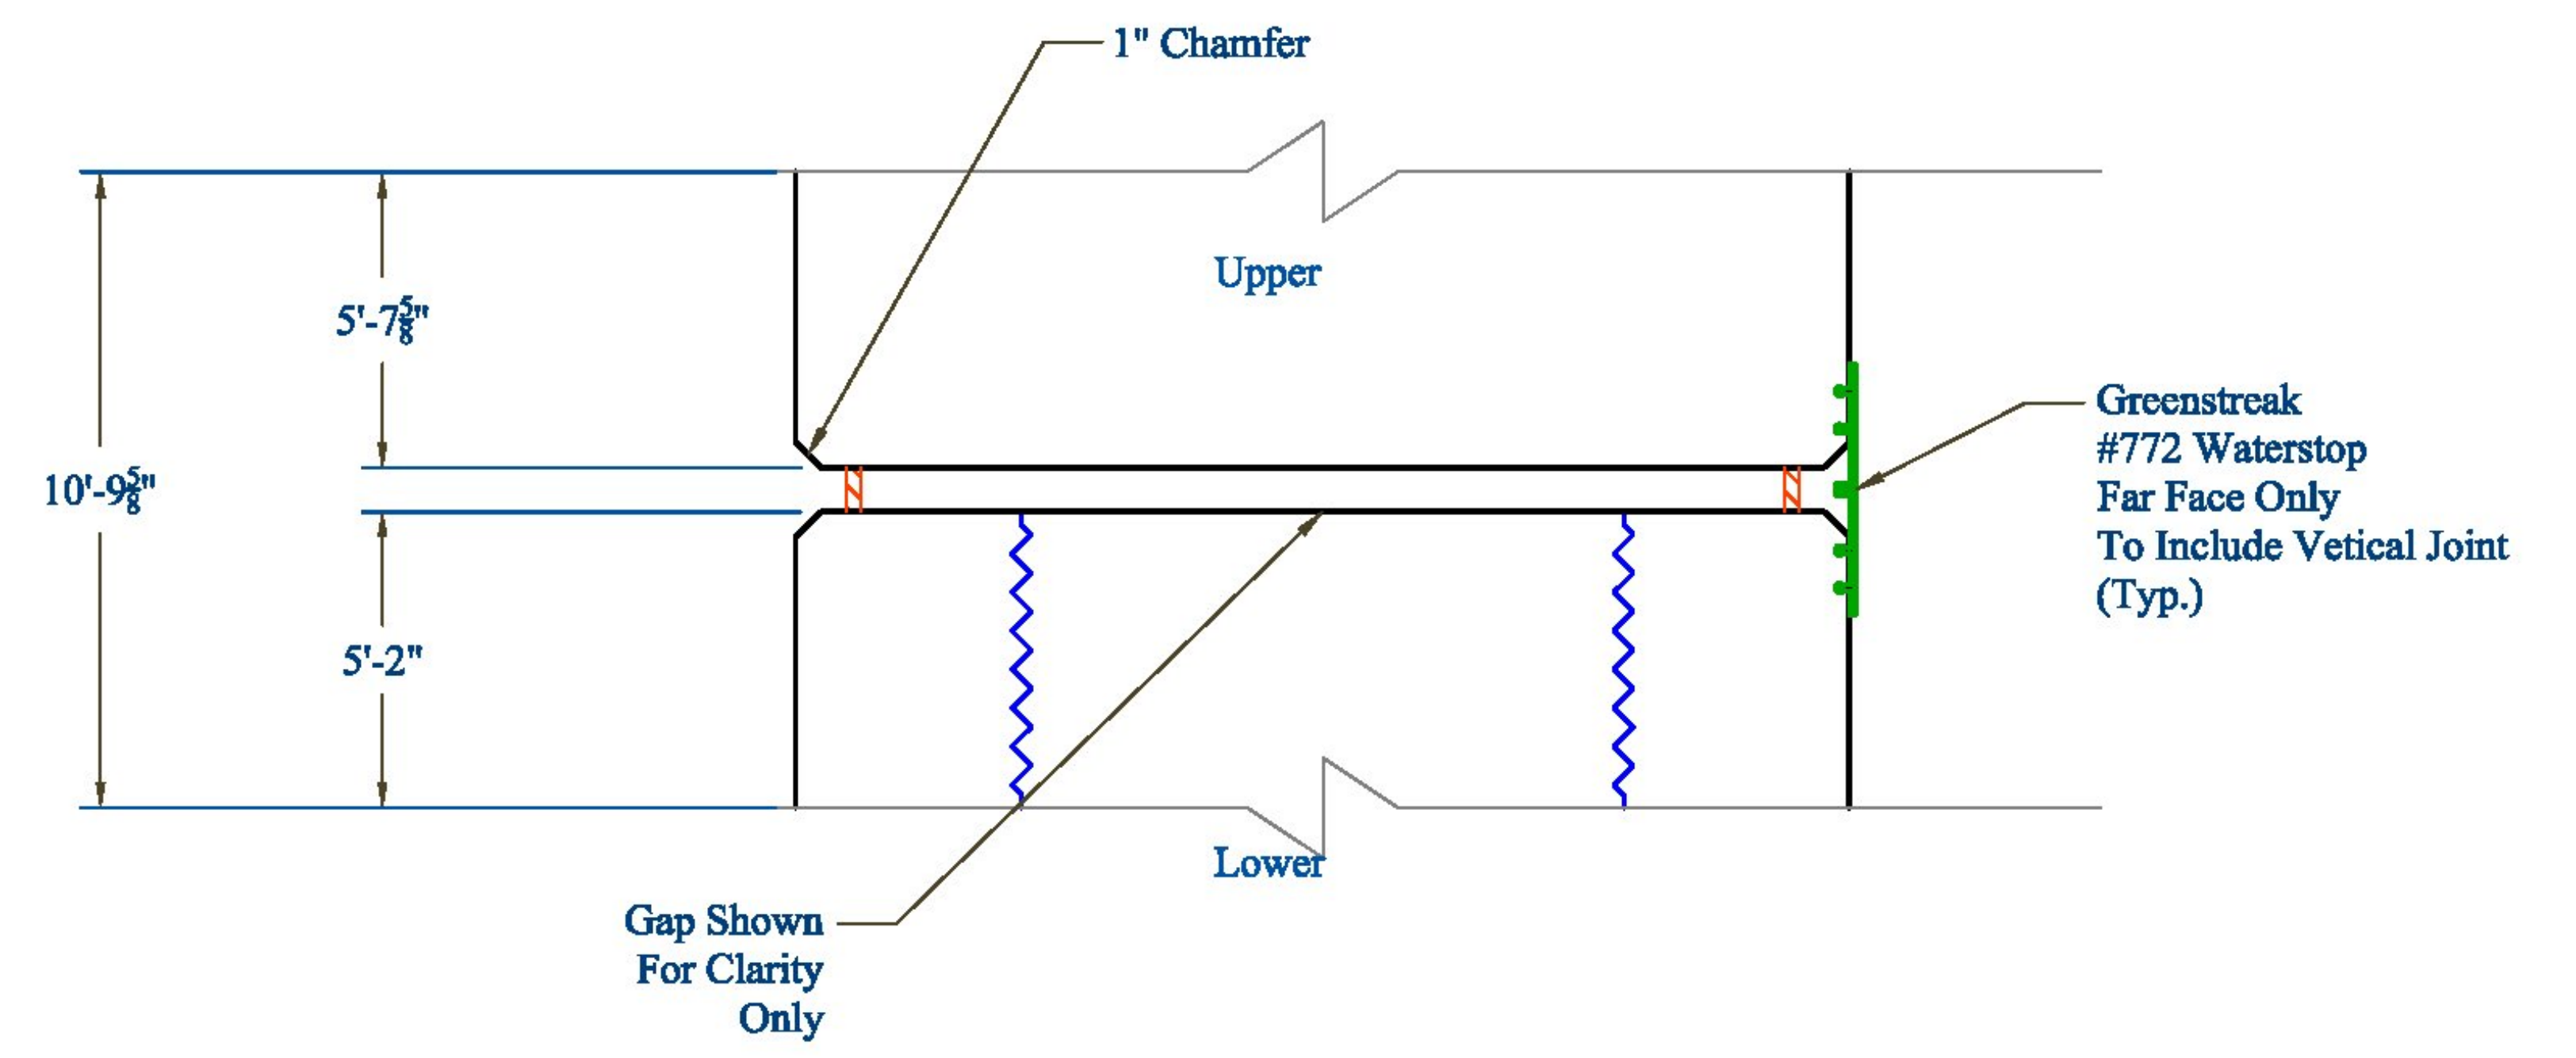

CONTRACTORS VISPE:

PRECAST CONCRETE ABUTMENT SHOP DRAWINGS (SDI JOB #14046)		Luck Brothers, Inc 73 Trade Road Plattsburg, NY, 12901 Ph: (518)-561-4321	FABRICATOR: 193 INDUSTRIAL AVE. WILLISTON, VT 05495 Ph: (802) 658-0201	
SUPERVISOR: M. WHEELER DETAILER: I. ADAMS CHECKER: E. Barendse ENGINEER: N/A	PROJECT NAME: Warren PROJECT #: BRF 013-4(32) LOCATION: Bridge #166 Route 100, Warren, VT			