



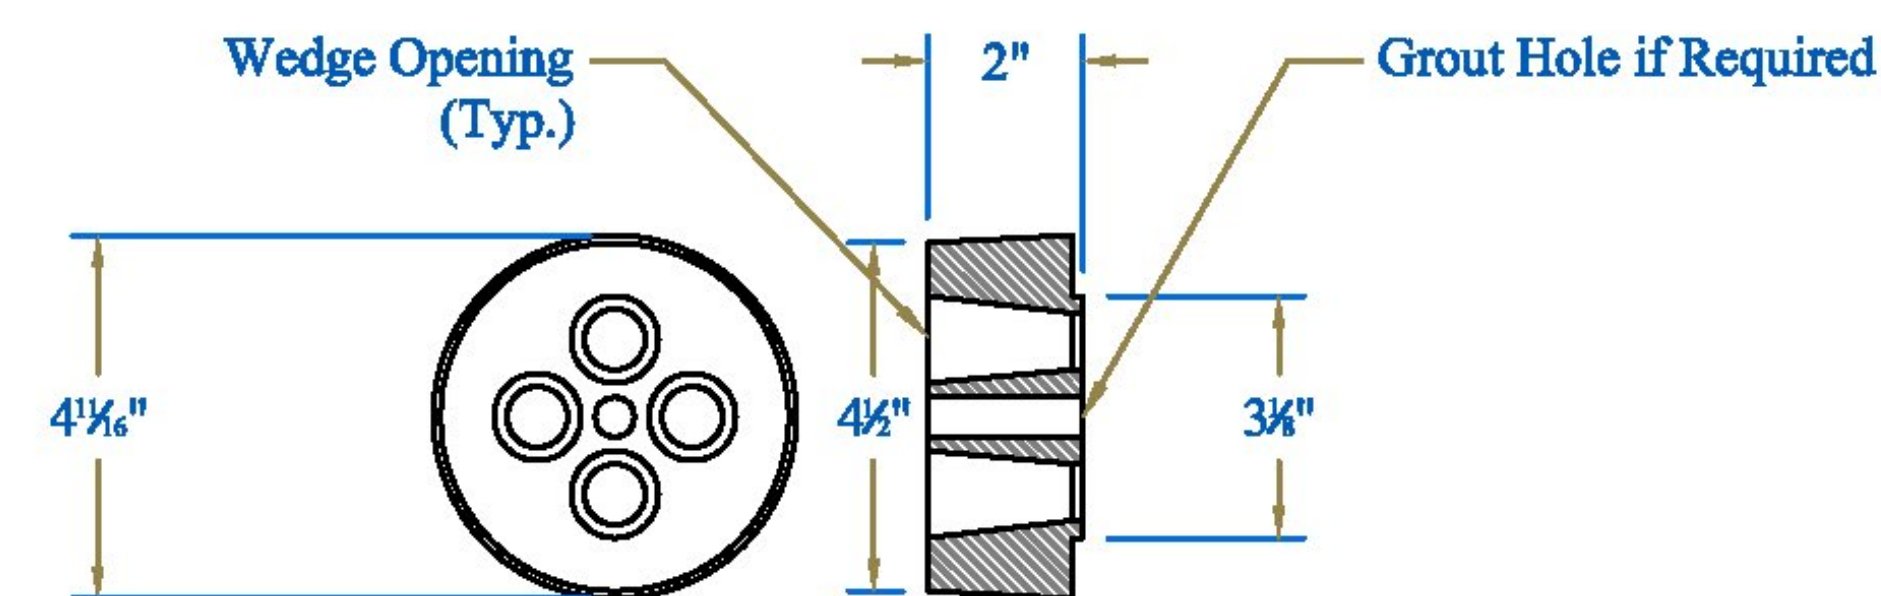


Typical 4-0.6" Cast Wedge Plate


Part # 68-04 1532 13

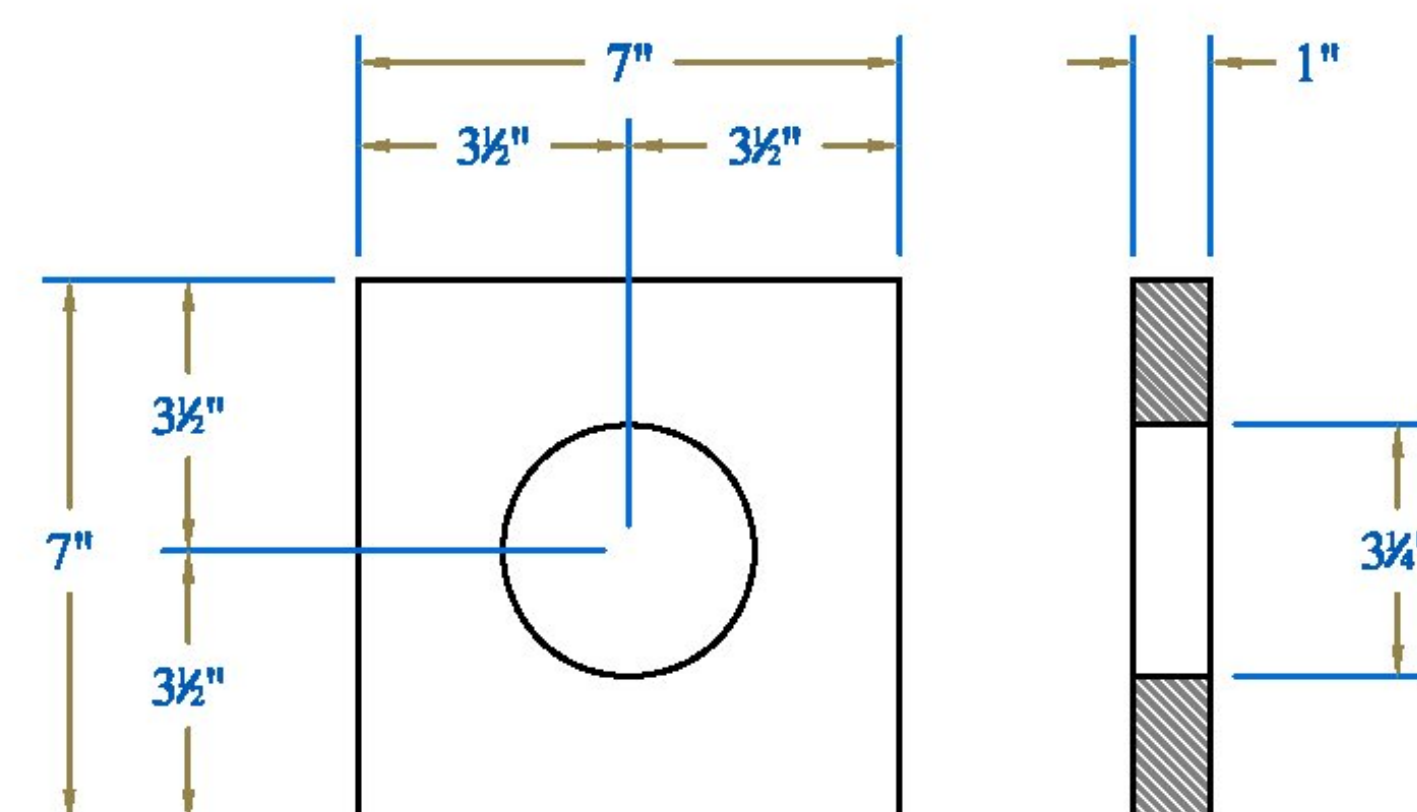

Bearing Plate

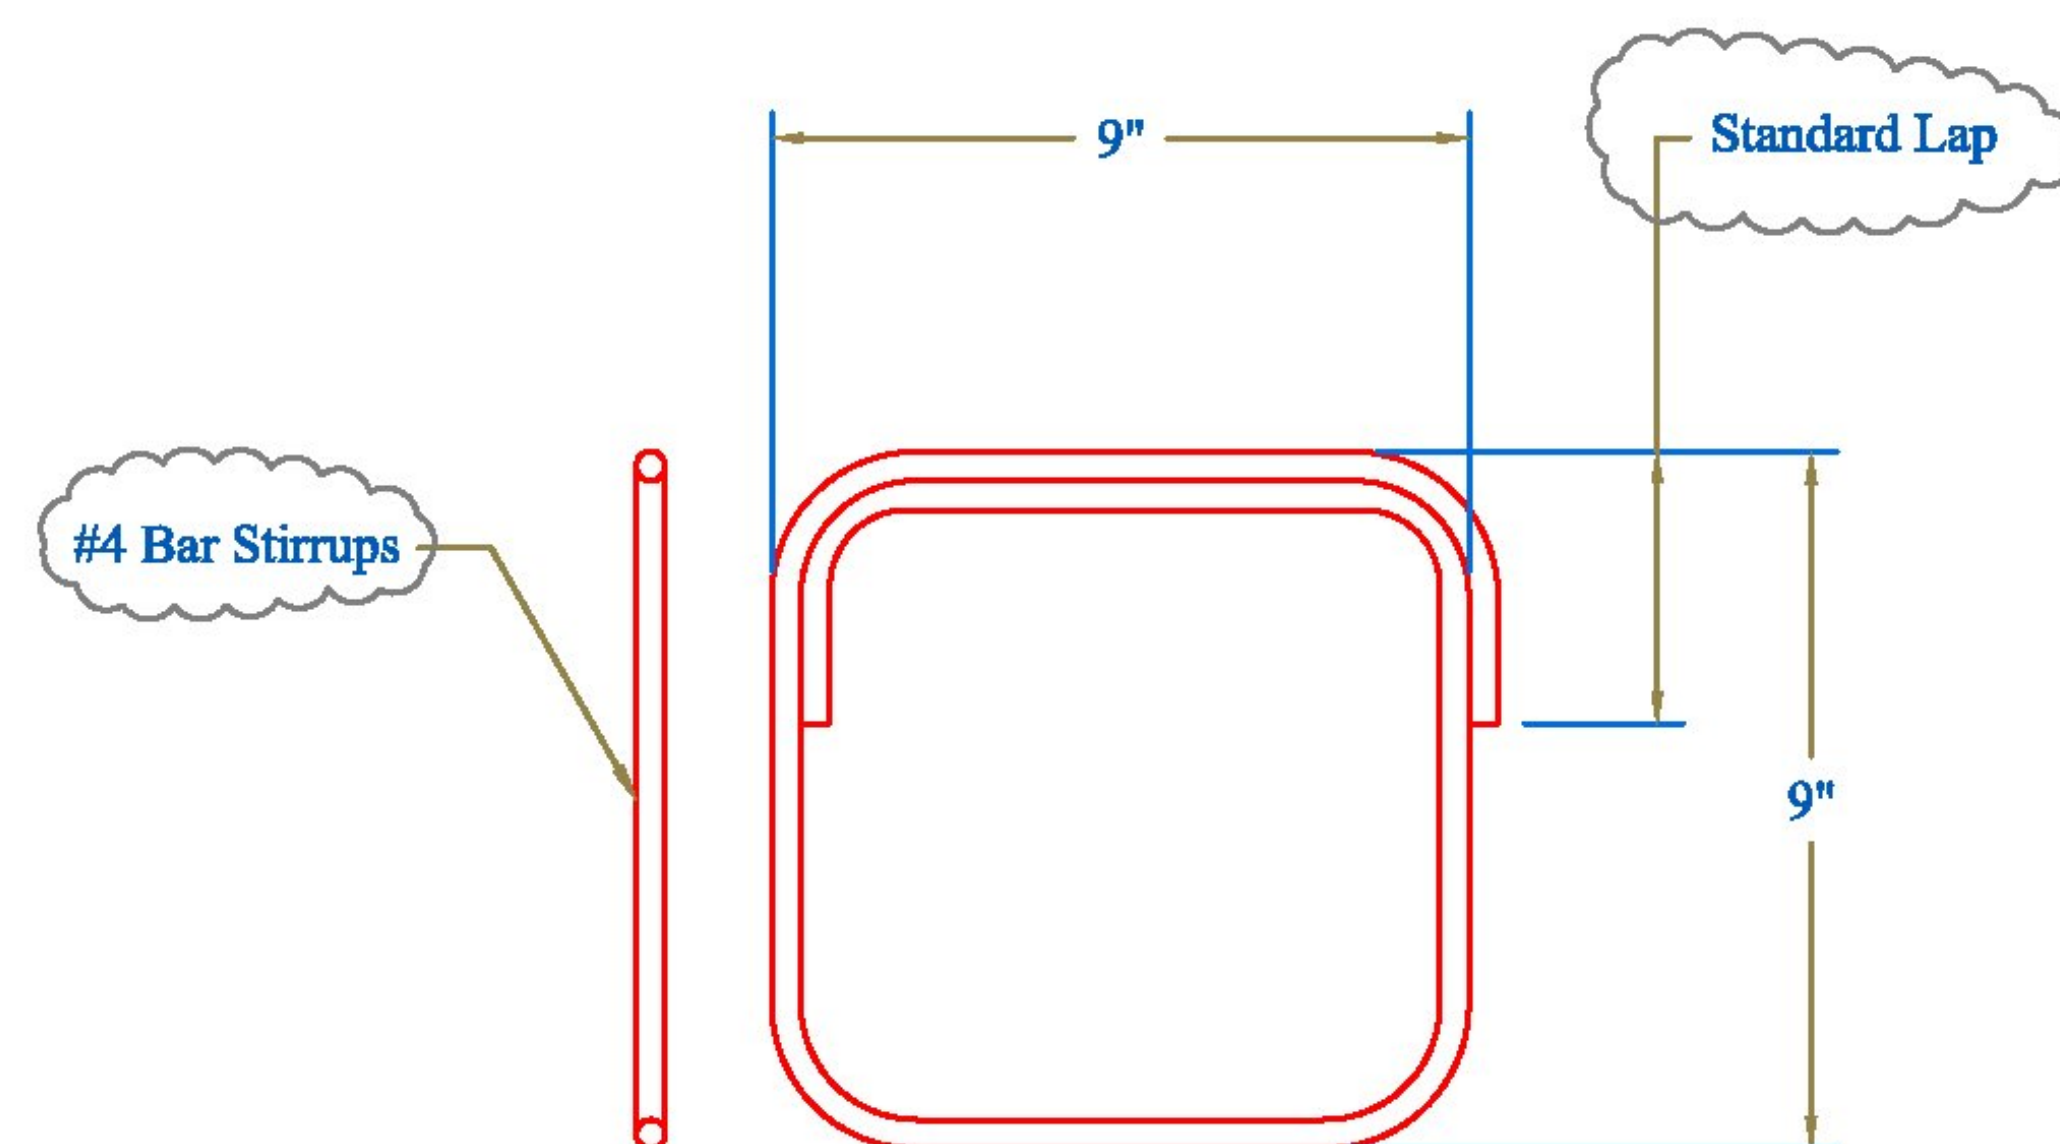


Reinforcement Detail

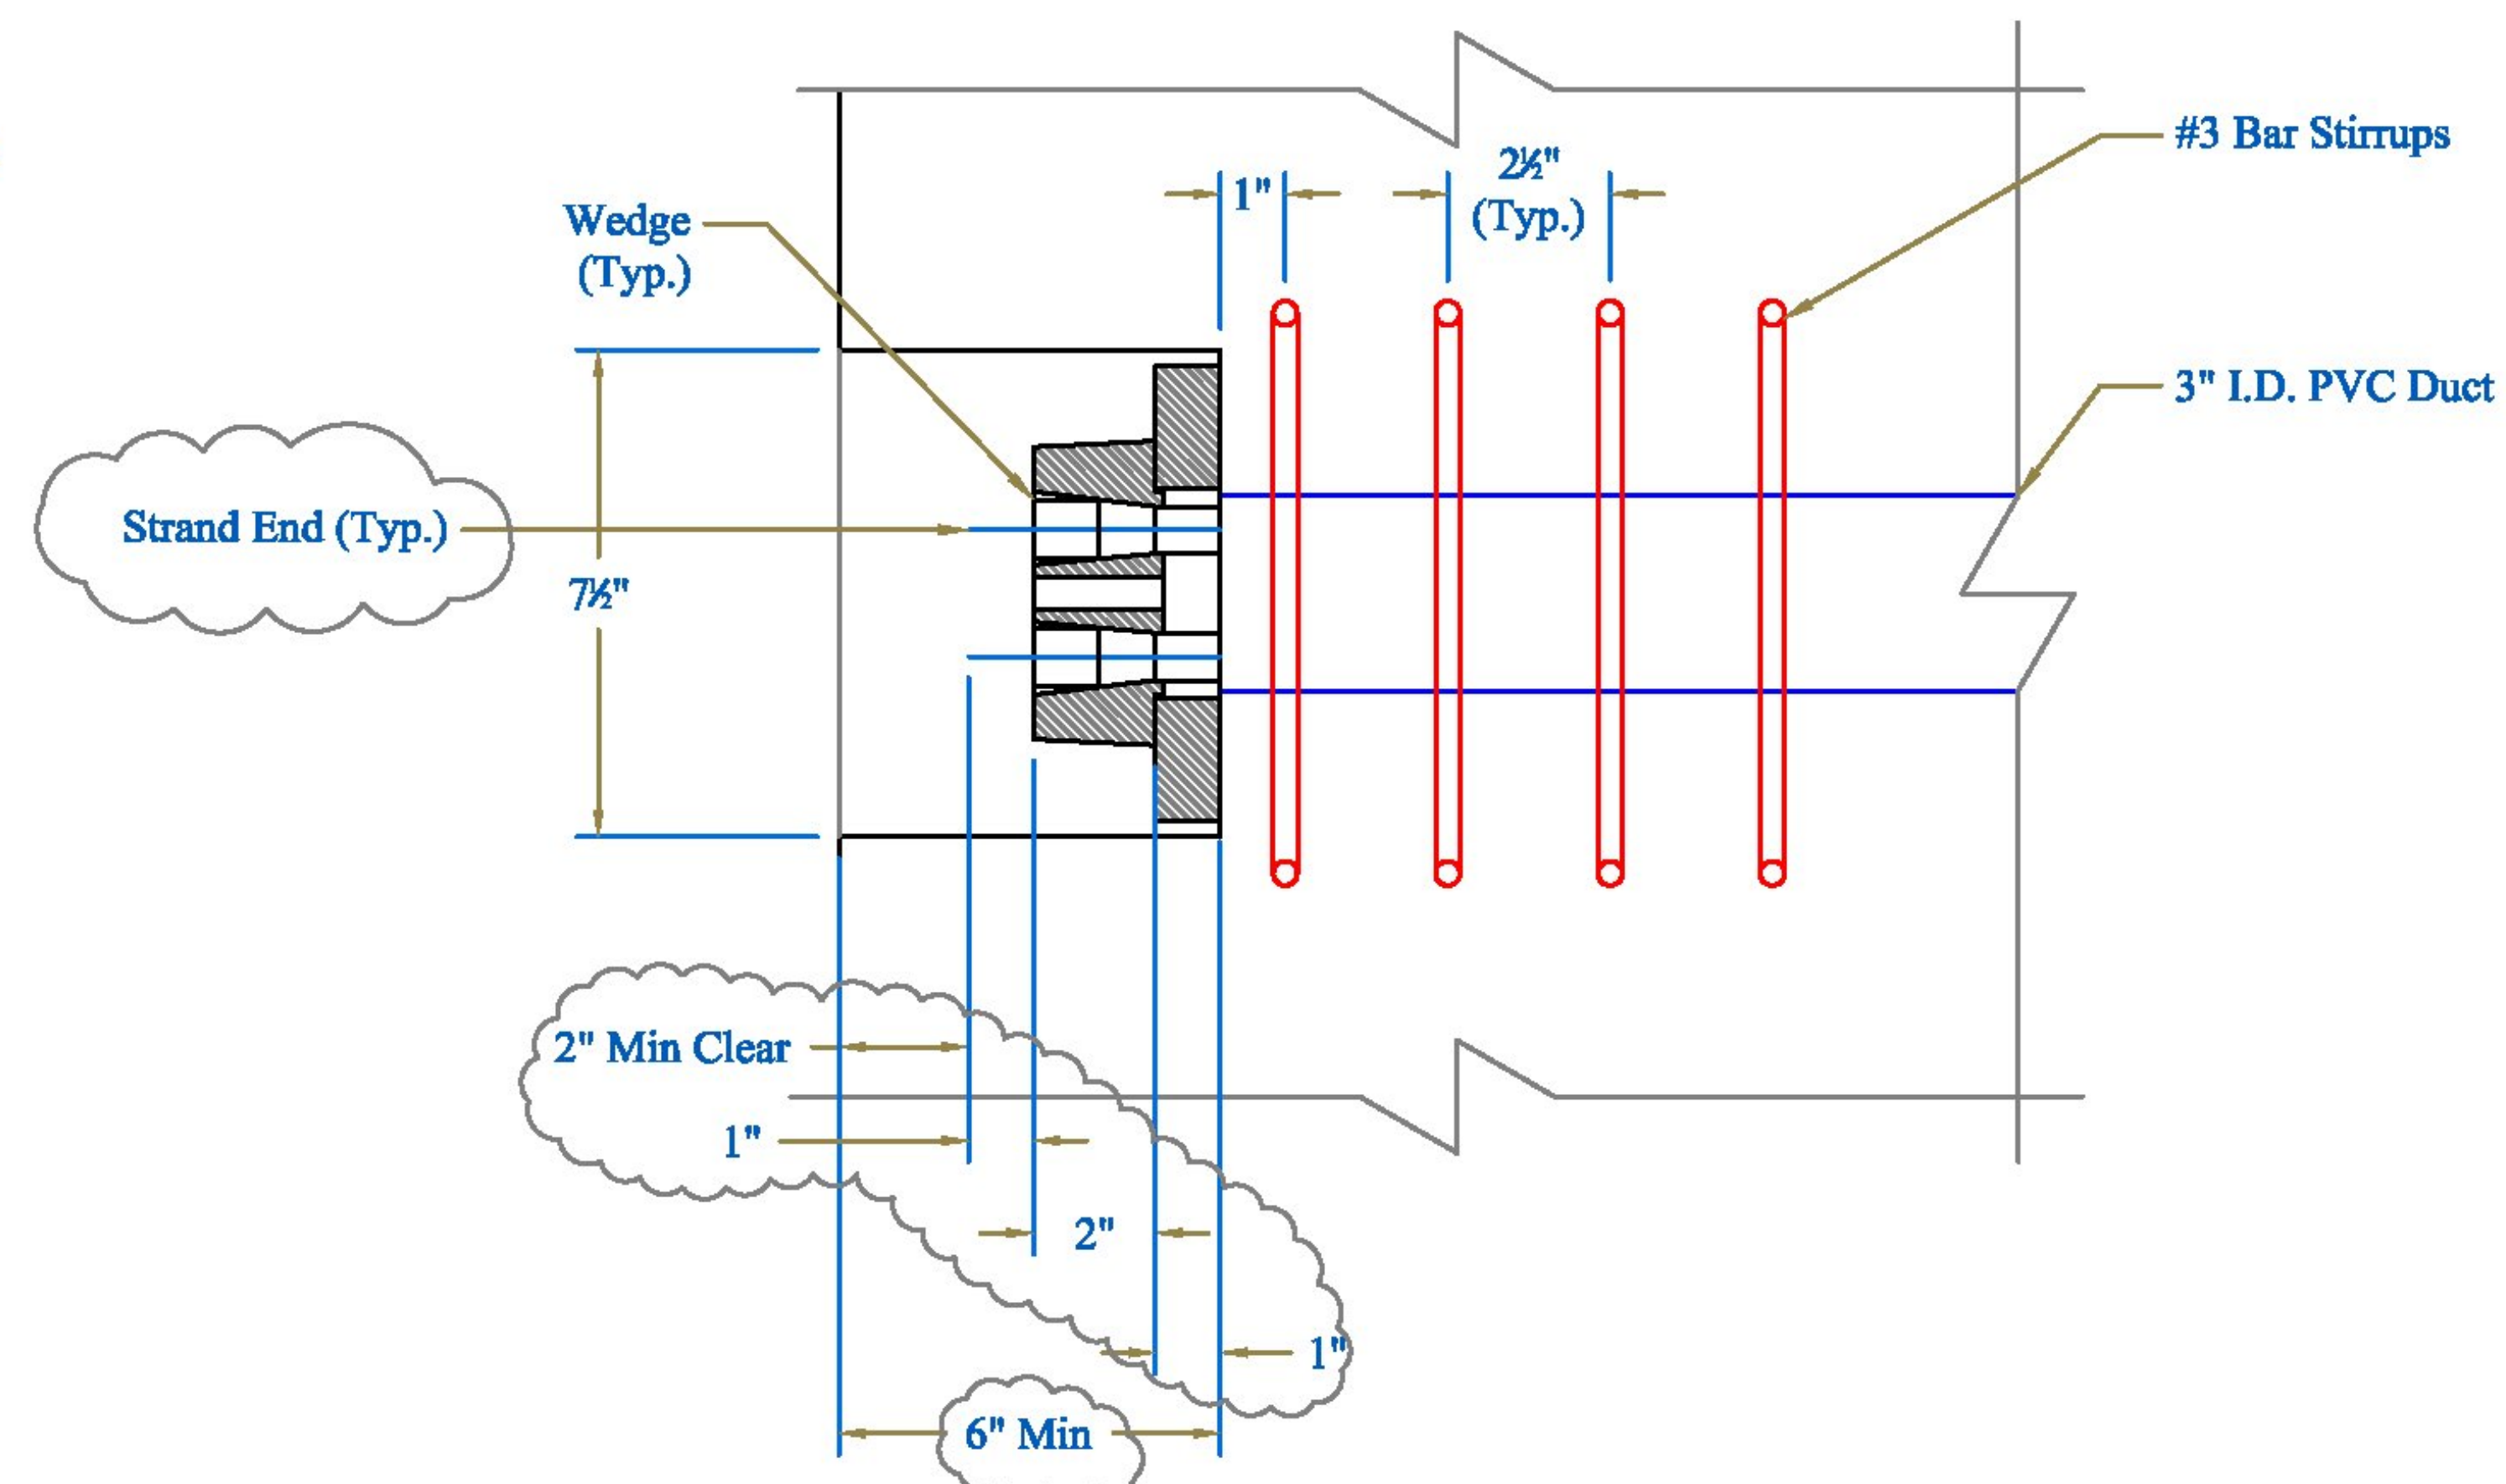

Bearing Plate Section

ANS(A Non Stock) Plate (Manufactured per Request so Not Part #)

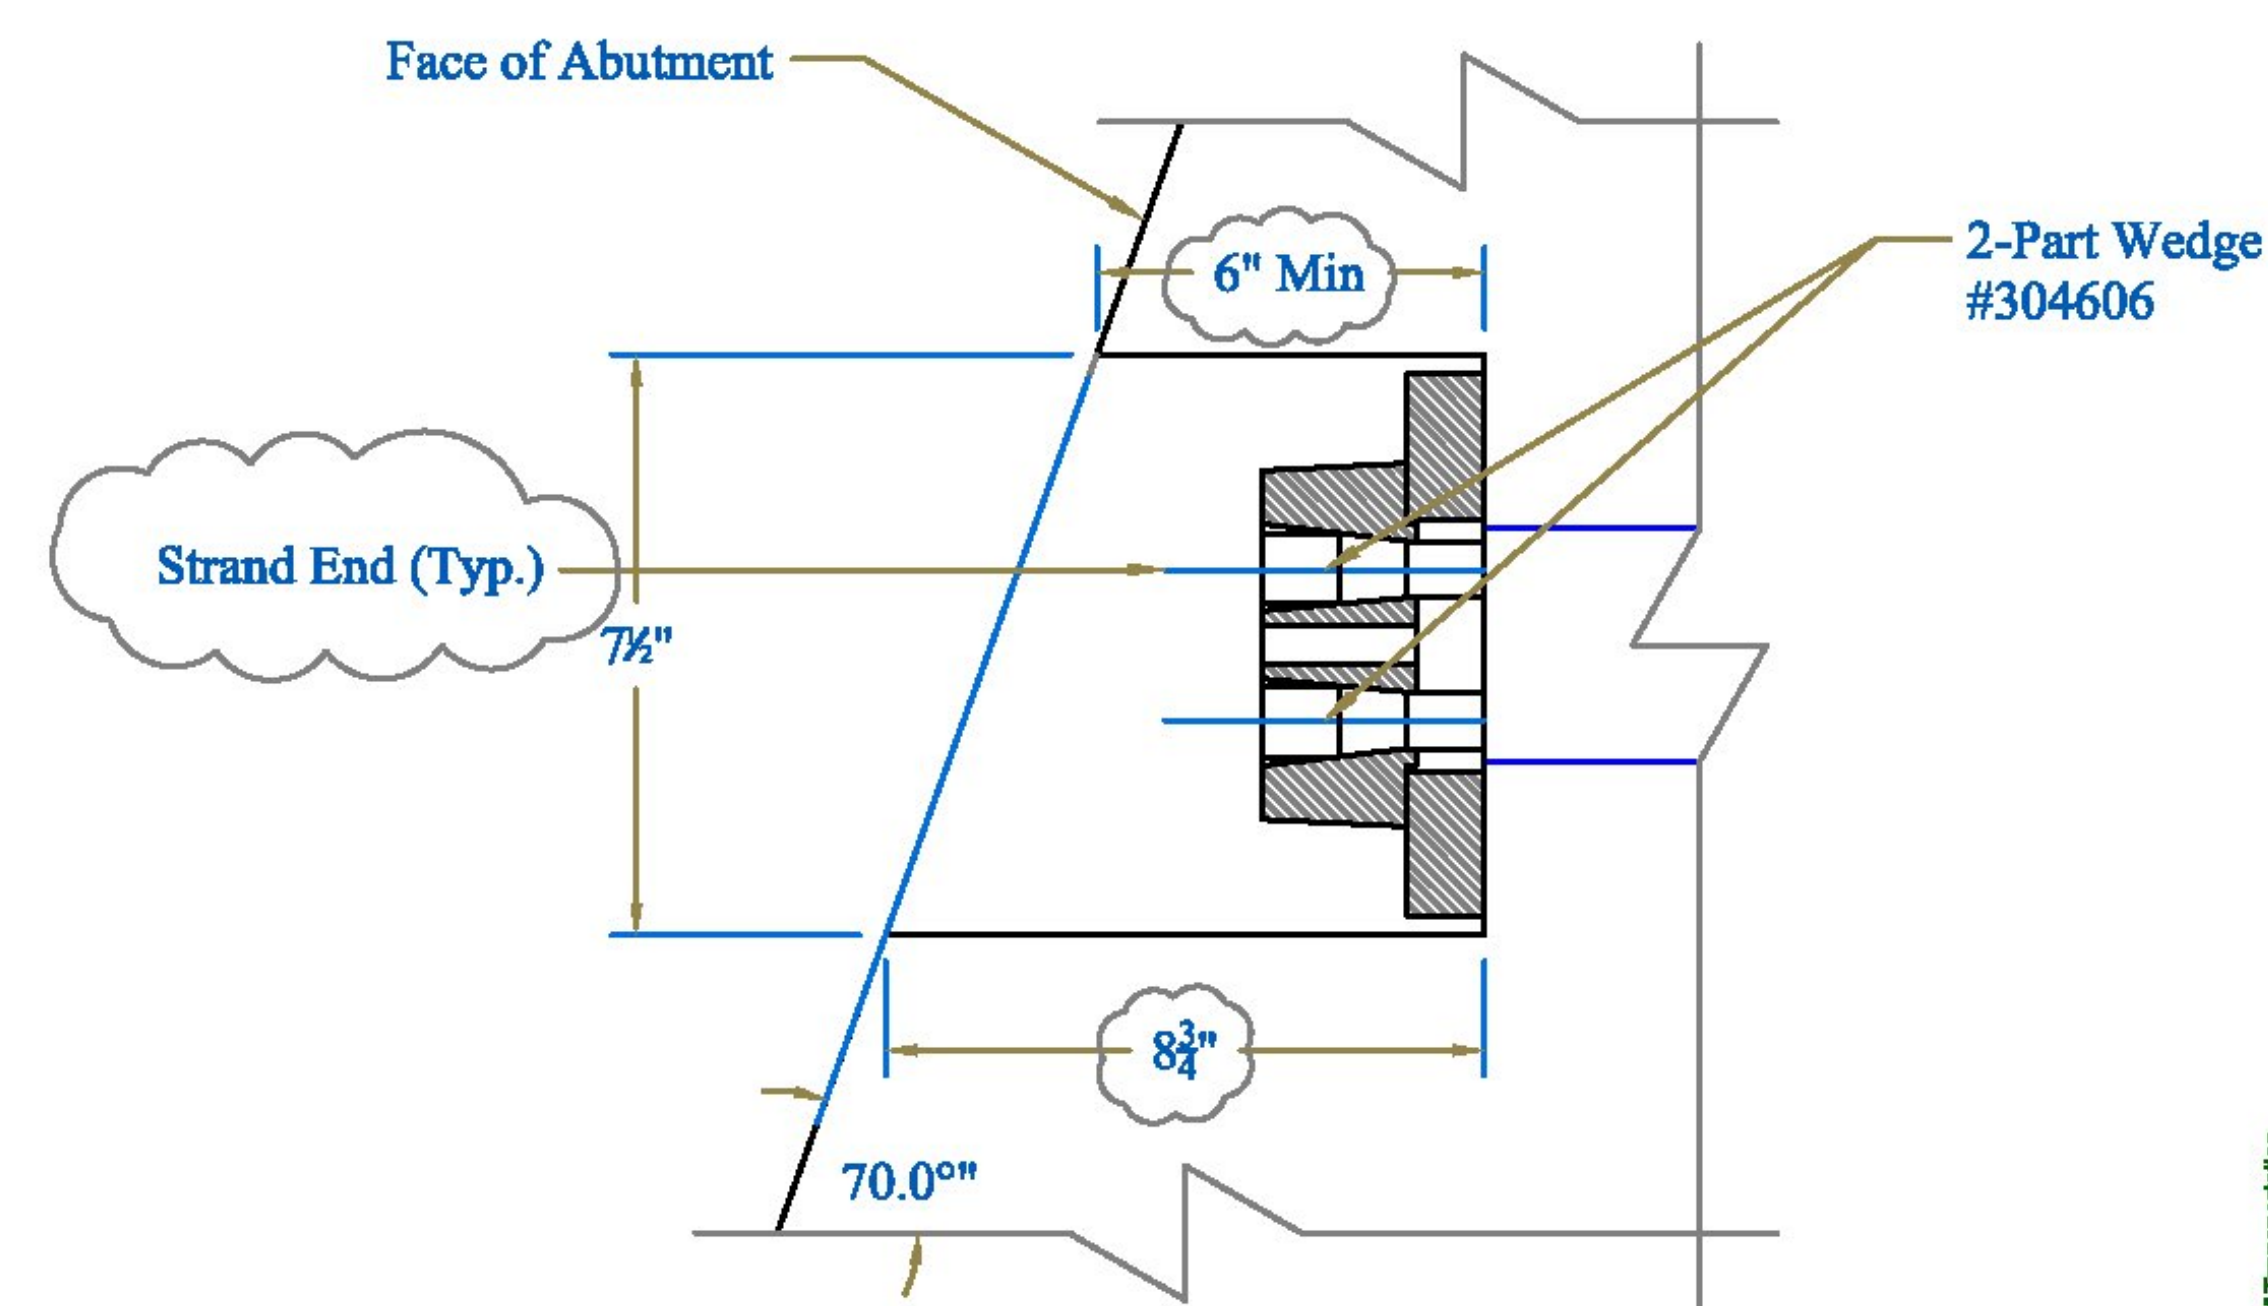

Bearing Plate Plan

RECEIVED	DATE: 6/13/2014
BY: Rob Young	DATE: 6/17/2014
FOR: June 12, 2014	
CONFORMANCE	
APPROVED	APPROVED AS NOTED
REJECTED	
This review is only for general conformance with the design concept and the information given in the Construction Documents. Corrections or comments made on the shop drawings during the review do not relieve the Contractor from compliance with the requirements of the Plans and Specifications. Review of a specific item shall not include review of an assembly of which an item is a component. The Contractor is responsible for dimensions to be confirmed and corrected at the job site; information that pertains solely to the fabrication process or to the means, methods, techniques, sequences and procedures of construction; coordination of the Work with that of other trades and performing all Work in a safe and satisfactory manner.	
McFarland Johnson	By: D. Kull

CONTRACTORS VTSPE:

PRECAST CONCRETE ABUTMENT SHOP DRAWINGS (SDI JOB #14046)

SUPERVISOR: M. WHEELER
 DETAILER: I. ADAMS
 CHECKER: E. Barendse
 ENGINEER: N/A

PROJECT NAME: Warren
 PROJECT #: BRF 013-4(32)
 LOCATION: Bridge #166
 Route 100, Warren, VT

Luck Brothers, Inc
 73 Trade Road
 Plattsburg, NY, 12901
 Ph: (518)-561-4321

04/08/2014

FABRICATOR:
 193 INDUSTRIAL AVE.
 WILLISTON, VT 05495
 Ph: (802) 658-0201

Post Tensioning Details

SD Ireland
 PRECAST

7 of 7