


EN600 = 53,000 Vertical
106,000 Basket

Lift Device = AL Patterson Part # LPA20T10G
Lift Pin Anchor
W/ LPLE20T Lift Eye

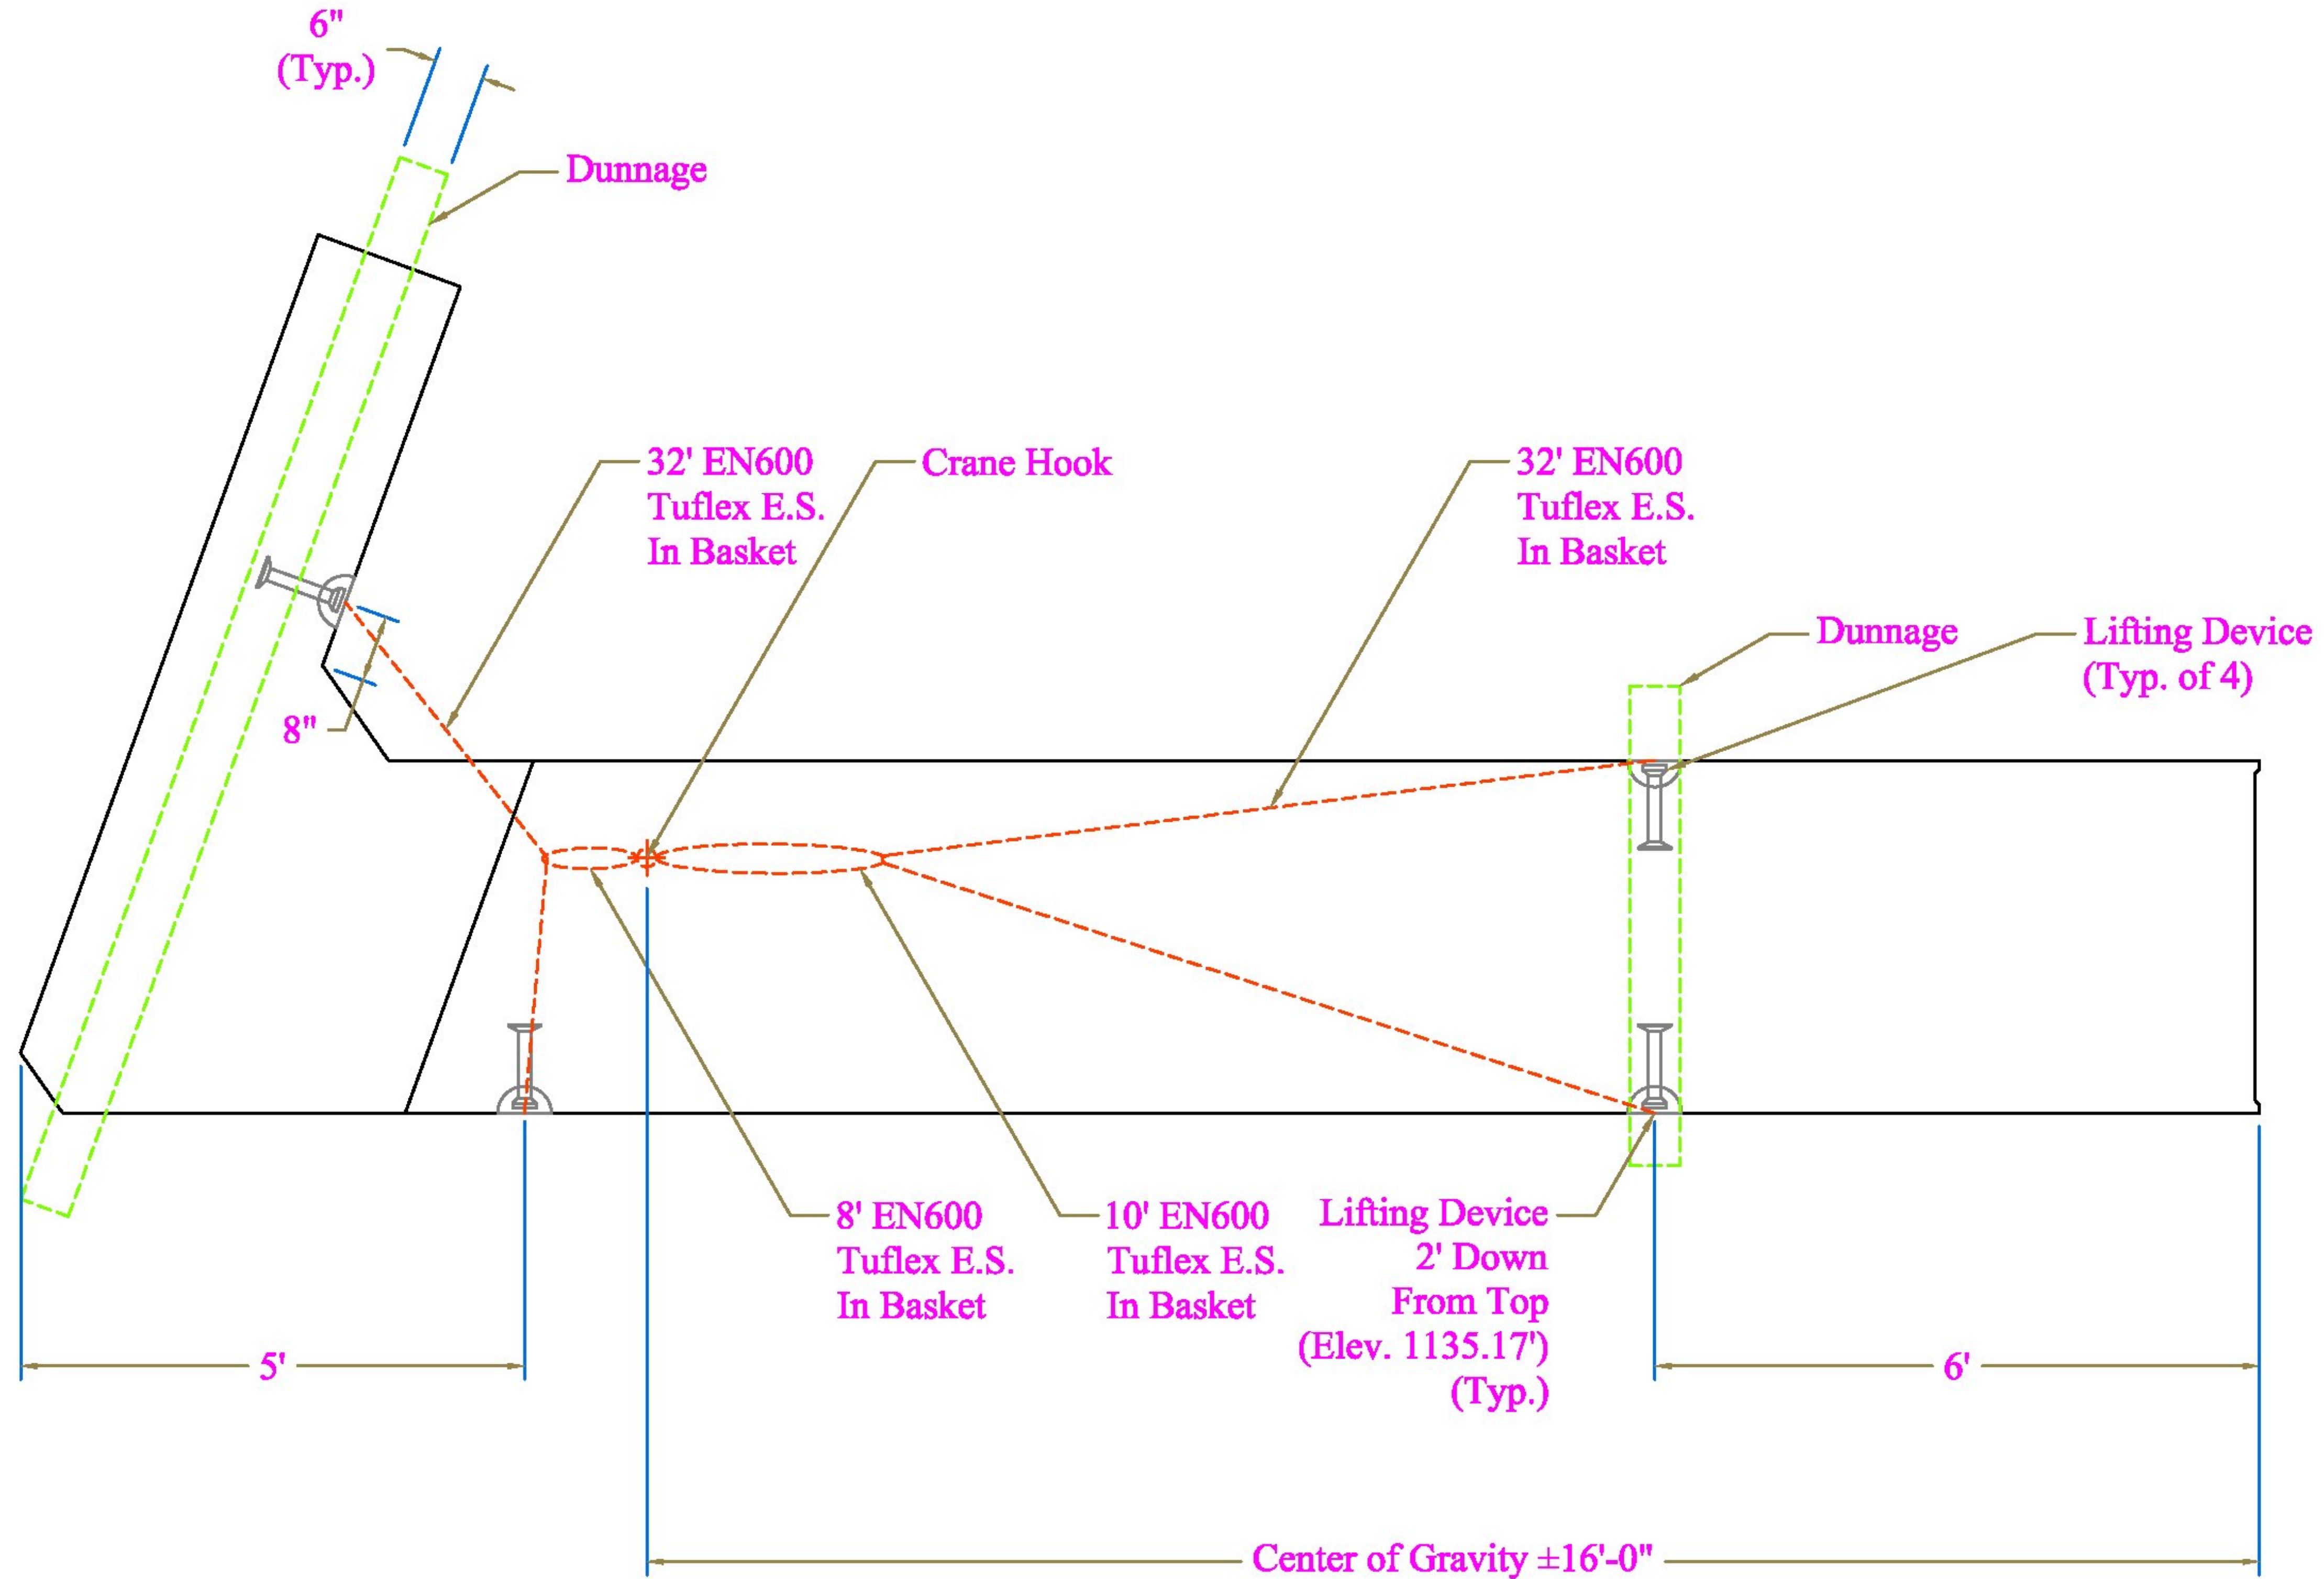

Vermont Agency of Transportation
RECEIVED
ON: June 12, 2014
and Checked for
CONFORMANCE
BY: Rob Young DATE: 6/17/2014

Approved
 Rejected
 Approved As Noted

This review is only for general conformance with the design concept and the information given in the Construction Documents. Corrections or comments made on the shop drawings during the review do not relieve the Contractor from compliance with the requirements of the Plans and Specifications. Review of a specific item shall not include review of an assembly of which an item is a component. The Contractor is responsible for dimensions to be confirmed and corrected at the job site; information that pertains solely to the fabrication process or to the means, methods, techniques, sequences and procedures of construction; coordination of the Work with that of other trades and performing all Work in a safe and satisfactory manner.

Date: 6/13/2014
 By: D. Kull

McFarland Johnson

CONTRACTORS VTSPE:	PRECAST CONCRETE ABUTMENT SHOP DRAWINGS (SDI JOB #14046)		Luck Brothers, Inc 73 Trade Road Plattsburg, NY, 12901 Ph: (518)-561-4321	FABRICATOR: 193 INDUSTRIAL AVE. WILLISTON, VT 05495 Ph: (802) 658-0201	
	SUPERVISOR: M. WHEELER DETAILER: I. ADAMS CHECKER: E. Barendse ENGINEER: N/A	PROJECT NAME: Warren PROJECT #: BRF 013-4(32) LOCATION: Bridge #166 Route 100, Warren, VT	03/03/2014	AB1L & AB2L Lifting	