


EN600 = 53,000 Vertical  
106,000 Basket

Lift Device = AL Patterson Part # LPA20T10G  
Lift Pin Anchor  
W/ LPLE20T Lift Eye

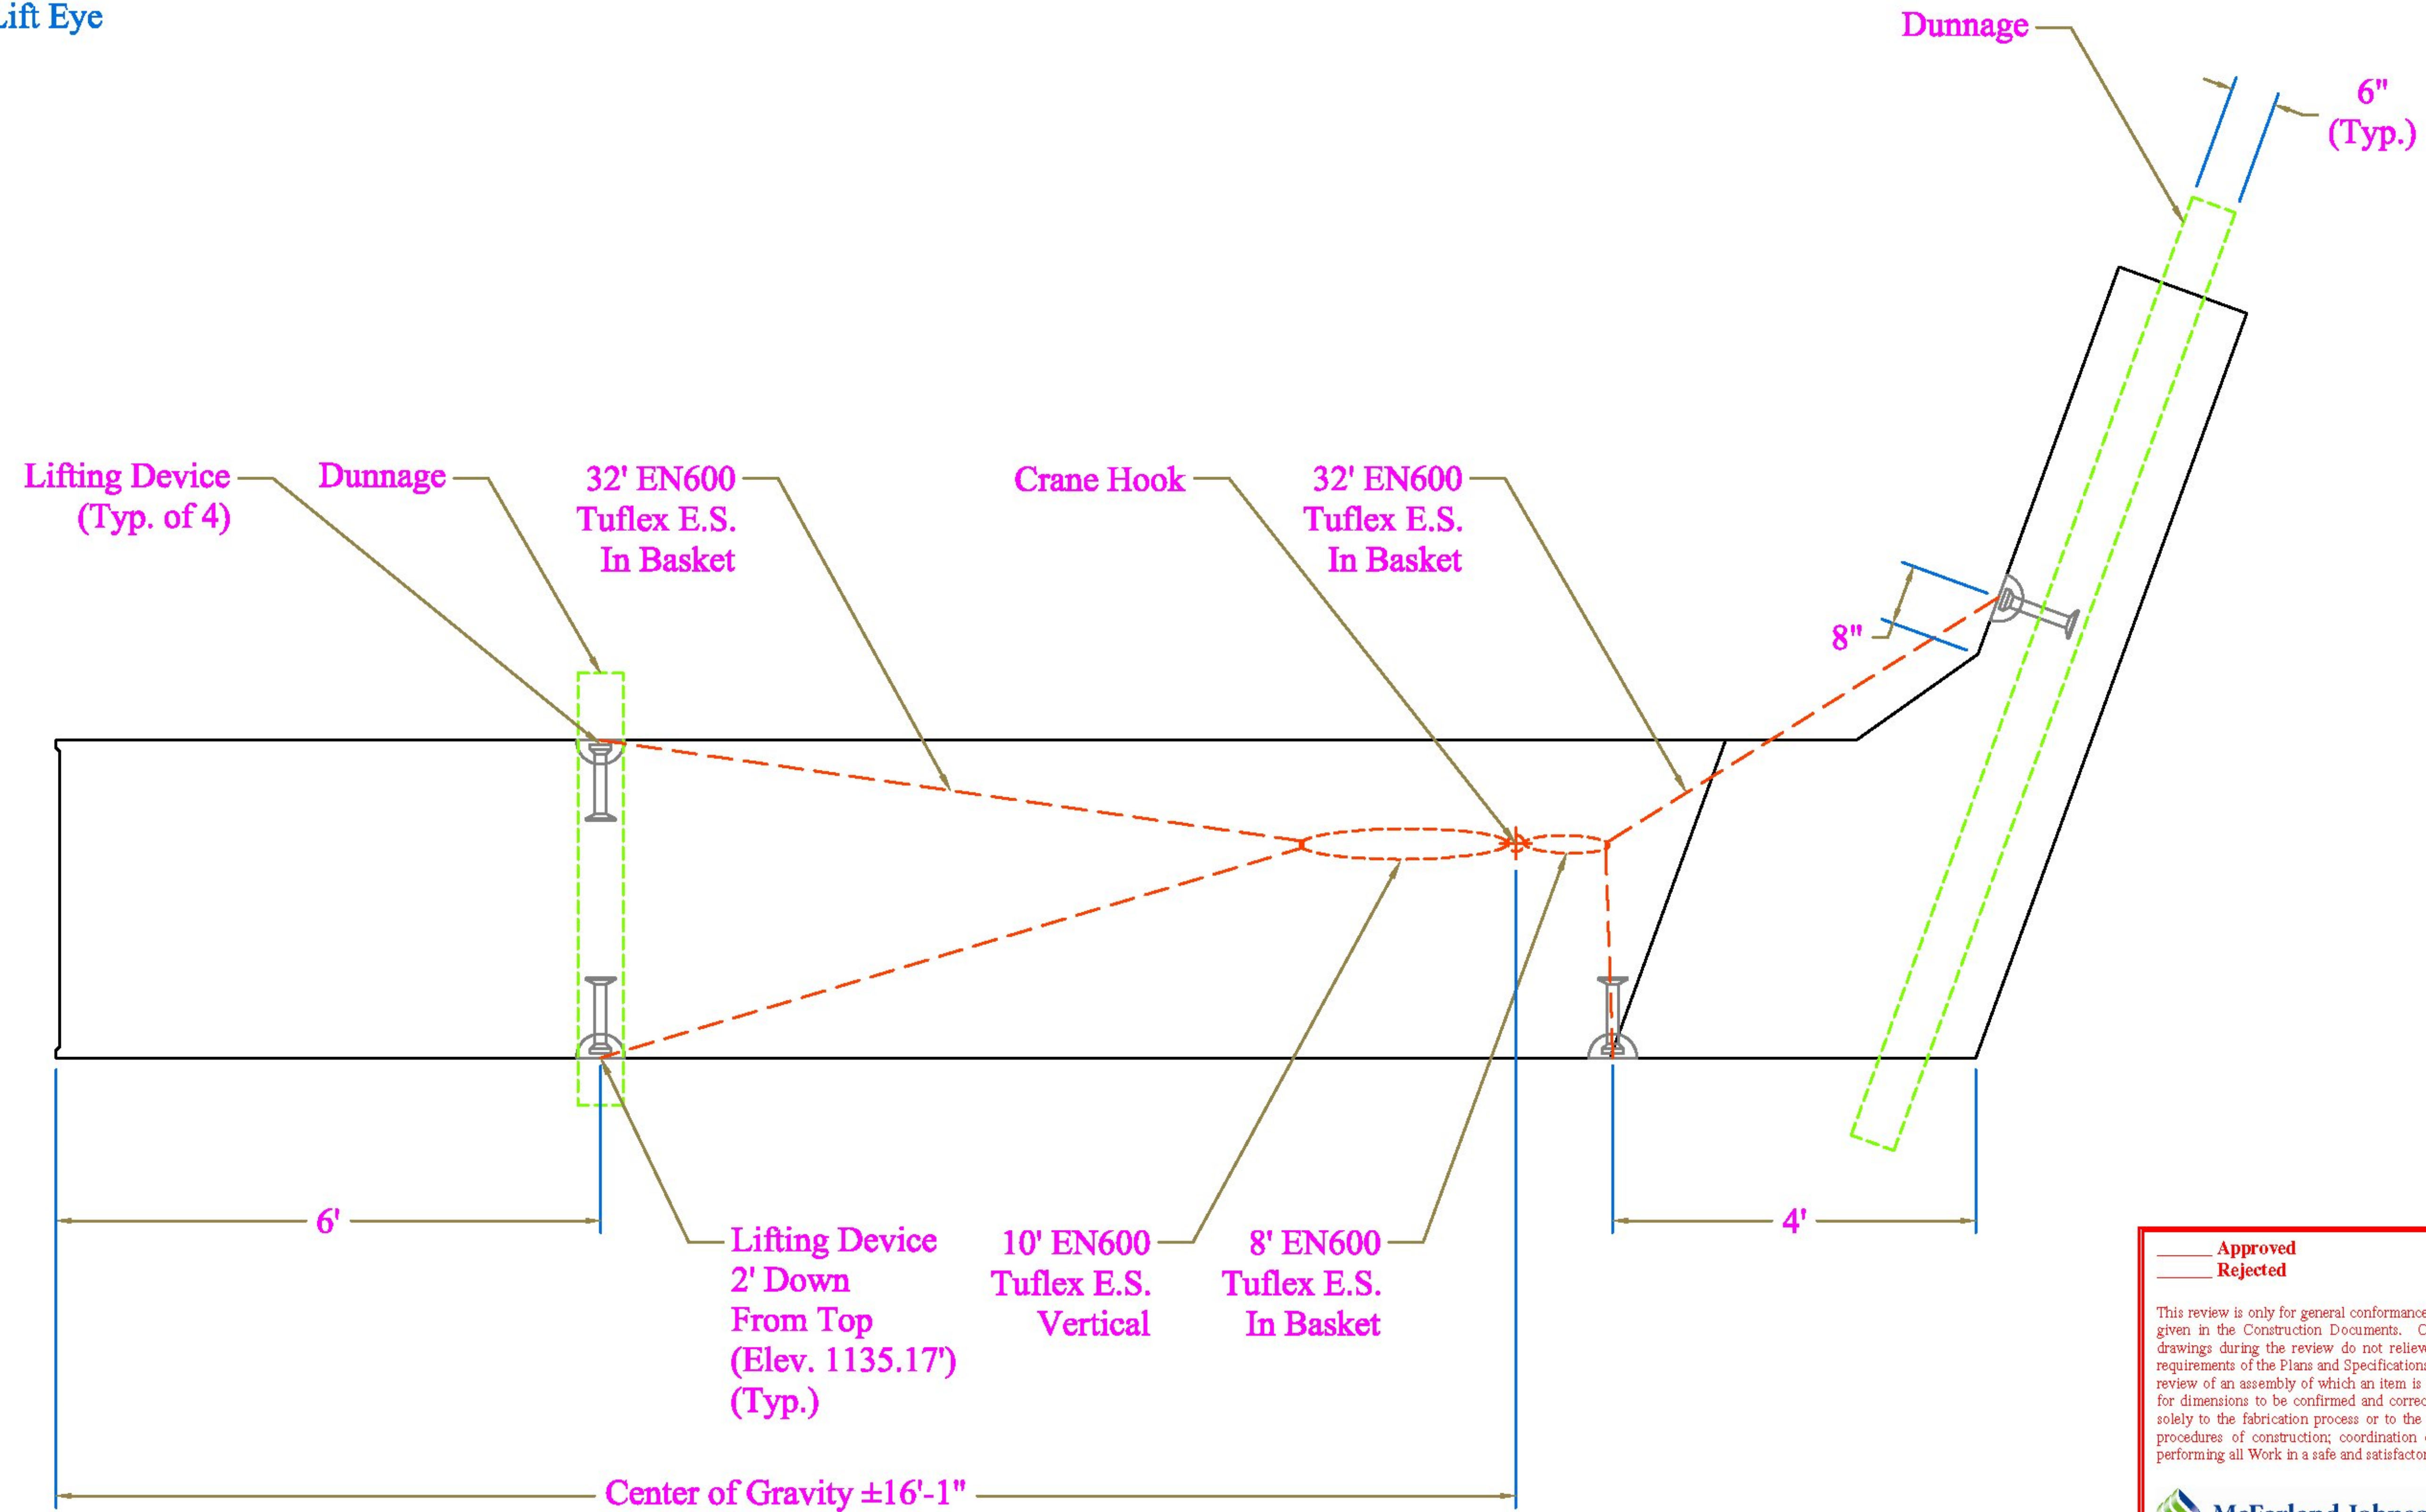

Vermont Agency of Transportation  
**RECEIVED**  
ON: June 12, 2014  
and Checked for  
**CONFORMANCE**  
BY: Rob Young DATE: 6/17/2014

— Approved	— X — Approved As Noted
— Rejected	

This review is only for general conformance with the design concept and the information given in the Construction Documents. Corrections or comments made on the shop drawings during the review do not relieve the Contractor from compliance with the requirements of the Plans and Specifications. Review of a specific item shall not include review of an assembly of which an item is a component. The Contractor is responsible for dimensions to be confirmed and corrected at the job site; information that pertains solely to the fabrication process or to the means, methods, techniques, sequences and procedures of construction; coordination of the Work with that of other trades and performing all Work in a safe and satisfactory manner.

Date: 6/13/2014  
By: D. Kull

**McFarland Johnson**

CONTRACTORS VTSPE:

PRECAST CONCRETE ABUTMENT SHOP DRAWINGS (SDI JOB #14046)  
SUPERVISOR: M. WHEELER  
DETAILER: I. ADAMS  
CHECKER: E. Barendse  
ENGINEER: N/A

PROJECT NAME: Warren  
PROJECT #: BRF 013-4(32)  
LOCATION: Bridge #166  
Route 100, Warren, VT

Luck Brothers, Inc  
73 Trade Road  
Plattsburg, NY, 12901  
Ph: (518)-561-4321  
03/03/2014

FABRICATOR:  
193 INDUSTRIAL AVE.  
WILLISTON, VT 05495  
Ph: (802) 658-0201



AB1R & AB2R Lifting