


NOTES:

- 1) ALL NEW TRAFFIC SIGNAL EQUIPMENT IS TO BE INSTALLED AT THE EXISTING EQUIPMENT LOCATIONS. TO BE PAID UNDER THE APPROPRIATE SECTION 900 PAY ITEM FOR THIS INTERSECTION.
- 2) EXISTING CONTROLLER TIMINGS SHALL BE RETAINED.
- 3) THE EXISTING TRAFFIC SIGNAL EQUIPMENT REMOVED IS TO BE SALVAGED AND RETURNED BY THE CONTRACTOR TO THE VTRANS TRAFFIC SHOP IN BERLIN, VT WITHIN 48 HOURS OF REMOVAL. CONTACT RUSS VELANDER AT 828-3535 WITH ANY QUESTIONS. SEE THE SPECIAL PROVISIONS FOR ADDITIONAL INFORMATION AND REQUIREMENTS.
- 4) ANY OTHER MISCELLANEOUS EQUIPMENT AND LABOR NECESSARY TO PROVIDE A FULLY FUNCTIONAL TRAFFIC SIGNAL SYSTEM SHALL BE INCIDENTAL TO THE SECTION 900 PAY ITEMS FOR THIS INTERSECTION.

| LIST OF MAJOR EQUIPMENT | QUANTITY |
|---|----------|
| ITEM #900.620 SPECIAL PROVISION (REMOVE AND REPLACE TRAFFIC SIGNAL CONTROLLER AND CABINET) (BUS 4 @ VT 3 & TH 44) | |
| ECONOLITE ASC/3-2100 OR NAZTEC MODEL 980 CONTROLLER | 1 EA |
| ECONOLITE OR NAZTEC "M" POLE MOUNTED CONTROLLER CABINET PAINTED FLAT BLACK WITH ANCILLARY CONTROL EQUIPMENT. | 1 EA |
| ITEM #900.645 SPECIAL PROVISION (VEHICLE SIGNAL HEADS, LED) (BUS 4 @ VT 3 & TH 44) | |
| ONE WAY, 3-SECTION, 12" POLYCARBONATE SPAN WIRE MOUNTED LED TRAFFIC SIGNAL HEADS WITH TUNNEL VISORS, LOUVERED BACKPLATES, AND SPAN WIRE DISCONNECT BRACKETS. ALL PIECES PAINTED FLAT BLACK. | 10 EA |

SIGNAL FACE ARRANGEMENT

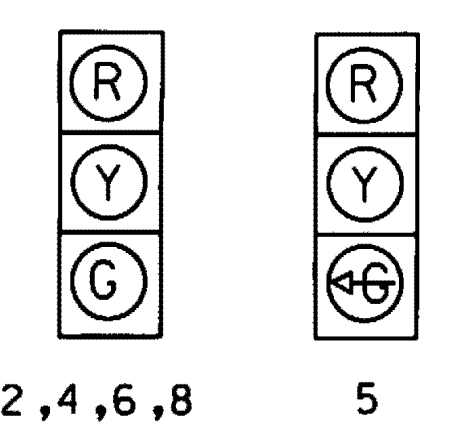

CONSTRUCTION ACTIVITIES WILL BE SHORT DURATION AND WILL LIKELY RESULT IN MINIMAL IMPACT TO THE TRAVELING PUBLIC. ALL WORK SHALL BE PERFORMED DURING DAYTIME, OFF-PEAK HOURS. REFER TO THE VERMONT AGENCY OF TRANSPORTATION STANDARD DRAWINGS E-110 AND E-111 FOR ADDITIONAL INFORMATION. TRAFFIC CONTROL WARNING SIGNS SHALL BE PROVIDED AS NECESSARY ON EACH APPROACH PER THE MANUAL ON UNIFORM TRAFFIC CONTROL DEVICES (MUTCD). PAYMENT FOR THESE SIGNS, REFLECTORIZED PLASTIC DRUMS, ECT. SHALL BE PAID UNDER CONTRACT ITEM 641.10. PEDESTRIAN ACCESSIBILITY MUST BE MAINTAINED AT ALL TIMES.

N.T.S.

RUTLAND TOWN
BUS 4 @ VT 3 & TH 44

| | |
|--|------------------------|
| PROJECT NAME: CASTLETON - RUTLAND TOWN | PLOT DATE: 31-JAN-2011 |
| PROJECT NUMBER: STPG SGNL (37) | DRAWN BY: B. MCAVOY |
| FILE NAME: I0c080/Traffic/tc080nul.dg | CHECKED BY: B. NYQUIST |
| PROJECT LEADER: B. NYQUIST | SHEET 4 OF 4 |
| DESIGNED BY: B. MCAVOY | |
| TRAFFIC SIGNAL SHEET 2 | |