

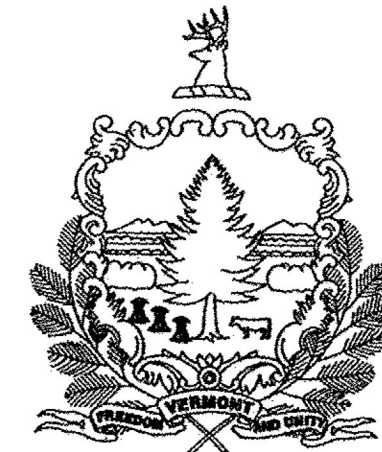


STATE OF VERMONT AGENCY OF TRANSPORTATION

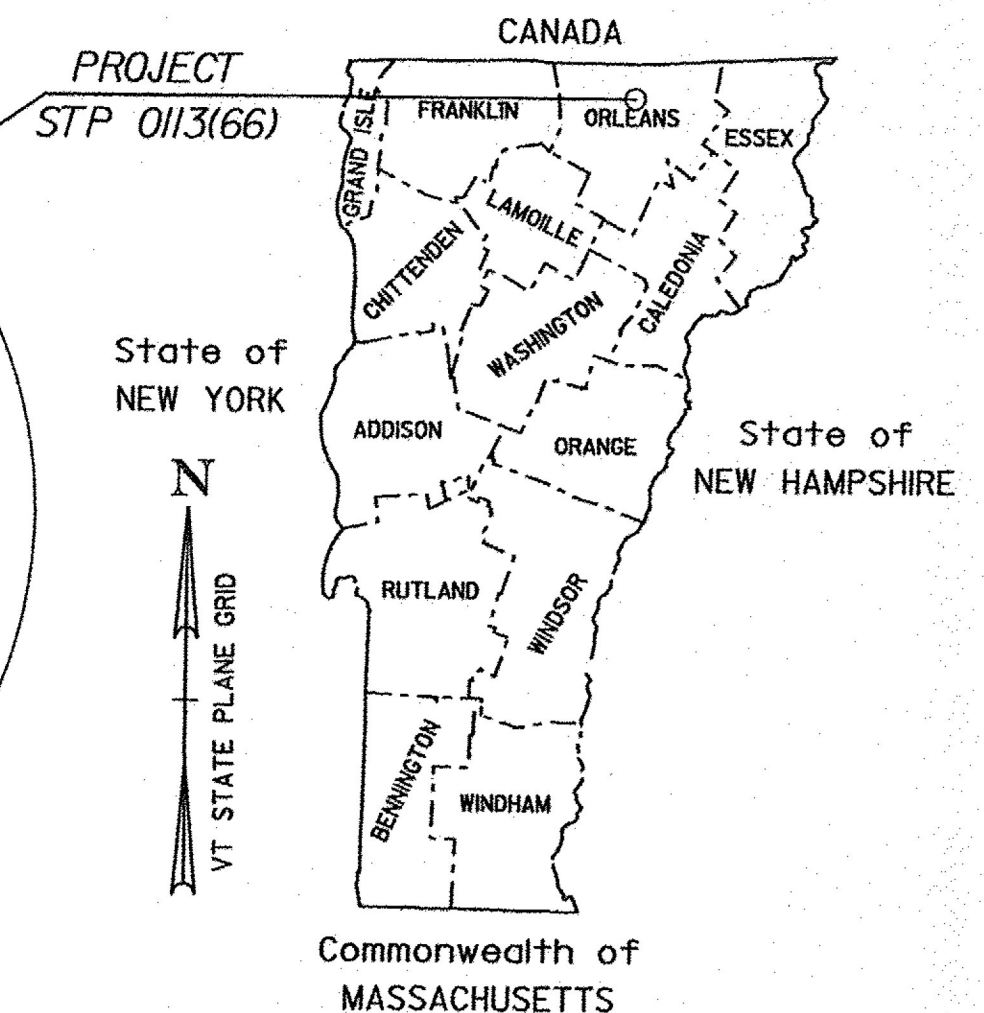

PROPOSED IMPROVEMENT TOWN OF COVENTRY COUNTY OF ORLEANS U.S. ROUTE 5 (MAJOR COLLECTOR)

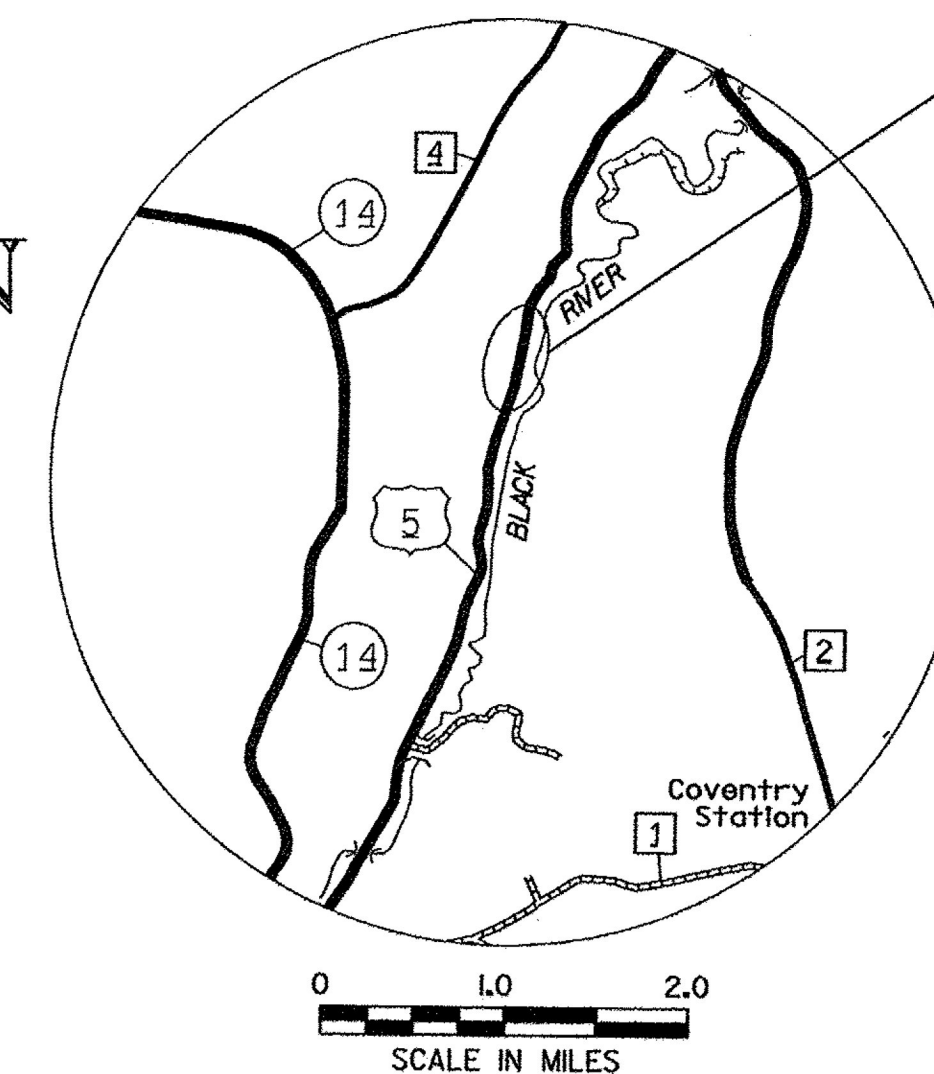


RECORD PLANS	
CONTRACTOR:	WINTerset, INC. - LYNDONVILLE, VT
RESIDENT ENGINEER:	MIKE BOOTH
CONSTRUCTION BEGAN:	JUNE 26, 2017
CONSTRUCTION COMPLETE:	SEPTEMBER 22, 2017
RECORD PLANS BY:	MIKE BOOTH & JESSE IVES
I HEREBY CERTIFY THAT ALL THE CONSTRUCTION REQUIRED BY THIS SET OF DRAWINGS HAS BEEN ACCOMPLISHED AS INDICATED HEREIN.	
BY	RESIDENT ENGINEER
DATE <u>10-9-18</u>	
NOTE: Any further information concerning final quantities, amounts or other details relative to this project may be found at Central Files in the electronic archives.	

PROJECT LOCATION: BEGINNING IN THE TOWN OF COVENTRY ON U.S. ROUTE 5 AT STATION 174+50.00 (MM 3.305) EXTENDING NORTHERLY 610.00 FEET (0.116 MILES) TO STATION 180+60.00 (MM 3.420)

PROJECT DESCRIPTION: WORK TO BE PERFORMED UNDER THIS PROJECT INCLUDES APPLICATION OF SHOTCRETE FACING ON THE SLOPE FACE, INSTALLATION OF ROCK DOWELS, HAND AND MACHINE SCALING OF SLOPE FACE.


LENGTH OF PROJECT: 610.00 FT 0.116 MILES

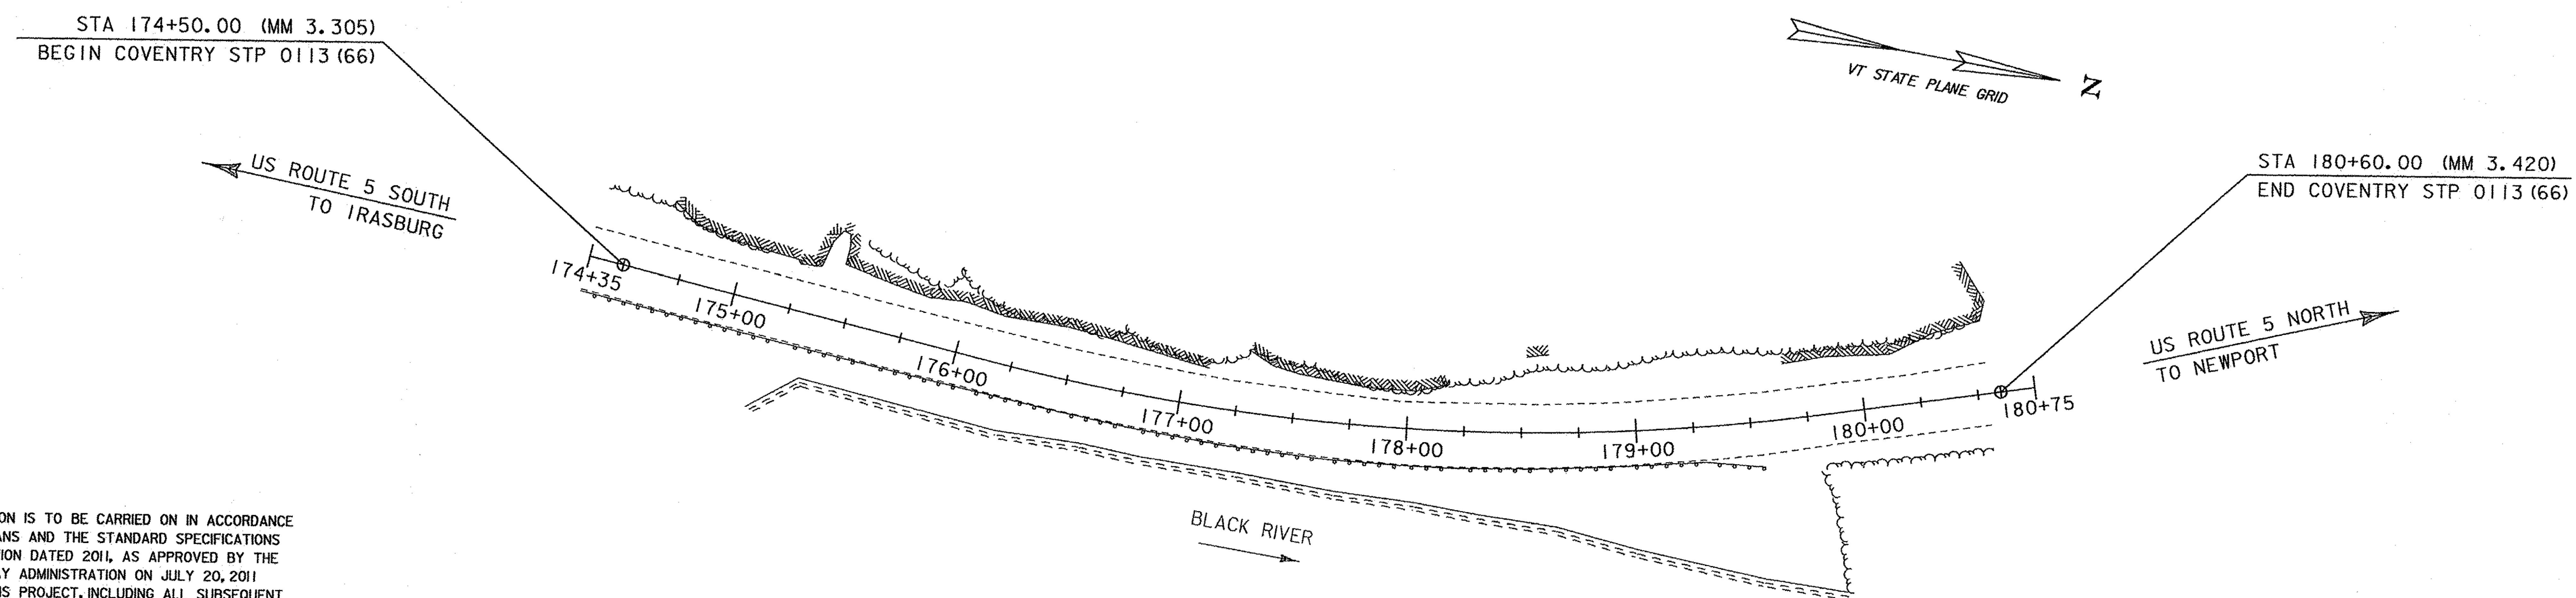

CONSTRUCTION IS TO BE CARRIED ON IN ACCORDANCE WITH THESE PLANS AND THE STANDARD SPECIFICATIONS FOR CONSTRUCTION DATED 2011, AS APPROVED BY THE FEDERAL HIGHWAY ADMINISTRATION ON JULY 20, 2011 FOR USE ON THIS PROJECT, INCLUDING ALL SUBSEQUENT REVISIONS AND SUCH REVISED SPECIFICATIONS AND SPECIAL PROVISIONS AS ARE INCORPORATED IN THESE PLANS.

QUALITY ASSURANCE PROGRAM : LEVEL 2	
SURVEYED BY : VTRANS	
SURVEYED DATE : 07/29/10	
DATUM	
VERTICAL	NAVD 88
HORIZONTAL	NAD 83 (07)

TRAFFIC DATA - U.S. ROUTE 5					
YEAR	AADT	DHV	ADTT	% T	% D
2014	2600	280	400	11.6	57
2024	2700	290	470	13.1	57
<small>18 kip ESAL for flexible pavement from 2014 to 2024: 1,714,000 - 10 YRS 18 kip ESAL for flexible pavement from 2014 to 2034: 3,681,000 - 20 YRS Design speed: 50 MPH</small>					

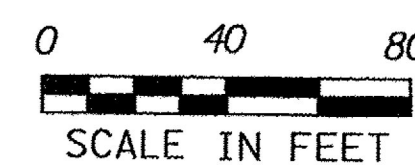

DIRECTOR OF PROJECT DELIVERY	
APPROVED	DATE <u>2/15/2017</u>
PROJECT MANAGER : KEN UPMAL, P.E.	
PROJECT NAME : COVENTRY	
PROJECT NUMBER : STP 0113(66)	
SHEET 1 OF 29 SHEETS	