



TYPICAL ROCK DOWEL DETAIL

PAY ITEM 900.640 SPECIAL PROVISION (ROCK DOWELING)

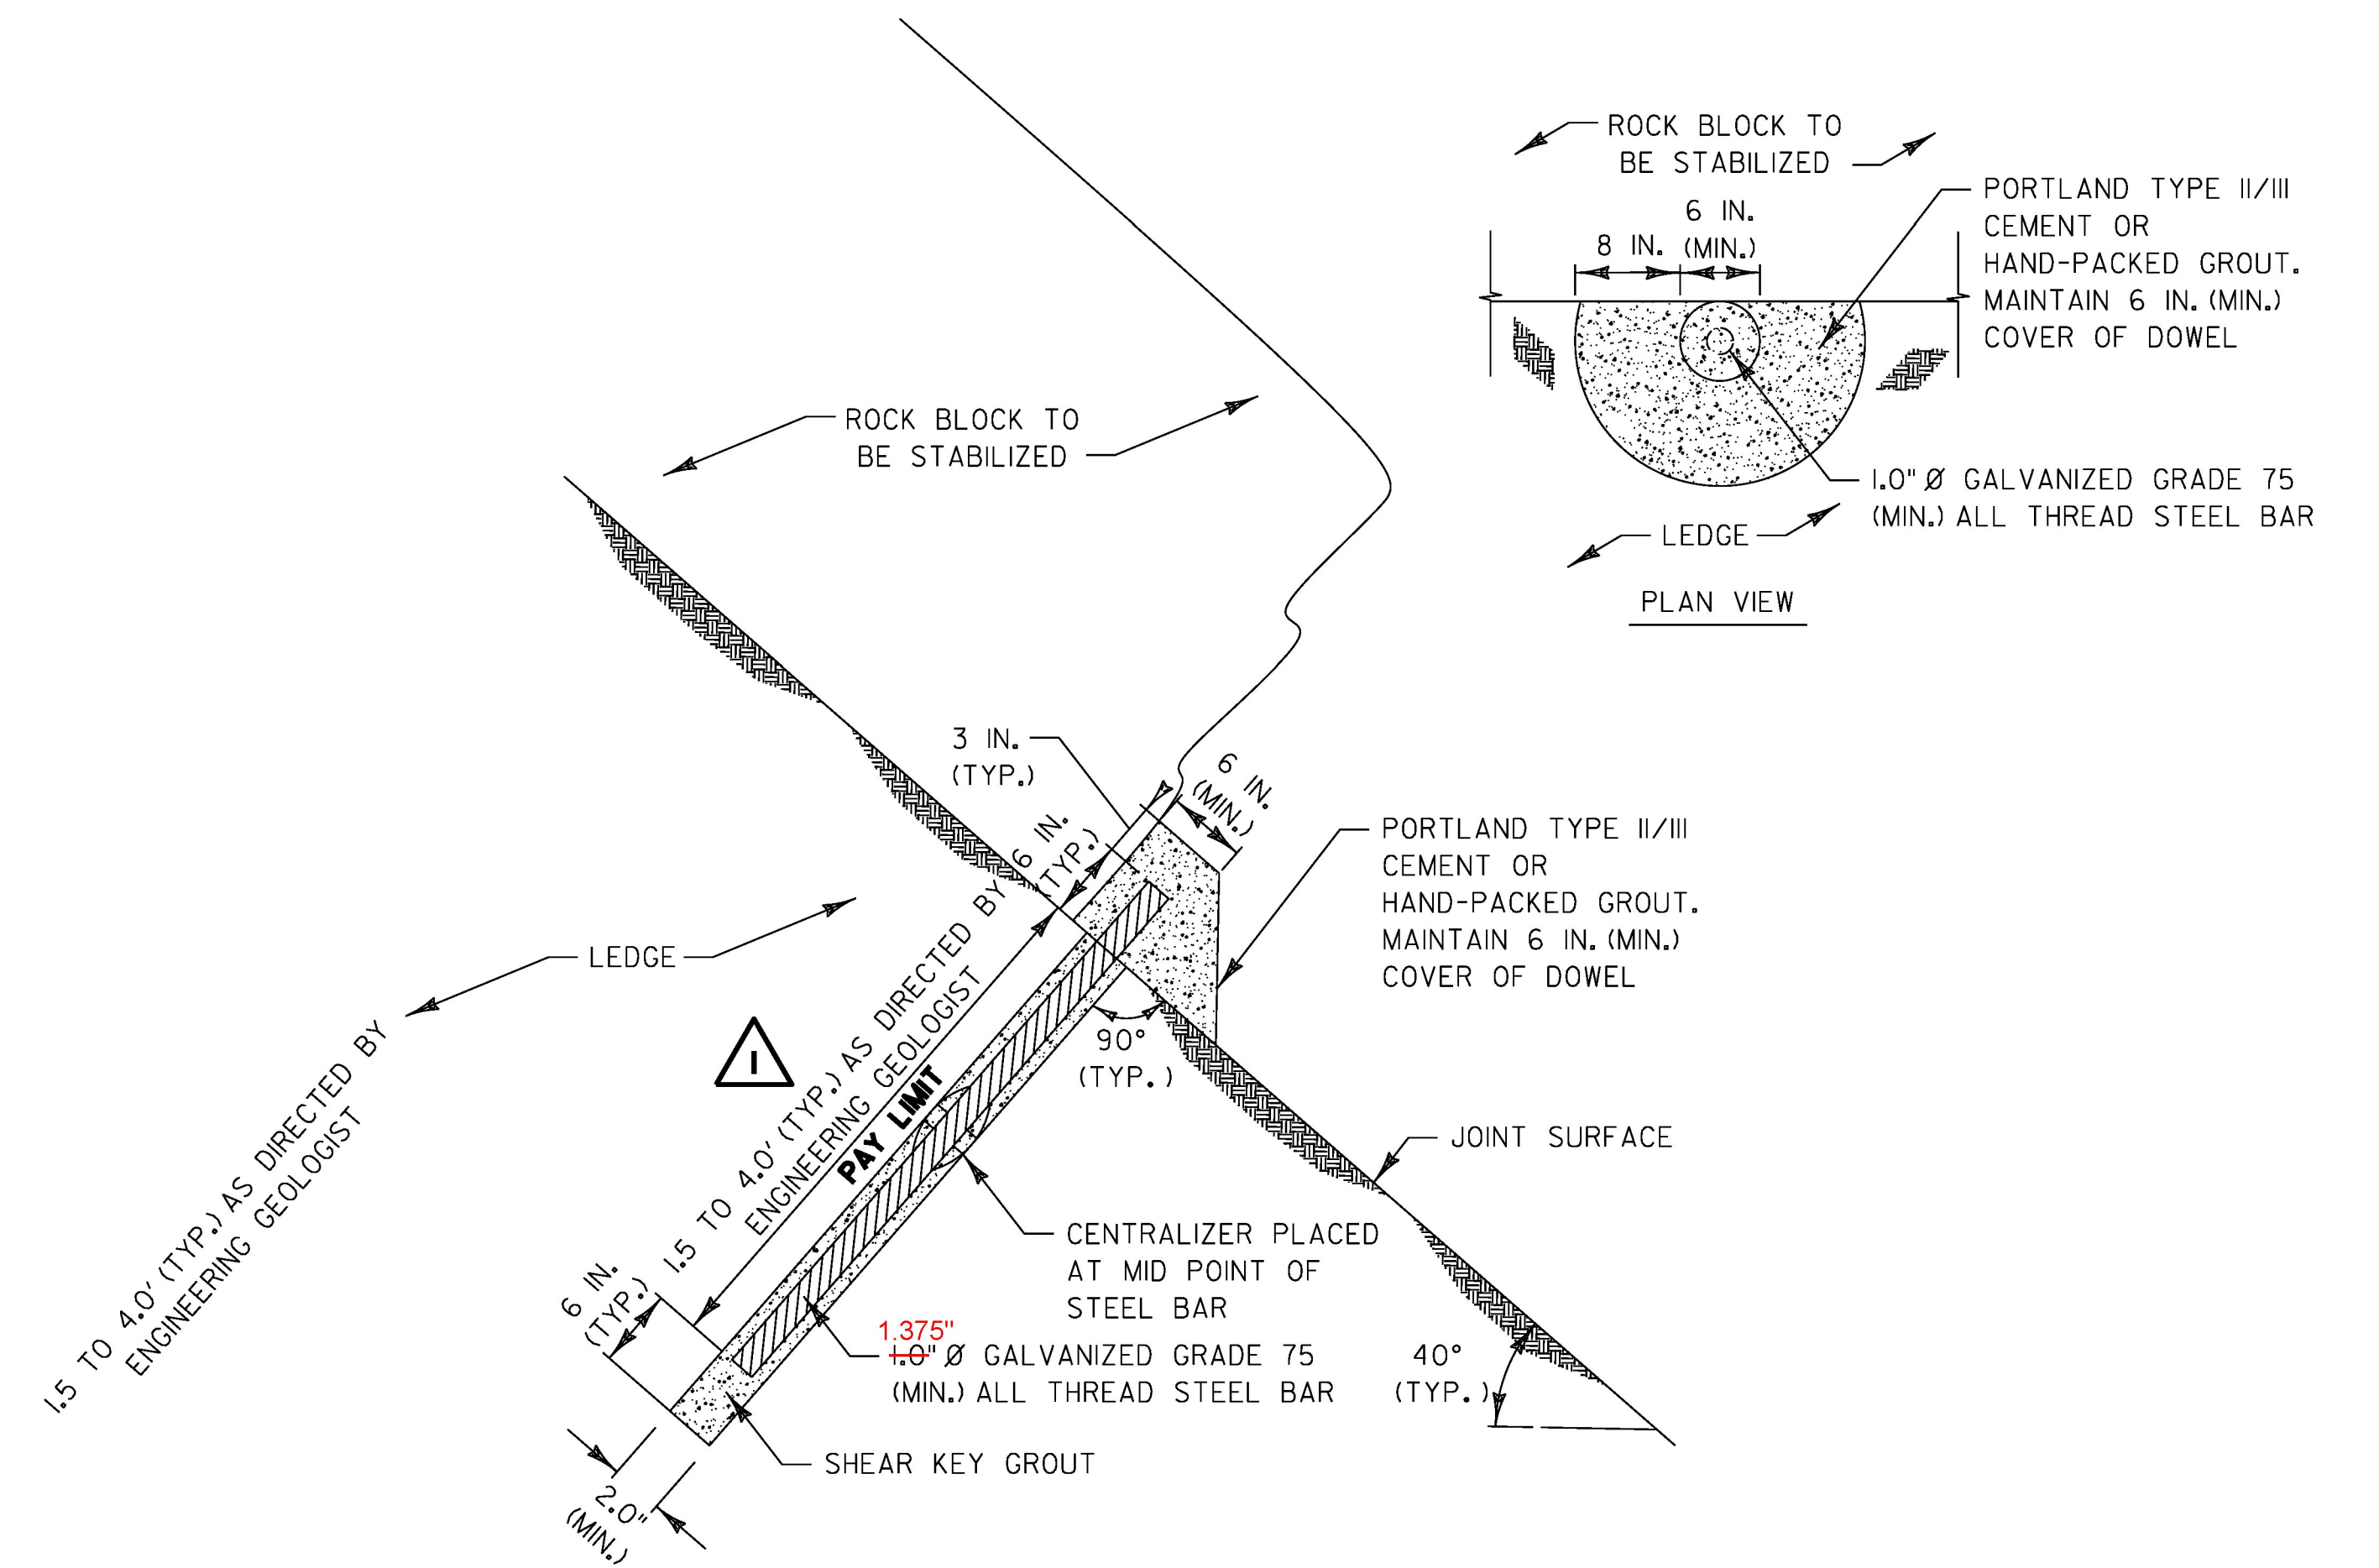

SHEAR KEY DETAIL

PAY ITEM 900.640 SPECIAL PROVISION (SHEAR KEYS)

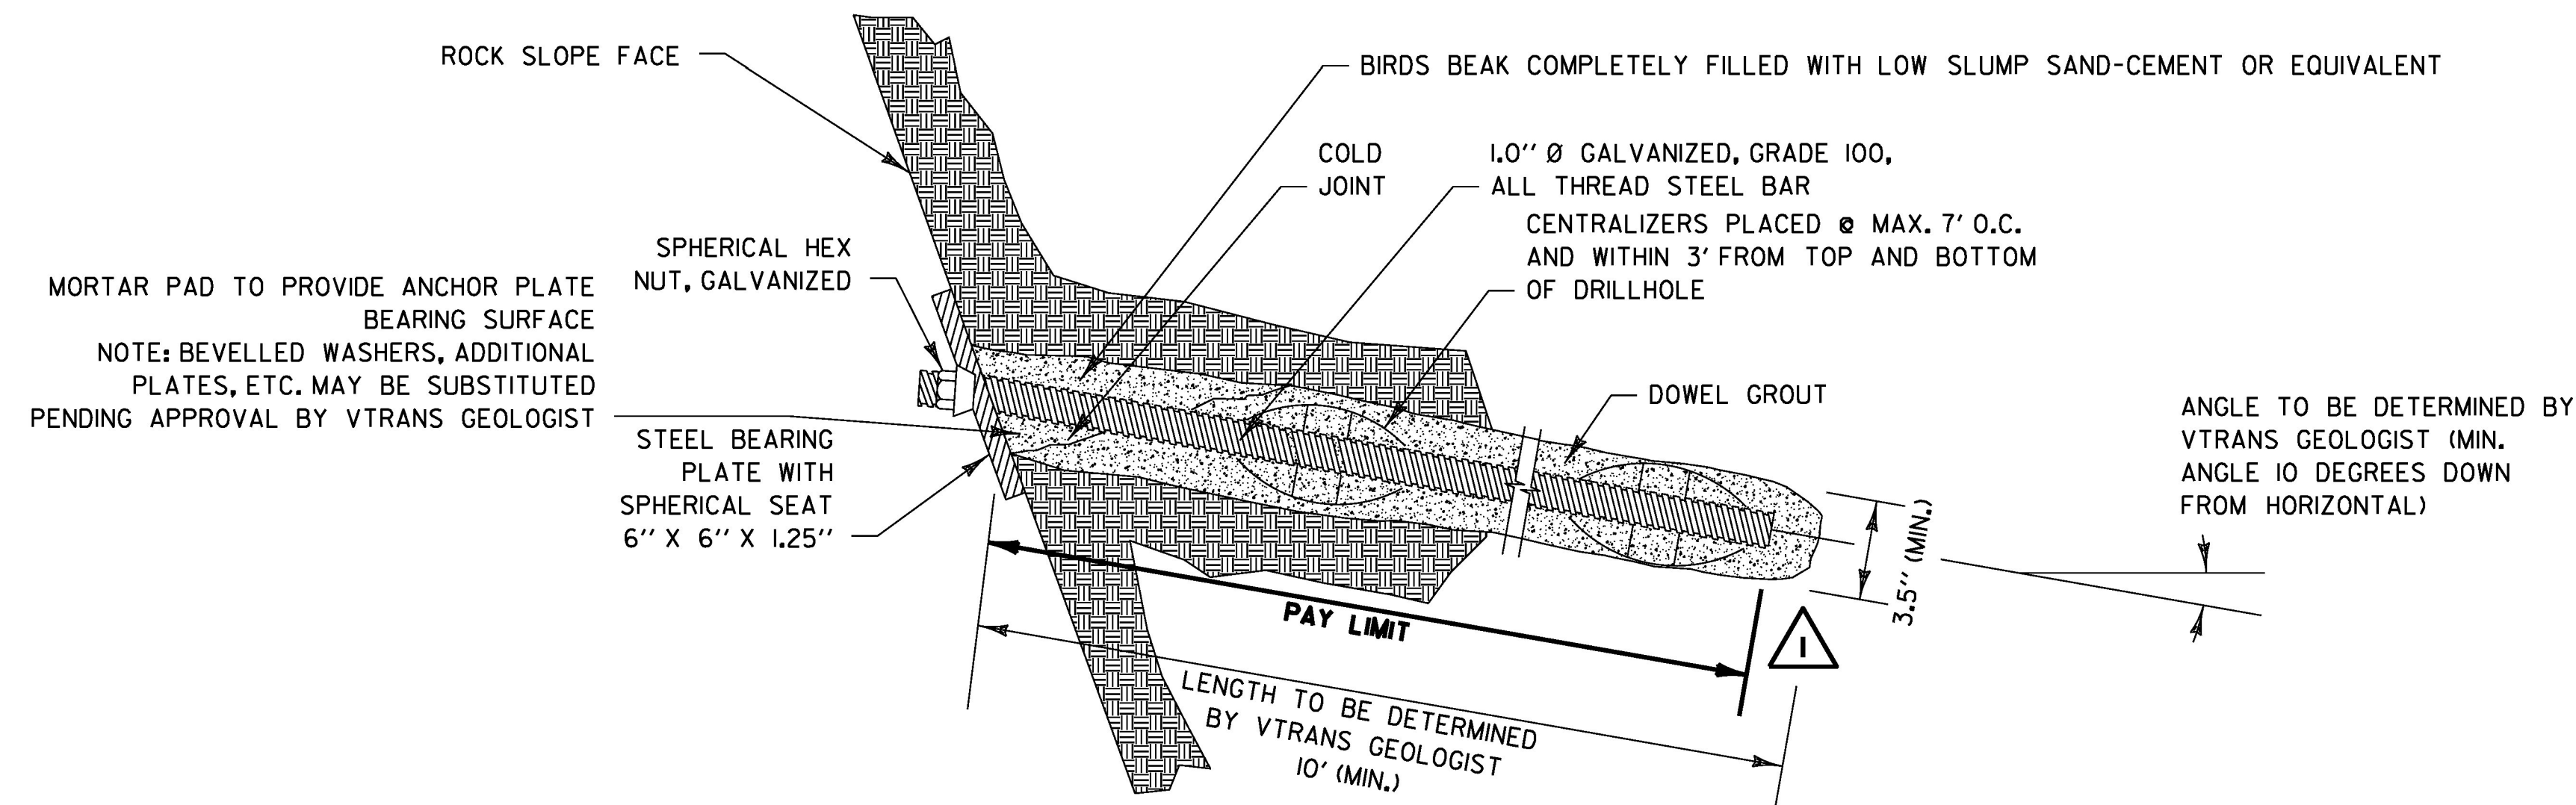

TYPICAL ROCK DOWEL DETAIL OVERHANGING CONDITION

PAY ITEM 900.640 SPECIAL PROVISION (ROCK DOWELING)

NOT TO SCALE

REVISION	DATE	DESCRIPTION
1	04-10-2017	ADDED PAY LIMIT DIMENSION

PROJECT NAME:	COVENTRY	FILE NAME:	d:\0c114det.dgn	PLOT DATE:	10-APR-2017
PROJECT NUMBER:	STP 0113(66)	PROJECT LEADER:	K. UPMAL	DRAWN BY:	S. ZWICK
		DESIGNED BY:	S. ZWICK	CHECKED BY:	C. LEACH
		DETAIL SHEET 1			SHEET 5 OF 29