



175+00

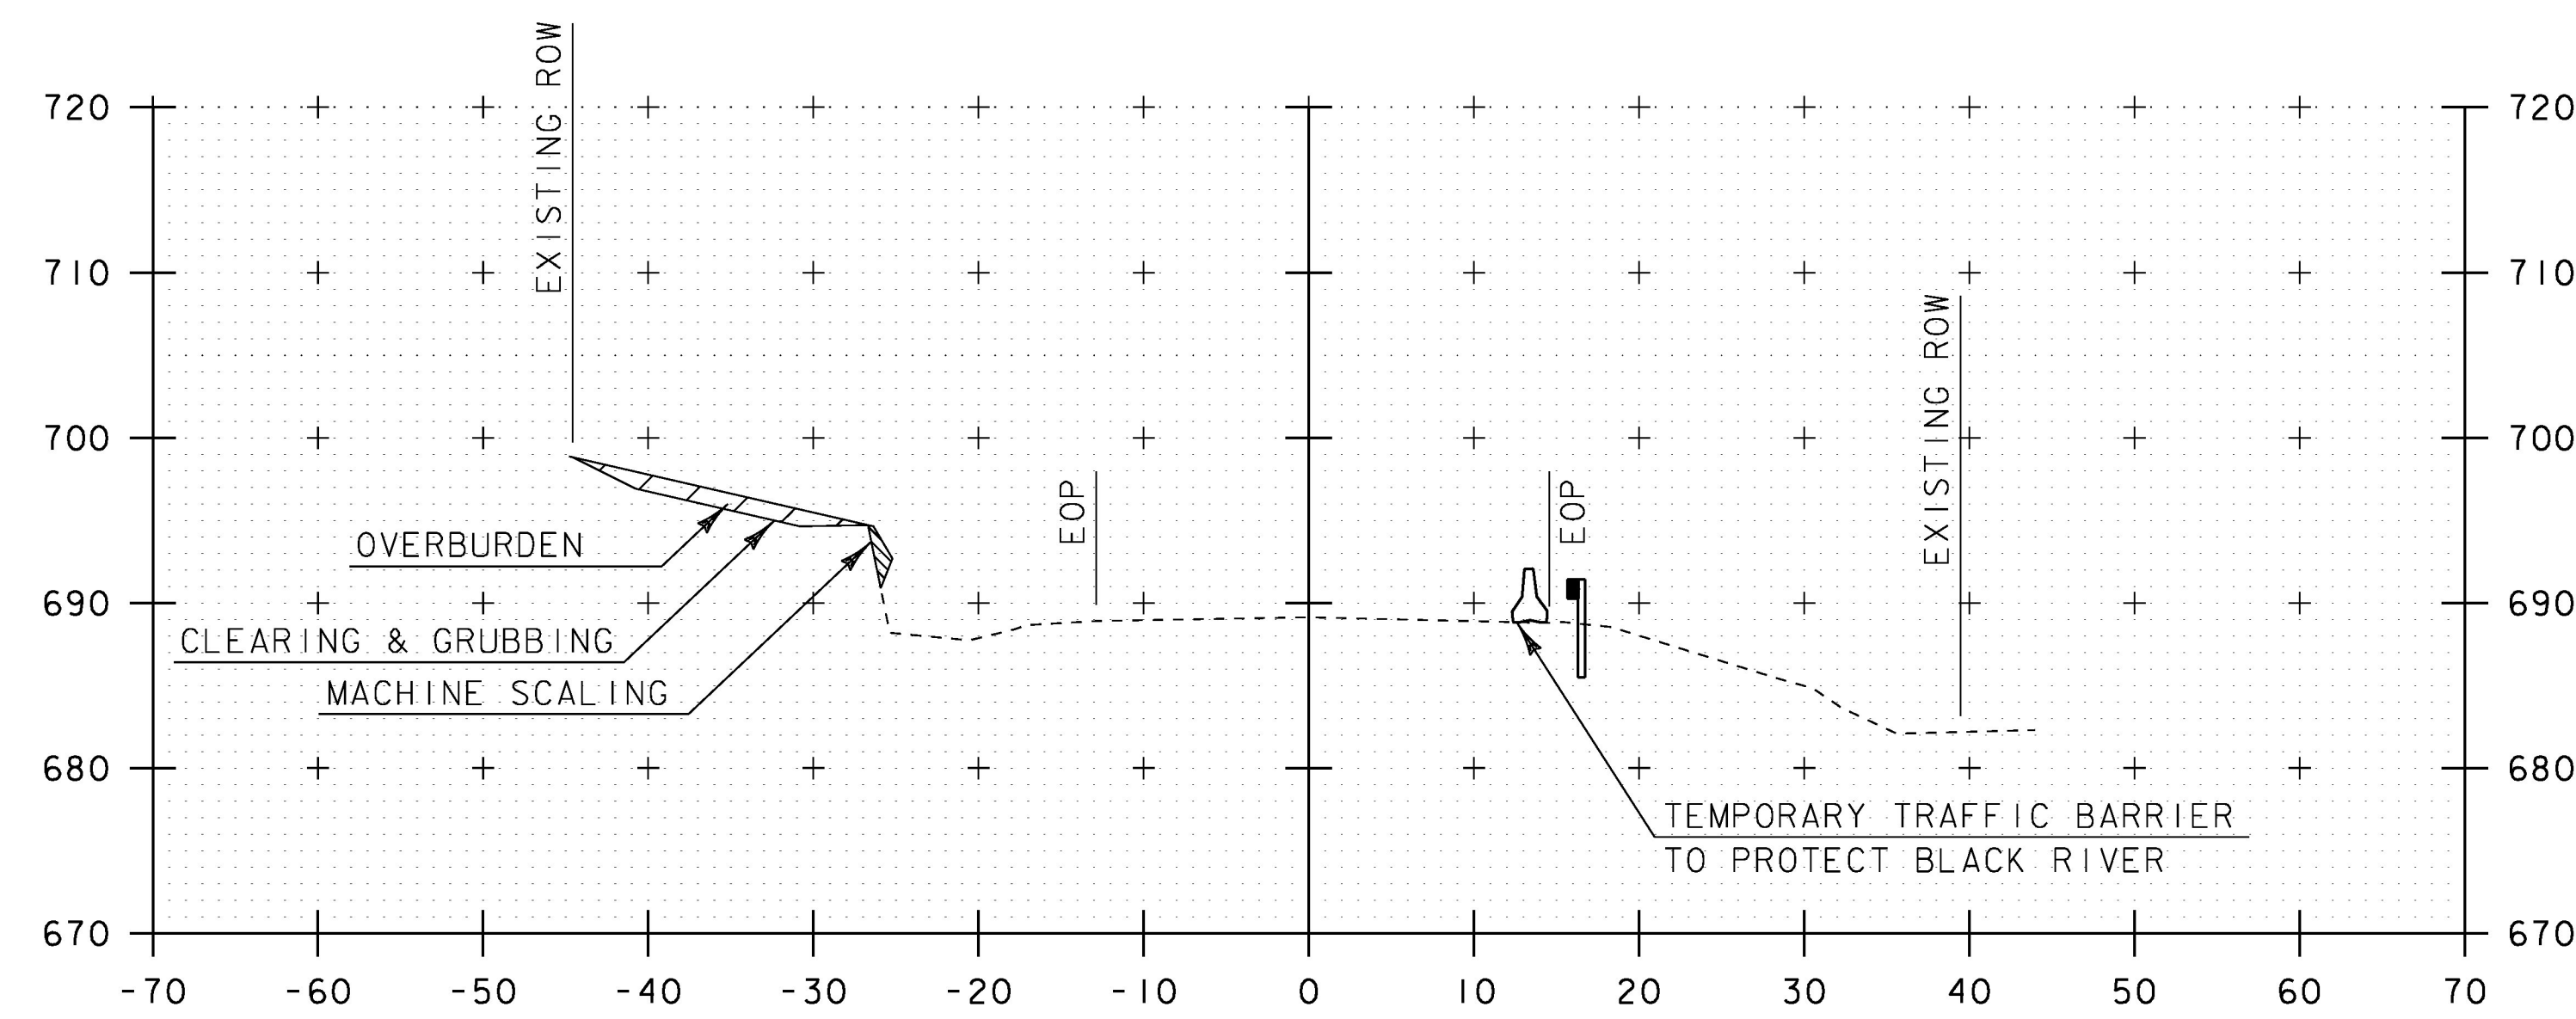

174+50
BEGIN PROJECT

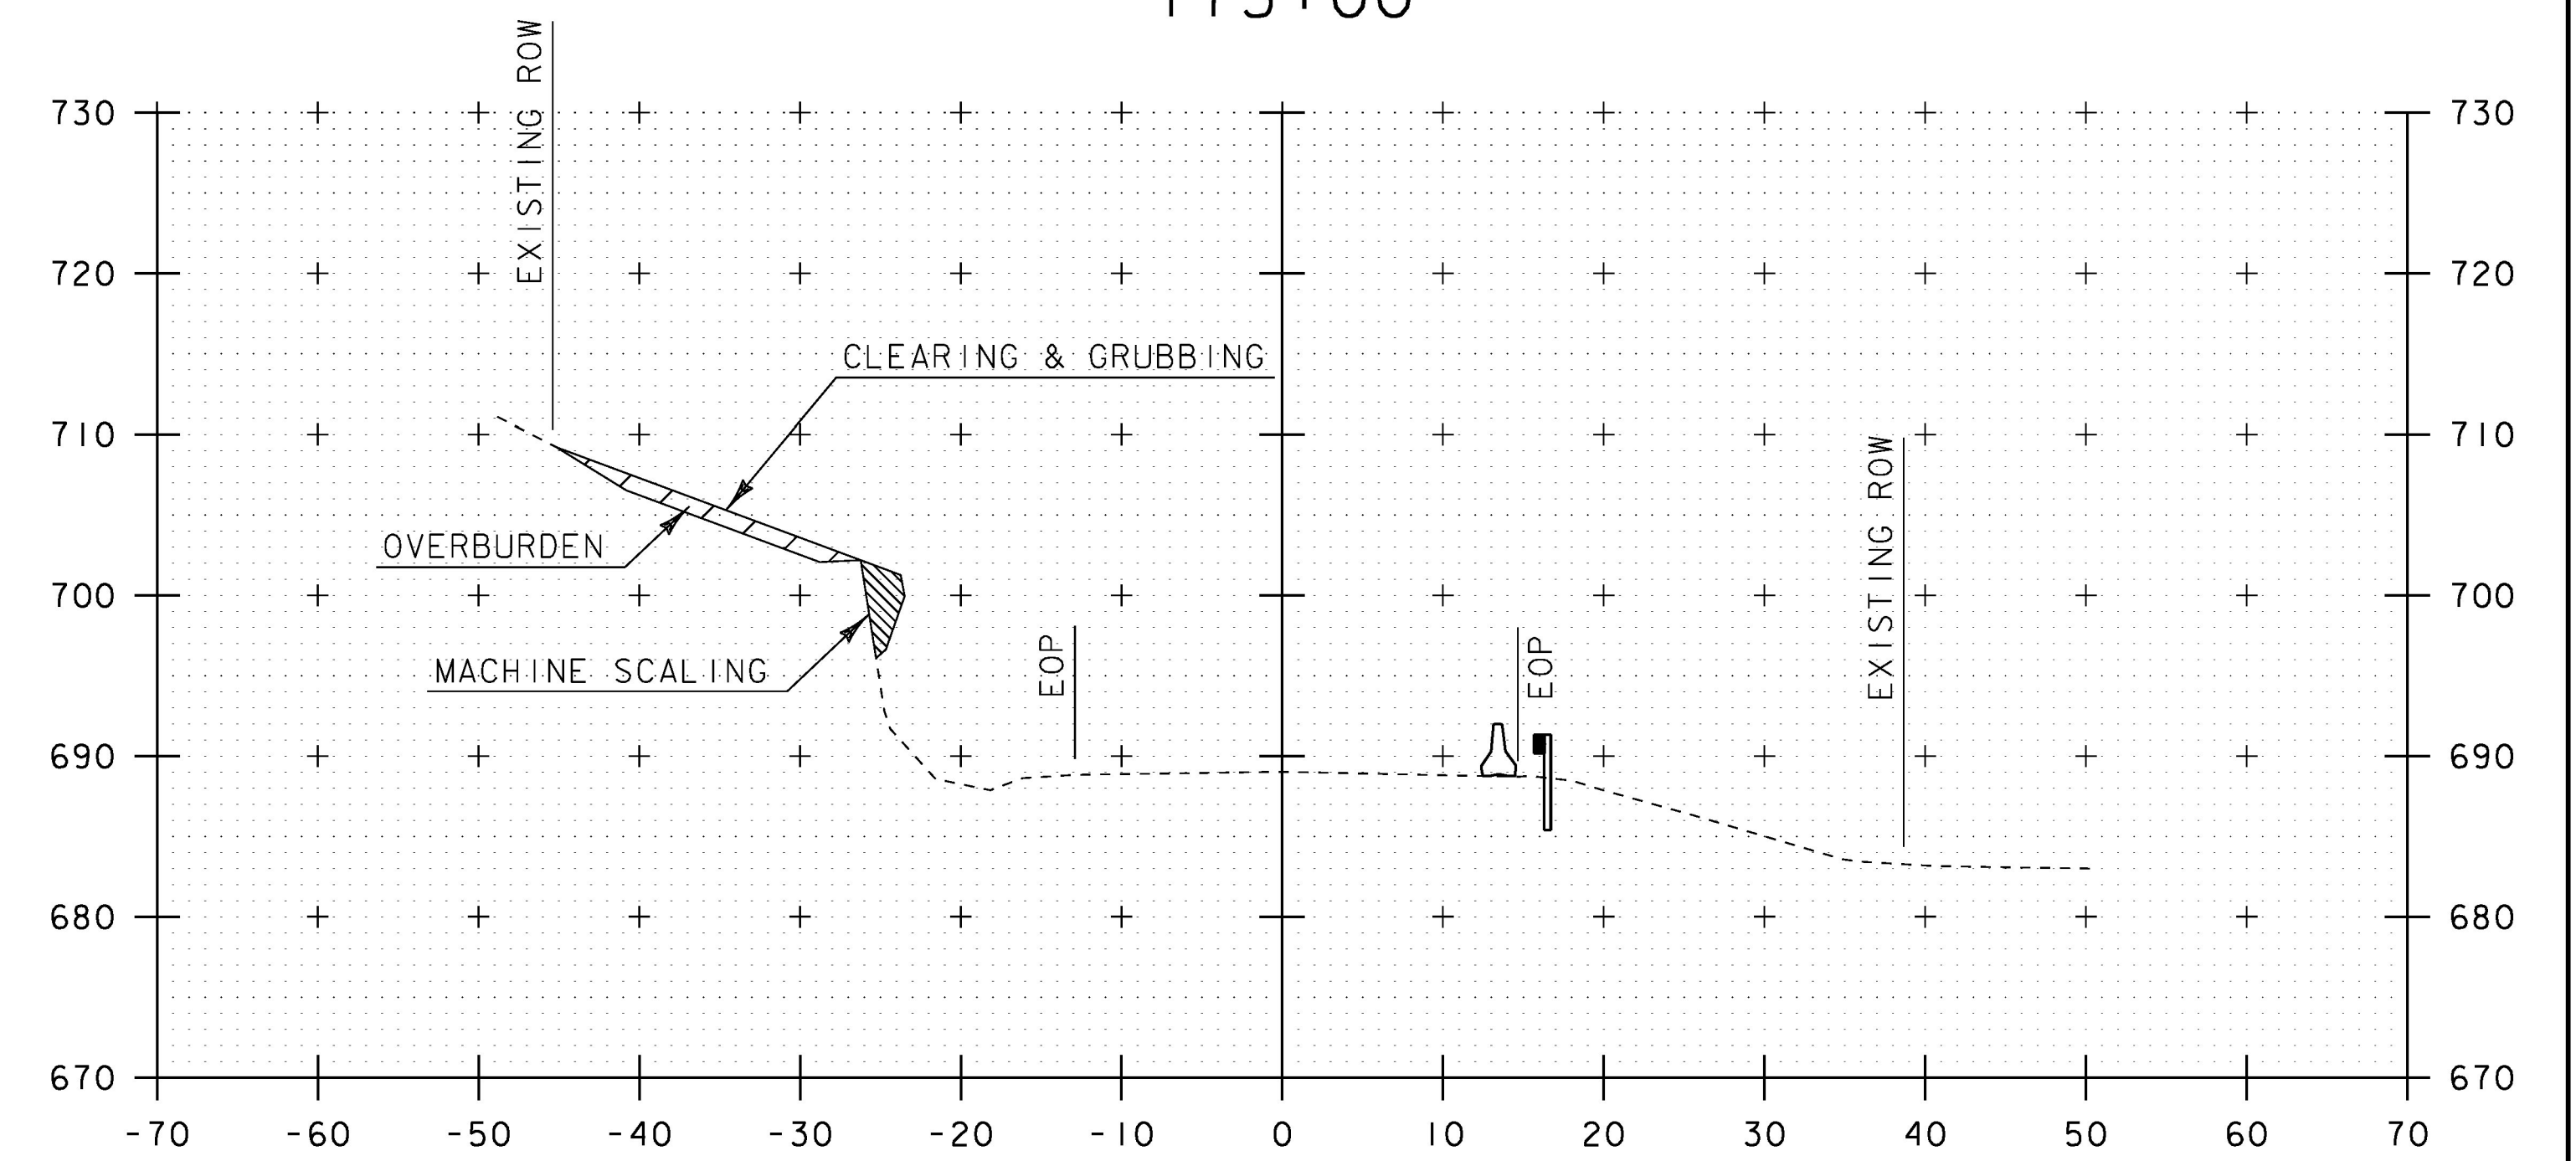

174+75

STA. 174+50 TO STA. 175+00

PROJECT NAME: COVENTRY	PLOT DATE: 15-FEB-2017
PROJECT NUMBER: STP 0113(66)	DRAWN BY: S. ZWICK
FILE NAME: d10c14xsc.dgn	CHECKED BY: C. LEACH
PROJECT LEADER: K. UPMAL	SHEET 17 OF 29
DESIGNED BY: S. ZWICK	
CROSS SECTION SHEET 1	