


176+75

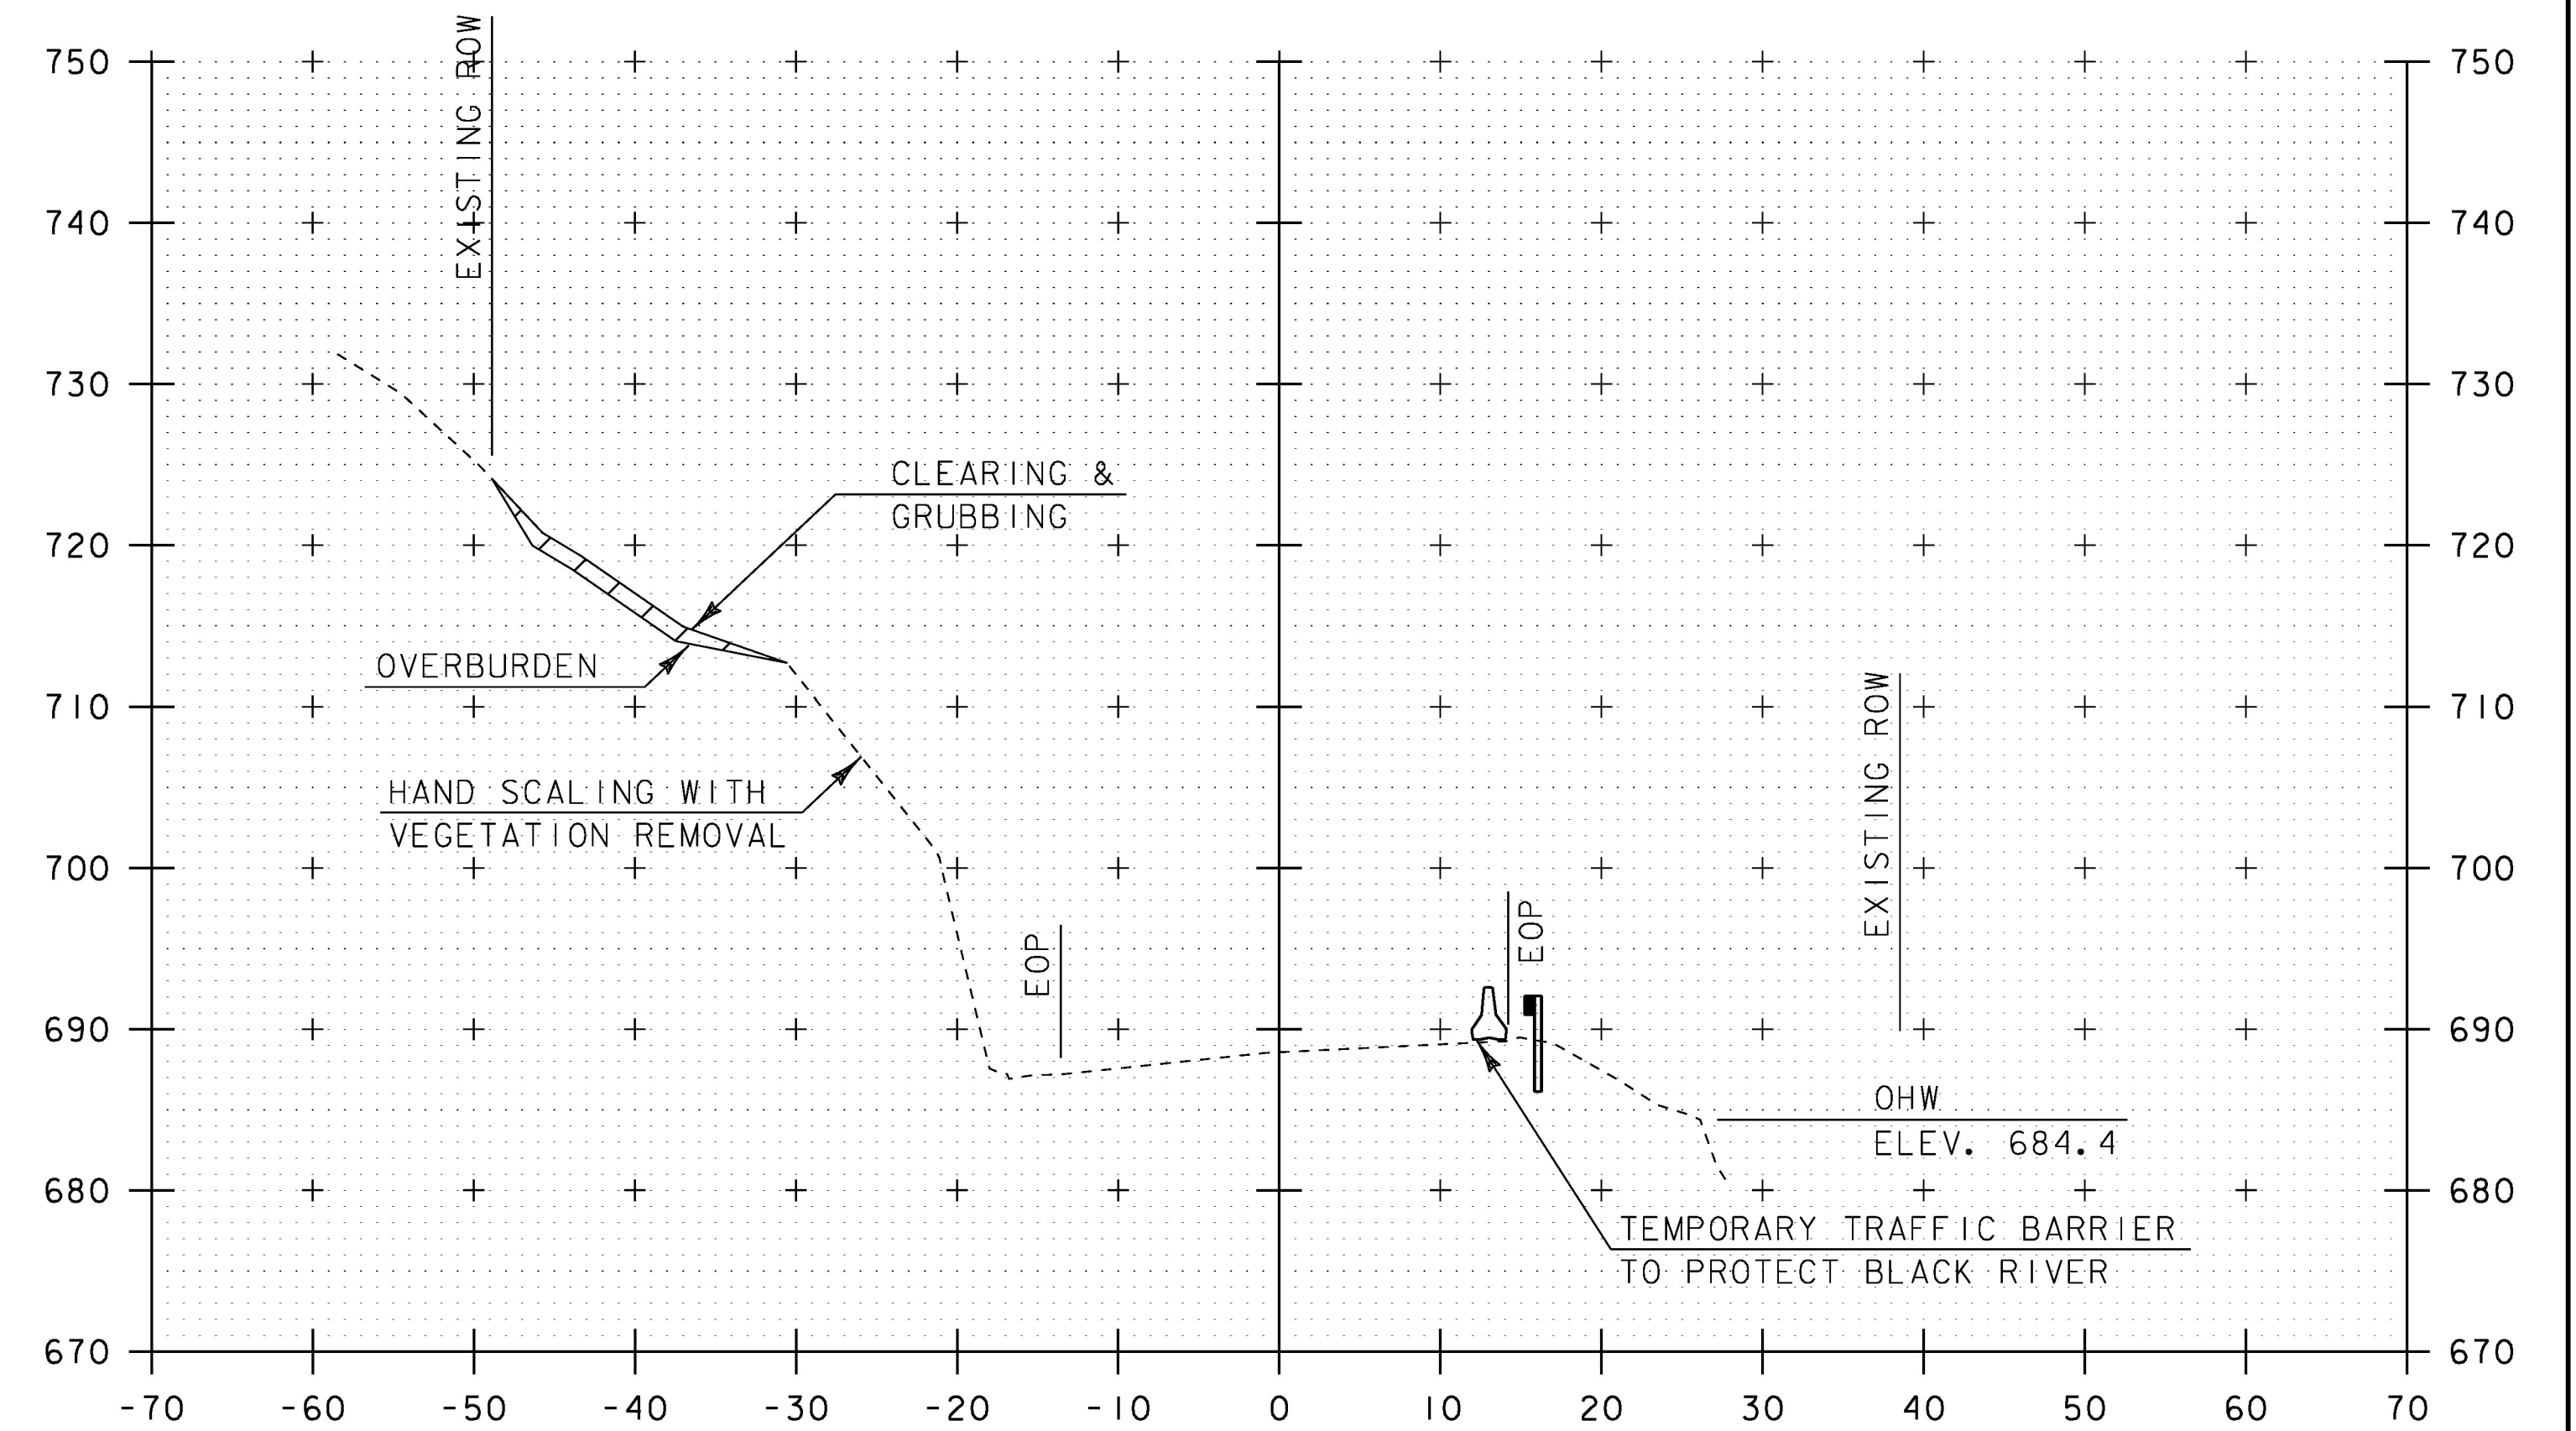

177+00

STA. 176+75 TO STA. 177+00

PROJECT NAME: COVENTRY	PLOT DATE: 15-FEB-2017
PROJECT NUMBER: STP 0113(66)	DRAWN BY: S. ZWICK
FILE NAME: d10c114xsc.dgn	CHECKED BY: C. LEACH
PROJECT LEADER: K. UPMAL	SHEET 21 OF 29
DESIGNED BY: S. ZWICK	
CROSS SECTION SHEET 5	