




177+50

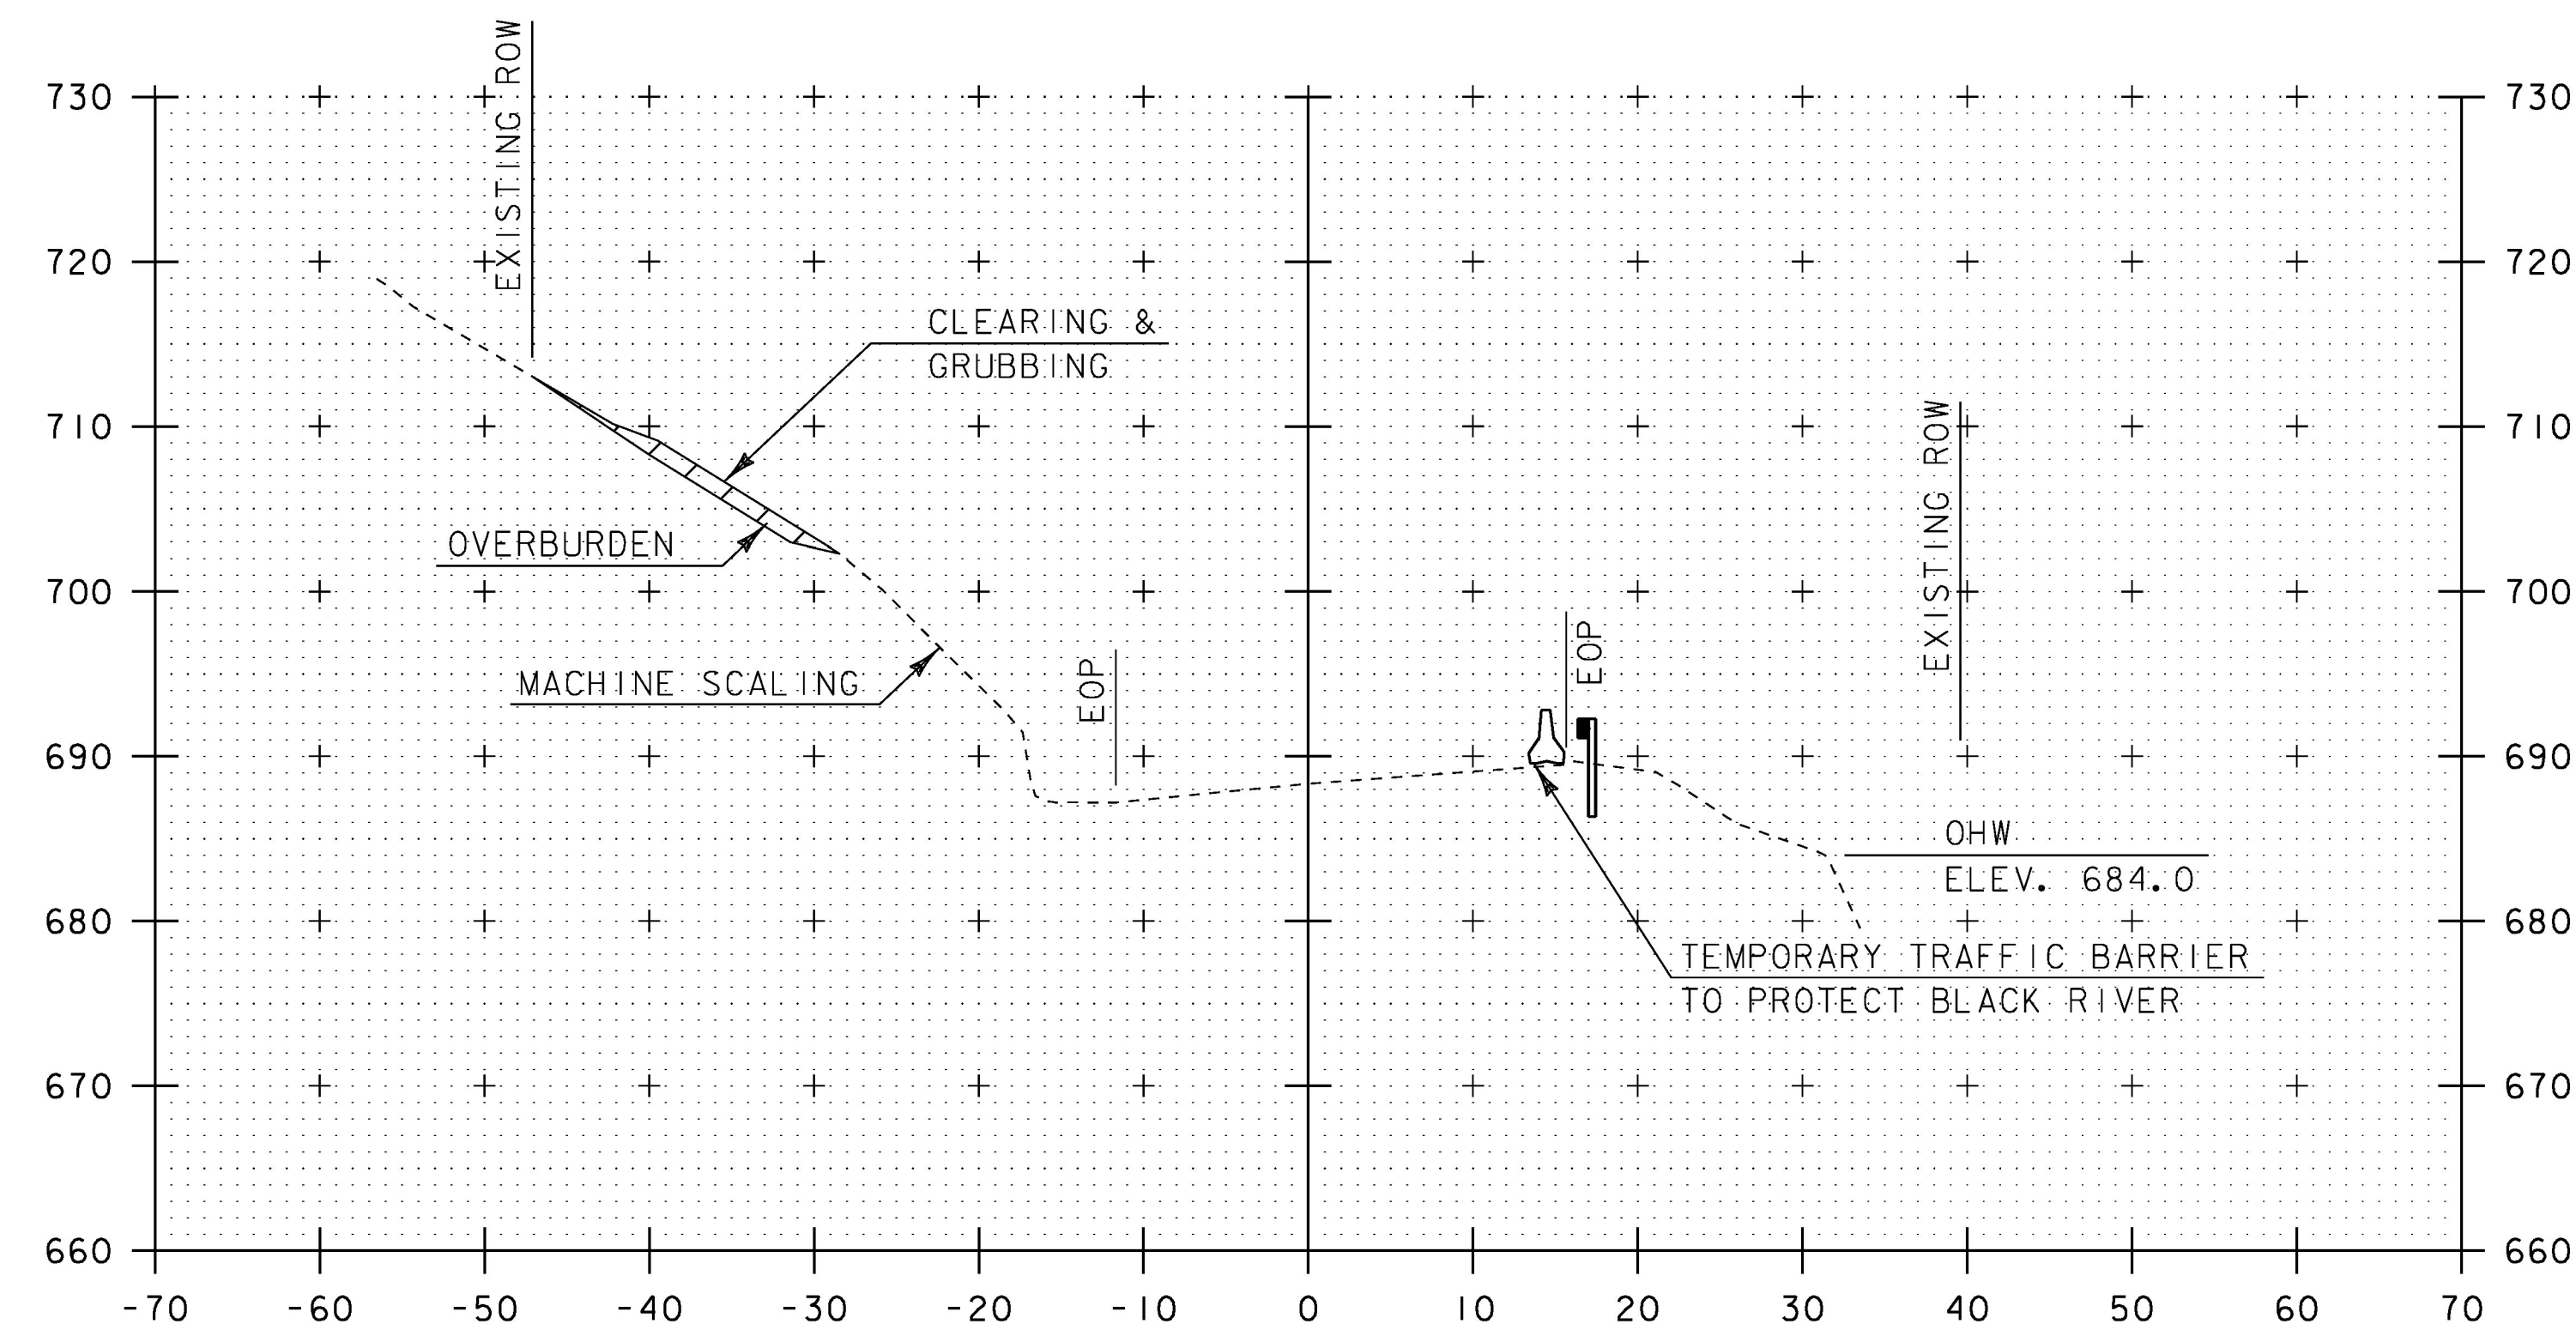

178+00

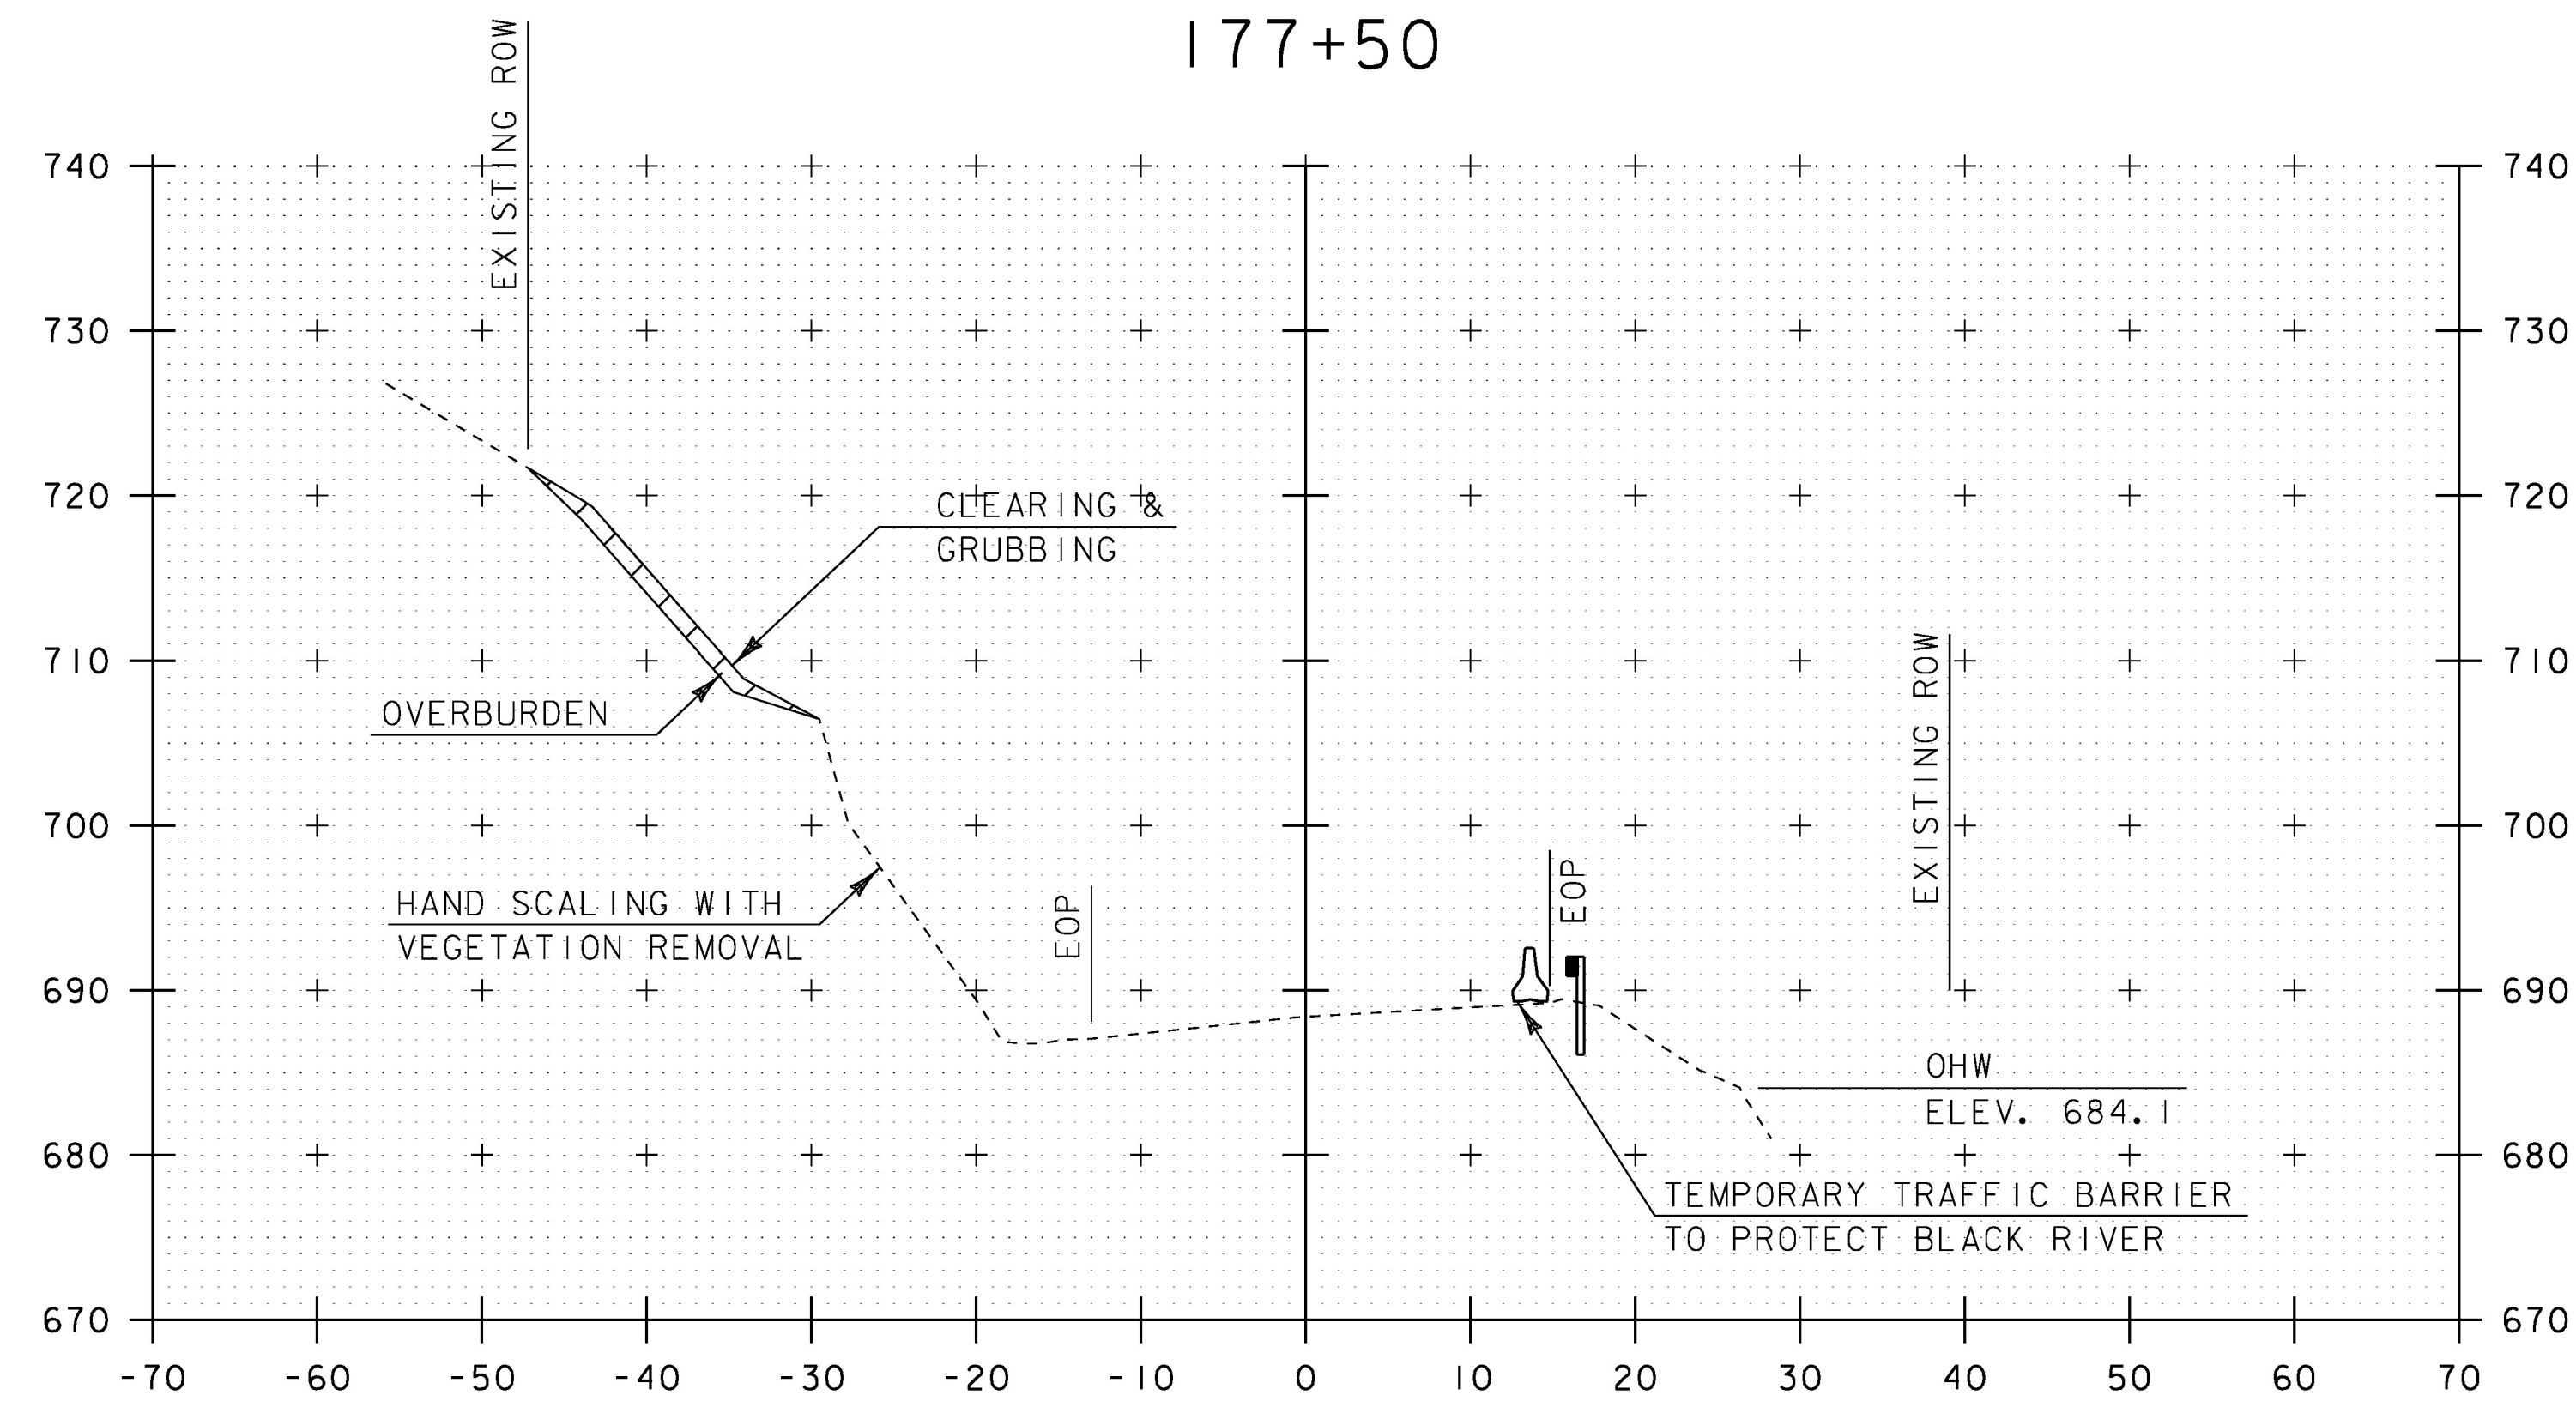

177+25

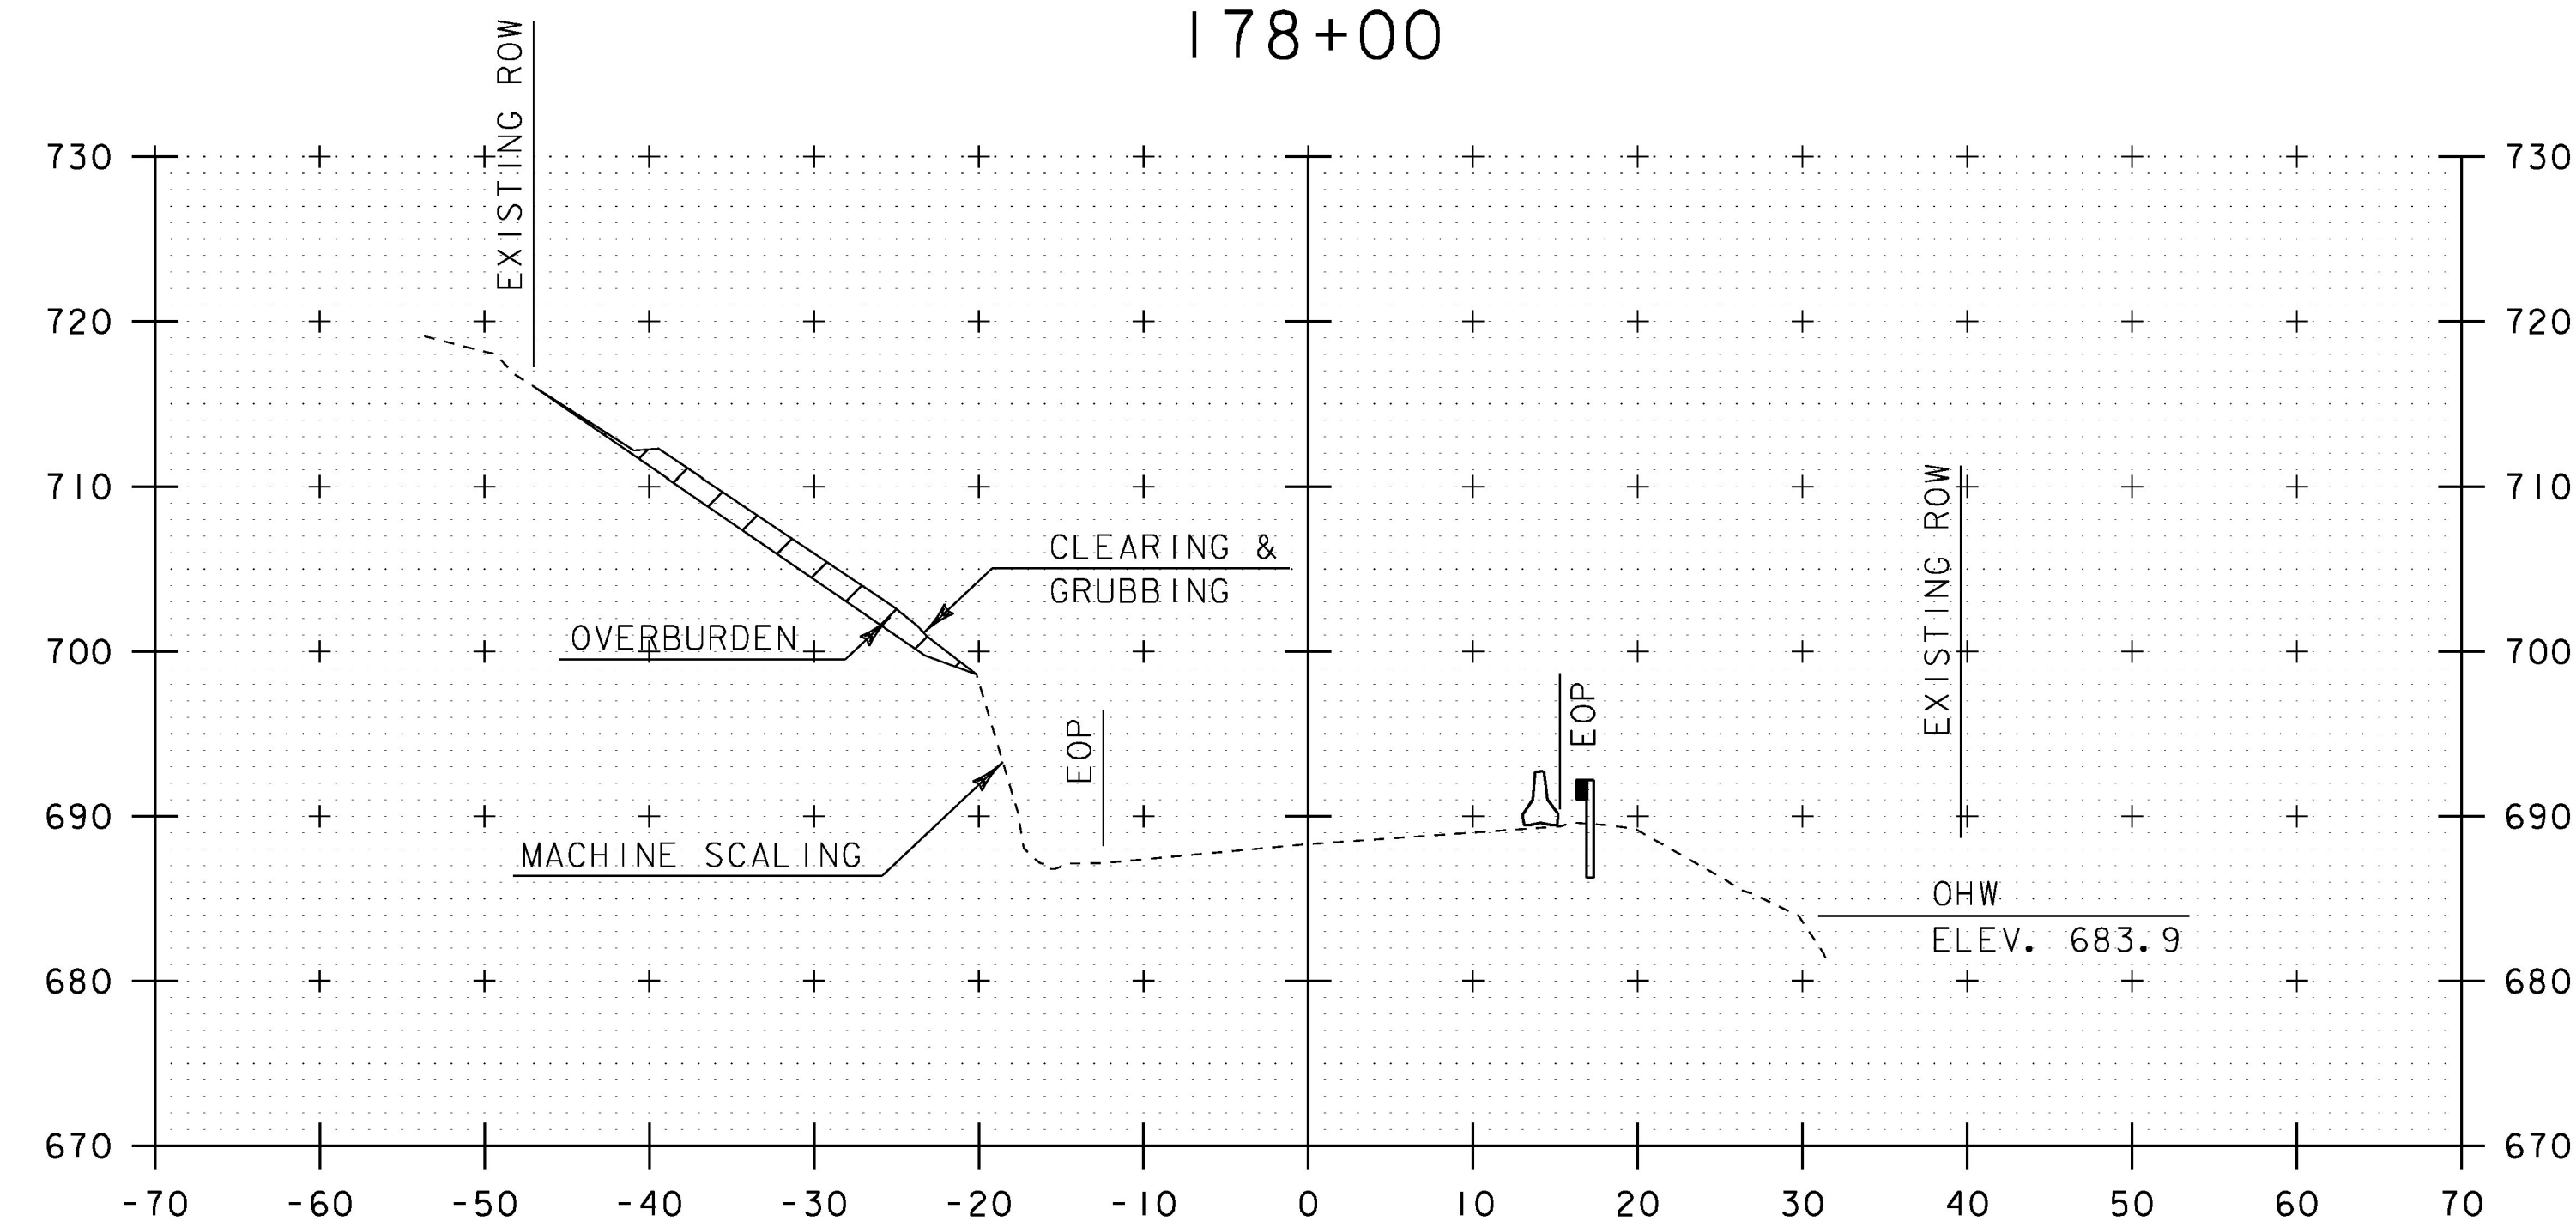

177+75

STA. 177+25 TO STA. 178+00

PROJECT NAME:	COVENTRY
PROJECT NUMBER:	STP 0113(66)
FILE NAME:	d:\0c14\4xsc.dgn
PROJECT LEADER:	K. UPMAL
DESIGNED BY:	S. ZWICK
CROSS SECTION SHEET	6
PLOT DATE:	15-FEB-2017
DRAWN BY:	S. ZWICK
CHECKED BY:	C. LEACH
SHEET	22 OF 29