




178+25

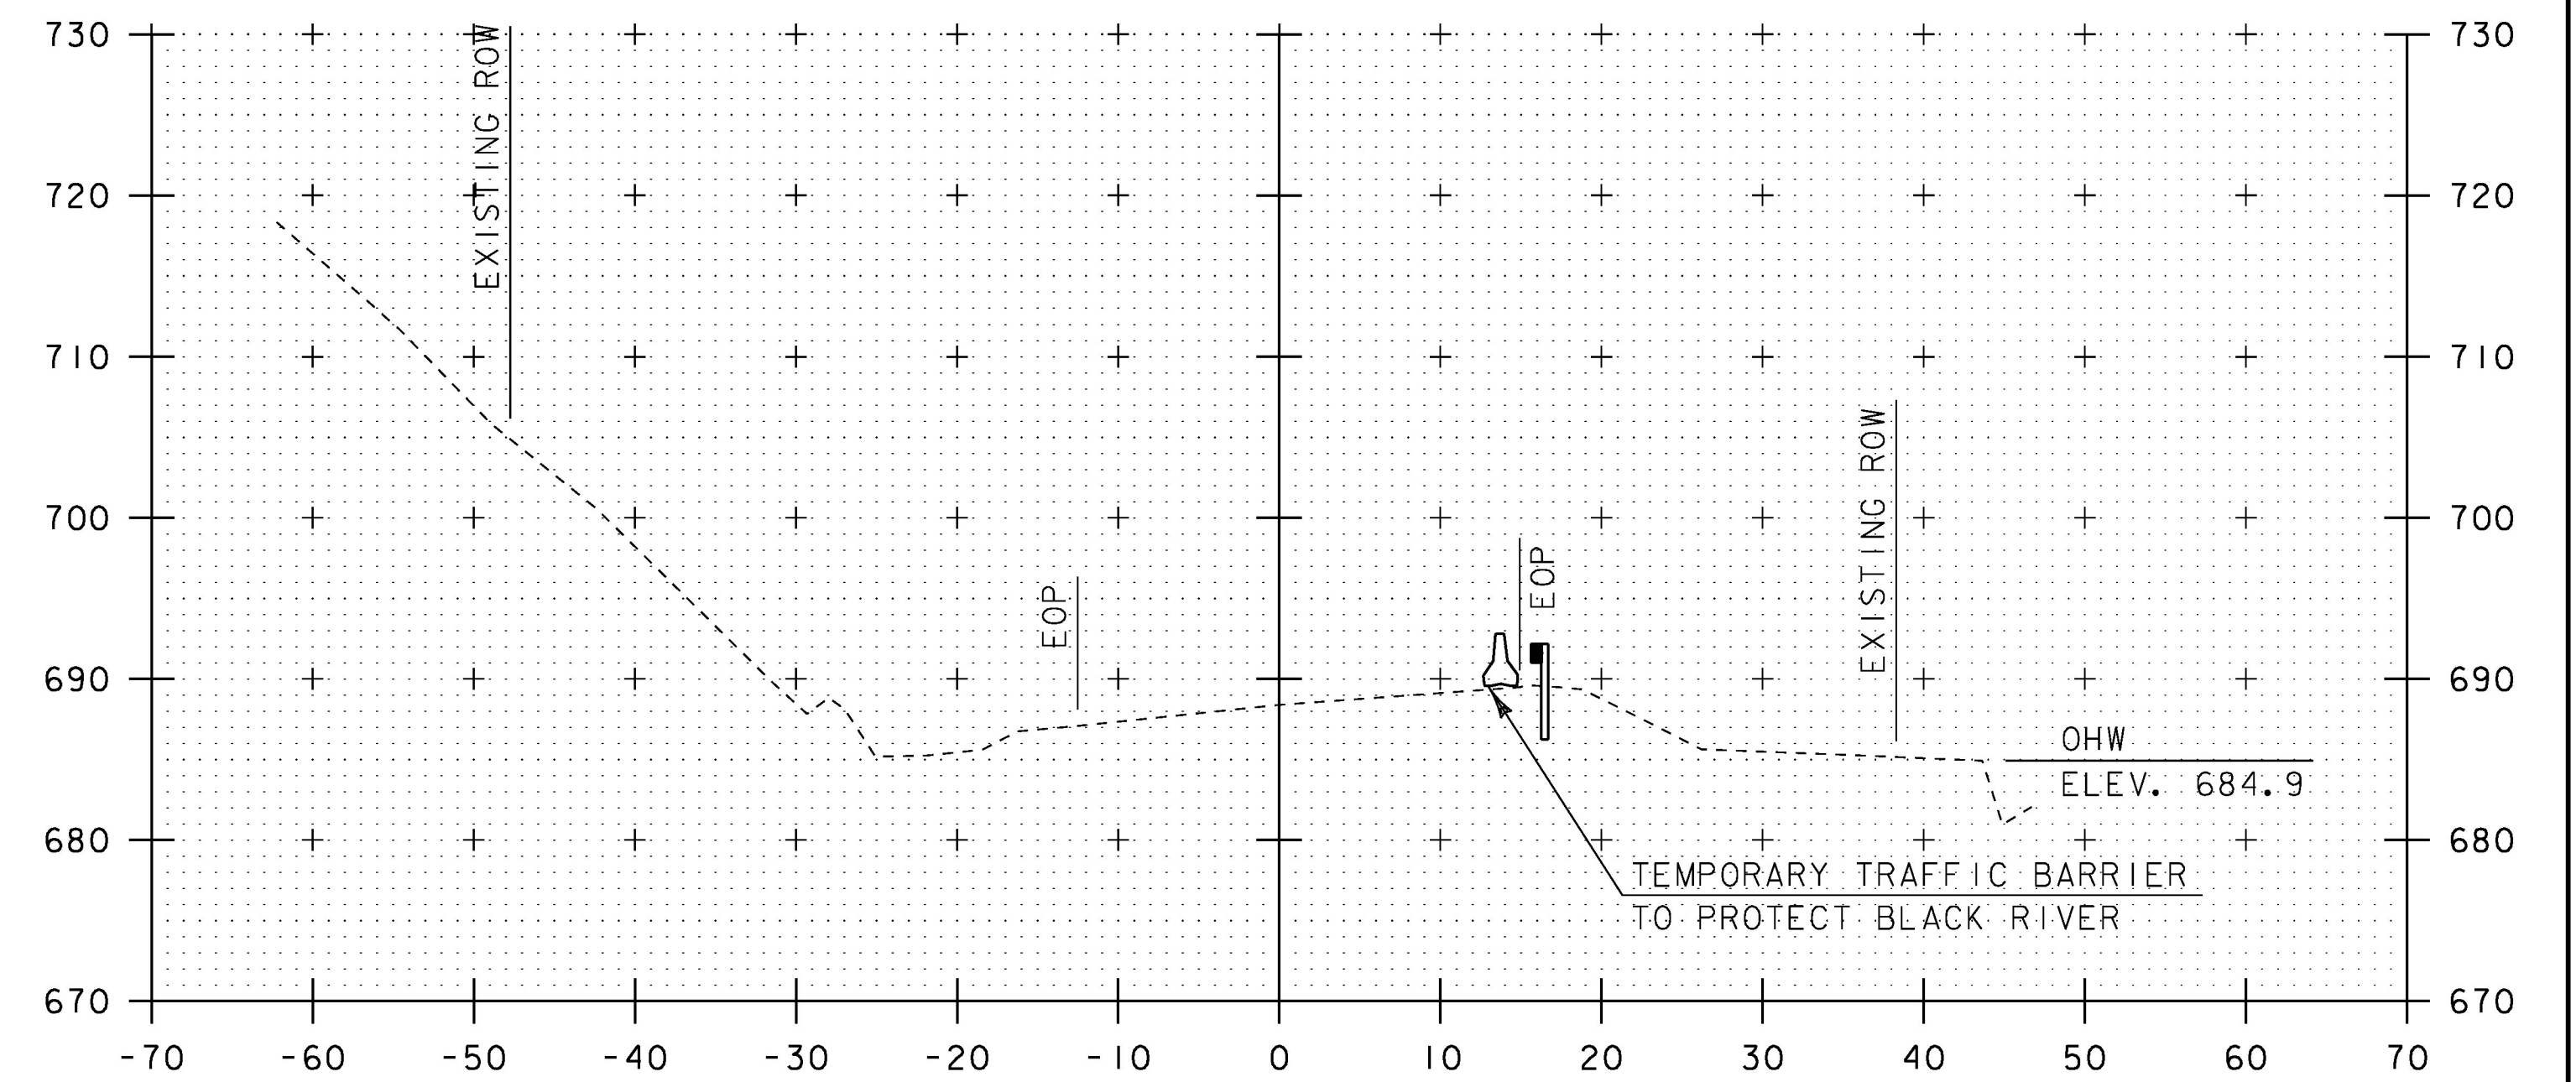

178+75

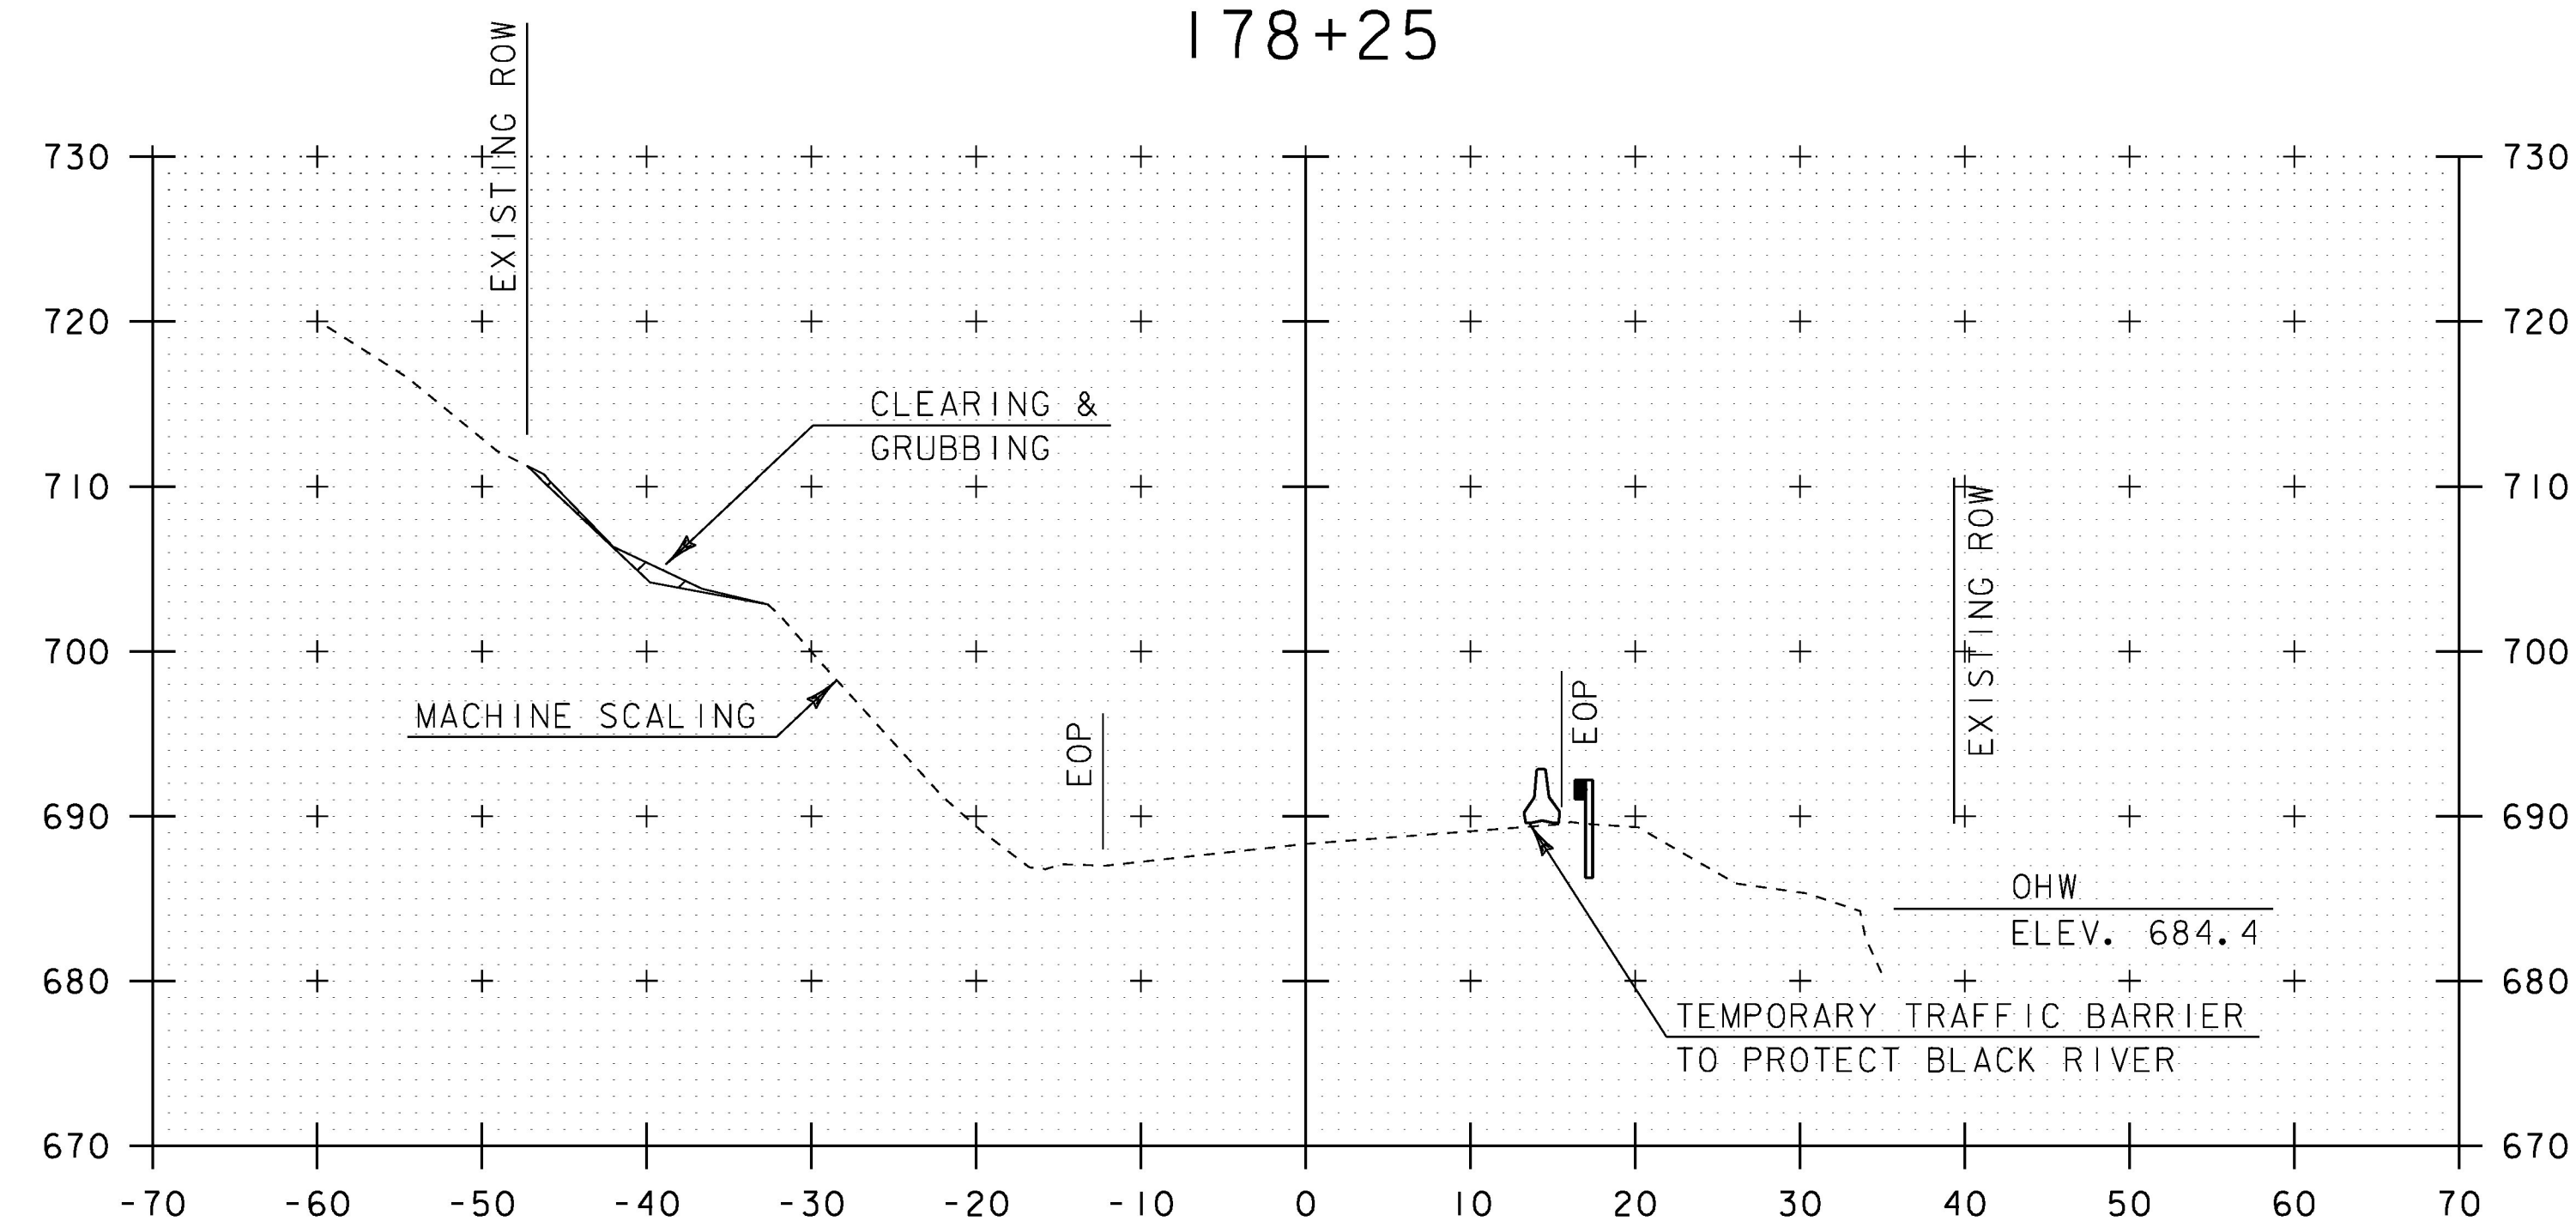

178+18

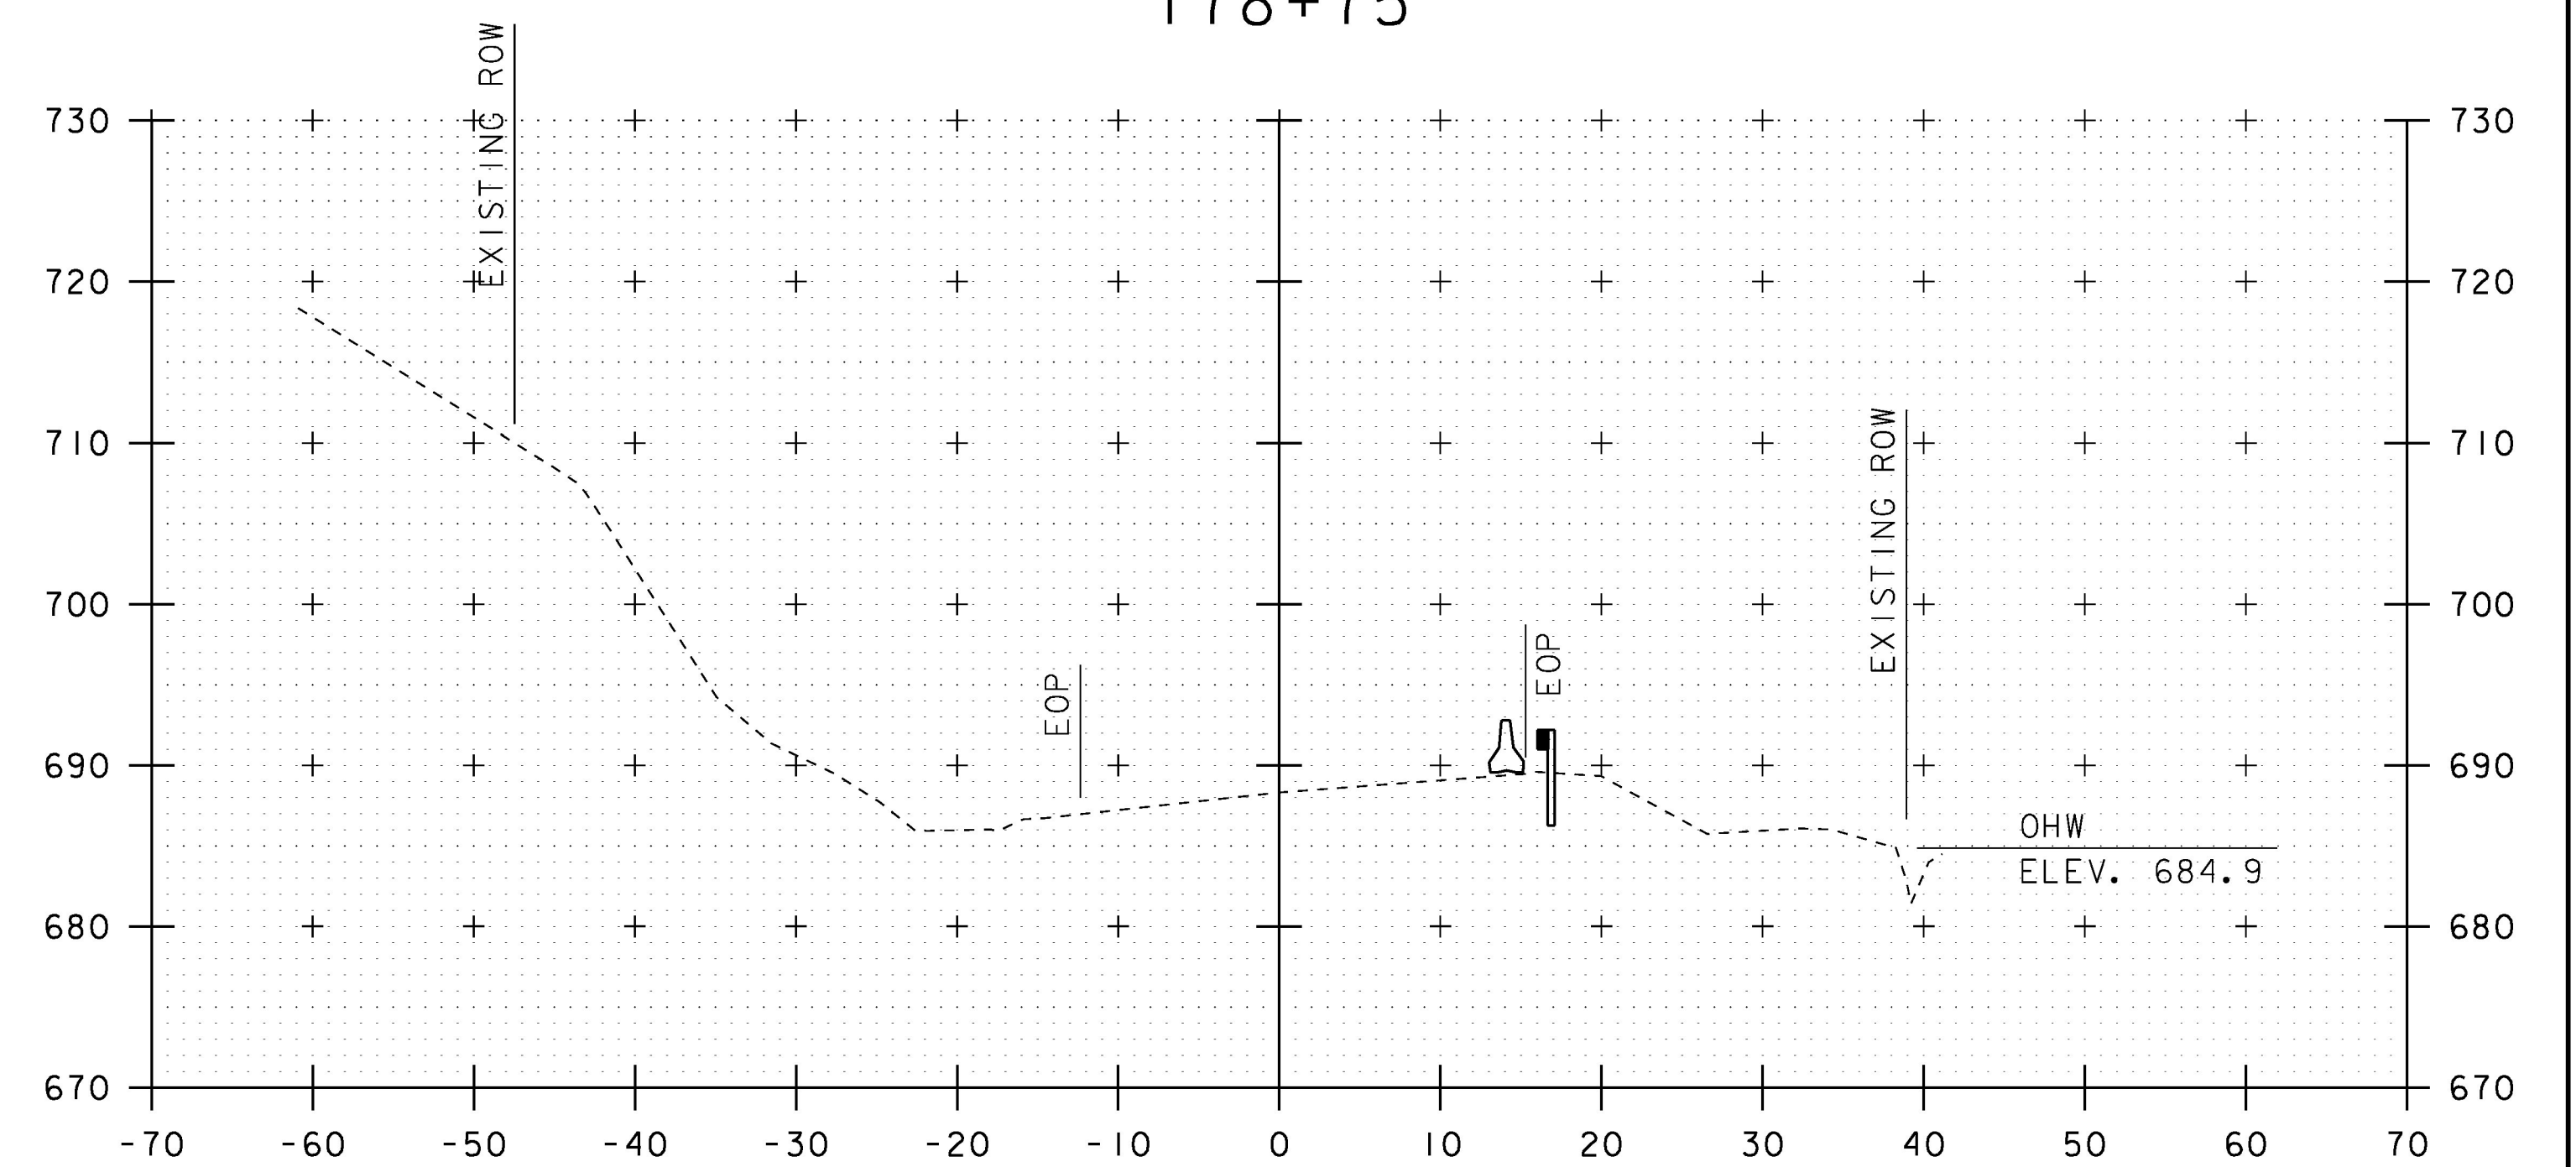

178+50

STA. 178+18 TO STA. 178+75

| | |
|-----------------------------|------------------------|
| PROJECT NAME: | COVENTRY |
| PROJECT NUMBER: | STP 0113(66) |
| FILE NAME: d:\0c14\4xsc.dgn | PLOT DATE: 15-FEB-2017 |
| PROJECT LEADER: K. UPMAL | DRAWN BY: S. ZWICK |
| DESIGNED BY: S. ZWICK | CHECKED BY: C. LEACH |
| CROSS SECTION SHEET 7 | SHEET 23 OF 29 |