




179+25

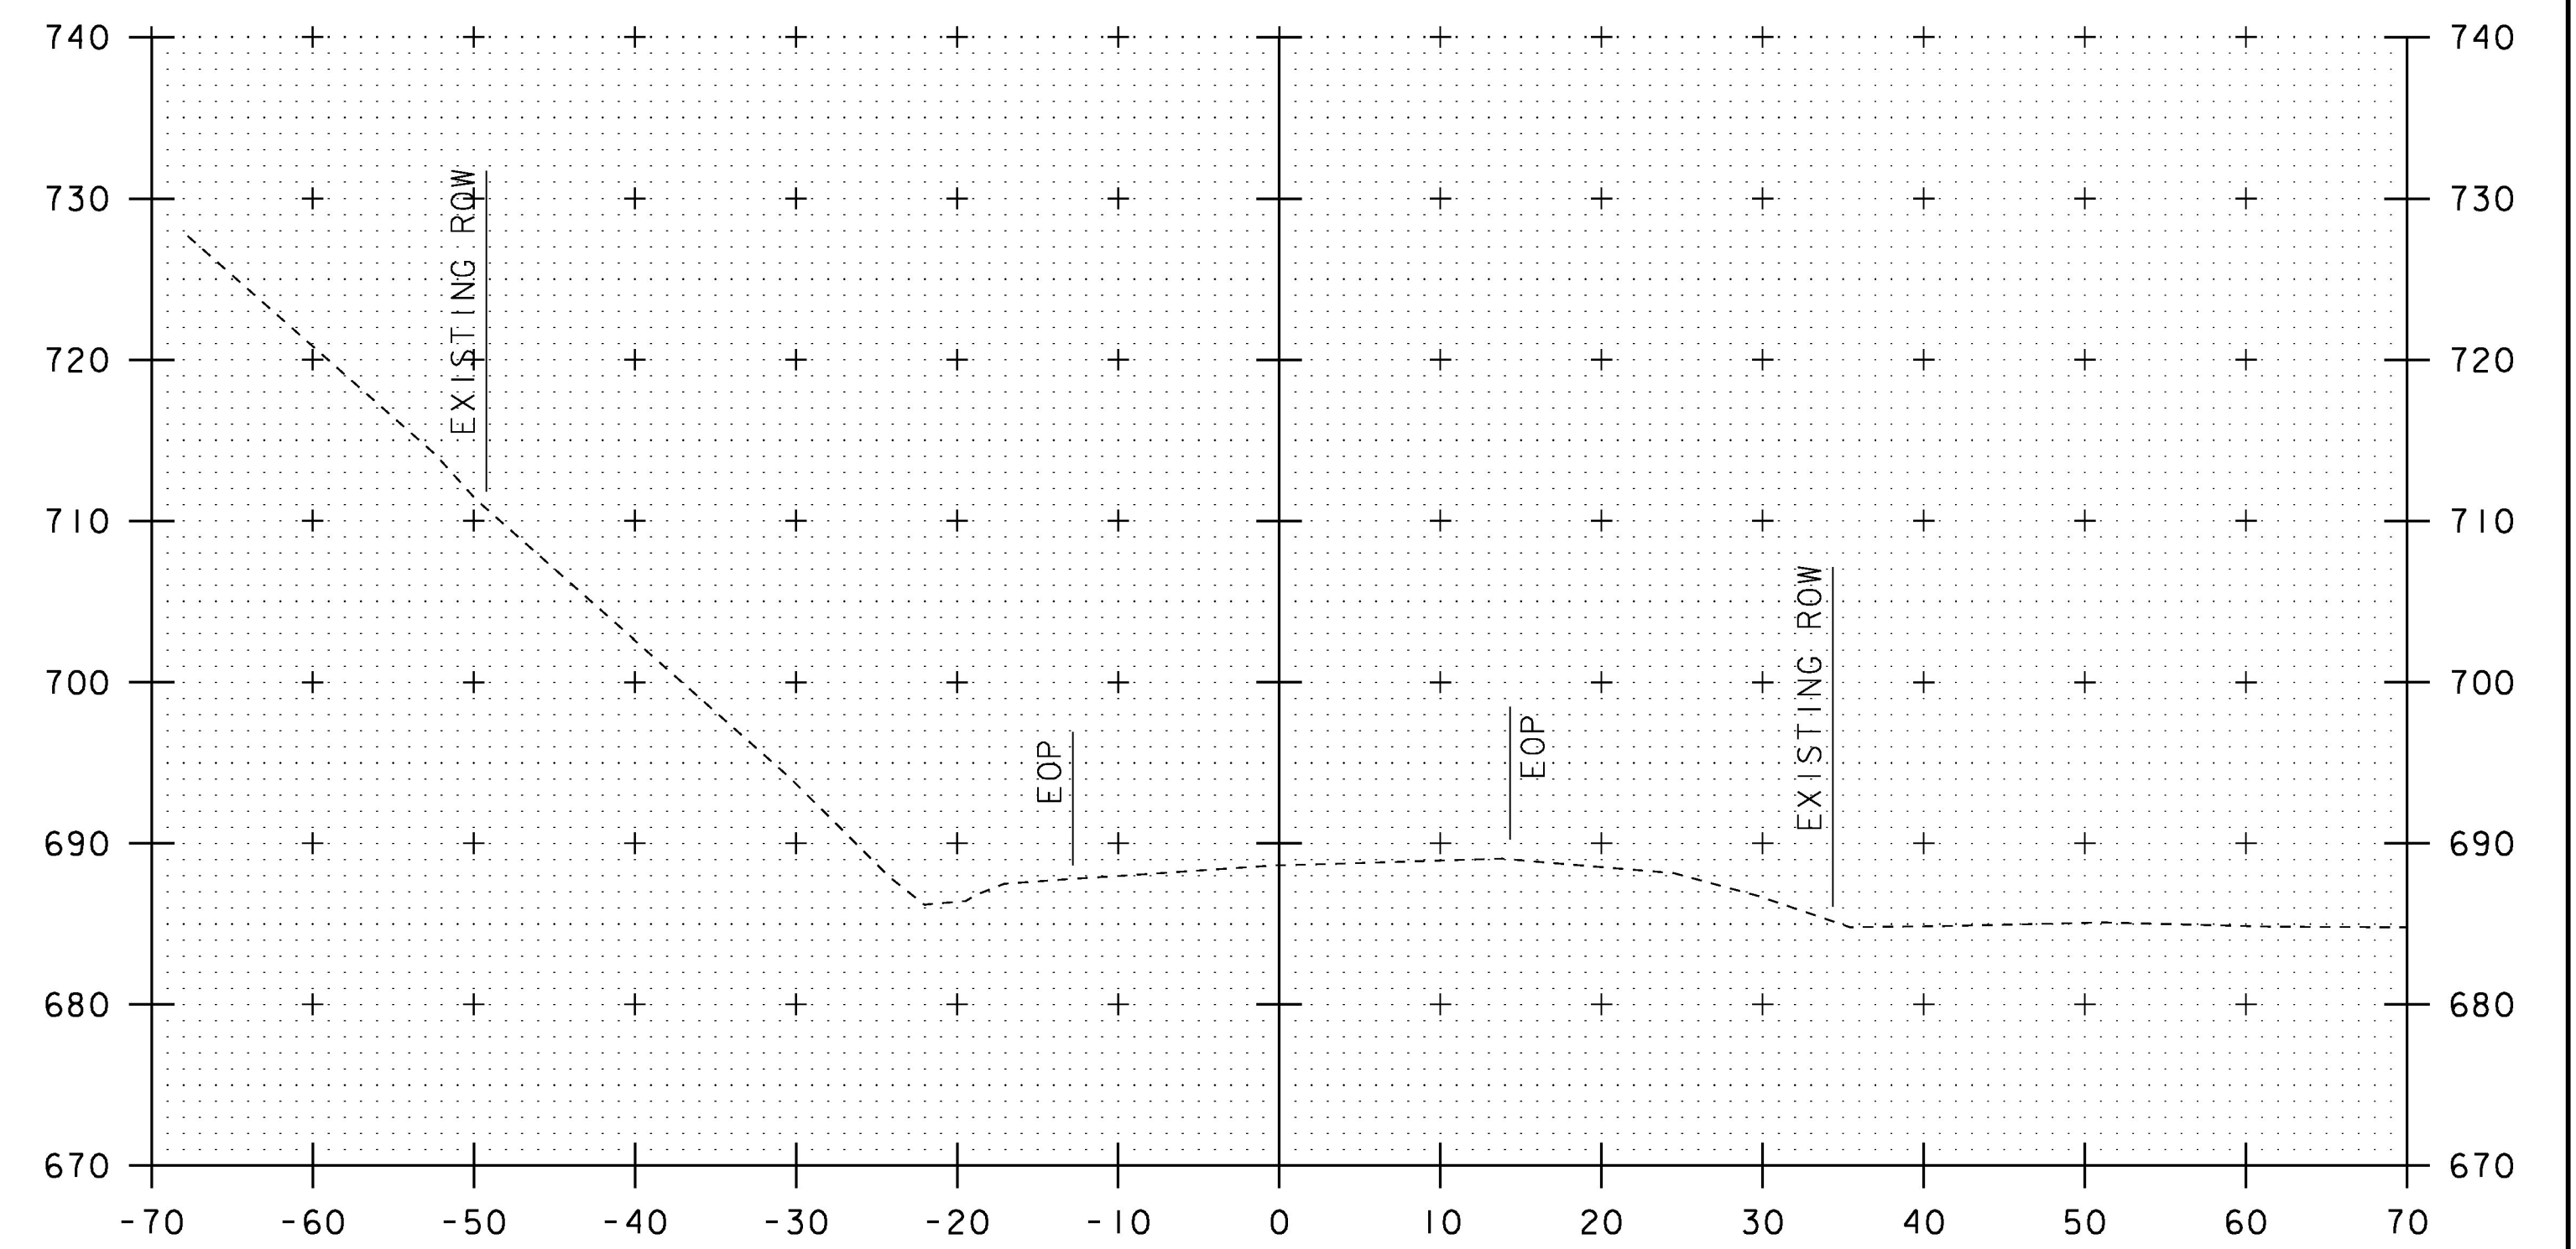

179+67

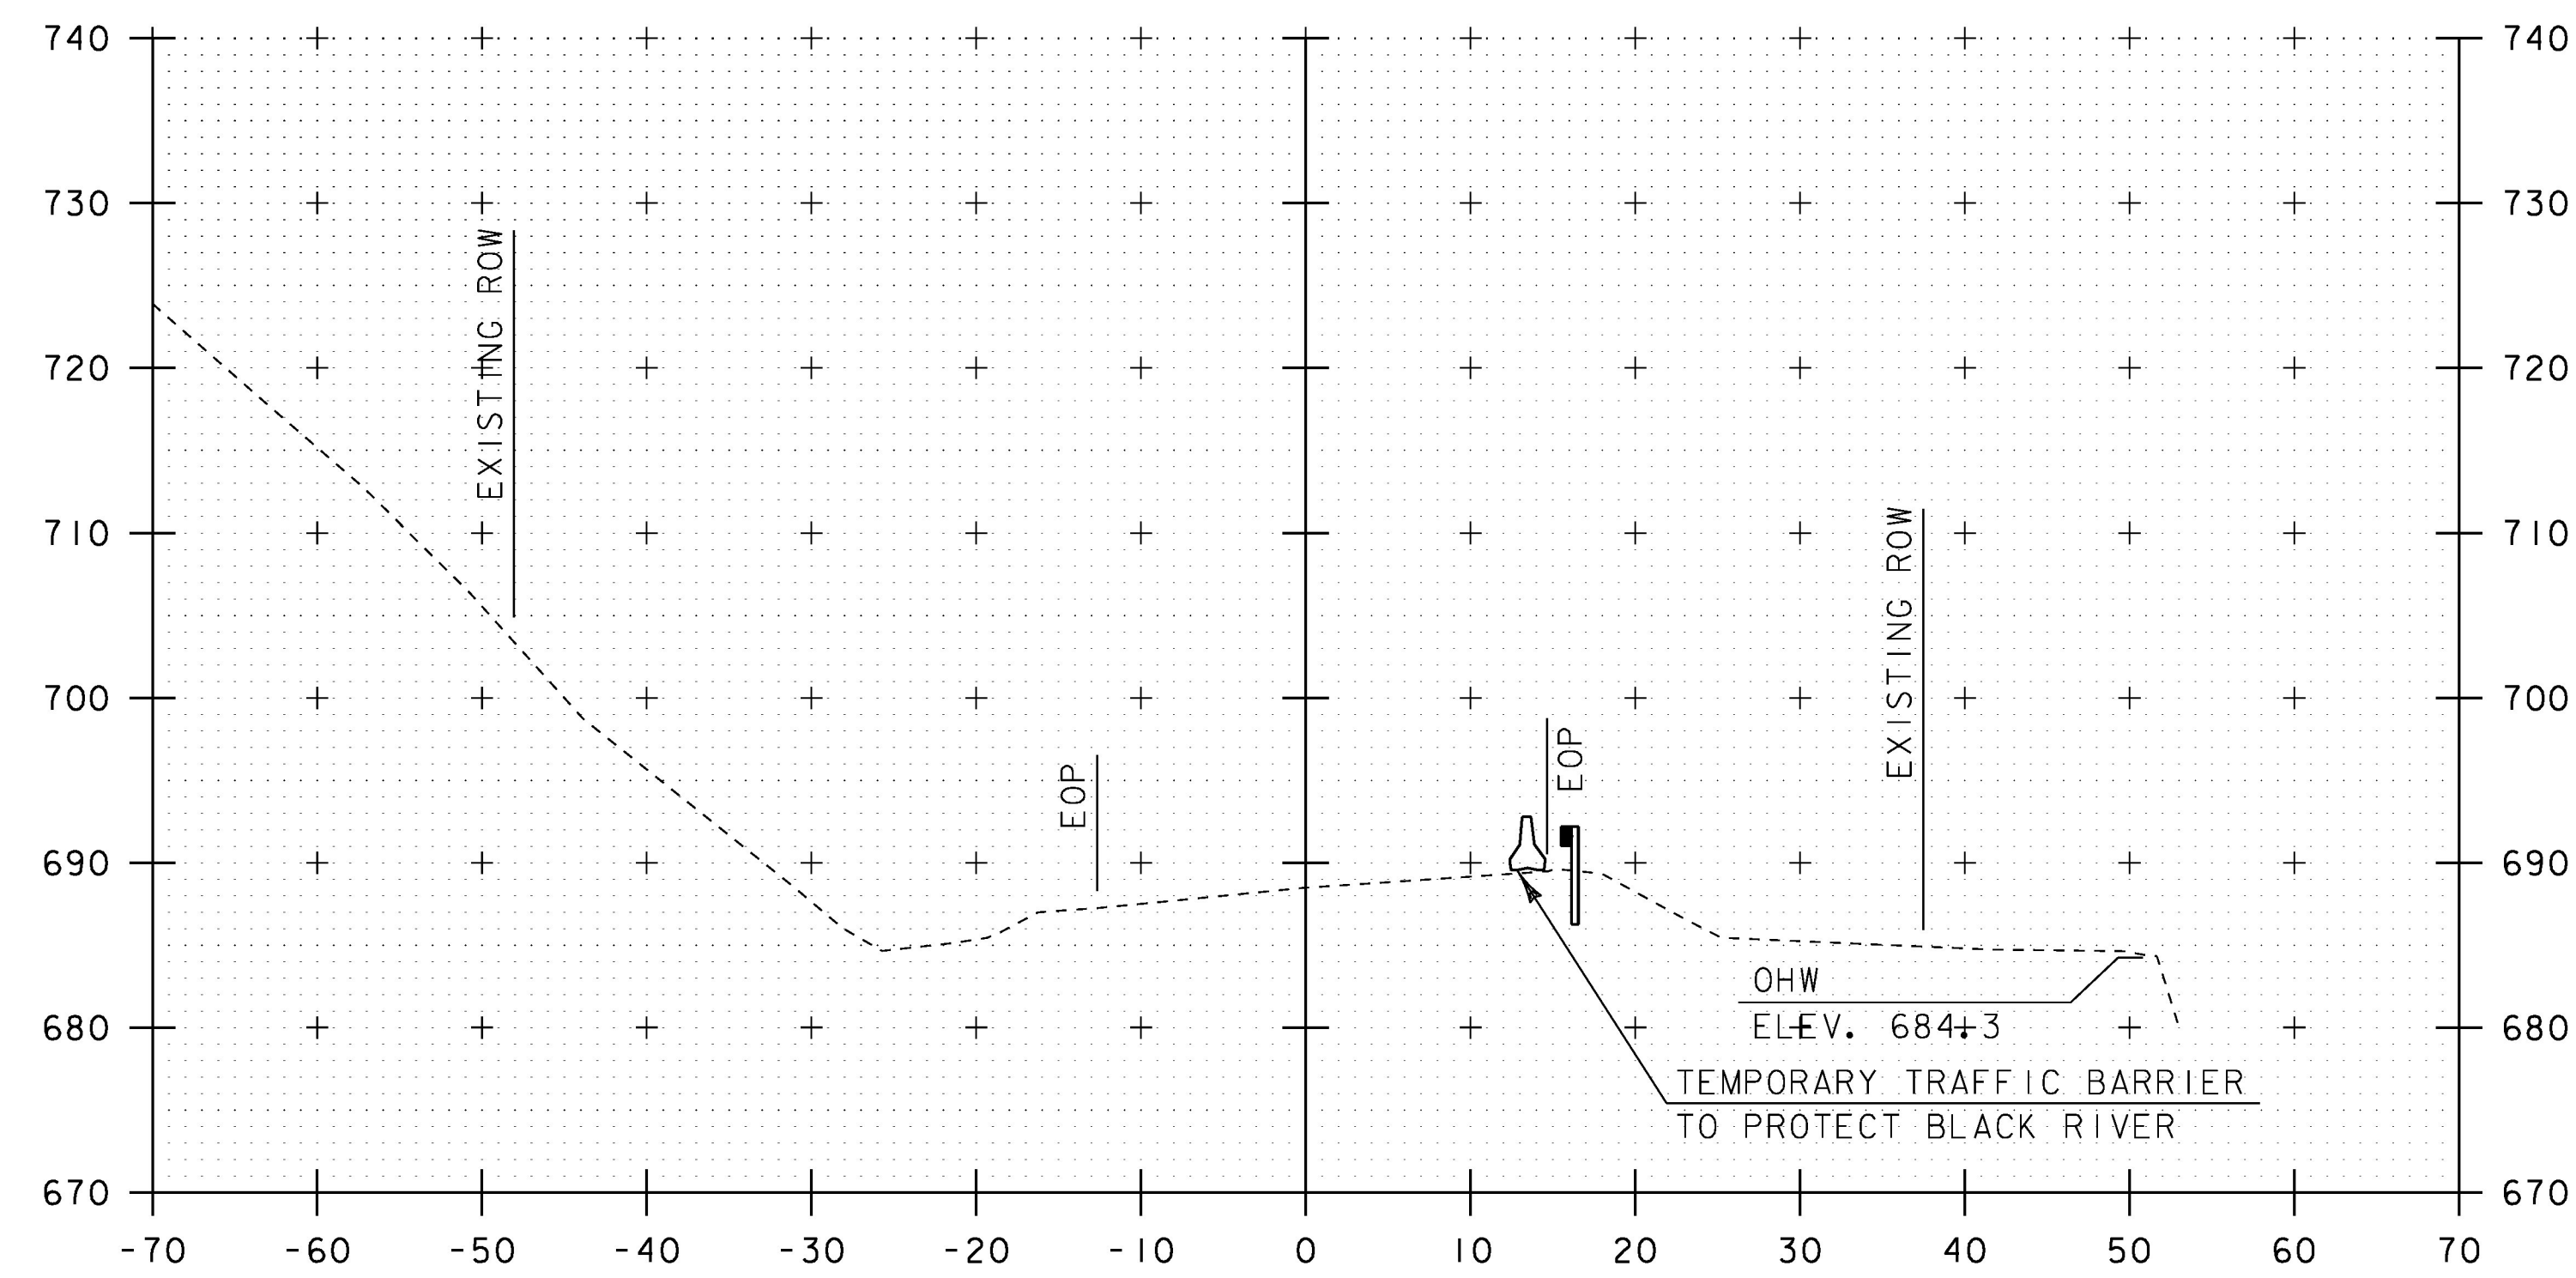

179+00

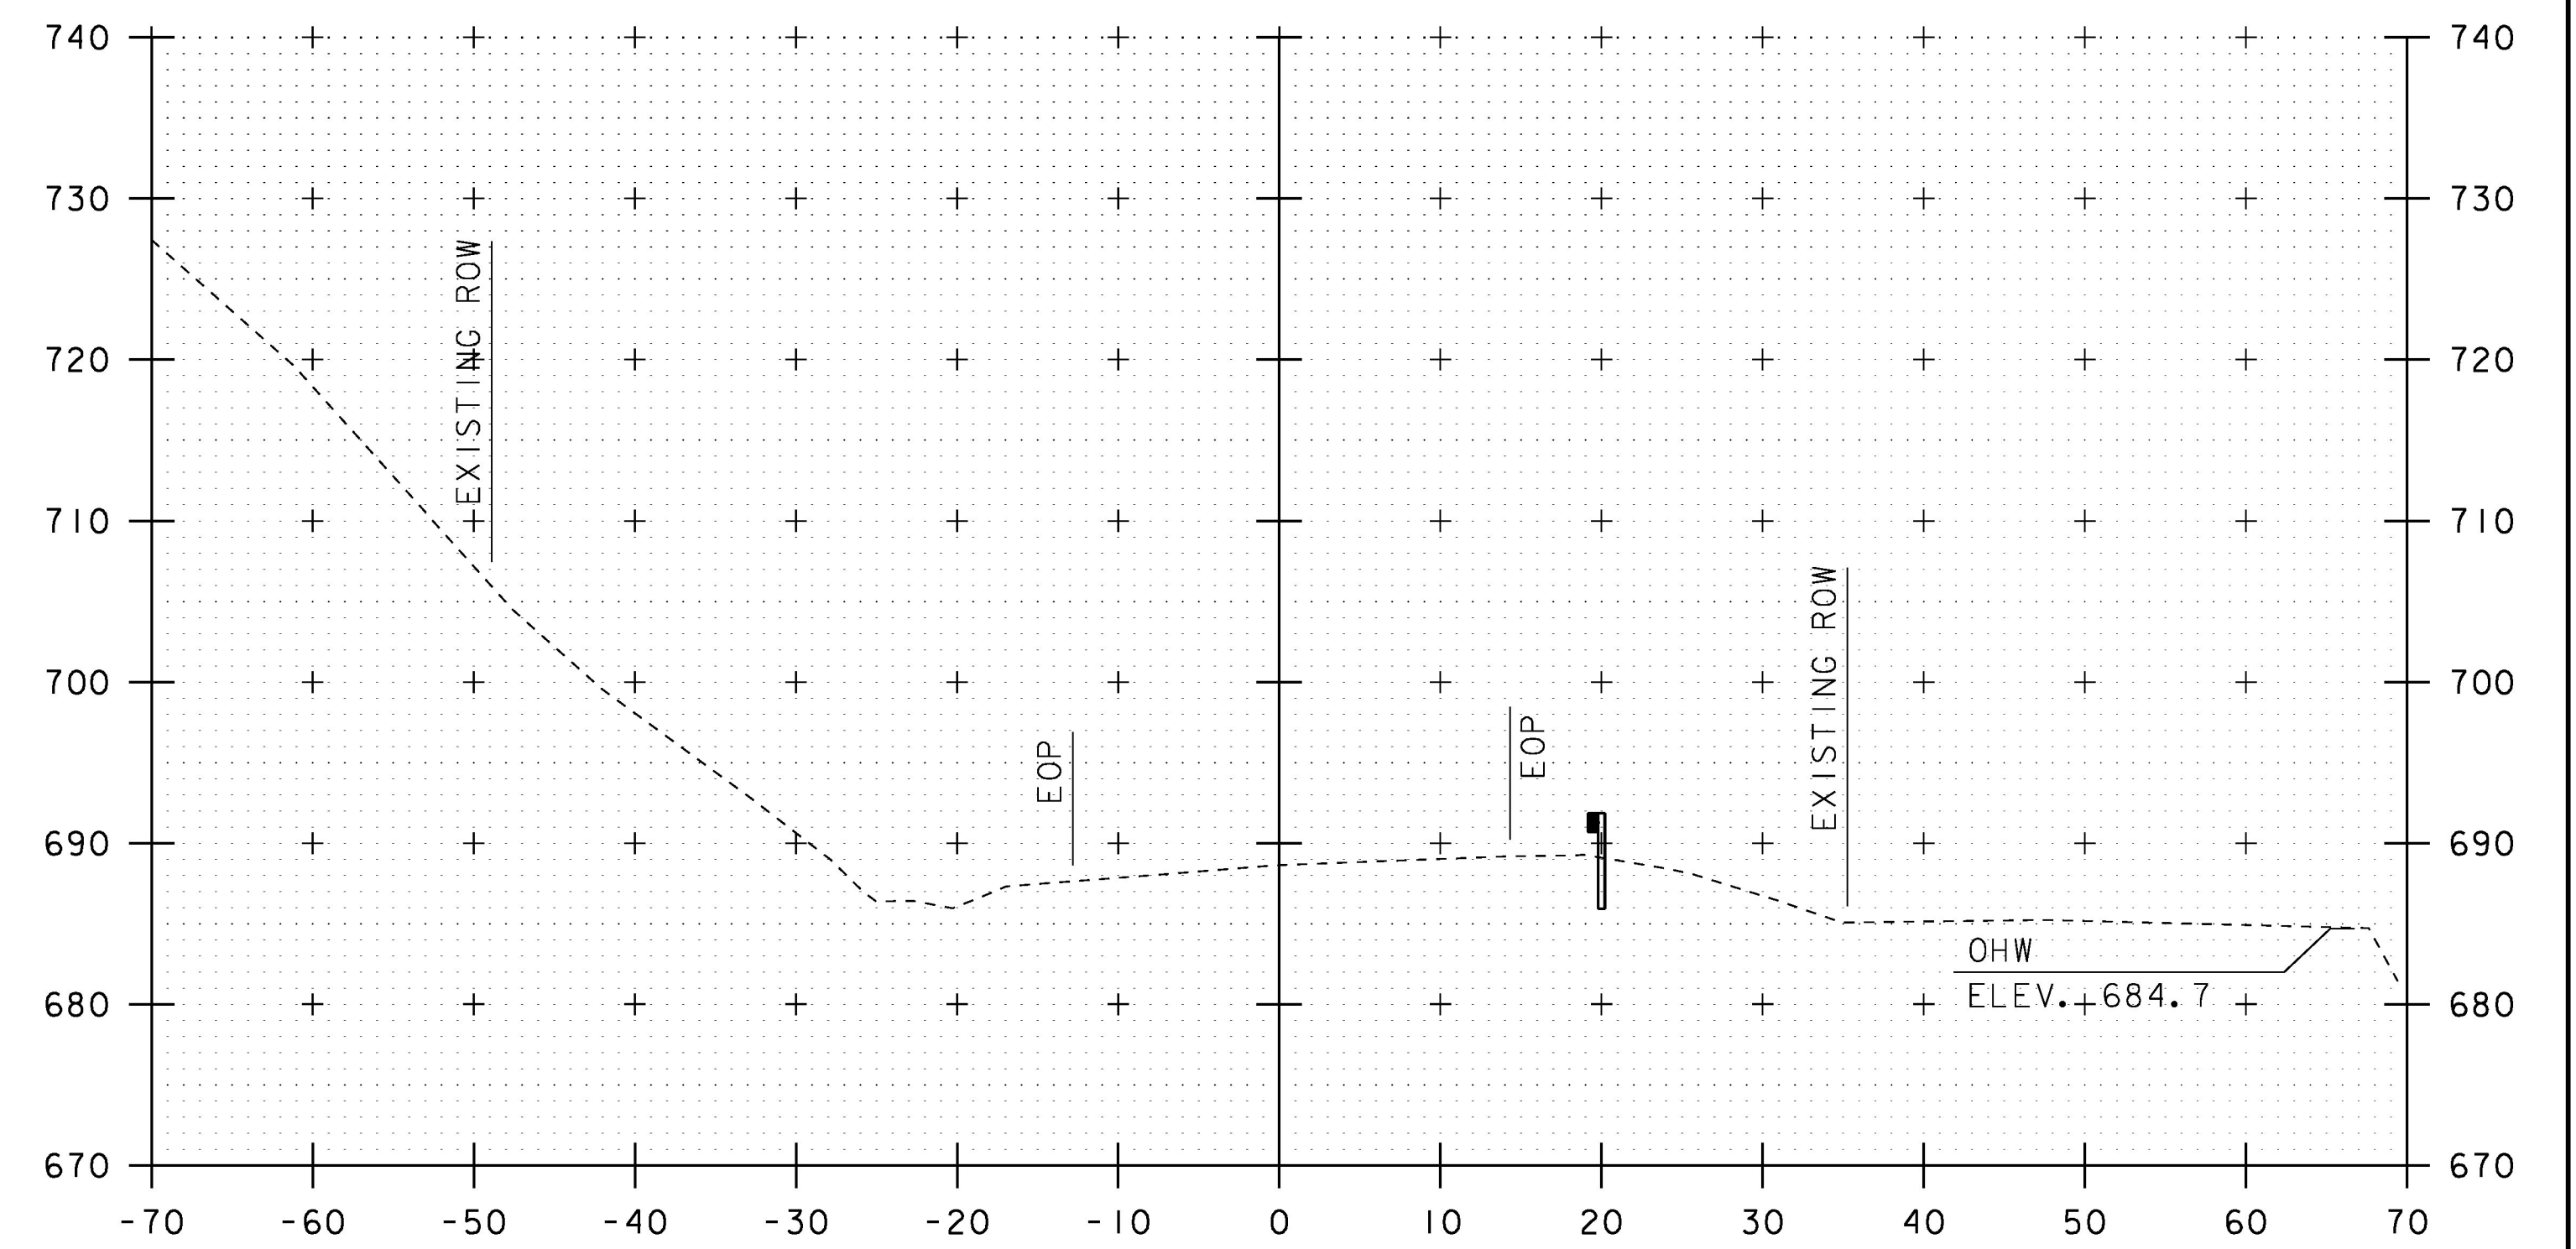

179+50

STA. 179+00 TO STA. 179+67

PROJECT NAME:	COVENTRY
PROJECT NUMBER:	STP 0113(66)
FILE NAME:	d:\0c14\4xsc.dgn
PROJECT LEADER:	K. UPMAL
DESIGNED BY:	S. ZWICK
CROSS SECTION SHEET	8
PLOT DATE:	15-FEB-2017
DRAWN BY:	S. ZWICK
CHECKED BY:	C. LEACH
SHEET	24 OF 29