




180+00

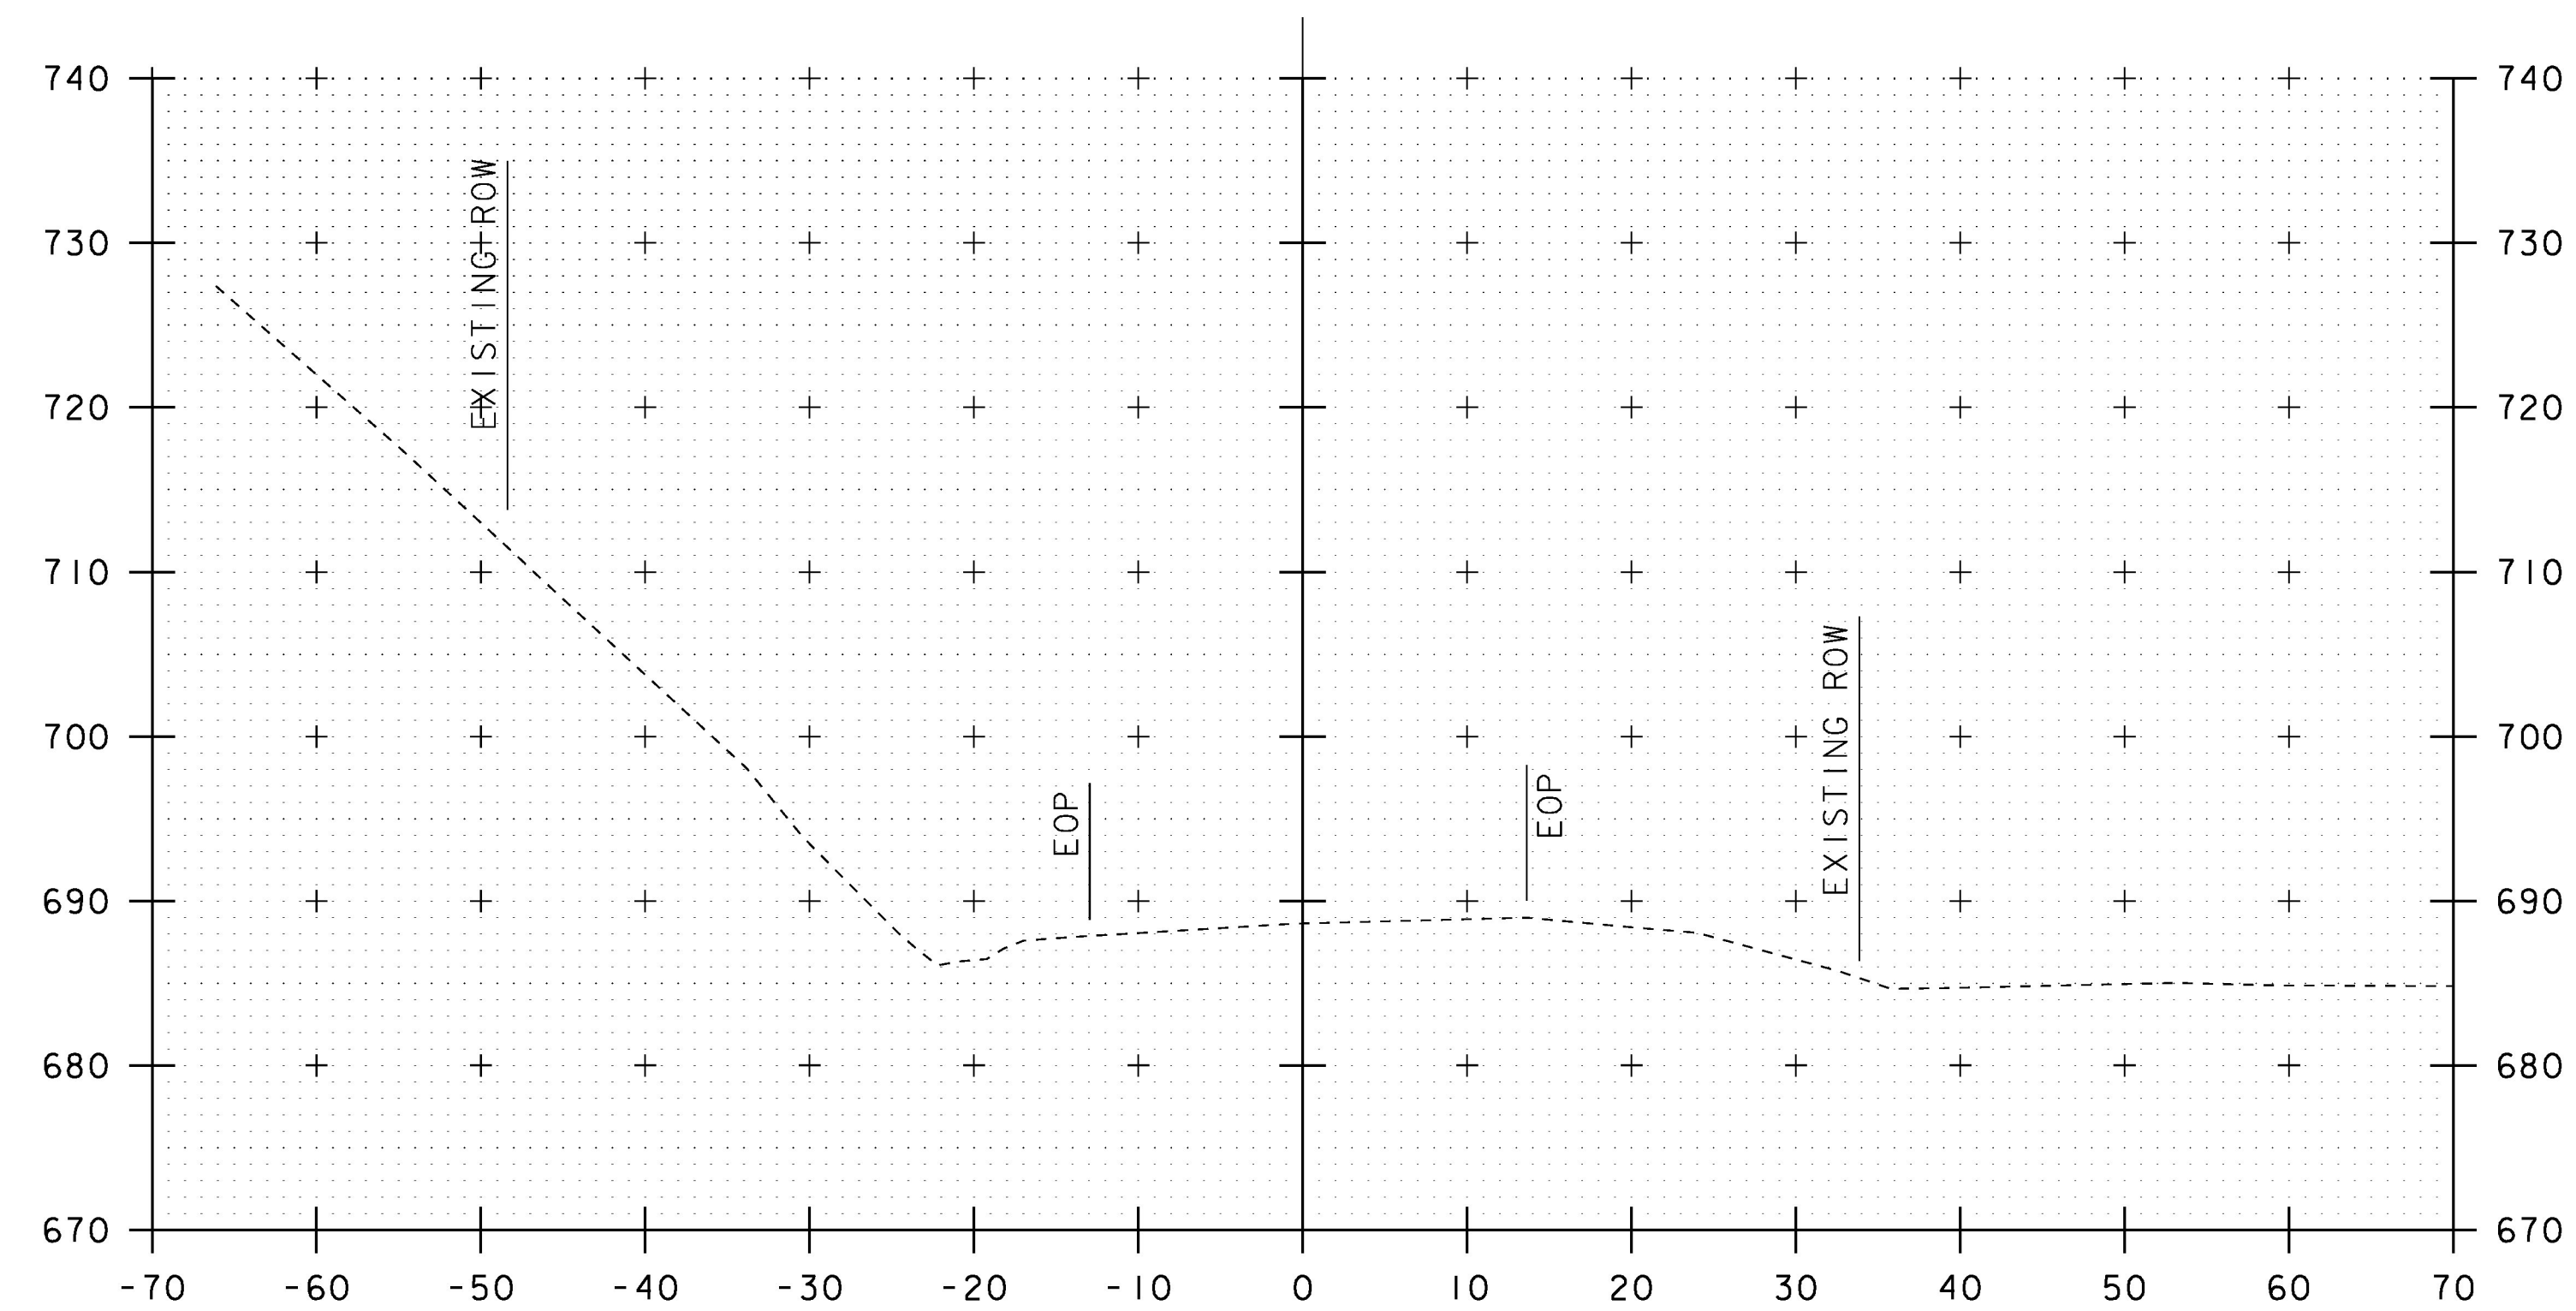


179+75

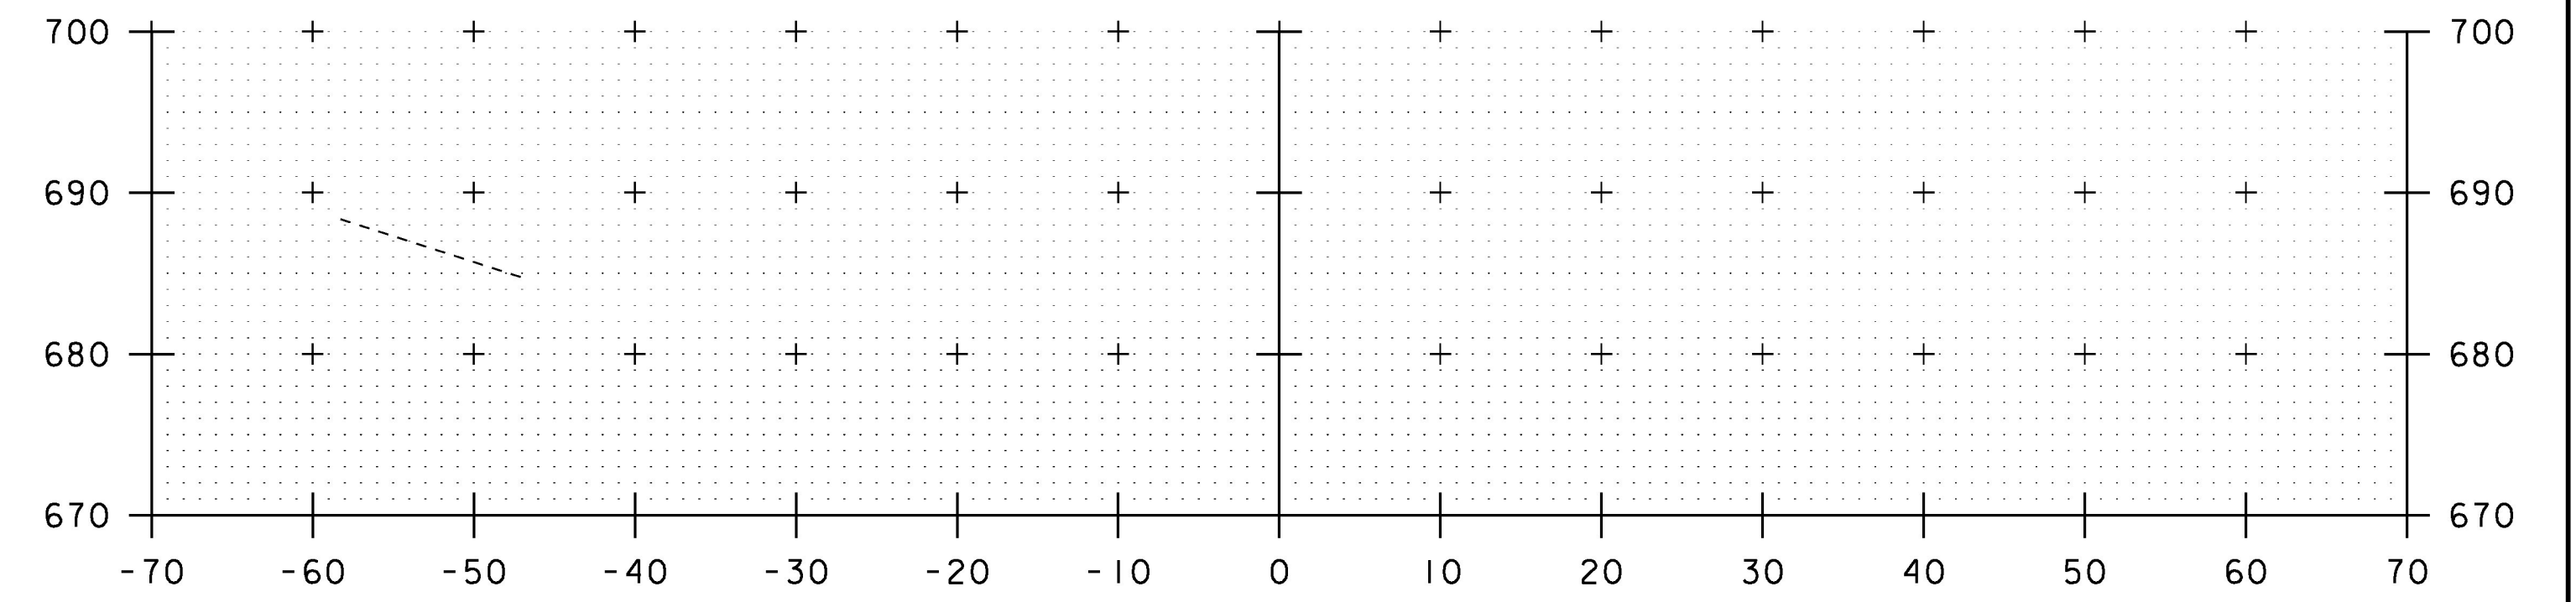

180+60
END PROJECT

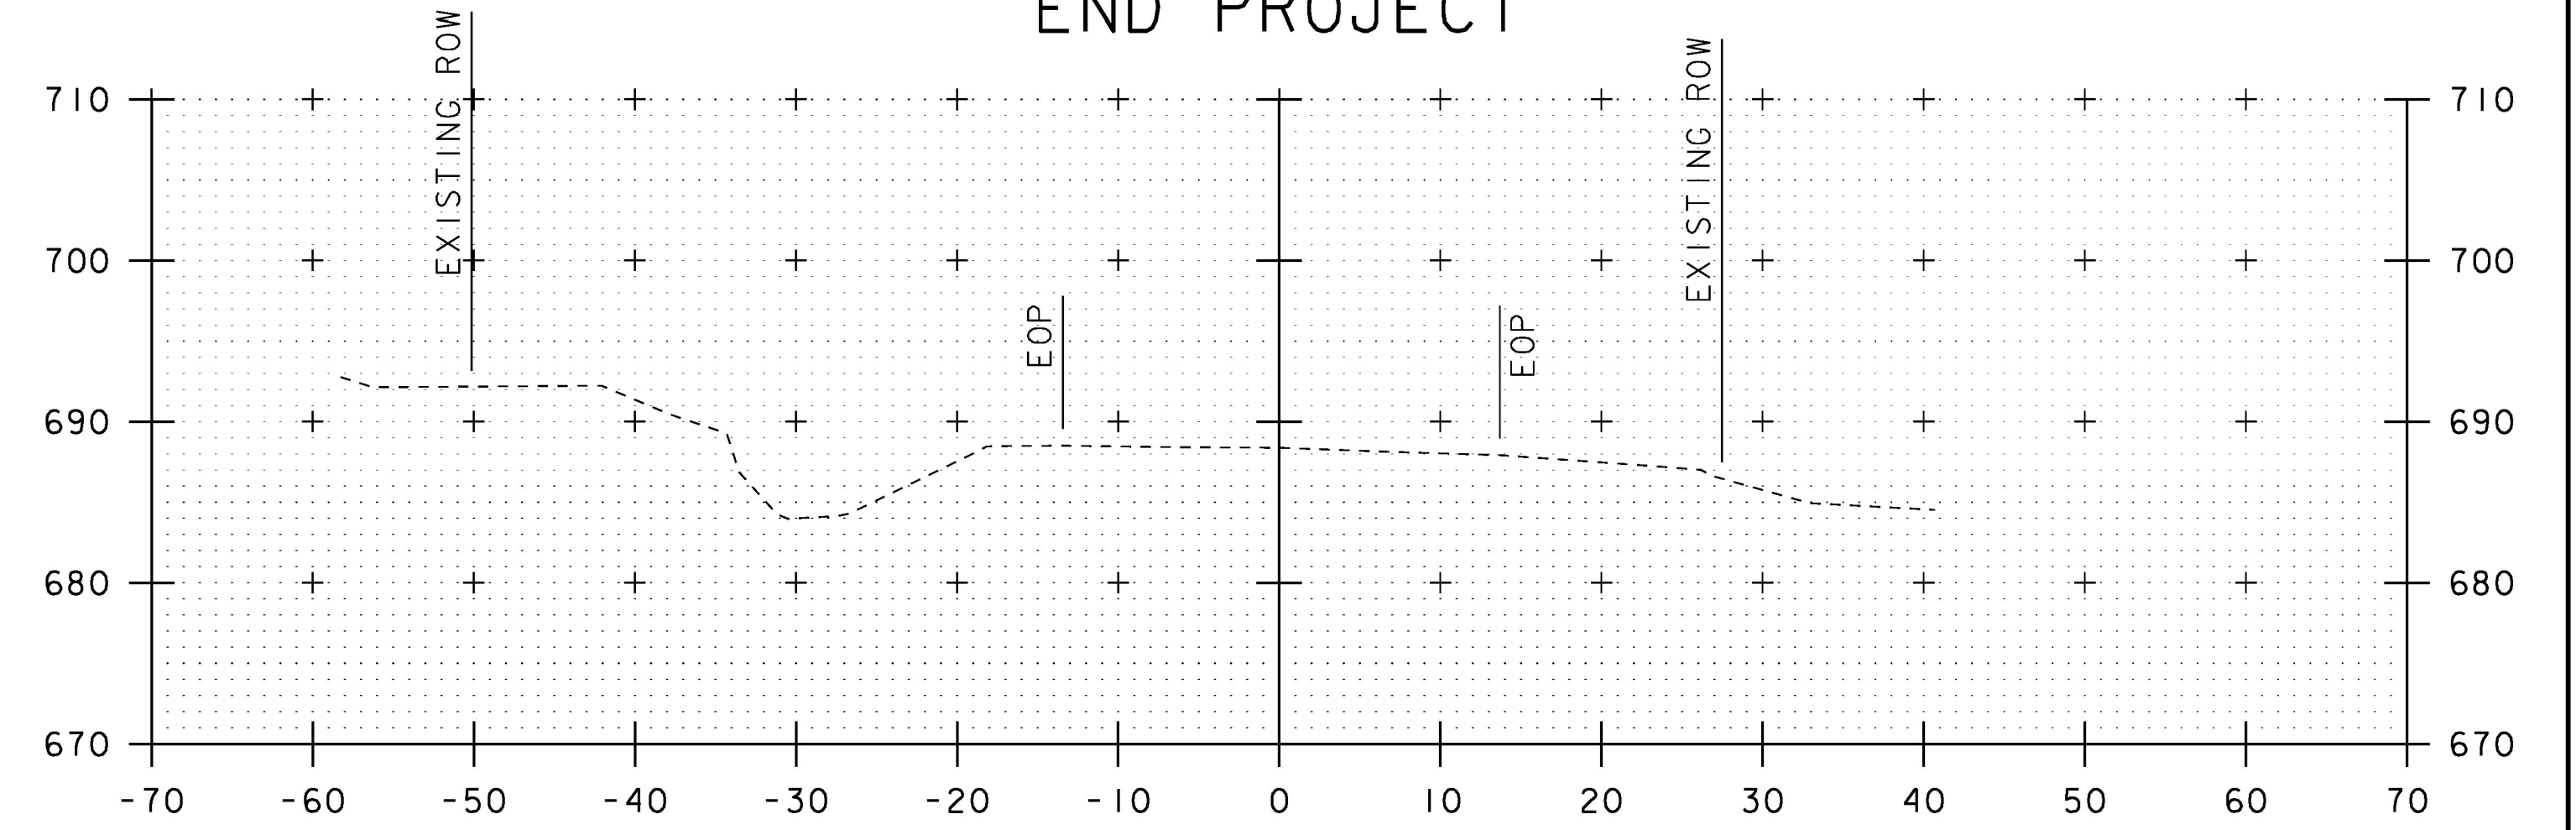

180+50

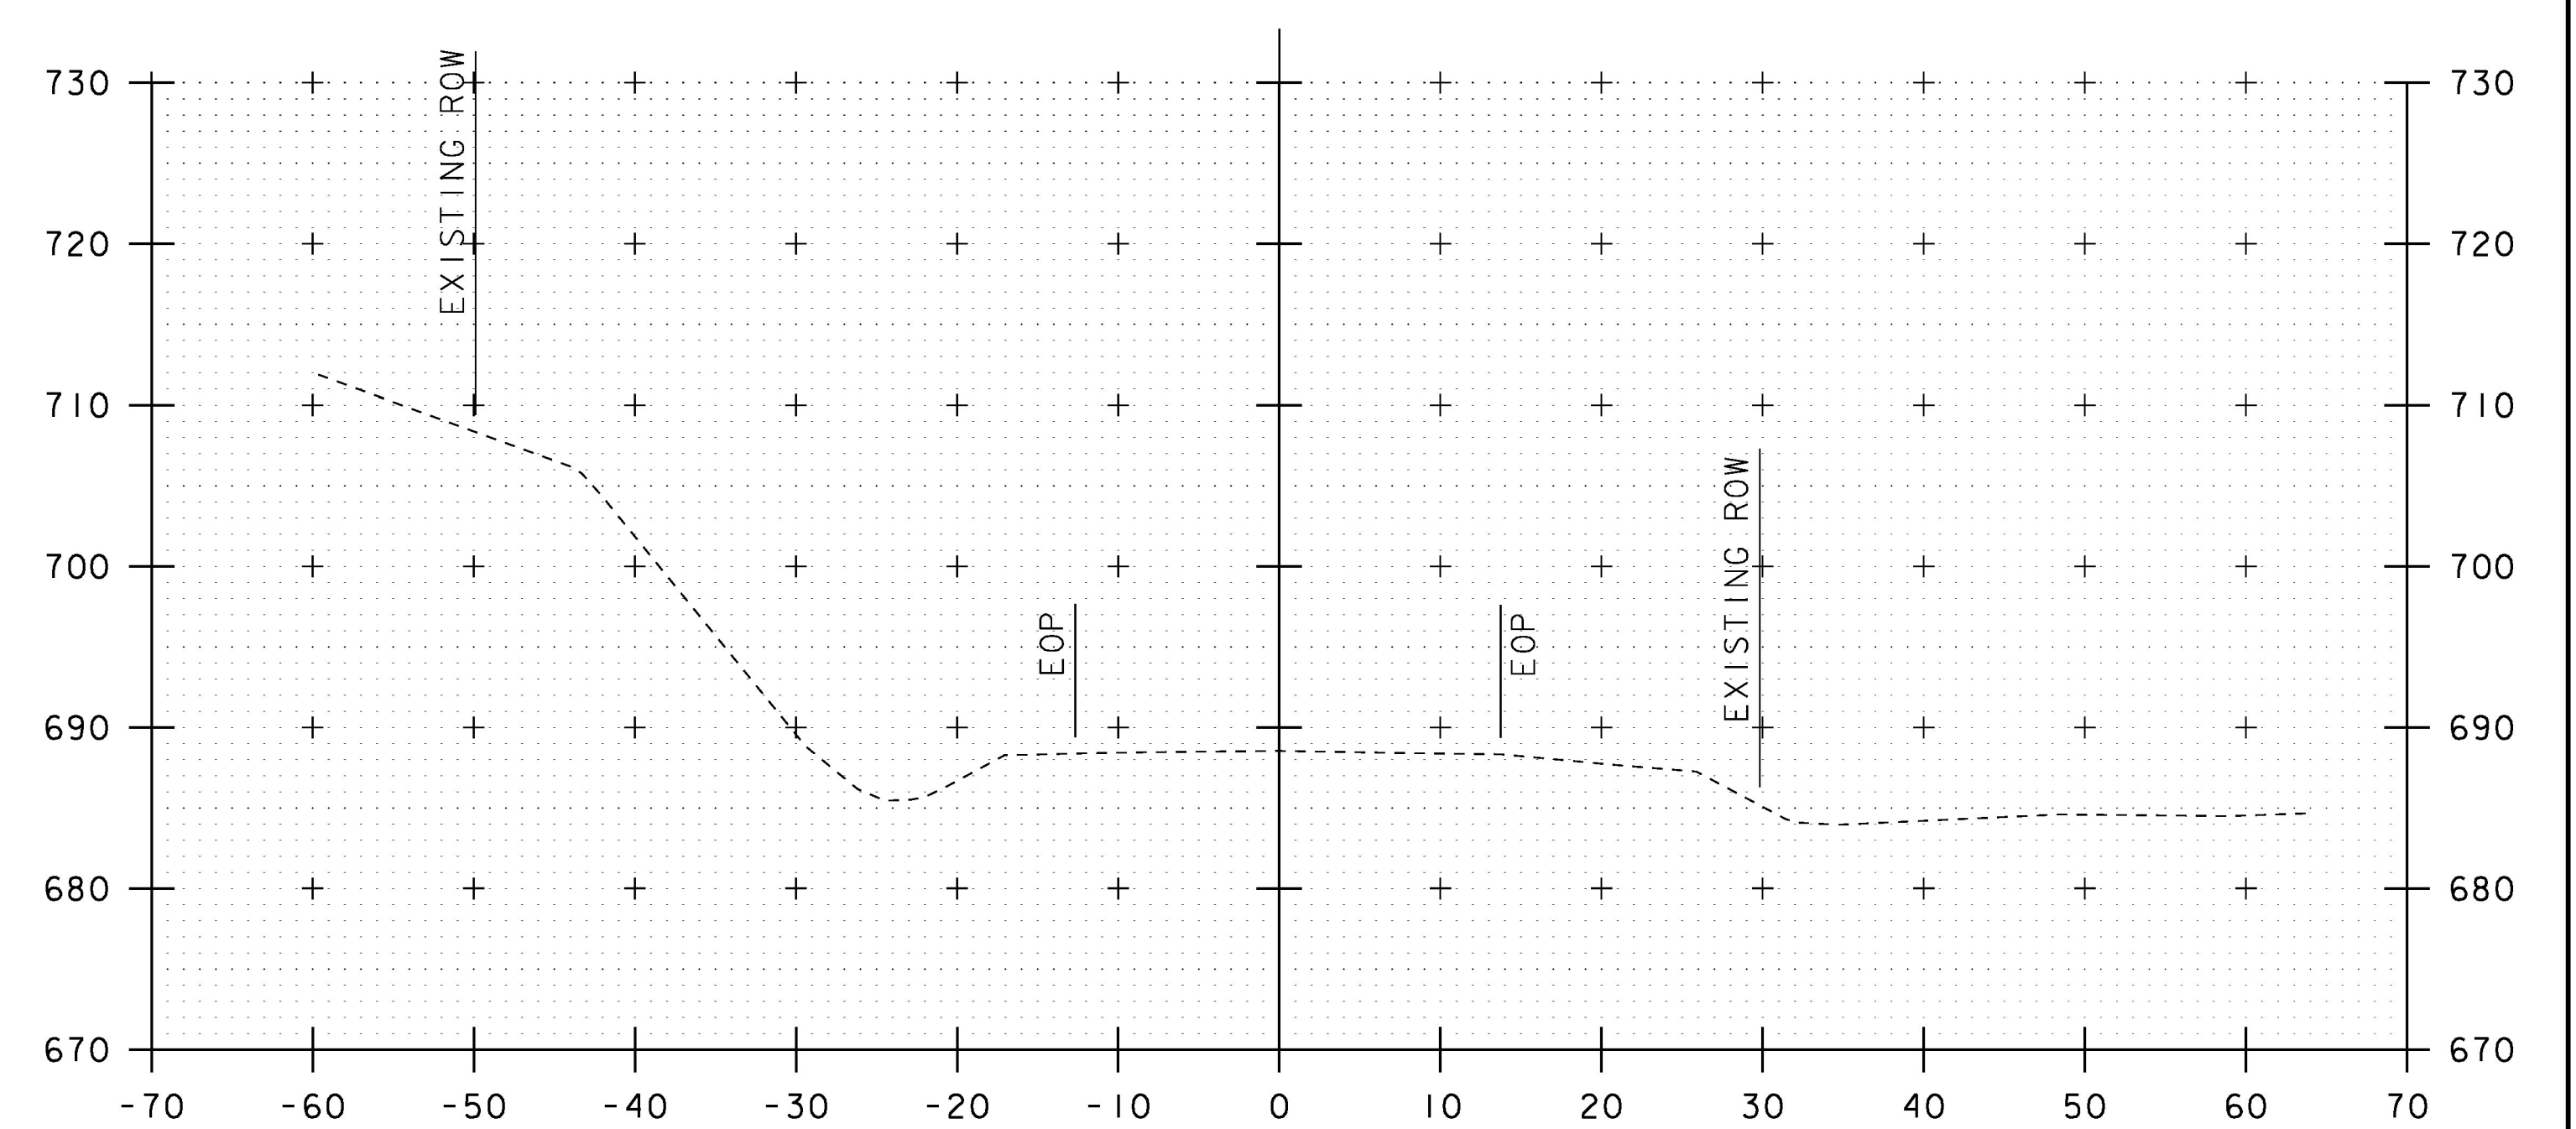

180+25

STA. 179+75 TO STA. 180+60

PROJECT NAME: COVENTRY	PLOT DATE: 15-FEB-2017
PROJECT NUMBER: STP 0113(66)	DRAWN BY: S. ZWICK
FILE NAME: d10c114xsc.dgn	CHECKED BY: C. LEACH
PROJECT LEADER: K. UPMAL	SHEET 25 OF 29
DESIGNED BY: S. ZWICK	
CROSS SECTION SHEET 9	