

DURABLE 4 INCH WHITE LINE (SEE OPTION ITEMS)
 STA. 11+25 - STA. 16+75 (SOLID LT & RT)

TEMPORARY 4 INCH WHITE LINE, PAINT
 STA. 11+25 - STA. 16+75 (SOLID LT & RT)

6 INCH UNDERDRAIN PIPE
 STA. 11+25 - STA. 13+75 RT
 STA. 15+98 - STA. 16+75 RT

DURABLE 4 INCH YELLOW LINE (SEE OPTION ITEMS)
 STA. 11+25 - STA. 16+75 (SOLID LT & RT)

TEMPORARY 4 INCH YELLOW LINE, PAINT
 STA. 11+25 - STA. 16+75 (SOLID LT & RT)

RELOCATE MAILBOX, SINGLE SUPPORT
 STA. 13+70 LT

BARRIER FENCE
 STA. 14+23 - STA. 15+60 LT
 STA. 14+33 - STA. 16+12 RT

STONE FILL, TYPE 1
 STA. 15+30 - STA. 16+10 RT

REMOVING SIGNS
 AS SHOWN - 3

EROSION LOG
 STA. 14+23 - STA. 15+60 LT
 STA. 14+33 - STA. 16+12 RT


GRUBBING MATERIAL
 STA. 15+30 - STA. 16+10 RT

GEOTEXTILE UNDER STONE FILL
 STA. 15+30 - STA. 16+10 RT

GEOTEXTILE FOR SILT FENCE
 STA. 15+30 - STA. 16+10 RT

ENVIRONMENTALLY SENSITIVE LOCATIONS:

NO.	LIMITS	POS.	TYPE
1.	STA. 14+23 - STA. 15+60	LT	-
2.	STA. 14+33 - STA. 16+12	RT	-

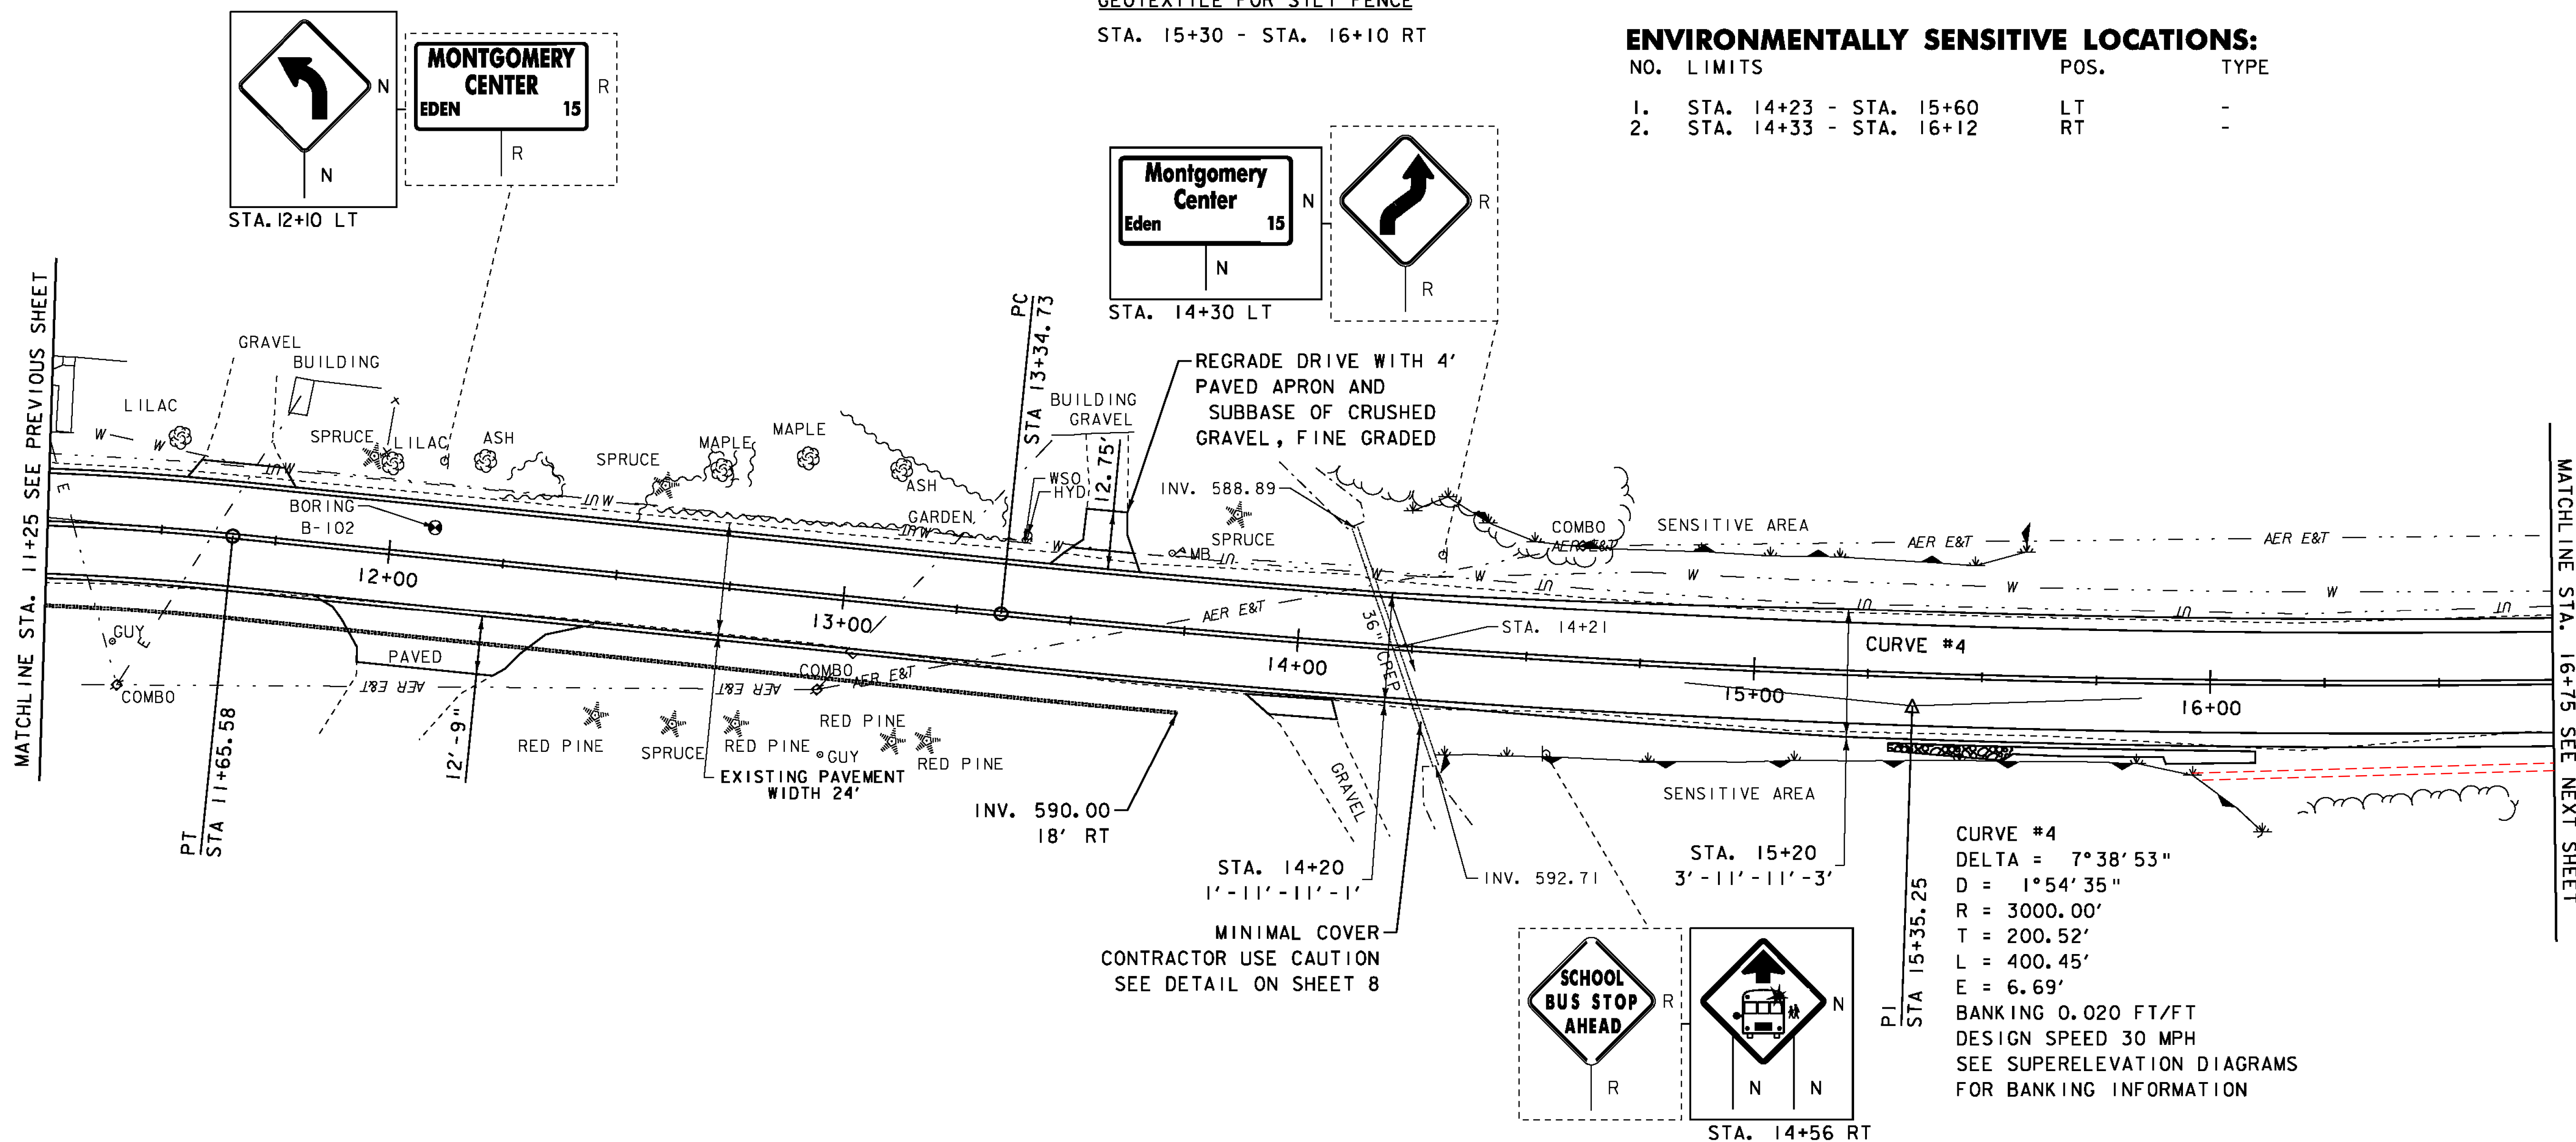

SIGN LEGEND
 R = REMOVE
 R&S = REMOVE AND SALVAGE
 RET = RETAIN
 S = SALVAGED
 N = NEW
 B-B = BACK TO BACK
 --- = EXISTING
 — = NEW

LEGEND
 MAILBOX ○ MANHOLE ⊖ CURB INLET
 BORING ⊙ WATER SHUT OFF (WSO) ⊠ TRAFFIC CONTROL BOX
 SIGN ⊙ GAS PIPELINE MARKER ⊕ PARKING METER
 HYDRANT ⊠ CATCH BASIN / DROP INLET ⊖ UTILITY POLE

DATUM
 NAVD 88
 NAD 83

SCALE IN FEET
 20 0 20

PROJECT LAYOUT SHEET 3

PROJECT NAME: MONTGOMERY-WESTFIELD
 PROJECT NUMBER: STP 2906(I)

FILE NAME: pi0CI90.dgn
 PROJECT LEADER: CDL
 DESIGNED BY: SJL
 PLOT FILE: pi0CI90_24.1

PLOT DATE: 9/5/12
 DRAWN BY: SJL
 CHECKED BY: EPD
 SHEET 24 OF 178

SEH
 2-25-14