

DURABLE 4 INCH WHITE LINE (SEE OPTION ITEMS)

STA. 33+25 - STA. 38+75 (SOLID LT & RT)
(WITH EDGELINE BREAKS AT TH#5)

DURABLE 4 INCH YELLOW LINE (SEE OPTION ITEMS)

STA. 33+25 - STA. 38+75 (SOLID LT & RT)
(WITH CENTERLINE BREAKS AT TH #5)

TEMPORARY 4 INCH WHITE LINE, PAINT

STA. 33+25 - STA. 38+75 (SOLID LT & RT)
(WITH EDGELINE BREAKS AT TH#5)

TEMPORARY 4 INCH YELLOW LINE, PAINT

STA. 33+25 - STA. 38+75 (SOLID LT & RT)
(WITH CENTERLINE BREAKS AT TH #5)

6 INCH UNDERDRAIN PIPE

STA. 33+50 - STA. 37+00 LT
STA. ~~38+00~~ - STA. 38+75 LT
~~37+98~~

THINNING AND TRIMMING FOR SIGNS

STA. 34+39 LT

REMOVING SIGNS

AS SHOWN - 2

GEOTEXTILE UNDER STONE FILL

STA. 35+03 - STA. 36+47 RT
STA. 36+83 - STA. 37+44 RT
STA. 37+54 - STA. 38+75 RT

GEOTEXTILE FOR SILT FENCE


STA. 35+03 - STA. 36+47 RT
STA. 36+83 - STA. 37+44 RT
STA. 37+54 - STA. 38+75 RT

STONE FILL, TYPE I



STA. 35+03 - STA. 36+47 RT
STA. 36+83 - STA. 37+44 RT
STA. 37+54 - STA. 38+75 RT

GRUBBING MATERIAL

STA. 35+03 - STA. 36+47 RT
STA. 36+83 - STA. 37+44 RT
STA. 37+54 - STA. 38+75 RT

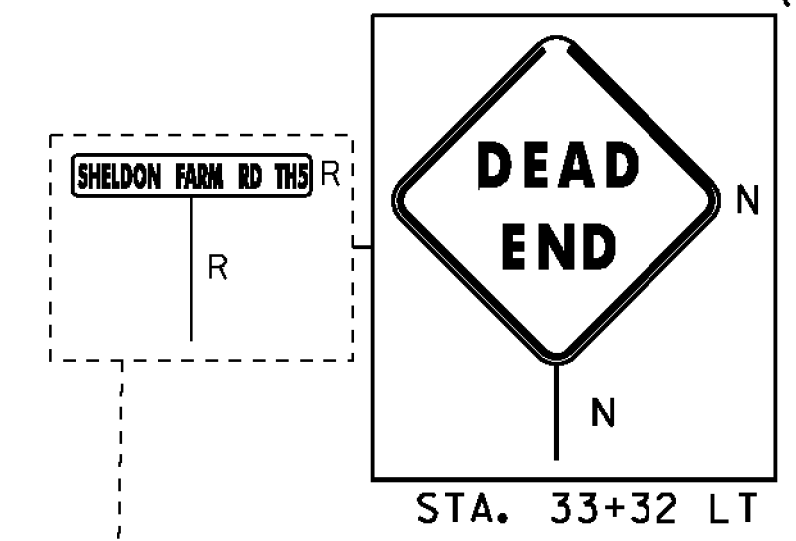

CURVE #7
DELTA = 11°34'49"
D = 4°46'29"
R = 1200.00'
T = 121.68'
L = 242.53'
E = 6.15'
BANKING 0.053 FT/FT
DESIGN SPEED 40 MPH
SEE SUPERELEVATION DIAGRAMS
FOR BANKING INFORMATION

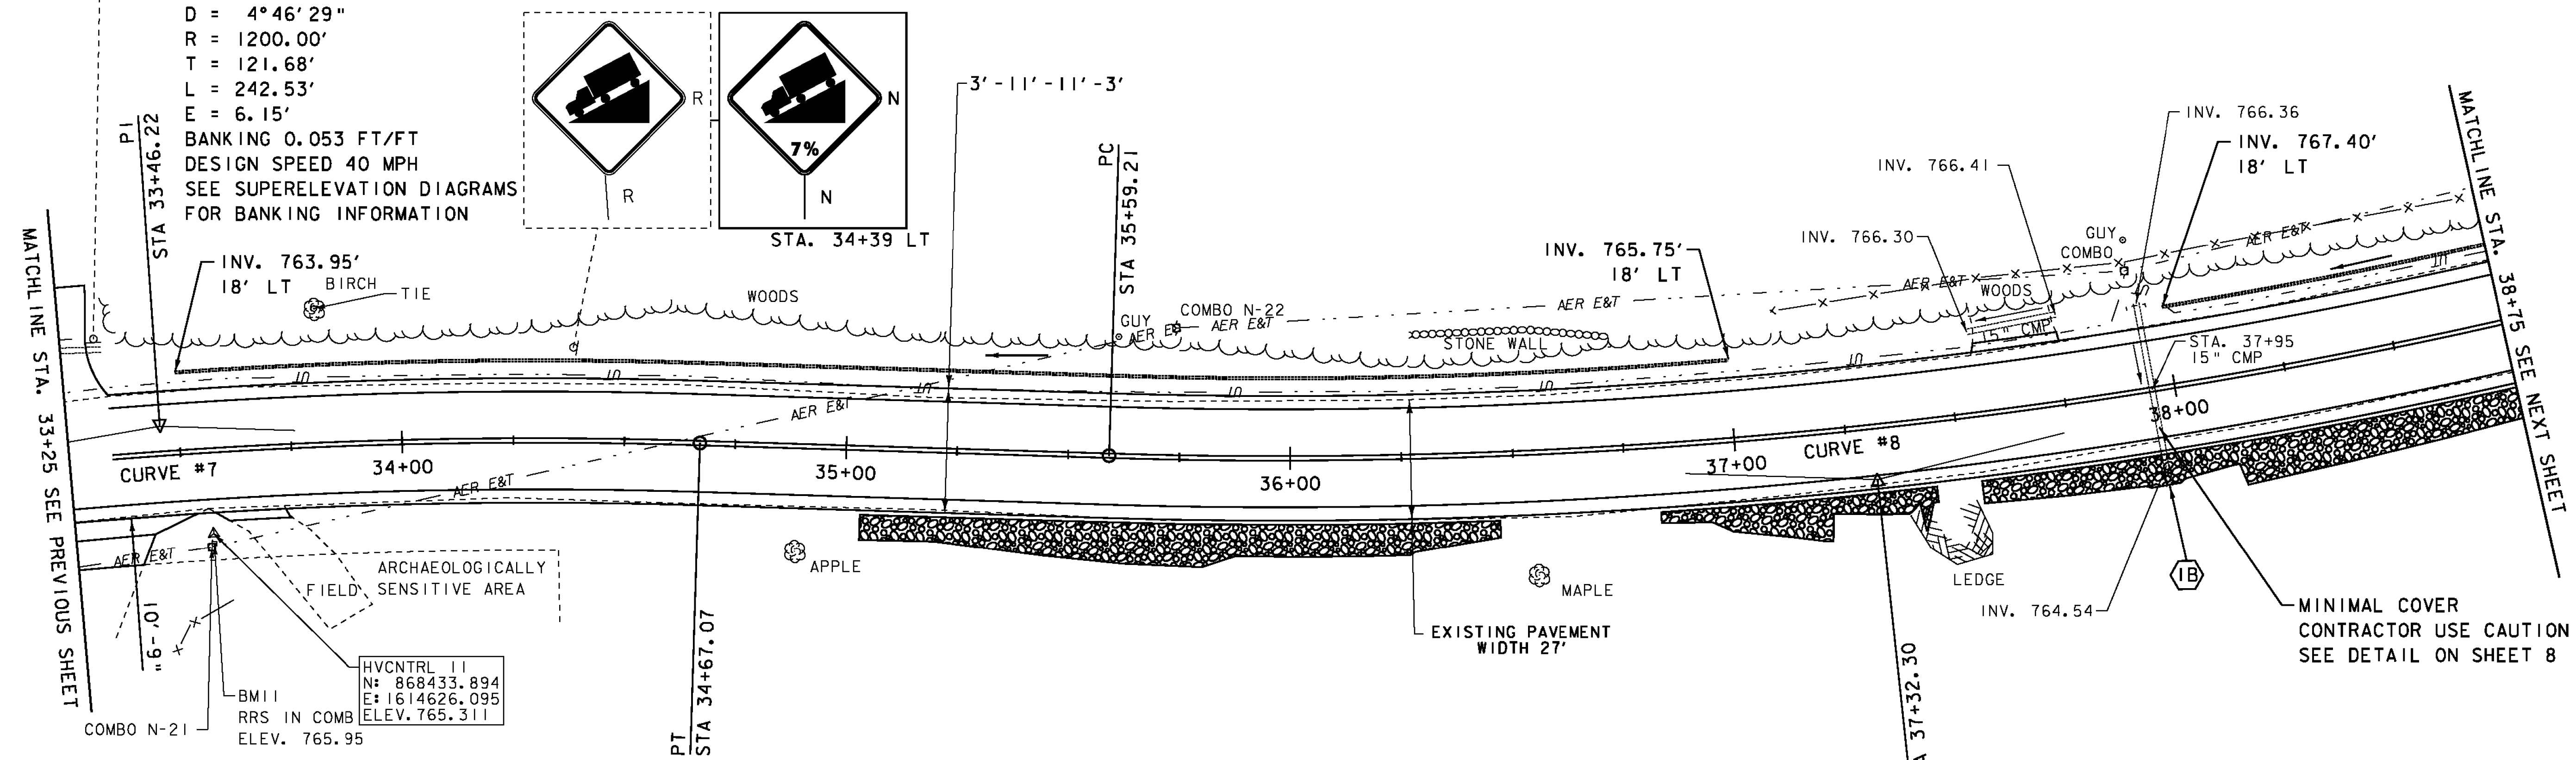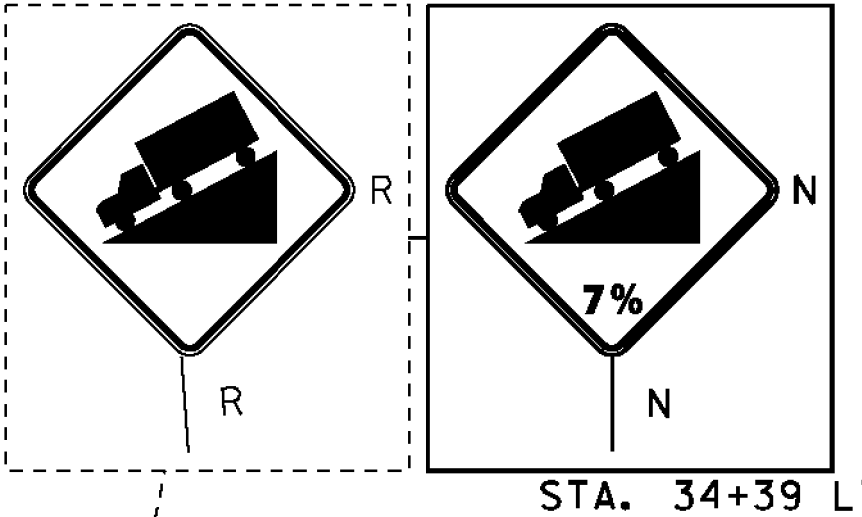

CURVE #8
DELTA = 15°46'03"
D = 4°35'01"
R = 1250.00'
T = 173.09'
L = 343.99'
E = 11.93'
BANKING 0.052 FT/FT
DESIGN SPEED 40 MPH
SEE SUPERELEVATION DIAGRAMS
FOR BANKING INFORMATION

(IB) STA. 37+95.28 RT 17.48' TO
STA. 37+95.40 RT 21.98'
EXTEND 15" CMP (4'-6")
PROPOSED INV. = 764.32
EXISTING INV. = 764.54

- LEGEND**
- MAILBOX
 - BORING
 - SIGN
 - HYDRANT
 - MANHOLE
 - WATER SHUT OFF (WSO)
 - GAS PIPELINE MARKER
 - CATCH BASIN / DROP INLET
 - CURB INLET
 - TRAFFIC CONTROL BOX
 - PARKING METER
 - UTILITY POLE

- SIGN LEGEND**
- R = REMOVE
 - R&S = REMOVE AND SALVAGE
 - RET = RETAIN
 - S = SALVAGED
 - N = NEW
 - B-B = BACK TO BACK
 - = EXISTING
 - = NEW

DATUM
VERTICAL NAVD 88
HORIZONTAL NAD 83



PROJECT LAYOUT SHEET 7	PROJECT NAME: MONTGOMERY-WESTFIELD	PLOT DATE: 9/5/12
	PROJECT NUMBER: STP 2906(I)	DRAWN BY: SJL
	FILE NAME: pIOC190.dgn	CHECKED BY: EPD
	DESIGNED BY: SJL	SHEET 28 OF 178
	PLOT FILE: pIOC190_28.I	

SEH
2-20-14