

DURABLE 4 INCH WHITE LINE (SEE OPTION ITEMS)
 STA. 38+75 - STA. 44+50 (SOLID LT & RT)

DURABLE 4 INCH YELLOW LINE (SEE OPTION ITEMS)
 STA. 38+75 - STA. 44+50 (SOLID LT & RT)

STONE FILL, TYPE I
 STA. 38+75 - STA. 40+10 RT
 STA. 41+60 - STA. 43+20 RT
 STA. 41+82 - STA. 42+47 LT

GRUBBING MATERIAL
 STA. 38+75 - STA. 40+10 RT
 STA. 41+60 - STA. 43+20 RT
 STA. 41+82 - STA. 42+47 LT

TEMPORARY 4 INCH WHITE LINE, PAINT
 STA. 38+75 - STA. 44+50 (SOLID LT & RT)

TEMPORARY 4 INCH YELLOW LINE, PAINT
 STA. 38+75 - STA. 44+50 (SOLID LT & RT)

GEOTEXTILE UNDER STONE FILL
 STA. 38+75 - STA. 40+10 RT
 STA. 41+60 - STA. 43+20 RT
 STA. 41+82 - STA. 42+47 LT



GEOTEXTILE FOR SILT FENCE
 STA. 38+75 - STA. 40+10 RT
 STA. 41+60 - STA. 43+20 RT
 STA. 41+82 - STA. 42+47 LT

6 INCH UNDERDRAIN PIPE
 STA. 38+75 - STA. ~~42+45~~ 41+58
 STA. 41+65 - STA. 44+50 LT

REMOVING SIGNS
 AS SHOWN - 1

BARRIER FENCE
 STA. 41+93 - STA. 44+50 RT

EROSION LOG
 STA. 41+93 - STA. 44+50 RT

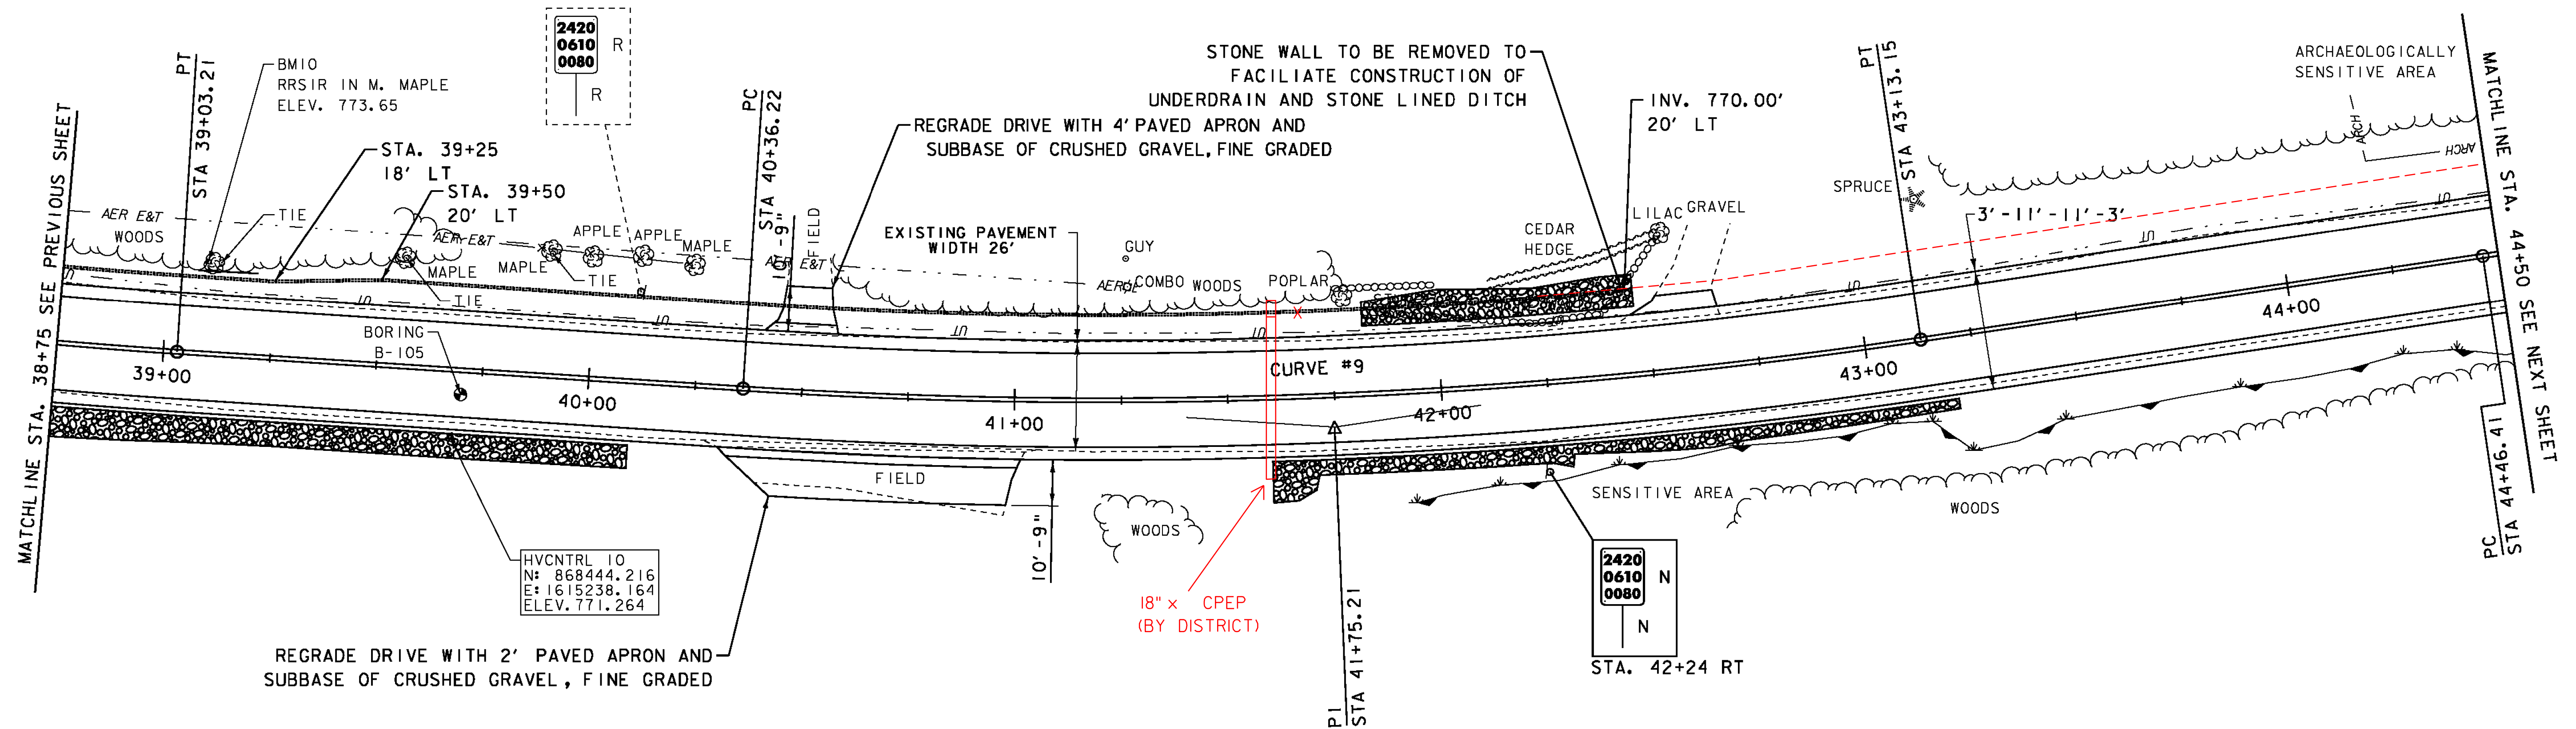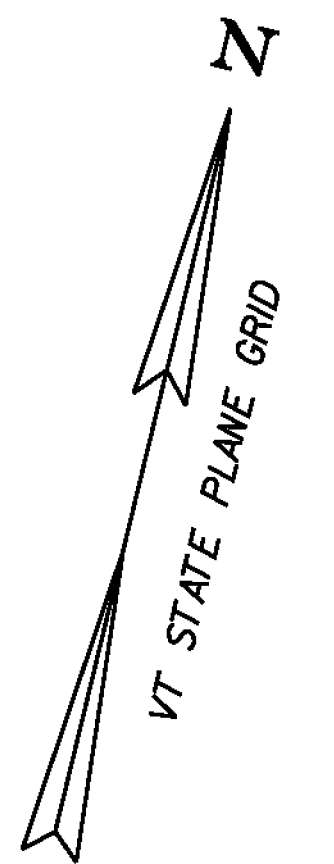

ENVIRONMENTALLY SENSITIVE LOCATIONS:

NO.	LIMITS	POS.	TYPE
3.	STA. 41+93 - STA. 44+50	RT	-

CURVE #9
 DELTA = 12° 12' 20"
 D = 4° 24' 27"
 R = 1300.00'
 T = 138.99'
 L = 276.93'
 E = 7.41'
 BANKING 0.050 FT/FT
 DESIGN SPEED 40 MPH
 SEE SUPERELEVATION DIAGRAMS
 FOR BANKING INFORMATION

- LEGEND**
- MAILBOX
 - BORING
 - SIGN
 - HYDRANT
 - MANHOLE
 - WATER SHUT OFF (WSO)
 - GAS PIPELINE MARKER
 - CATCH BASIN / DROP INLET
 - CURB INLET
 - TRAFFIC CONTROL BOX
 - PARKING METER
 - UTILITY POLE

- SIGN LEGEND**
- R = REMOVE
 - R&S = REMOVE AND SALVAGE
 - RET = RETAIN
 - S = SALVAGED
 - N = NEW
 - B-B = BACK TO BACK
 - = EXISTING
 - = NEW

DATUM
 VERTICAL NAVD 88
 HORIZONTAL NAD 83



PROJECT LAYOUT SHEET 8

PROJECT NAME: MONTGOMERY-WESTFIELD
 PROJECT NUMBER: STP 2906(1)
 FILE NAME: pIOC190.dgn
 PROJECT LEADER: CDL
 DESIGNED BY: SJL
 PLOT FILE: pIOC190_29.1
 PLOT DATE: 9/5/12
 DRAWN BY: SJL
 CHECKED BY: EPD
 SHEET 29 OF 178

SEH
 2-20-14