

DURABLE 4 INCH WHITE LINE (SEE OPTION ITEMS)  
 STA. 44+50 - STA. 49+75 (SOLID LT & RT)

TEMPORARY 4 INCH WHITE LINE, PAINT  
 STA. 44+50 - STA. 49+75 (SOLID LT & RT)



DURABLE 4 INCH YELLOW LINE (SEE OPTION ITEMS)  
 STA. 44+50 - STA. 49+75 (SOLID LT & RT)

TEMPORARY 4 INCH YELLOW LINE, PAINT  
 STA. 44+50 - STA. 49+75 (SOLID LT & RT)

CURVE #10  
 DELTA = 21° 13' 22"  
 D = 3° 08' 22"  
 R = 1825.00'  
 T = 341.92'  
 L = 676.00'  
 E = 31.75'  
 BANKING 0.042 FT/FT  
 DESIGN SPEED 40 MPH  
 SEE SUPERELEVATION DIAGRAMS  
 FOR BANKING INFORMATION

6 INCH UNDERDRAIN PIPE  
 STA. 47+75 - STA. 49+75 LT  
 STA. 44+50 - STA. 44+69

HVCNTRL 9  
 N: 868734.152  
 E: 1616127.982  
 ELEV. 779.915

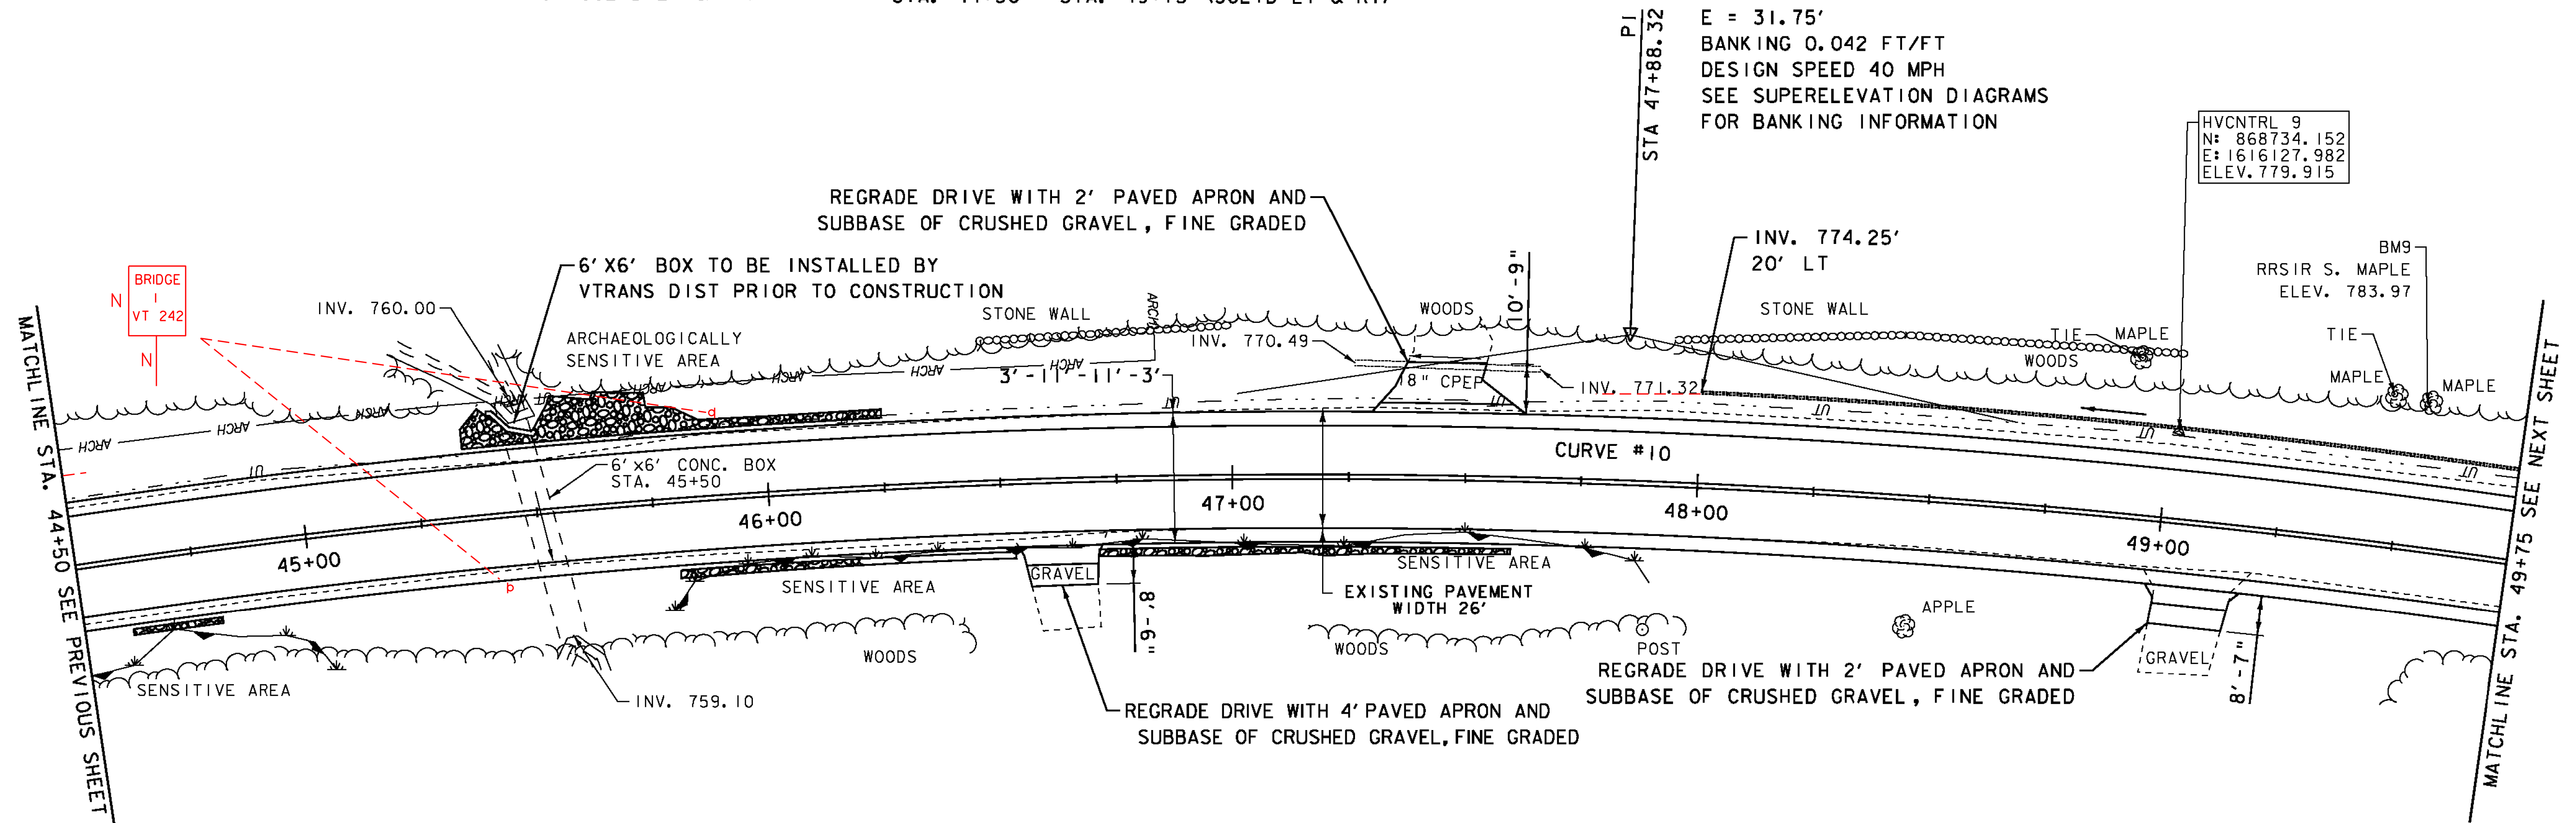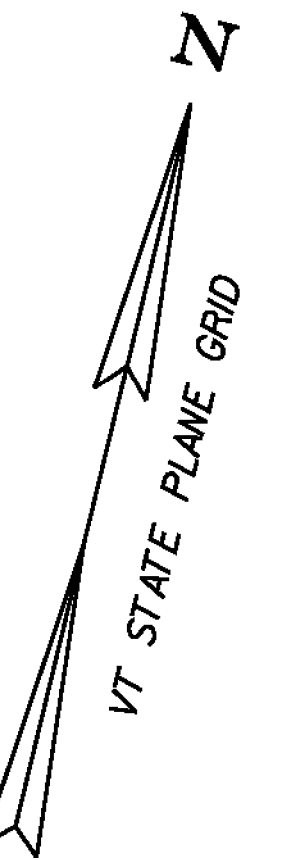

**ENVIRONMENTALLY SENSITIVE LOCATIONS:**

| NO. | LIMITS                  | POS. | TYPE |
|-----|-------------------------|------|------|
| 3.  | STA. 44+50 - STA. 45+03 | RT   | -    |
| 4.  | STA. 45+78 - STA. 47+90 | RT   | -    |

STONE FILL, TYPE I

|                         |    |
|-------------------------|----|
| STA. 44+60 - STA. 44+80 | RT |
| STA. 45+35 - STA. 46+25 | LT |
| STA. 45+80 - STA. 46+53 | RT |
| STA. 46+71 - STA. 47+60 | RT |

GEOTEXTILE FOR SILT FENCE

|                         |    |
|-------------------------|----|
| STA. 44+60 - STA. 44+80 | RT |
| STA. 45+35 - STA. 46+25 | LT |
| STA. 45+80 - STA. 46+53 | RT |
| STA. 46+71 - STA. 47+60 | RT |

GRUBBING MATERIAL

|                         |    |
|-------------------------|----|
| STA. 44+60 - STA. 44+80 | RT |
| STA. 45+35 - STA. 46+25 | LT |
| STA. 45+80 - STA. 46+53 | RT |
| STA. 46+71 - STA. 47+60 | RT |

GEOTEXTILE UNDER STONE FILL

|                         |    |
|-------------------------|----|
| STA. 44+60 - STA. 44+80 | RT |
| STA. 45+35 - STA. 46+25 | LT |
| STA. 45+80 - STA. 46+53 | RT |
| STA. 46+71 - STA. 47+60 | RT |

BARRIER FENCE

STA. 44+50 - STA. 45+03 RT  
 STA. 44+78 - STA. 47+90 RT

EROSION LOG

STA. 44+50 - STA. 45+03 RT  
 STA. 44+78 - STA. 47+90 RT

SIGN LEGEND

- R = REMOVE
- R&S = REMOVE AND SALVAGE
- RET = RETAIN
- S = SALVAGED
- N = NEW
- B-B = BACK TO BACK
- = EXISTING
- = NEW

DATUM  
 NAVD 88  
 NAD 83

| LEGEND |                          |
|--------|--------------------------|
| ○      | MAILBOX                  |
| ○      | BORING                   |
| ○      | SIGN                     |
| ○      | HYDRANT                  |
| ○      | MANHOLE                  |
| ○      | WATER SHUT OFF (WSO)     |
| ○      | GAS PIPELINE MARKER      |
| ⊠      | CATCH BASIN / DROP INLET |
| -      | CURB INLET               |
| ⊠      | TRAFFIC CONTROL BOX      |
| ⊕      | PARKING METER            |
| ⊠      | UTILITY POLE             |



**PROJECT LAYOUT SHEET 9**

PROJECT NAME: MONTGOMERY-WESTFIELD  
 PROJECT NUMBER: STP 2906(I)

FILE NAME: pIOC190.dgn  
 PROJECT LEADER: CDL  
 DESIGNED BY: SJL  
 PLOT FILE: pIOC190\_30.I

PLOT DATE: 9/5/12  
 DRAWN BY: SJL  
 CHECKED BY: EPD  
 SHEET 30 OF 178

SEH  
 2-20-14