

ENVIRONMENTALLY SENSITIVE LOCATIONS:

| NO. | LIMITS | POS. | TYPE |
|-----|-------------------------|------|------|
| 5. | STA. 53+67 - STA. 55+50 | LT | - |



BARRIER FENCE

STA. 53+67 - STA. 55+50 LT

EROSION LOG

STA. 53+67 - STA. 55+50 LT

CURVE #12
 DELTA = 19° 18' 13"
 D = 7° 09' 43"
 R = 800.00'
 T = 136.05'
 L = 269.53'
 E = 11.49'
 BANKING 0.067 FT/FT
 DESIGN SPEED 40 MPH
 SEE SUPERELEVATION DIAGRAMS
 FOR BANKING INFORMATION

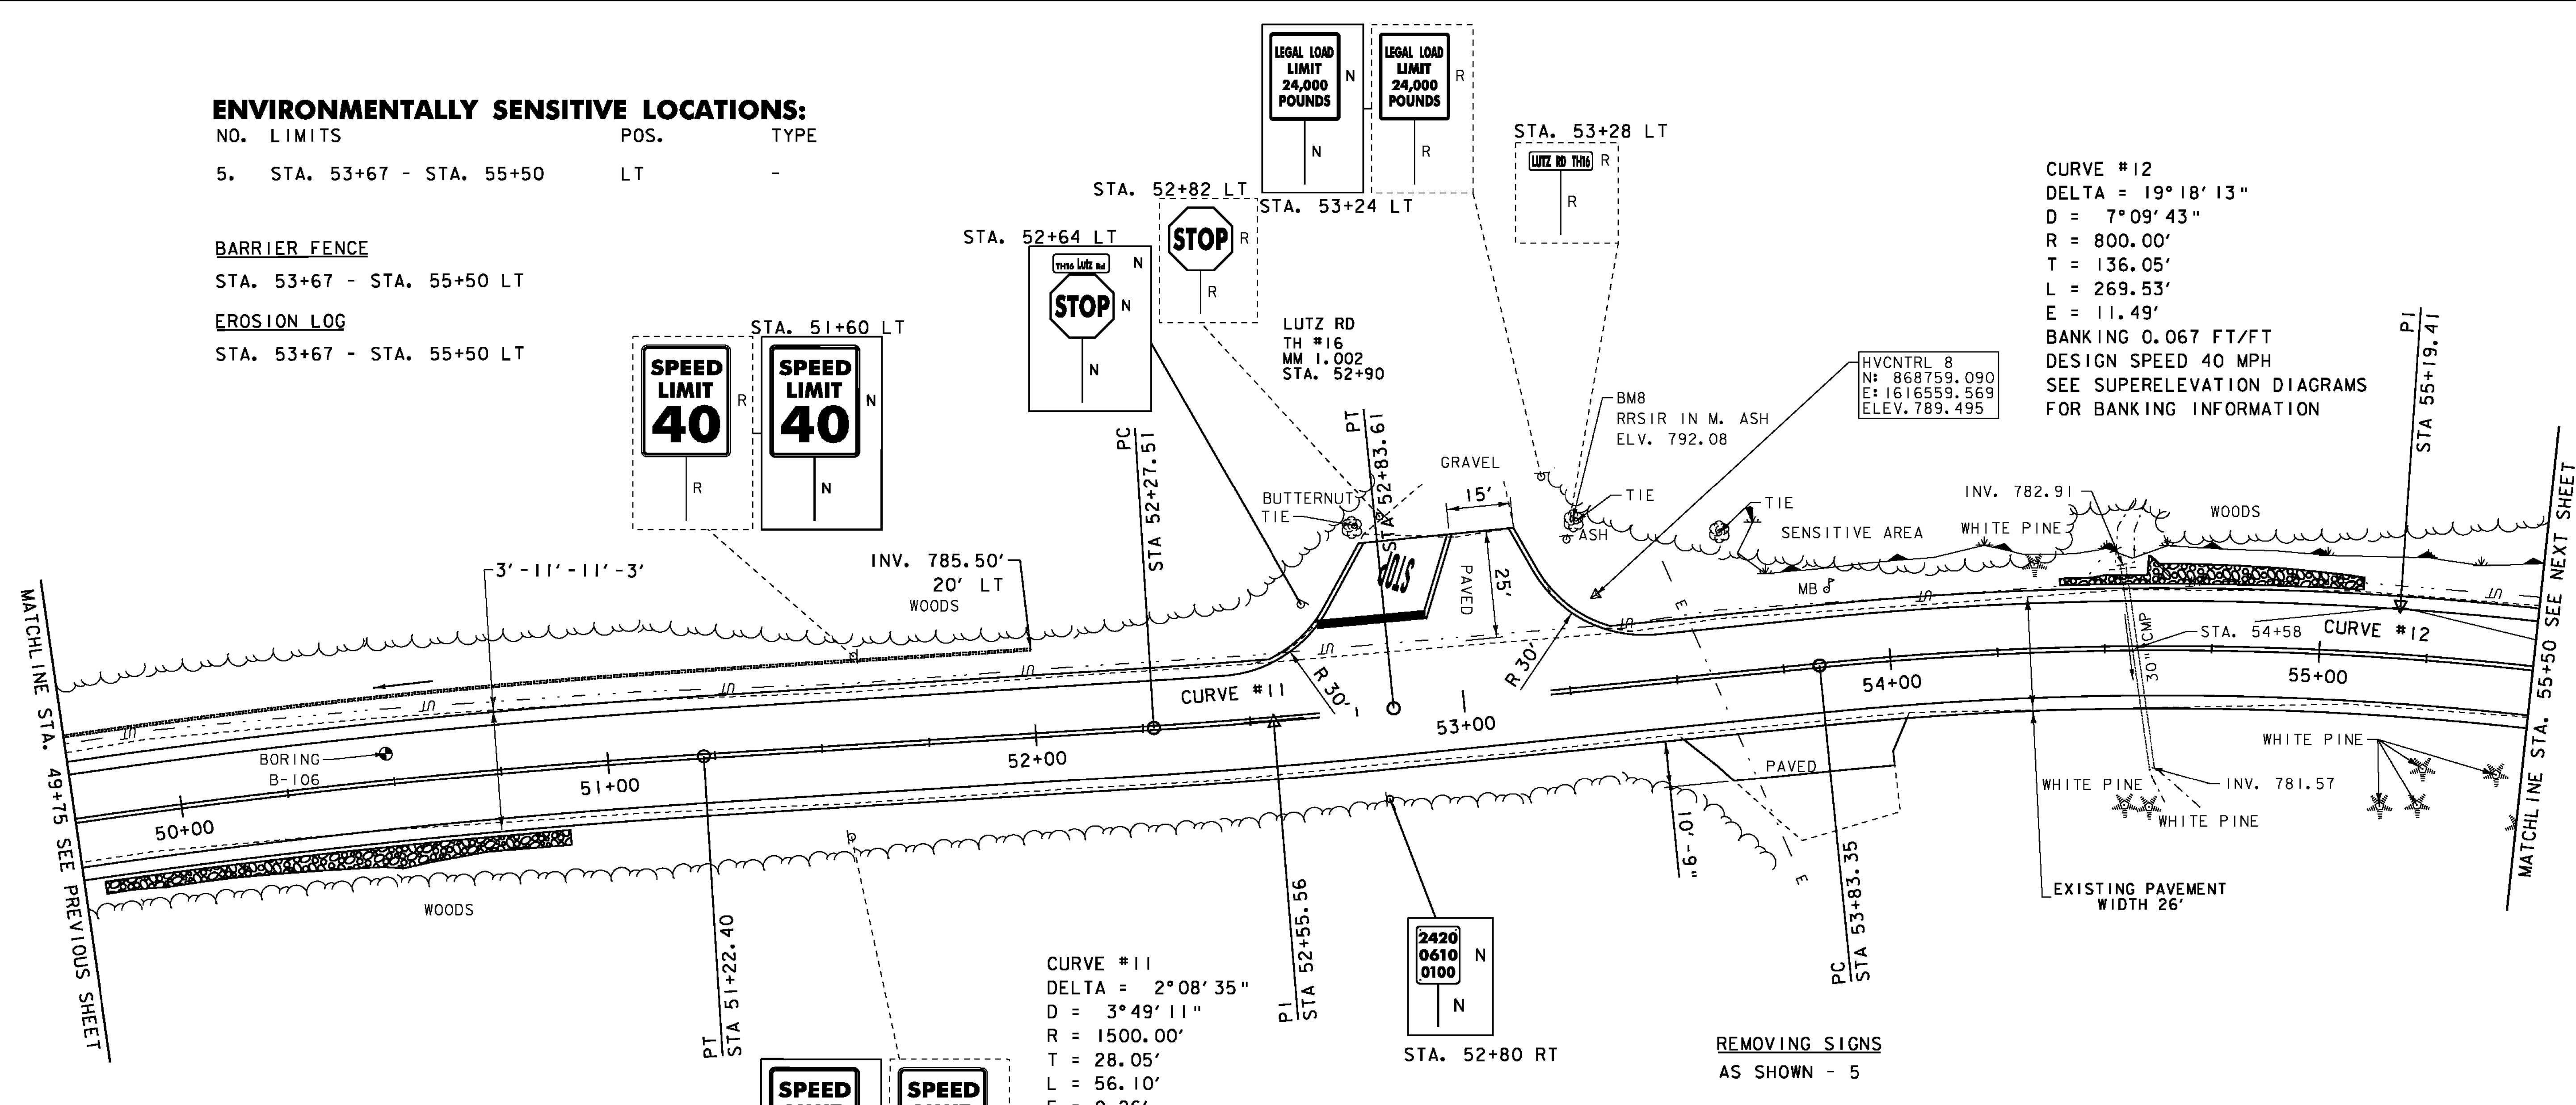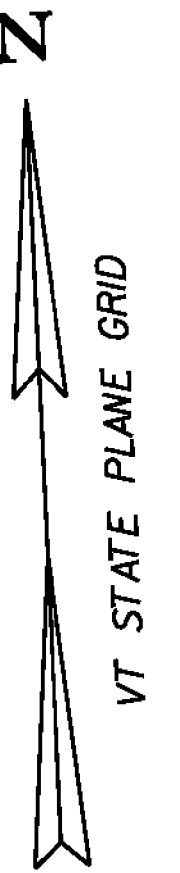

SIGN LEGEND

- R = REMOVE
- R&S = REMOVE AND SALVAGE
- RET = RETAIN
- S = SALVAGED
- N = NEW
- B-B = BACK TO BACK
- = EXISTING
- = NEW

LEGEND

- MAILBOX
- BORING
- SIGN
- HYDRANT
- MANHOLE
- WATER SHUT OFF (WSO)
- GAS PIPELINE MARKER
- CATCH BASIN / DROP INLET
- CURB INLET
- TRAFFIC CONTROL BOX
- PARKING METER
- UTILITY POLE

| | |
|-------|----------|
| DATUM | NAV D 88 |
| | NAD 83 |

- DURABLE 4 INCH WHITE LINE (SEE OPTION ITEMS)**
 STA. 49+75 - STA. 55+50 (SOLID LT & RT)
 (WITH EDGELINE BREAKS AT TH #16)
 STA. 52+90 (EDGELINES TH #16)
- DURABLE 4 INCH YELLOW LINE (SEE OPTION ITEMS)**
 STA. 49+75 - STA. 55+50 (SOLID LT & RT)
 (WITH CENTERLINE BREAKS AT TH #16)
 STA. 52+90 LT (CENTERLINE TH #16)
- DURABLE 24 INCH STOP BAR (SEE OPTION ITEMS)**
 STA. 52+68 - STA. 52+93 LT (TH#16)
- DURABLE LETTER OF SYMBOL (SEE OPTION ITEMS)**
 STA. 52+88 LT "STOP" (TH#16)
- 6 INCH UNDERDRAIN PIPE**
 STA. 49+75 - STA. 52+00-LT
 51+98

- TEMPORARY 4 INCH WHITE LINE, PAINT**
 STA. 49+75 - STA. 55+50 (SOLID LT & RT)
 (WITH EDGELINE BREAKS AT TH #16)
 STA. 52+90 (EDGELINES TH #16)
- TEMPORARY 4 INCH YELLOW LINE, PAINT**
 STA. 49+75 - STA. 55+50 (SOLID LT & RT)
 (WITH CENTERLINE BREAKS AT TH #16)
 STA. 52+90 LT (CENTERLINE TH #16)
- TEMPORARY 24 INCH STOP BAR, PAINT**
 STA. 52+68 - STA. 52+93 LT (TH#16)
- TEMPORARY LETTER OF SYMBOL, PAINT**
 STA. 52+88 LT "STOP" (TH#16)

REMOVING SIGNS
 AS SHOWN - 5

THINNING AND TRIMMING FOR SIGNS
 STA. 51+56 RT


RELOCATE MAILBOX, SINGLE SUPPORT
 STA. 53+86 LT

- STONE FILL, TYPE I**
 STA. 49+80 - STA. 50+90 RT
 STA. 54+40 - STA. 55+10 LT
- GRUBBING MATERIAL**
 STA. 49+80 - STA. 50+90 RT
 STA. 54+40 - STA. 55+10 LT
- GEOTEXTILE UNDER STONE FILL**
 STA. 49+80 - STA. 50+90 RT
 STA. 54+40 - STA. 55+10 LT
- GEOTEXTILE FOR SILT FENCE**
 STA. 49+80 - STA. 50+90 RT
 STA. 54+40 - STA. 55+10 LT

CURVE #11
 DELTA = 2° 08' 35"
 D = 3° 49' 11"
 R = 1500.00'
 T = 28.05'
 L = 56.10'
 E = 0.26'
 BANKING 0.020 FT/FT
 DESIGN SPEED 40 MPH
 SEE SUPERELEVATION DIAGRAMS
 FOR BANKING INFORMATION

PROJECT LAYOUT SHEET 10

| | |
|-----------------|----------------------|
| PROJECT NAME: | MONTGOMERY-WESTFIELD |
| PROJECT NUMBER: | STP 2906(I) |
| FILE NAME: | p10CI90.dgn |
| PROJECT LEADER: | CDL |
| DESIGNED BY: | SJL |
| PLOT FILE: | p10CI90_31.I |
| PLOT DATE: | 9/5/12 |
| DRAWN BY: | SJL |
| CHECKED BY: | EPD |
| SHEET | 31 OF 178 |

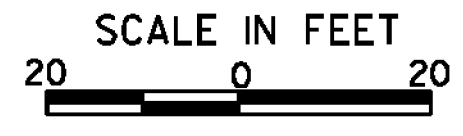

SEH 2-20-14