

DURABLE 4 INCH WHITE LINE (SEE OPTION ITEMS)
 STA. 55+50 - STA. 61+50 (SOLID LT & RT)

DURABLE 4 INCH YELLOW LINE (SEE OPTION ITEMS)
 STA. 55+50 - STA. 61+50 (SOLID LT & RT)

TEMPORARY 4 INCH WHITE LINE, PAINT
 STA. 55+50 - STA. 61+50 (SOLID LT & RT)

TEMPORARY 4 INCH YELLOW LINE, PAINT
 STA. 55+50 - STA. 61+50 (SOLID LT & RT)

6 INCH UNDERDRAIN PIPE
 STA. 56+50 - STA. 59+00 LT 58+73
 STA. 61+00 - STA. 61+50 LT 60+72

REMOVING SIGNS
 AS SHOWN - 2

BARRIER FENCE
 STA. 55+50 - STA. 55+61 LT

EROSION LOG
 STA. 55+50 - STA. 55+61 LT

STONE FILL, TYPE I
 STA. 59+50 - STA. 59+75 RT
 STA. 60+20 - STA. 60+70 RT
 STA. 60+90 - STA. 61+45 RT

GRUBBING MATERIAL
 STA. 59+50 - STA. 59+75 RT
 STA. 60+20 - STA. 60+70 RT
 STA. 60+90 - STA. 61+45 RT


GEOTEXTILE UNDER STONE FILL
 STA. 59+50 - STA. 59+75 RT
 STA. 60+20 - STA. 60+70 RT
 STA. 60+90 - STA. 61+45 RT

GEOTEXTILE FOR SILT FENCE
 STA. 59+50 - STA. 59+75 RT
 STA. 60+20 - STA. 60+70 RT
 STA. 60+90 - STA. 61+45 RT

KUNERT DR
 TH #65
 MM 1.143
 STA. 60+35

ENVIRONMENTALLY SENSITIVE LOCATIONS:


NO.	LIMITS	POS.	TYPE
5.	STA. 55+50 - STA. 55+61	LT	-

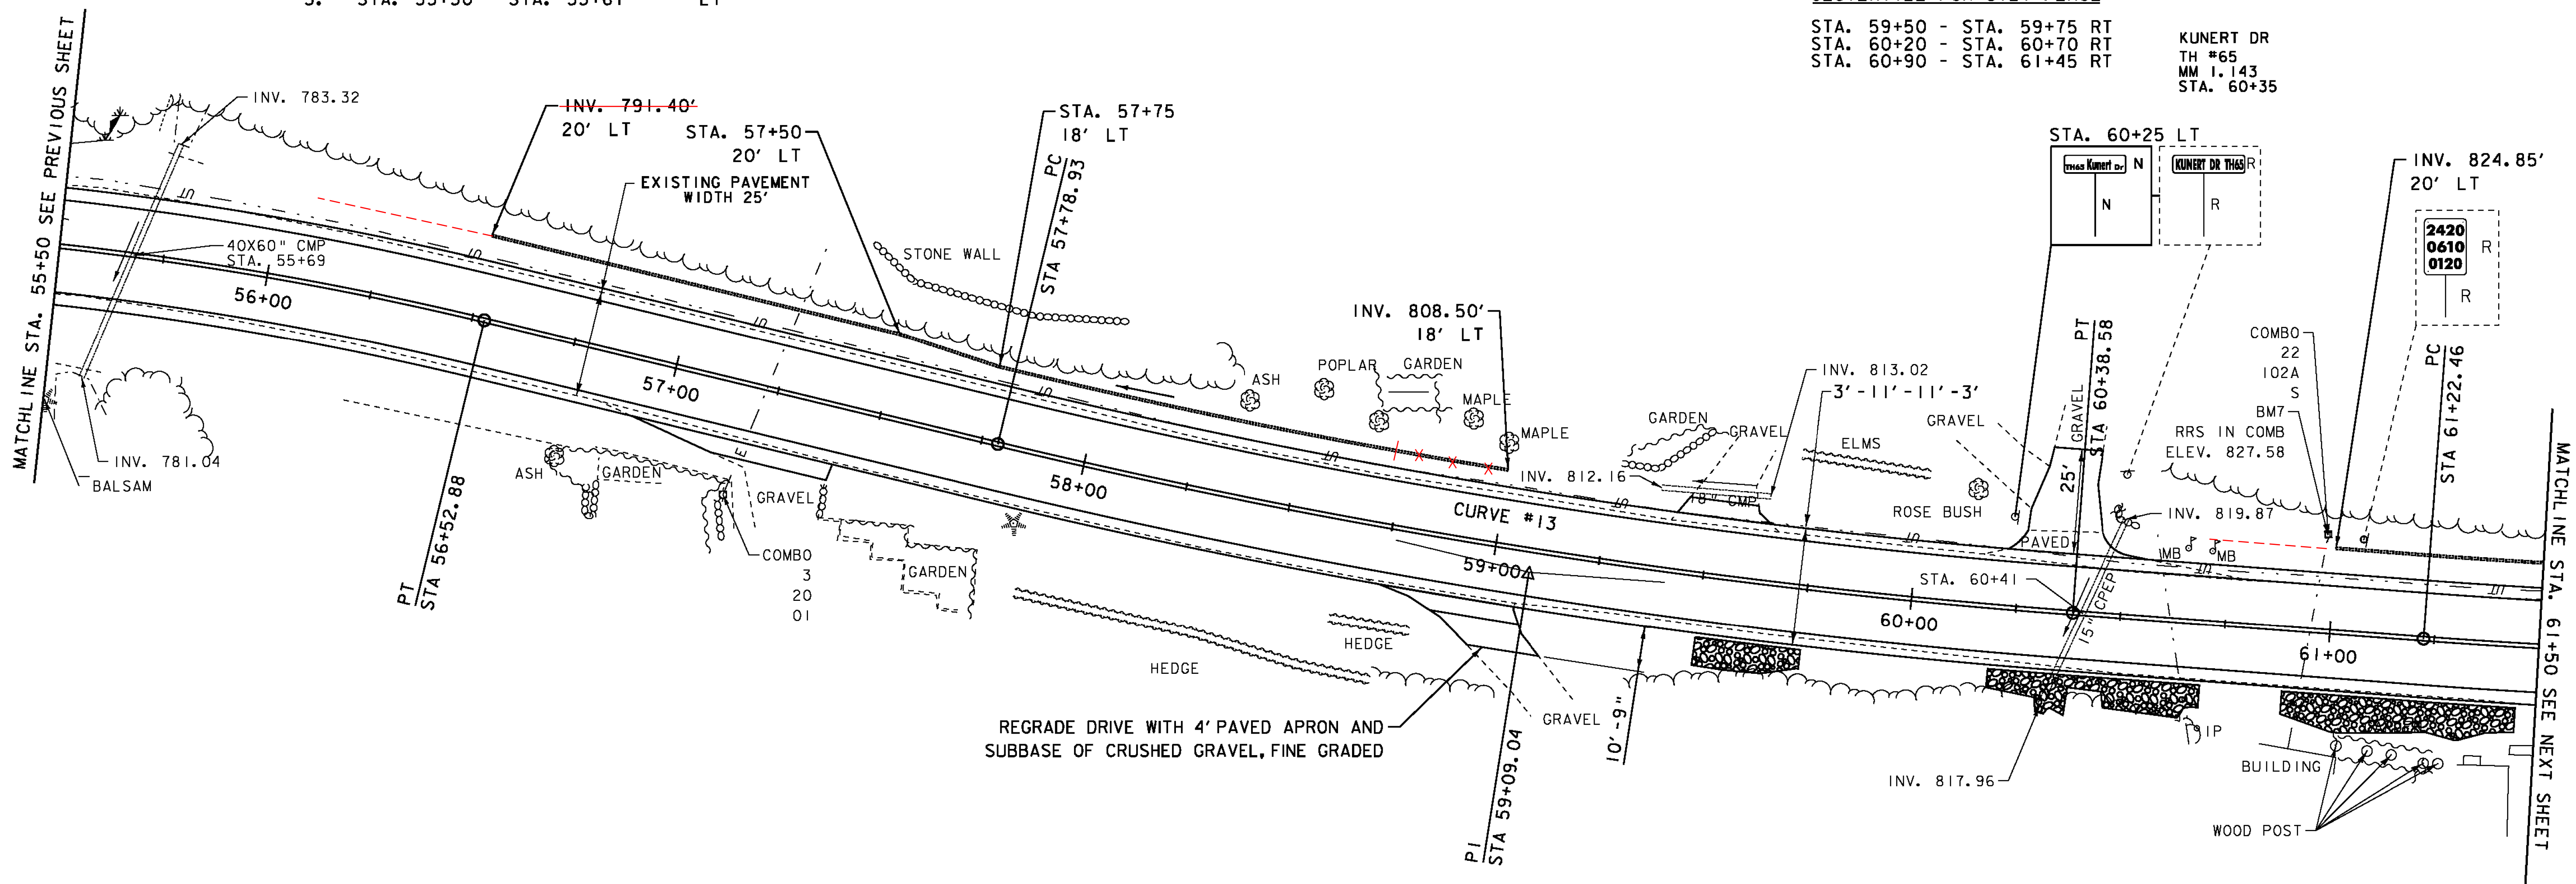

- LEGEND**
- MAILBOX
 - BORING
 - SIGN
 - HYDRANT
 - MANHOLE
 - WATER SHUT OFF (WSO)
 - GAS PIPELINE MARKER
 - CATCH BASIN / DROP INLET
 - CURB INLET
 - TRAFFIC CONTROL BOX
 - ⊕ PARKING METER
 - UTILITY POLE

- SIGN LEGEND**
- R = REMOVE
 - R&S = REMOVE AND SALVAGE
 - RET = RETAIN
 - S = SALVAGED
 - N = NEW
 - B-B = BACK TO BACK
 - = EXISTING
 - = NEW

CURVE #13
 DELTA = 9° 17' 52"
 D = 3° 34' 52"
 R = 1600.00'
 T = 130.11'
 L = 259.65'
 E = 5.28'
 BANKING 0.043 FT/FT
 DESIGN SPEED 40 MPH
 SEE SUPERELEVATION DIAGRAMS
 FOR BANKING INFORMATION

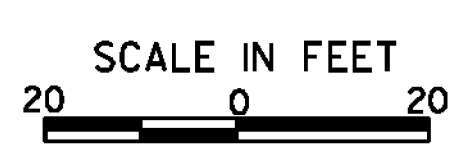

PROJECT LAYOUT SHEET 11	PROJECT NAME: MONTGOMERY-WESTFIELD	PLOT DATE: 9/5/12
	PROJECT NUMBER: STP 2906(1)	DRAWN BY: SJL
	FILE NAME: p10CI90.dgn	CHECKED BY: EPD
	DESIGNED BY: SJL	SHEET 32 OF 178
	PLOT FILE: p10CI90_32.1	

SEH
2-25-14