

DURABLE 4 INCH WHITE LINE (SEE OPTION ITEMS)  
 STA. 61+50 - STA. 67+50 (SOLID LT & RT)

DURABLE 4 INCH YELLOW LINE (SEE OPTION ITEMS)  
 STA. 61+50 - STA. 67+50 (SOLID LT & RT)

THINNING AND TRIMMING FOR SIGNS  
 STA. 66+63 RT

TEMPORARY 4 INCH WHITE LINE, PAINT  
 STA. 61+50 - STA. 67+50 (SOLID LT & RT)

TEMPORARY 4 INCH YELLOW LINE, PAINT  
 STA. 61+50 - STA. 67+50 (SOLID LT & RT)

6 INCH UNDERDRAIN PIPE  
 STA. 61+50 - STA. ~~66+00~~ LT 66+12  
 STA. ~~67+00~~ - STA. 67+50 LT  
 66+63

RELOCATE MAILBOX, SINGLE SUPPORT  
 STA. 64+35 LT


REMOVING SIGNS  
 AS SHOWN - 2

STONE FILL, TYPE I  
 STA. 62+85 - STA. 64+40 RT

GRUBBING MATERIAL  
 STA. 62+85 - STA. 64+40 RT

GEOTEXTILE UNDER STONE FILL  
 STA. 62+85 - STA. 64+40 RT

GEOTEXTILE FOR SILT FENCE  
 STA. 62+85 - STA. 64+40 RT

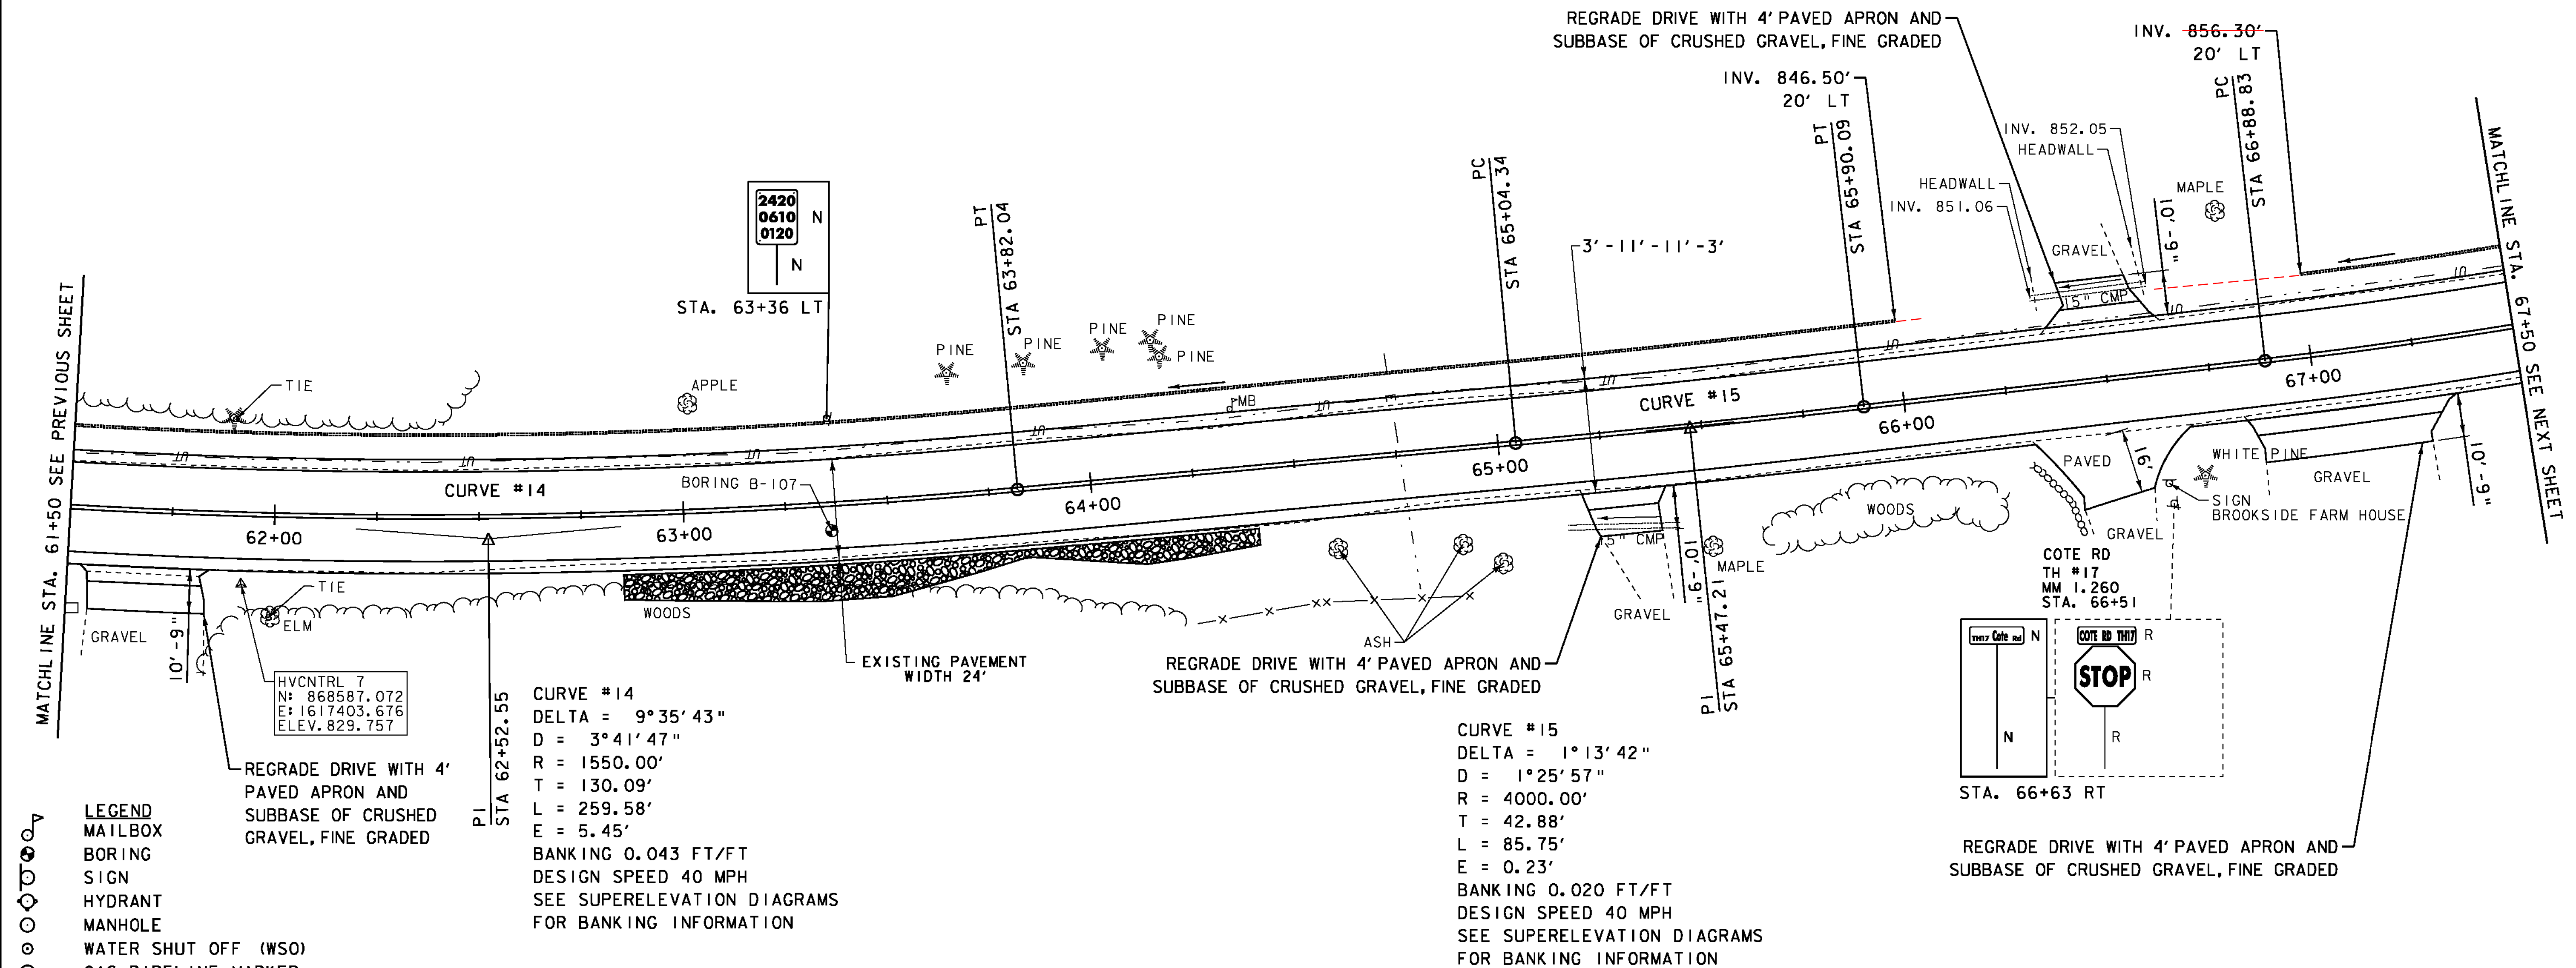

- LEGEND**
- MAILBOX
  - BORING
  - SIGN
  - HYDRANT
  - MANHOLE
  - WATER SHUT OFF (WSO)
  - GAS PIPELINE MARKER
  - CATCH BASIN / DROP INLET
  - CURB INLET
  - TRAFFIC CONTROL BOX
  - PARKING METER
  - UTILITY POLE

- SIGN LEGEND**
- R = REMOVE
  - R&S = REMOVE AND SALVAGE
  - RET = RETAIN
  - S = SALVAGED
  - N = NEW
  - B-B = BACK TO BACK
  - = EXISTING
  - = NEW

DATUM

NAVD 88
NAD 83

SCALE IN FEET

<b>PROJECT LAYOUT SHEET 12</b>	PROJECT NAME: MONTGOMERY-WESTFIELD
	PROJECT NUMBER: STP 2906(I)
	FILE NAME: p10ci90.dgn
	PLOT DATE: 9/5/12
PROJECT LEADER: CDL	DRAWN BY: SJL
DESIGNED BY: SJL	CHECKED BY: EPD
PLOT FILE: p10ci90_33.1	SHEET 33 OF 178

SEH  
2-28-14