

DURABLE 4 INCH WHITE LINE (SEE OPTION ITEMS)  
STA. 67+50 - STA. 73+75 (SOLID LT & RT)

TEMPORARY 4 INCH WHITE LINE, PAINT  
STA. 67+50 - STA. 73+75 (SOLID LT & RT)

6 INCH UNDERDRAIN PIPE  
STA. 67+50 - STA. 68+50 LT  
STA. 69+50 - STA. ~~71+00~~ LT  
70+93

STONE FILL, TYPE I  
STA. 67+85 - STA. 69+40 RT

GEOTEXTILE UNDER STONE FILL  
STA. 67+85 - STA. 69+40 RT

DURABLE 4 INCH YELLOW LINE (SEE OPTION ITEMS)  
STA. 67+50 - STA. 73+75 (SOLID LT & RT)

TEMPORARY 4 INCH YELLOW LINE, PAINT  
STA. 67+50 - STA. 73+75 (SOLID LT & RT)

REMOVING SIGNS  
AS SHOWN - I

GRUBBING MATERIAL  
STA. 67+85 - STA. 69+40 RT

GEOTEXTILE FOR SILT FENCE  
STA. 67+85 - STA. 69+40 RT

BARRIER FENCE


STA. 72+04 - STA. 73+75 LT

EROSION LOG

STA. 72+04 - STA. 73+75 LT

**ENVIRONMENTALLY SENSITIVE LOCATIONS:**



NO.	LIMITS	POS.	TYPE
6.	STA. 72+04 - STA. 73+75	LT	-

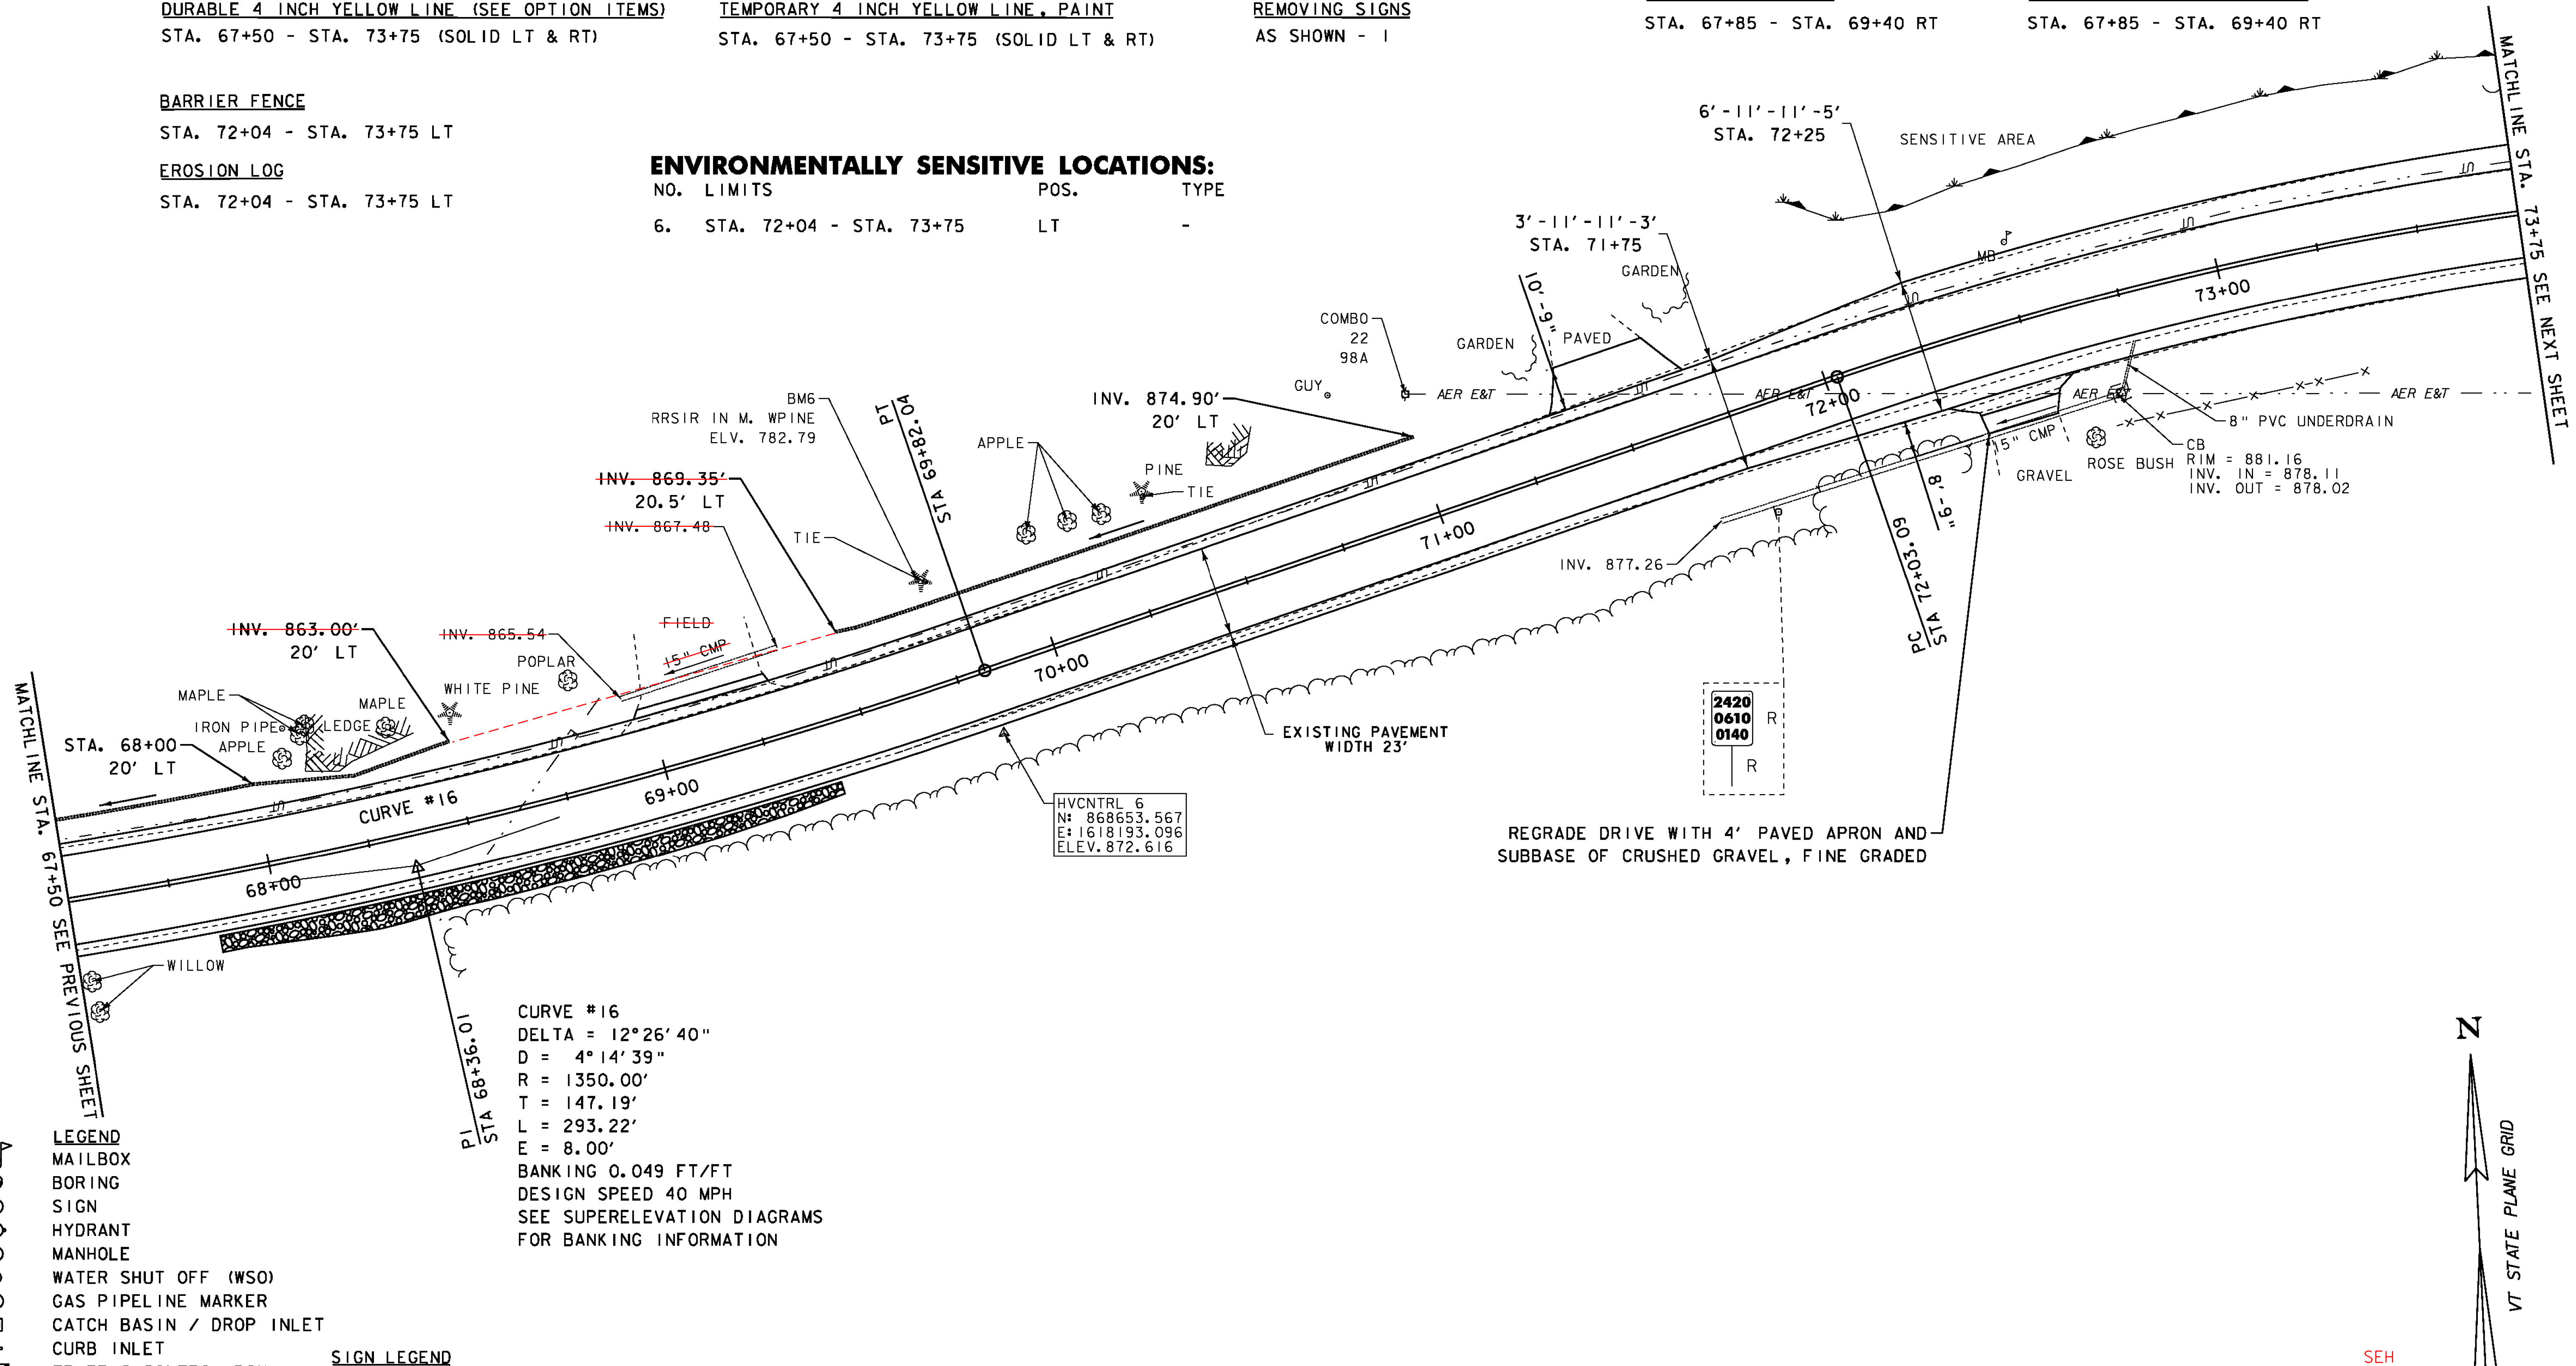

- LEGEND**
- MAILBOX
  - BORING
  - SIGN
  - HYDRANT
  - MANHOLE
  - WATER SHUT OFF (WSO)
  - GAS PIPELINE MARKER
  - CATCH BASIN / DROP INLET
  - CURB INLET
  - TRAFFIC CONTROL BOX
  - ⊕ PARKING METER
  - ⊕ UTILITY POLE

- SIGN LEGEND**
- R = REMOVE
  - R&S = REMOVE AND SALVAGE
  - RET = RETAIN
  - S = SALVAGED
  - N = NEW
  - B-B = BACK TO BACK
  - = EXISTING
  - = NEW

**DATUM**  
VERTICAL NAVD 88  
HORIZONTAL NAD 83

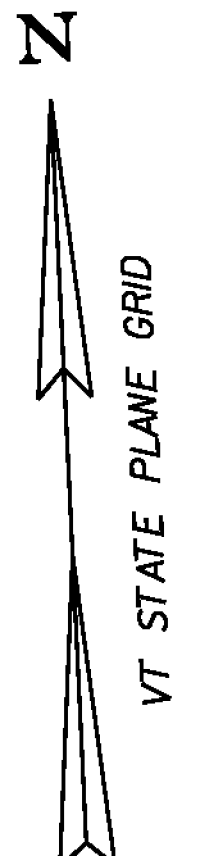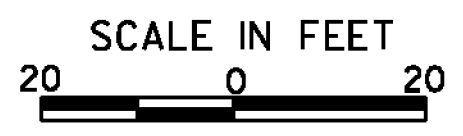

<b>PROJECT LAYOUT SHEET 13</b>	PROJECT NAME: MONTGOMERY-WESTFIELD
	PROJECT NUMBER: STP 2906(I)
	FILE NAME: piOC190.dgn
	PLOT DATE: 9/5/12
	PROJECT LEADER: CDL
	DESIGNED BY: SJL
	PLOT FILE: piOC190_34.I
	DRAWN BY: SJL
	CHECKED BY: EPD
	SHEET 34 OF 178

SEH  
2-25-14