

DURABLE 4 INCH WHITE LINE (SEE OPTION ITEMS)
 STA. 79+25 - STA. 84+75 (SOLID LT & RT)

TEMPORARY 4 INCH WHITE LINE, PAINT
 STA. 79+25 - STA. 84+75 (SOLID LT & RT)

DURABLE 4 INCH YELLOW LINE (SEE OPTION ITEMS)
 STA. 79+25 - STA. 84+75 (SOLID LT & RT)

TEMPORARY 4 INCH YELLOW LINE, PAINT
 STA. 79+25 - STA. 84+75 (SOLID LT & RT)


STEEL BEAM GUARDRAIL, GALVANIZED
 STA. 83+10 - STA. 84+75 LT
 STA. 82+15 - STA. 84+35 RT

REMOVING SIGNS
 AS SHOWN - 2

~~STEEL BEAM GUARDRAIL, GALVANIZED W/8 FEET POSTS~~
~~STA. 82+15 - STA. 84+35 RT~~

REMOVAL & DISPOSAL OF GUARDRAIL
 STA. 82+15 - STA. 84+35 RT
 STA. 83+05 - STA. 84+75 LT

ANCHOR FOR STEEL BEAM GUARDRAIL
 STA. 82+15 RT
 STA. 83+10 LT
 STA. 84+35 RT

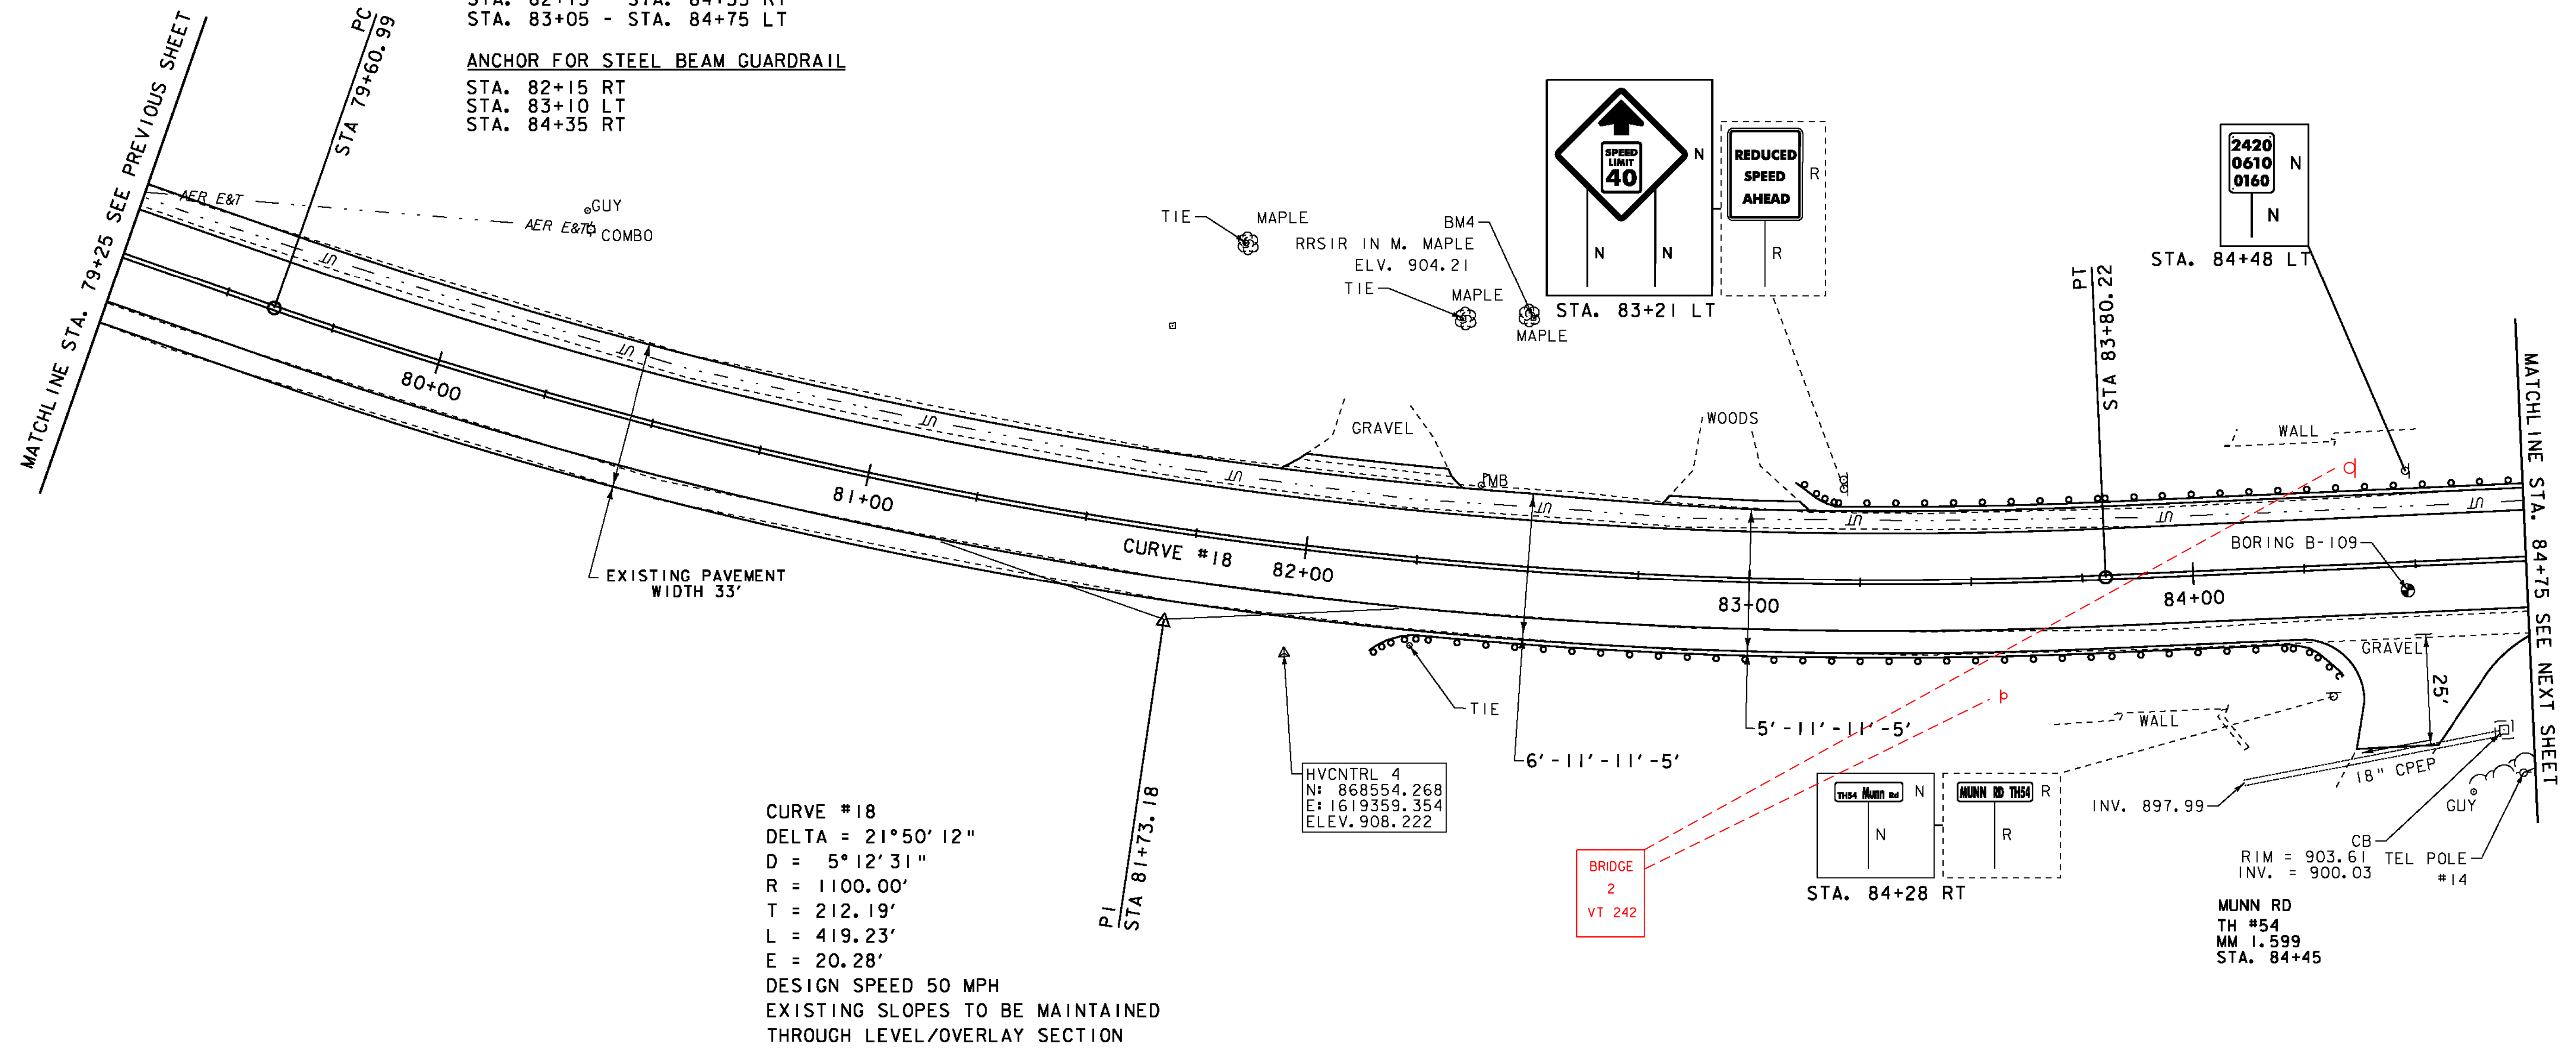

DATUM	NAVD 88
	NAD 83

LEGEND	
○	MANHOLE
⊙	WATER SHUT OFF (WSO)
⊙	GAS PIPELINE MARKER
⊙	CATCH BASIN / DROP INLET
—	CURB INLET
⊕	TRAFFIC CONTROL BOX
⊕	PARKING METER
⊕	UTILITY POLE
○	MAILBOX
⊙	BORING
⊙	SIGN
⊙	HYDRANT

SIGN LEGEND	
R	= REMOVE
R&S	= REMOVE AND SALVAGE
RET	= RETAIN
S	= SALVAGED
N	= NEW
B-B	= BACK TO BACK
---	= EXISTING
---	= NEW



PROJECT LAYOUT SHEET 15	PROJECT NAME: MONTGOMERY-WESTFIELD	PLOT DATE: 9/5/12
	PROJECT NUMBER: STP 2906(I)	DRAWN BY: SJL
	FILE NAME: pIOC190.dgn	CHECKED BY: EPD
	PROJECT LEADER: CDL	SHEET 36 OF 178
	DESIGNED BY: SJL	
	PLOT FILE: pIOC190_36.1	

SEH
2-25-14