

DURABLE 4 INCH WHITE LINE (SEE OPTION ITEMS)
 STA. 84+75 - STA. 90+25 (SOLID LT & RT)

TEMPORARY 4 INCH WHITE LINE, PAINT
 STA. 84+75 - STA. 90+25 (SOLID LT & RT)

DURABLE 4 INCH YELLOW LINE (SEE OPTION ITEMS)
 STA. 84+75 - STA. 90+25 (SOLID LT & RT)

TEMPORARY 4 INCH YELLOW LINE, PAINT
 STA. 84+75 - STA. 90+25 (SOLID LT & RT)



STEEL BEAM GUARDRAIL, GALVANIZED
 STA. 84+75 - STA. ~~86+30~~ LT
 89+10 LT

~~STEEL BEAM GUARDRAIL, GALVANIZED W/8 FEET POSTS~~
~~STA. 86+30 - STA. 89+10 LT~~

REMOVAL & DISPOSAL OF GUARDRAIL
 STA. 84+75 - STA. 89+06 LT

ANCHOR FOR STEEL BEAM GUARDRAIL
 STA. 89+10 LT

CURVE #19
 DELTA = 6°33'33"
 D = 3°34'52"
 R = 1600.00'
 T = 91.68'
 L = 183.17'
 E = 2.62'
 DESIGN SPEED 50 MPH
 EXISTING SLOPES TO BE MAINTAINED
 THROUGH LEVEL/OVERLAY SECTION

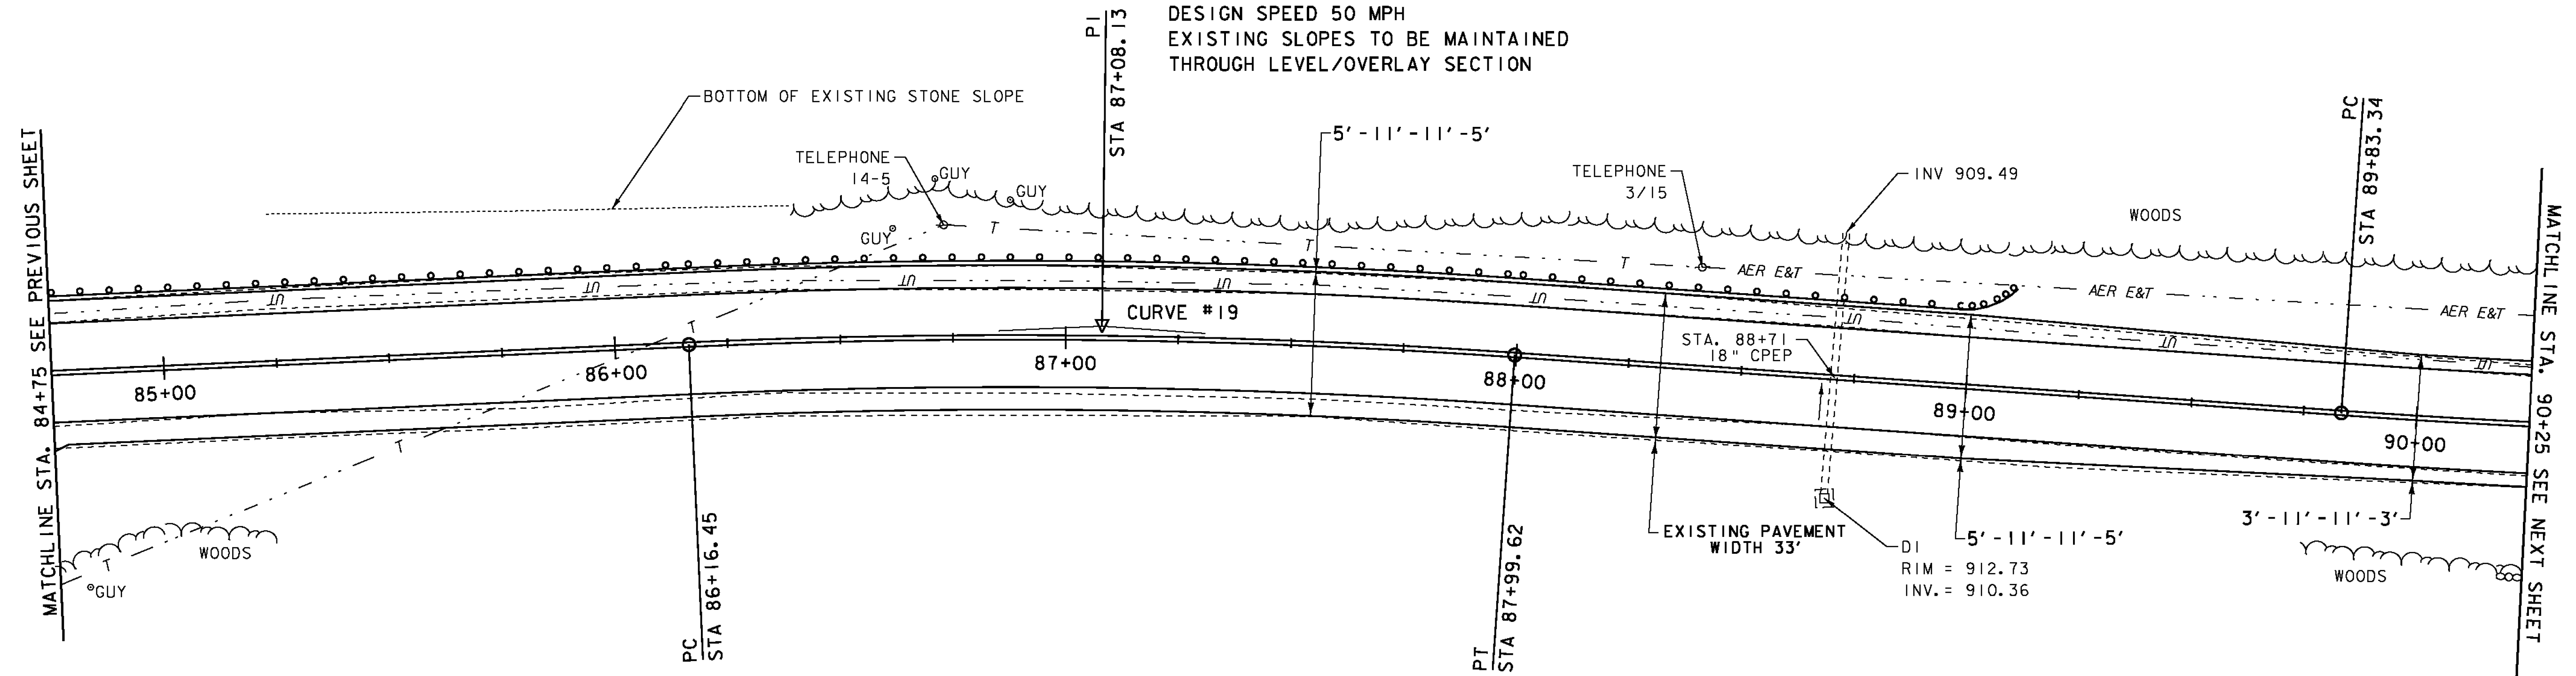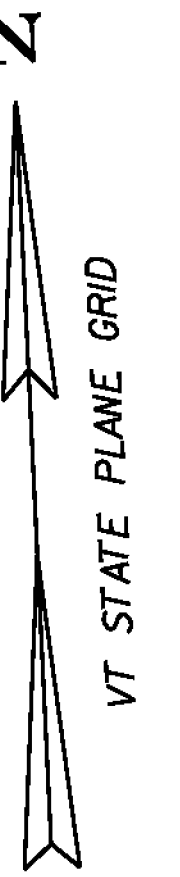

LEGEND

- MAILBOX
- BORING
- SIGN
- HYDRANT
- MANHOLE
- WATER SHUT OFF (WSO)
- GAS PIPELINE MARKER
- CATCH BASIN / DROP INLET
- CURB INLET
- ⊗ TRAFFIC CONTROL BOX
- ⊕ PARKING METER
- ⊖ UTILITY POLE

SIGN LEGEND

- R = REMOVE
- R&S = REMOVE AND SALVAGE
- RET = RETAIN
- S = SALVAGED
- N = NEW
- B-B = BACK TO BACK
- = EXISTING
- = NEW

DATUM
 NAVD 88
 NAD 83

SCALE IN FEET
 20 0 20

PROJECT LAYOUT SHEET 16

PROJECT NAME: MONTGOMERY-WESTFIELD
 PROJECT NUMBER: STP 2906(1)

FILE NAME: p10ci90.dgn PLOT DATE: 9/5/12
 PROJECT LEADER: CDL DRAWN BY: SJL
 DESIGNED BY: SJL CHECKED BY: EPD
 PLOT FILE: p10ci90_37.1 SHEET 37 OF 178

SEH
 2-25-14