

DURABLE 4 INCH WHITE LINE (SEE OPTION ITEMS)
 STA. 107+25 - STA. 112+75 (SOLID LT & RT)

DURABLE 4 INCH YELLOW LINE (SEE OPTION ITEMS)
 STA. 107+25 - STA. 112+75 (SOLID LT & RT)

TEMPORARY 4 INCH WHITE LINE, PAINT
 STA. 107+25 - STA. 112+75 (SOLID LT & RT)

TEMPORARY 4 INCH YELLOW LINE, PAINT
 STA. 107+25 - STA. 112+75 (SOLID LT & RT)

6 INCH UNDERDRAIN PIPE
 STA. ~~108+50~~ - STA. ~~111+00~~ LT
 108+20 110+90

RELOCATE MAILBOX, SINGLE SUPPORT
 STA. 110+47 LT

BARRIER FENCE
 STA. 107+25 - STA. 107+37 RT
 STA. 107+25 - STA. 107+85 LT
 STA. 107+54 - STA. 108+19 RT
 STA. 111+40 - STA. 112+54 RT

EROSION LOG
 STA. 107+25 - STA. 107+37 RT
 STA. 107+25 - STA. 107+85 LT
 STA. 107+54 - STA. 108+19 RT
 STA. 111+40 - STA. 112+54 RT


STONE FILL, TYPE 1
 STA. 110+75 - STA. 112+45 RT

GRUBBING MATERIAL
 STA. 110+75 - STA. 112+45 RT

GEOTEXTILE UNDER STONE FILL
 STA. 110+75 - STA. 112+45 RT


GEOTEXTILE FOR SILT FENCE
 STA. 110+75 - STA. 112+45 RT

REMOVING SIGNS
 AS SHOWN - 2

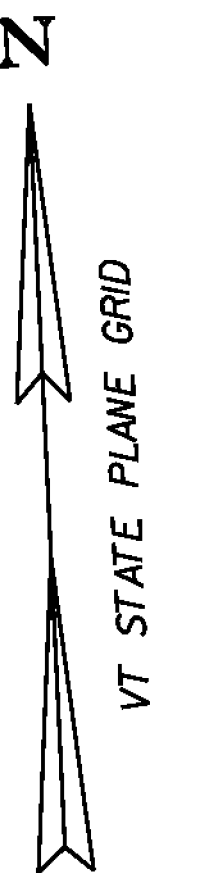

ENVIRONMENTALLY SENSITIVE LOCATIONS:

NO.	LIMITS	POS.	TYPE
9.	STA. 107+25 - STA. 107+37	RT	-
10.	STA. 107+25 - STA. 107+85	LT	-
11.	STA. 107+54 - STA. 108+19	RT	-
12.	STA. 111+40 - STA. 112+54	RT	-

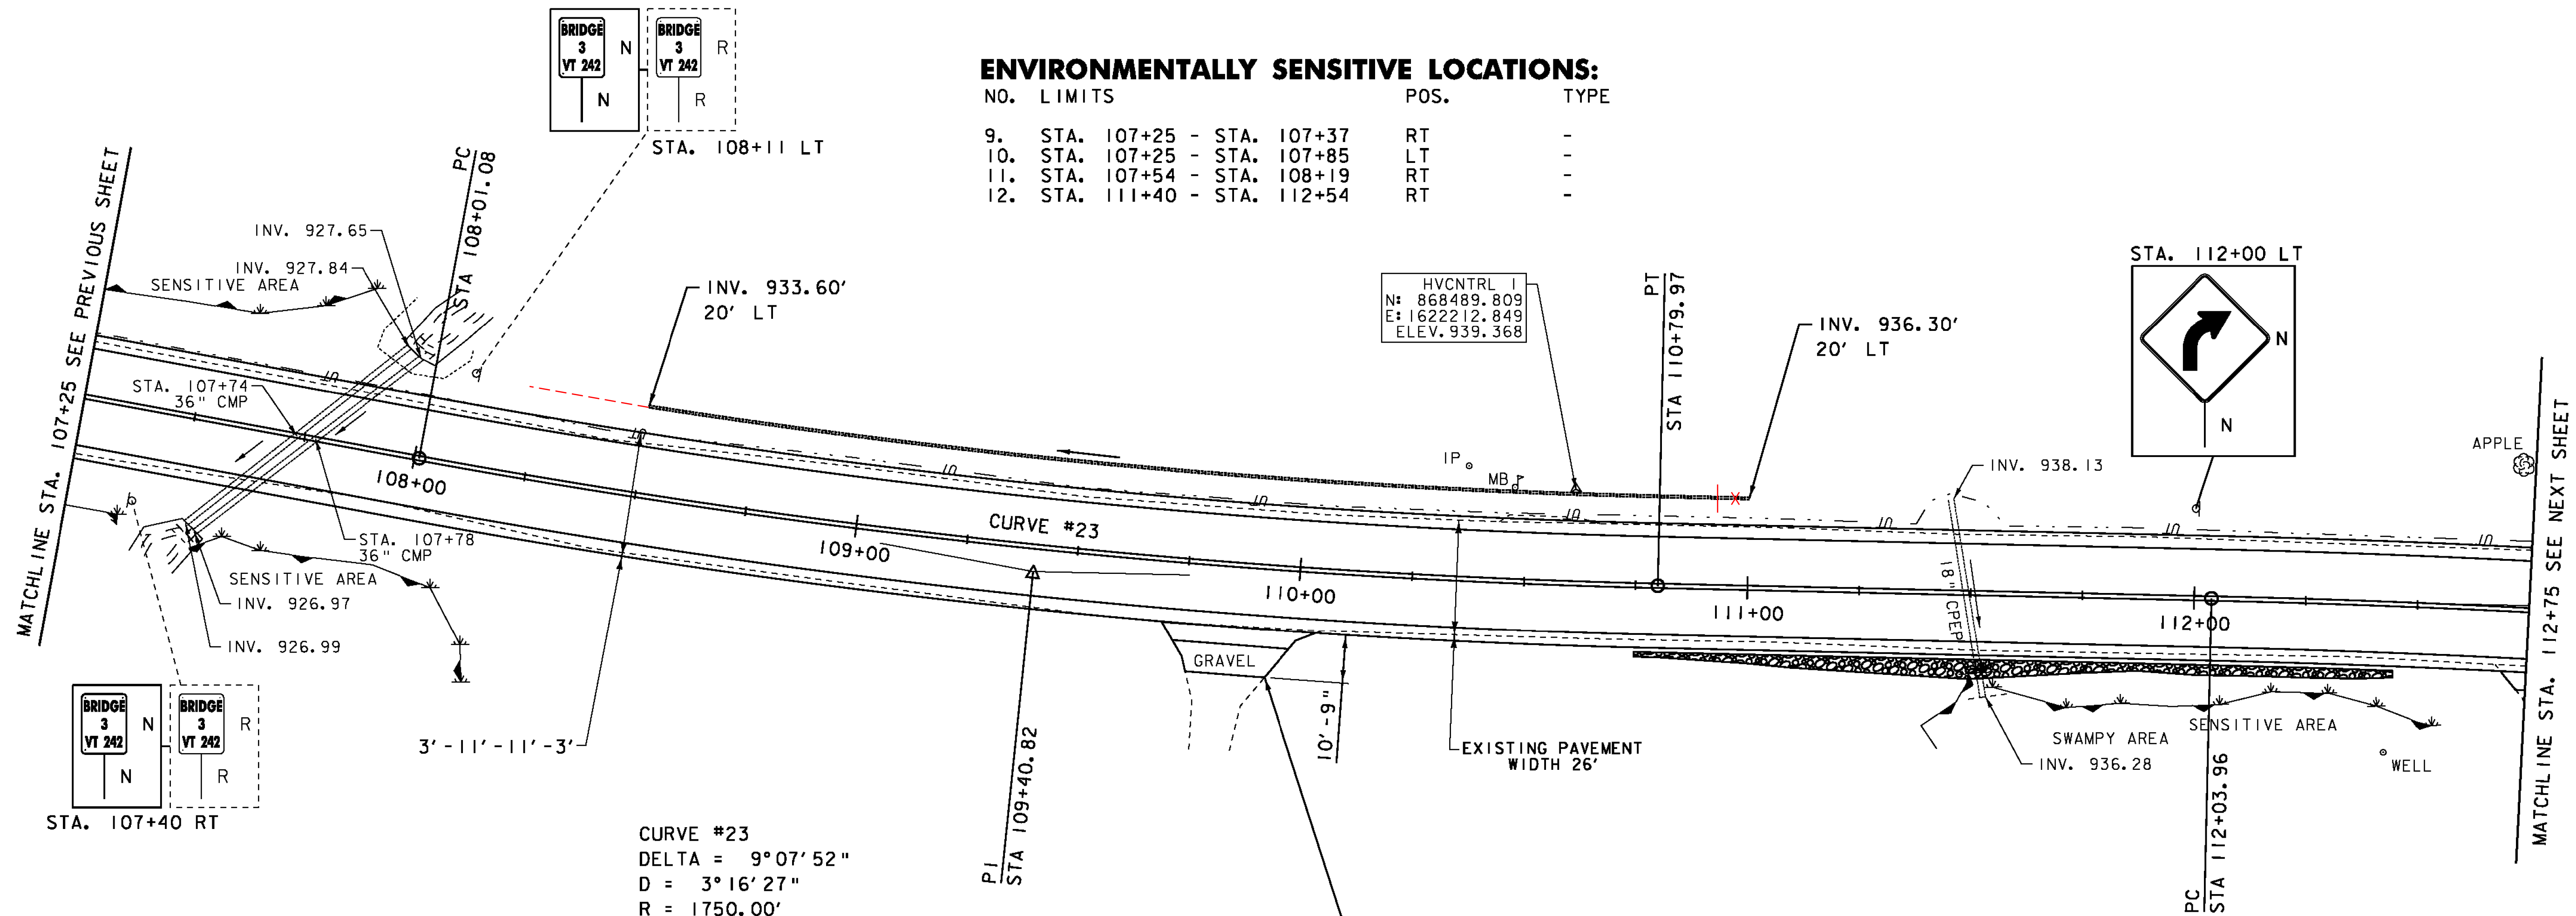

CURVE #23
 DELTA = 9°07'52"
 D = 3°16'27"
 R = 1750.00'
 T = 139.74'
 L = 278.90'
 E = 5.57'
 BANKING 0.040 FT/FT
 DESIGN SPEED 40 MPH
 SEE SUPERELEVATION DIAGRAMS
 FOR BANKING INFORMATION

- LEGEND**
- MAILBOX
 - BORING
 - SIGN
 - HYDRANT
 - MANHOLE
 - WATER SHUT OFF (WSO)
 - GAS PIPELINE MARKER
 - CATCH BASIN / DROP INLET
 - CURB INLET
 - TRAFFIC CONTROL BOX
 - ⊕ PARKING METER
 - ⊕ UTILITY POLE

- SIGN LEGEND**
- R = REMOVE
 - R&S = REMOVE AND SALVAGE
 - RET = RETAIN
 - S = SALVAGED
 - N = NEW
 - B-B = BACK TO BACK
 - = EXISTING
 - = NEW

DATUM
 VERTICAL NAVD 88
 HORIZONTAL NAD 83



PROJECT LAYOUT SHEET 20

PROJECT NAME: MONTGOMERY-WESTFIELD
 PROJECT NUMBER: STP 2906(I)

FILE NAME: p10C190.dgn
 PROJECT LEADER: CDL
 DESIGNED BY: SJL
 PLOT FILE: p10C190_41.I

PLOT DATE: 9/5/12
 DRAWN BY: SJL
 CHECKED BY: EPD
 SHEET 41 OF 178

SEH
 2-20-14