

DURABLE 4 INCH WHITE LINE (SEE OPTION ITEMS)
 STA. 112+75 - STA. 118+50 (SOLID LT & RT)

TEMPORARY 4 INCH WHITE LINE, PAINT
 STA. 112+75 - STA. 118+50 (SOLID LT & RT)

6 INCH UNDERDRAIN PIPE
 STA. ~~115+00~~ - STA. ~~117+00~~ LT
 115+52 117+82

REMOVING SIGNS
 AS SHOWN - 1

DURABLE 4 INCH YELLOW LINE (SEE OPTION ITEMS)
 STA. 112+75 - STA. 118+50 (SOLID LT & RT)

TEMPORARY 4 INCH YELLOW LINE, PAINT
 STA. 112+75 - STA. 118+50 (SOLID LT & RT)

RELOCATE MAILBOX, SINGLE SUPPORT
 STA. 117+48 LT

STONE FILL, TYPE I

STA. 114+35 - STA. 114+45 RT
 STA. 114+40 - STA. 115+25 LT
 STA. 118+27 - STA. 118+40 RT

CURVE #24
 DELTA = 22°20'23"
 D = 2°18'04" (1) D = 4°46'29" (2)
 R = 2490.00' (1) R = 1200.00' (2)
 T = 330.76' (1) T = 248.00' (2)
 L = 201.02' (1) L = 371.00' (2)
 E = 21.87'

GEOTEXTILE UNDER STONE FILL

STA. 114+35 - STA. 114+45 RT
 STA. 114+40 - STA. 115+25 LT
 STA. 118+27 - STA. 118+40 RT


GRUBBING MATERIAL

STA. 114+35 - STA. 114+45 RT
 STA. 114+40 - STA. 115+25 LT
 STA. 118+27 - STA. 118+40 RT

GEOTEXTILE FOR SILT FENCE

STA. 114+35 - STA. 114+45 RT
 STA. 114+40 - STA. 115+25 LT
 STA. 118+27 - STA. 118+40 RT

BANKING 0.041 FT/FT, 0.070 FT/FT
 DESIGN SPEED 40 MPH, 50 MPH
 SEE SUPERELEVATION DIAGRAMS
 FOR BANKING INFORMATION

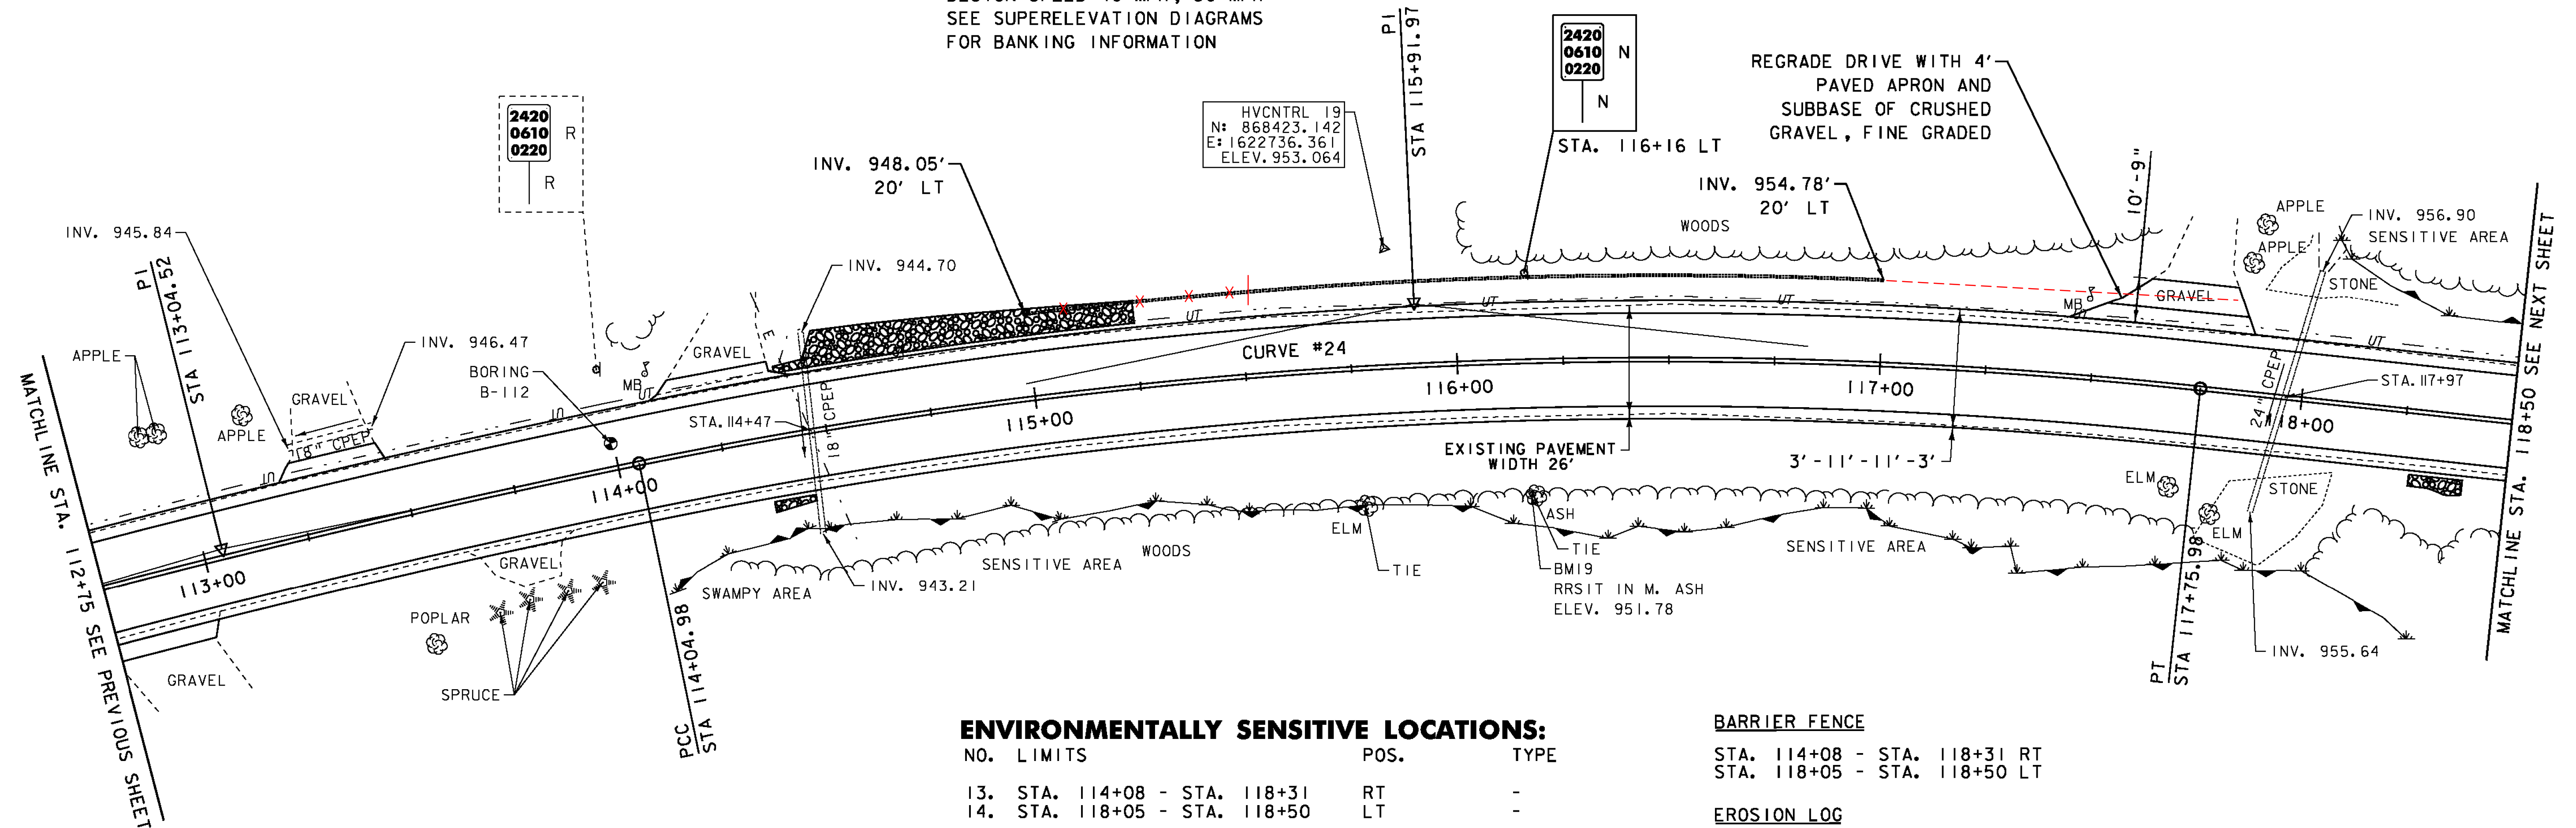

ENVIRONMENTALLY SENSITIVE LOCATIONS:

NO.	LIMITS	POS.	TYPE
13.	STA. 114+08 - STA. 118+31	RT	-
14.	STA. 118+05 - STA. 118+50	LT	-

BARRIER FENCE

STA. 114+08 - STA. 118+31 RT
 STA. 118+05 - STA. 118+50 LT

EROSION LOG

STA. 114+08 - STA. 118+31 RT
 STA. 118+05 - STA. 118+50 LT

SIGN LEGEND

- R = REMOVE
- R&S = REMOVE AND SALVAGE
- RET = RETAIN
- S = SALVAGED
- N = NEW
- B-B = BACK TO BACK
- = EXISTING
- = NEW

LEGEND

- MAILBOX
- BORING
- SIGN
- HYDRANT
- MANHOLE
- WATER SHUT OFF (WSO)
- GAS PIPELINE MARKER
- CATCH BASIN / DROP INLET
- CURB INLET
- TRAFFIC CONTROL BOX
- PARKING METER
- UTILITY POLE

DATUM
 NAVD 88
 NAD 83

PROJECT LAYOUT SHEET 21

PROJECT NAME: MONTGOMERY-WESTFIELD
 PROJECT NUMBER: STP 2906(I)

FILE NAME: p\OC190.dgn
 PROJECT LEADER: CDL
 DESIGNED BY: SJL
 PLOT FILE: p\OC190_42.1

PLOT DATE: 9/5/12
 DRAWN BY: SJL
 CHECKED BY: EPD
 SHEET 42 OF 178

SCALE IN FEET
 20 0 20

SEH
 2-20-14