

DURABLE 4 INCH WHITE LINE (SEE OPTION ITEMS)
 STA. 118+50 - STA. 124+25 (SOLID LT & RT)
 (WITH EDGELINE BREAKS AT TH #19)
 STA. 120+57 RT (EDGELINES TH #19)

DURABLE 4 INCH YELLOW LINE (SEE OPTION ITEMS)
 STA. 118+50 - STA. 124+25 (SOLID LT & RT)
 (WITH CENTERLINE BREAK AT TH #19)
 STA. 120+57 RT (CENTERLINE TH #19)

DURABLE 24 INCH STOP BAR (SEE OPTION ITEMS)
 STA. 120+51 - STA. 120+70 RT (TH#19)

DURABLE LETTER OF SYMBOL (SEE OPTION ITEMS)
 STA. 120+62 RT "STOP" (TH#19)

TEMPORARY 4 INCH WHITE LINE, PAINT
 STA. 118+50 - STA. 124+25 (SOLID LT & RT)
 (WITH EDGELINE BREAKS AT TH #19)
 STA. 120+57 RT (EDGELINES TH #19)

TEMPORARY 4 INCH YELLOW LINE, PAINT
 STA. 118+50 - STA. 124+25 (SOLID LT & RT)
 (WITH CENTERLINE BREAK AT TH #19)
 STA. 120+57 RT (CENTERLINE TH #19)

TEMPORARY 24 INCH STOP BAR, PAINT
 STA. 120+51 - STA. 120+70 RT (TH#19)

TEMPORARY LETTER OF SYMBOL, PAINT
 STA. 120+62 RT "STOP" (TH#19)

BARRIER FENCE
 STA. 118+50 - STA. 119+53

EROSION LOG
 STA. 118+50 - STA. 119+53

STONE FILL, TYPE 1
 STA. 119+25 - STA. 119+45 LT
 STA. 119+45 - STA. 119+70 RT
 STA. 120+80 - STA. 123+85 RT
 STA. 124+20 - STA. 124+25 RT

GRUBBING MATERIAL
 STA. 119+25 - STA. 119+45 LT
 STA. 119+45 - STA. 119+70 RT
 STA. 120+80 - STA. 123+85 RT
 STA. 124+20 - STA. 124+25 RT



GEOTEXTILE UNDER STONE FILL
 STA. 119+25 - STA. 119+45 LT
 STA. 119+45 - STA. 119+70 RT
 STA. 120+80 - STA. 123+85 RT
 STA. 124+20 - STA. 124+25 RT

GEOTEXTILE FOR SILT FENCE
 STA. 119+25 - STA. 119+45 LT
 STA. 119+45 - STA. 119+70 RT
 STA. 120+80 - STA. 123+85 RT
 STA. 124+20 - STA. 124+25 RT

REMOVING SIGNS
 AS SHOWN - 2

ENVIRONMENTALLY SENSITIVE LOCATIONS:

NO.	LIMITS	POS.	TYPE
14.	STA. 118+50 - STA. 119+53	LT	-

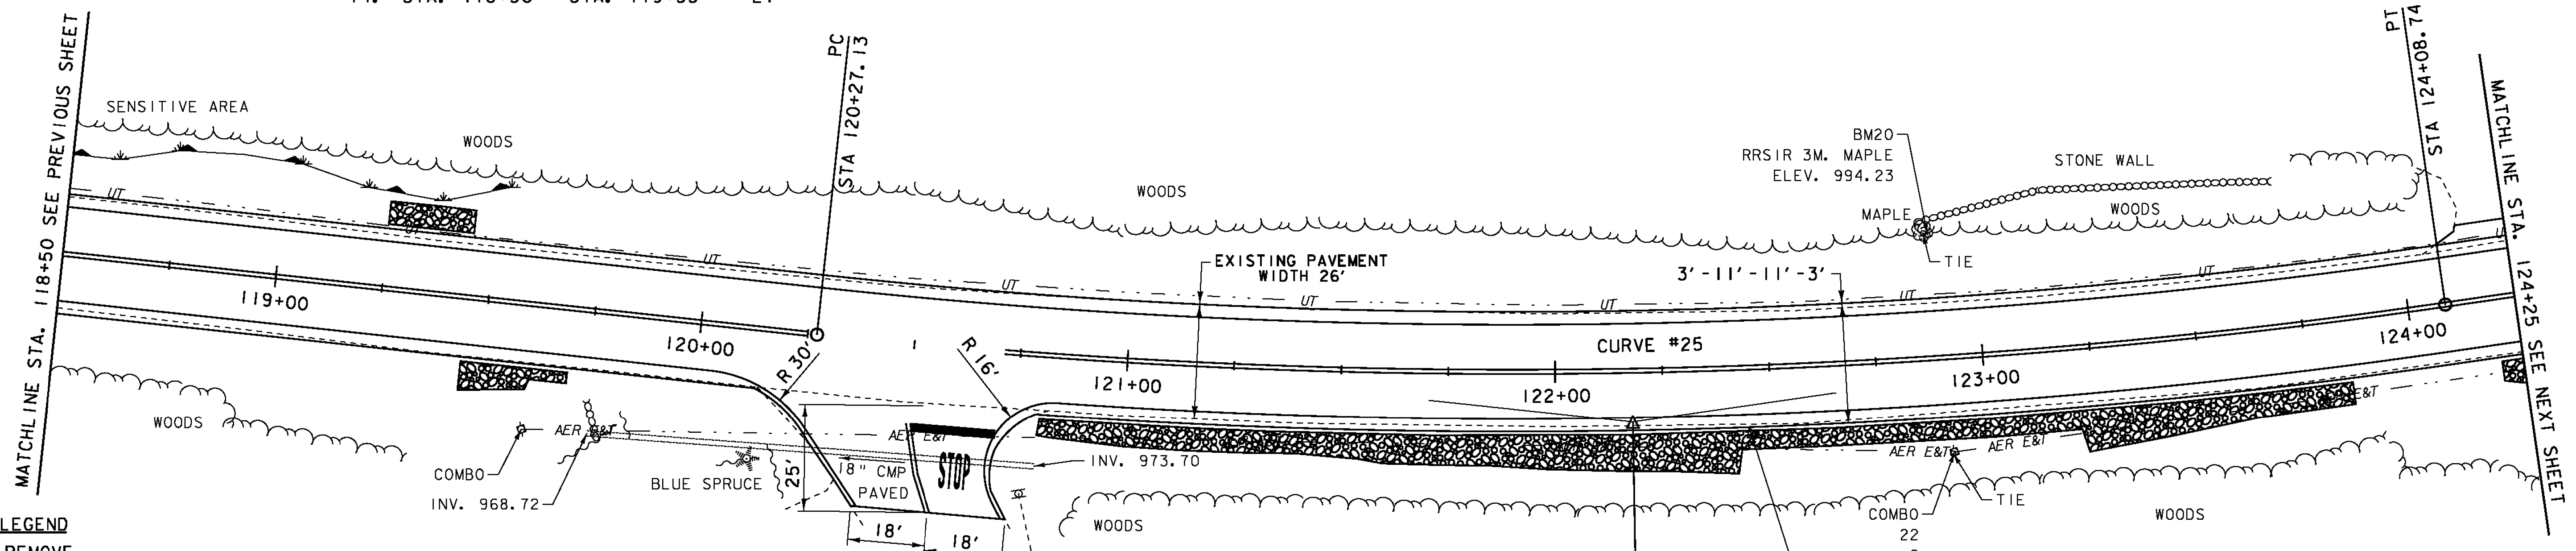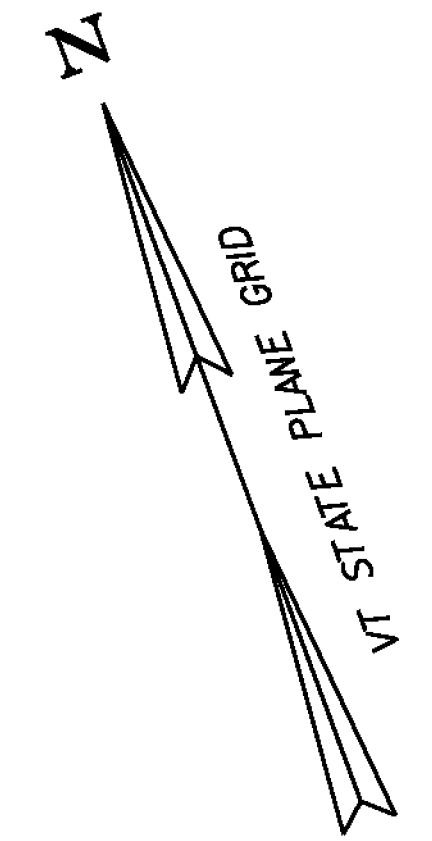


SIGN LEGEND

- R = REMOVE
- R&S = REMOVE AND SALVAGE
- RET = RETAIN
- S = SALVAGED
- N = NEW
- B-B = BACK TO BACK
- = EXISTING
- = NEW

LEGEND

- MAILBOX
- BORING
- SIGN
- HYDRANT
- MANHOLE
- WATER SHUT OFF (WSO)
- GAS PIPELINE MARKER
- CATCH BASIN / DROP INLET
- CURB INLET
- TRAFFIC CONTROL BOX
- PARKING METER
- UTILITY POLE

UNKNOWN ROAD NAME
 TH #19
 MM 2.282
 STA. 120+50

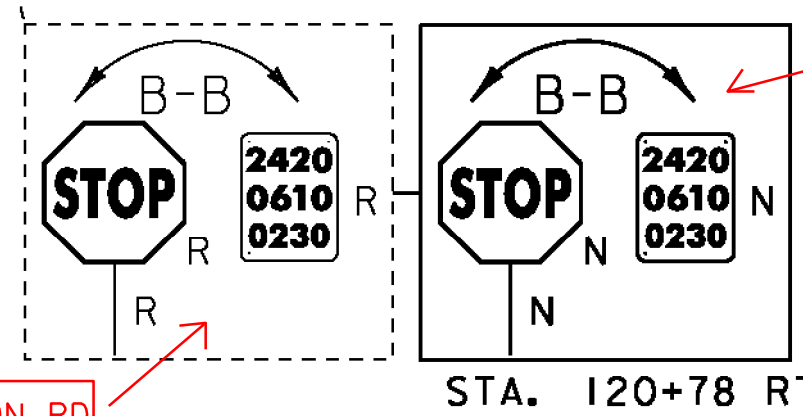

CURVE #25
 DELTA = 14°20' 14"
 D = 3°45' 26"
 R = 1525.00'
 T = 191.80'
 L = 381.61'
 E = 12.01'
 BANKING 0.063 FT/FT
 DESIGN SPEED 50 MPH
 SEE SUPERELEVATION DIAGRAMS
 FOR BANKING INFORMATION

DATUM	NAVD 88
	NAD 83



PROJECT LAYOUT SHEET 22

PROJECT NAME:	MONTGOMERY-WESTFIELD
PROJECT NUMBER:	STP 2906(I)
FILE NAME:	piOCI90.dgn
PROJECT LEADER:	CDL
DESIGNED BY:	SJL
PLOT FILE:	piOCI90_43.I
PLOT DATE:	9/5/12
DRAWN BY:	SJL
CHECKED BY:	EPD
SHEET	43 OF 178

SEH
2-25-14