

DURABLE 4 INCH WHITE LINE (SEE OPTION ITEMS)
 STA. 141+25 - STA. 146+75 (SOLID LT & RT)

TEMPORARY 4 INCH WHITE LINE, PAINT
 STA. 141+25 - STA. 146+75 (SOLID LT & RT)

6 INCH UNDERDRAIN PIPE
 STA. 143+00 - STA. 146+75 LT
 142+98

REMOVING SIGNS
 AS SHOWN - 1

DURABLE 4 INCH YELLOW LINE (SEE OPTION ITEMS)
 STA. 141+25 - STA. 146+75 (SOLID LT & RT)

TEMPORARY 4 INCH YELLOW LINE, PAINT
 STA. 141+25 - STA. 146+75 (SOLID LT & RT)

STONE FILL, TYPE 1
 STA. 142+45 - STA. 146+10 RT
 STA. 145+75 - STA. 145+95 LT

BARRIER FENCE
 STA. 141+25 - STA. 141+45 LT
 STA. 143+71 - STA. 146+75 LT

GRUBBING MATERIAL
 STA. 142+45 - STA. 146+10 RT
 STA. 145+75 - STA. 145+95 LT



EROSION LOG
 STA. 141+25 - STA. 141+45 LT
 STA. 143+71 - STA. 146+75 LT

GEOTEXTILE UNDER STONE FILL
 STA. 142+45 - STA. 146+10 RT
 STA. 145+75 - STA. 145+95 LT

GEOTEXTILE FOR SILT FENCE
 STA. 142+45 - STA. 146+10 RT
 STA. 145+75 - STA. 145+95 LT

ENVIRONMENTALLY SENSITIVE LOCATIONS:

NO.	LIMITS	POS.	TYPE
17.	STA. 141+25 - STA. 141+45	LT	-
18.	STA. 143+71 - STA. 146+75	LT	-

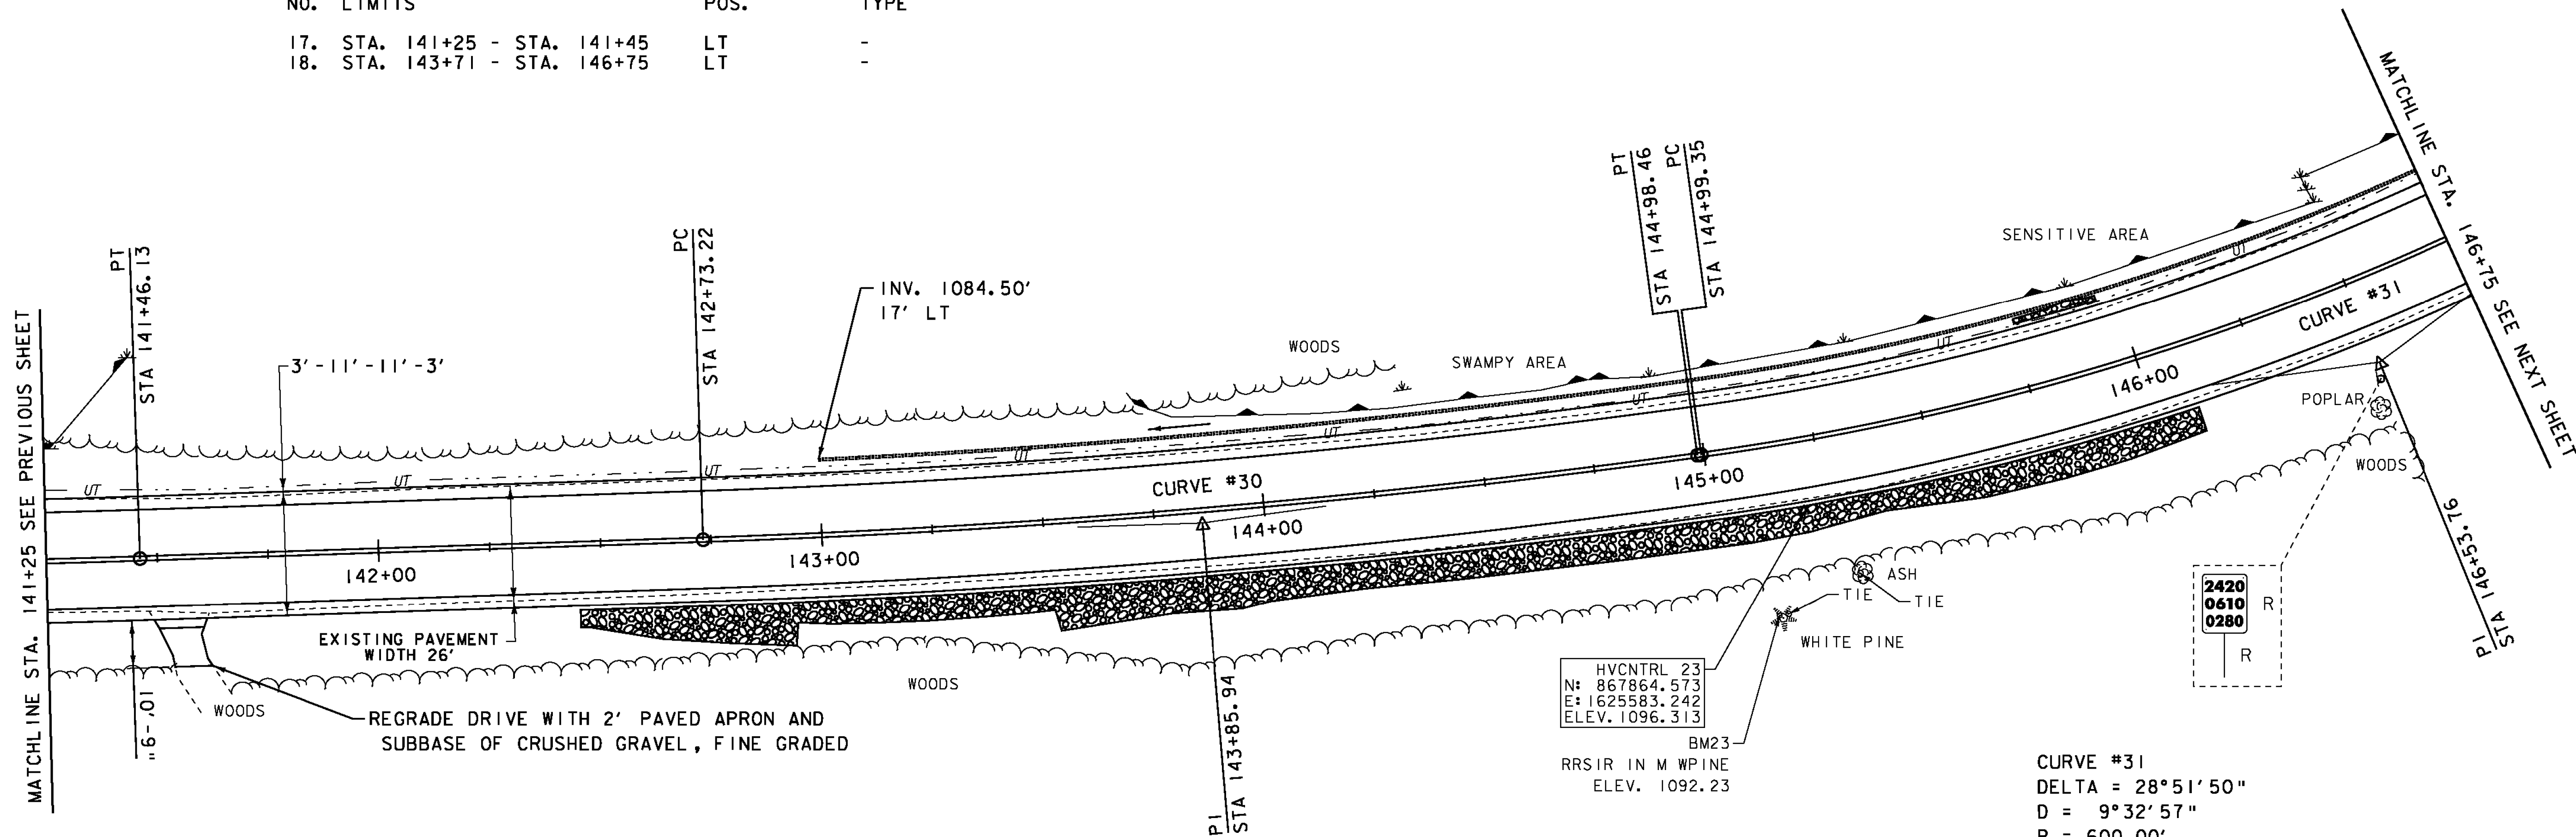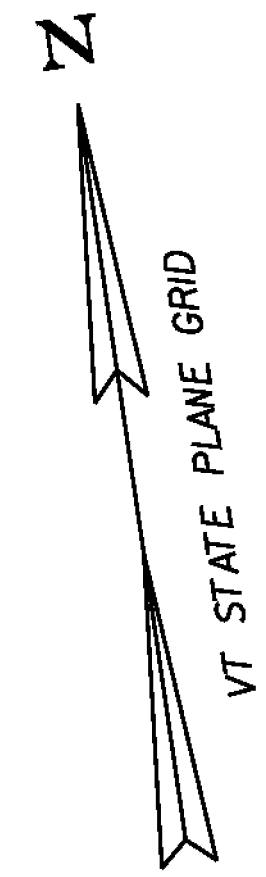

- LEGEND**
- MAILBOX
 - BORING
 - SIGN
 - HYDRANT
 - MANHOLE
 - WATER SHUT OFF (WSO)
 - GAS PIPELINE MARKER
 - CATCH BASIN / DROP INLET
 - CURB INLET
 - TRAFFIC CONTROL BOX
 - ⊕ PARKING METER
 - UTILITY POLE

- SIGN LEGEND**
- R = REMOVE
 - R&S = REMOVE AND SALVAGE
 - RET = RETAIN
 - S = SALVAGED
 - N = NEW
 - B-B = BACK TO BACK
 - = EXISTING
 - = NEW

DATUM
 VERTICAL NAVD 88
 HORIZONTAL NAD 83

CURVE #30
 DELTA = 5°51'58"
 D = 2°36'16"
 R = 2200.00'
 T = 112.72'
 L = 225.24'
 E = 2.89'
 BANKING 0.048 FT/FT
 DESIGN SPEED 50 MPH
 SEE SUPERELEVATION DIAGRAMS
 FOR BANKING INFORMATION

CURVE #31
 DELTA = 28°51'50"
 D = 9°32'57"
 R = 600.00'
 T = 154.41'
 L = 302.26'
 E = 19.55'
 BANKING 0.080 FT/FT
 DESIGN SPEED 40 MPH
 SEE SUPERELEVATION DIAGRAMS
 FOR BANKING INFORMATION



PROJECT LAYOUT SHEET 26	PROJECT NAME: MONTGOMERY-WESTFIELD	PLOT DATE: 9/5/12
	PROJECT NUMBER: STP 2906(I)	DRAWN BY: SJL
	FILE NAME: p10C190.dgn	CHECKED BY: EPD
	PROJECT LEADER: CDL	SHEET 47 OF 178
	DESIGNED BY: SJL	
	PLOT FILE: p10C190_47.1	

SEH
2-25-14